



- NOTES:**
- SEE SHEET BT-C-002 FOR GENERAL NOTES, LEGEND AND ABBREVIATIONS.
 - SEE SHEET BT-C-004 FOR TYPICAL SECTIONS AND DETAILS.
 - CONTRACTOR SHALL GRADE AND LEVEL SITE FOR HIS USE, BUT IN A MANNER THAT IT CONTINUOUSLY AND EFFECTIVELY DRAINS AND CAUSES NO DAMAGE OR PONDING IN CONSTRUCTION WORK AREAS OR FINAL SITE.

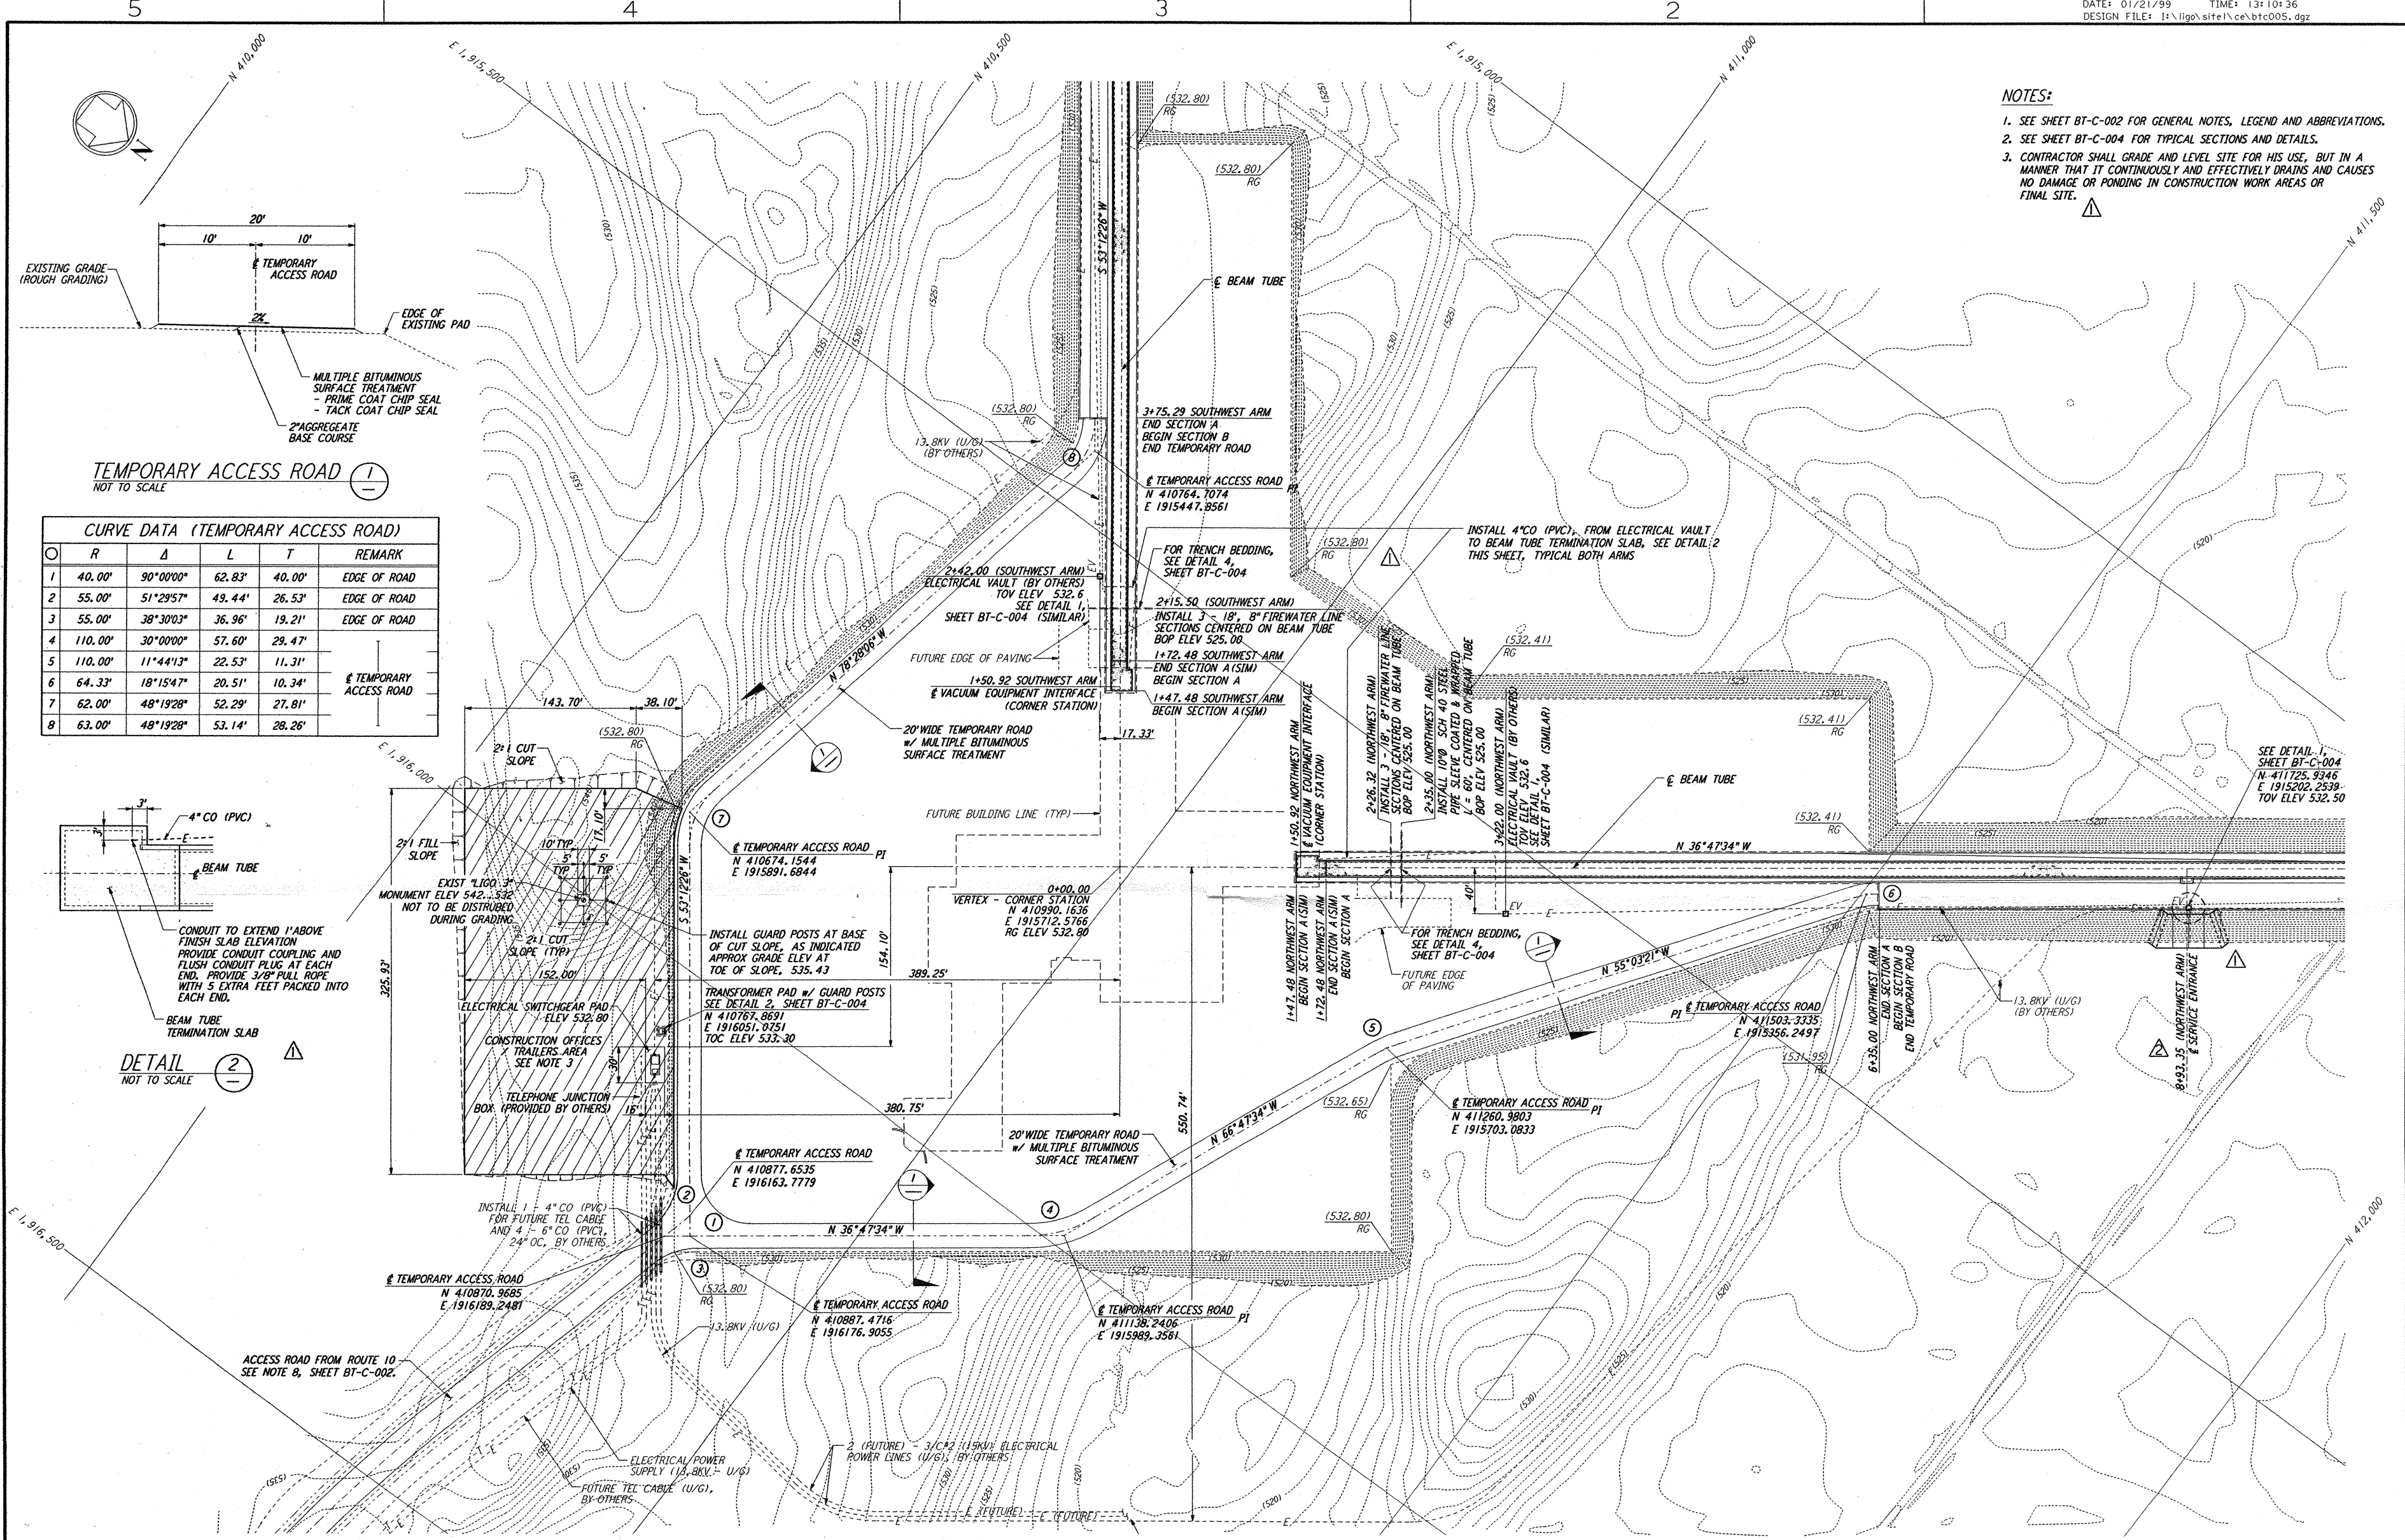


TEMPORARY ACCESS ROAD
 NOT TO SCALE

STATION	R	Δ	L	T	REMARK
1	40.00'	90°00'00"	62.83'	40.00'	EDGE OF ROAD
2	55.00'	51°29'57"	49.44'	26.53'	EDGE OF ROAD
3	55.00'	38°30'03"	36.96'	19.21'	EDGE OF ROAD
4	110.00'	30°00'00"	57.60'	29.47'	
5	110.00'	11°44'13"	22.53'	11.31'	
6	64.33'	18°15'47"	20.51'	10.34'	
7	62.00'	48°19'28"	52.29'	27.81'	
8	63.00'	48°19'28"	53.14'	28.26'	

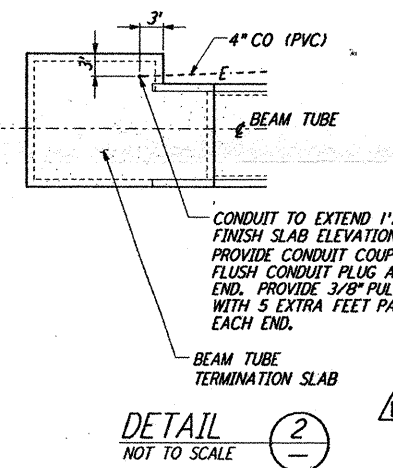

This document and the design it covers are the property of PARSONS. They are loaned only with the borrower's expressed written agreement that they will not be reproduced, copied, loaned, exhibited, or used in any other way, except by written consent from PARSONS.

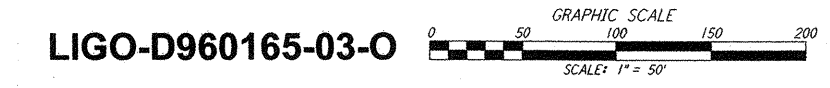

NO.	DATE	BY	CHKD	ENGR	PROJ	DESCRIPTION
3	1-22-99	MET			MDW	ISSUED FOR AS BUILT
2	5-10-96	WRB	TDM	JB	MDW	REVISED BEAM TUBE SERVICE ENTRANCES
1	2-29-96	WRB	TDM	JB	MDW	CHANGE ORDER NO. 2

ISSUED FOR CONSTRUCTION	WRB	1-19-96
DRAWN	MP	1-19-96
CHECKED	JB	1-19-96
ENGINEER	MDW	1-19-96
PROJ		

PARSONS
 100 WEST WALNUT STREET
 PASADENA, CALIFORNIA

LIGO
 CALIFORNIA INSTITUTE OF TECHNOLOGY
 MASSACHUSETTS INSTITUTE OF TECHNOLOGY

LASER INTERFEROMETER
 GRAVITATIONAL-WAVE OBSERVATORY
 BTE SITING & FABRICATION - HANFORD, WA

CIVIL
 CORNER STATION
 PLAN

SCALE: 1" = 50'
 PP150969 8094
BT-C-005