


not be reproduced, copied, loaned, exhibited, or used in any other way, except by written consent from PARSONS to the borrower.


This document and the design it covers are the property of PARSONS. They are loaned only with the borrower's expressed written agreement that they will

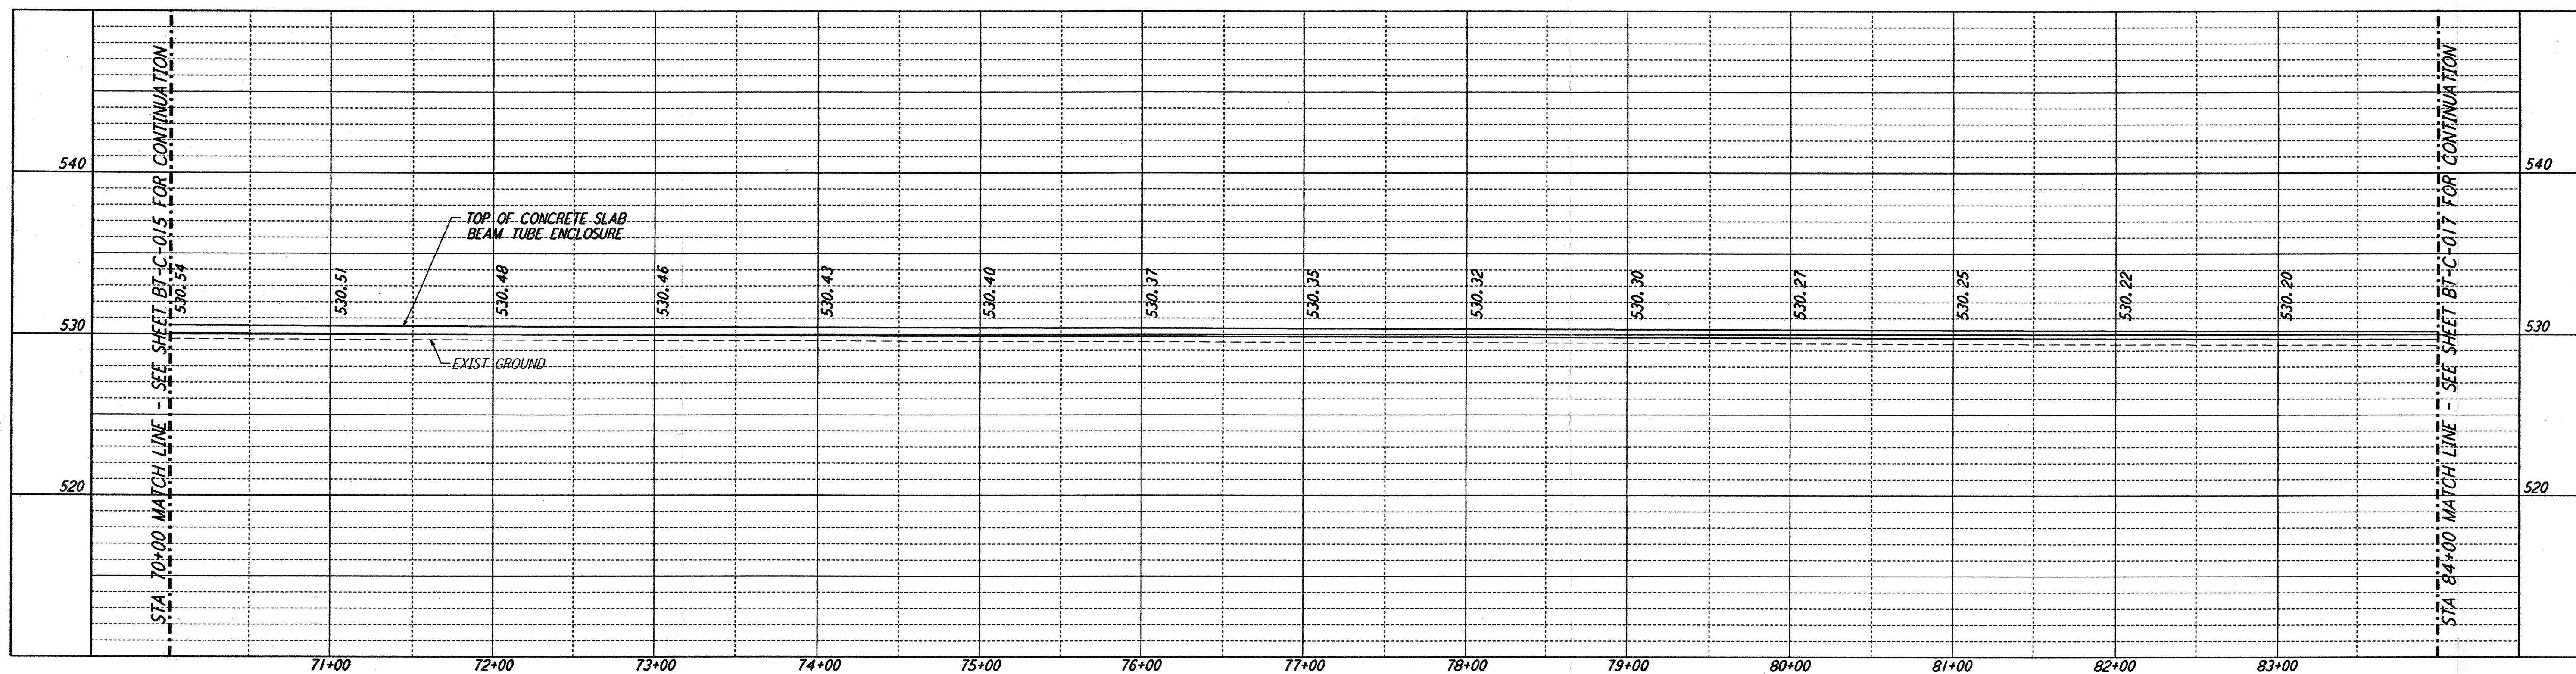


NOTES:

- SEE SHEET BT-C-002 FOR GENERAL NOTES, LEGEND AND ABBREVIATIONS.
- SEE SHEET BT-C-004 FOR TYPICAL SECTIONS AND DETAILS.


PROFILE  
SCALES: HORIZ: 1" = 50'  
VERT: 1" = 5'

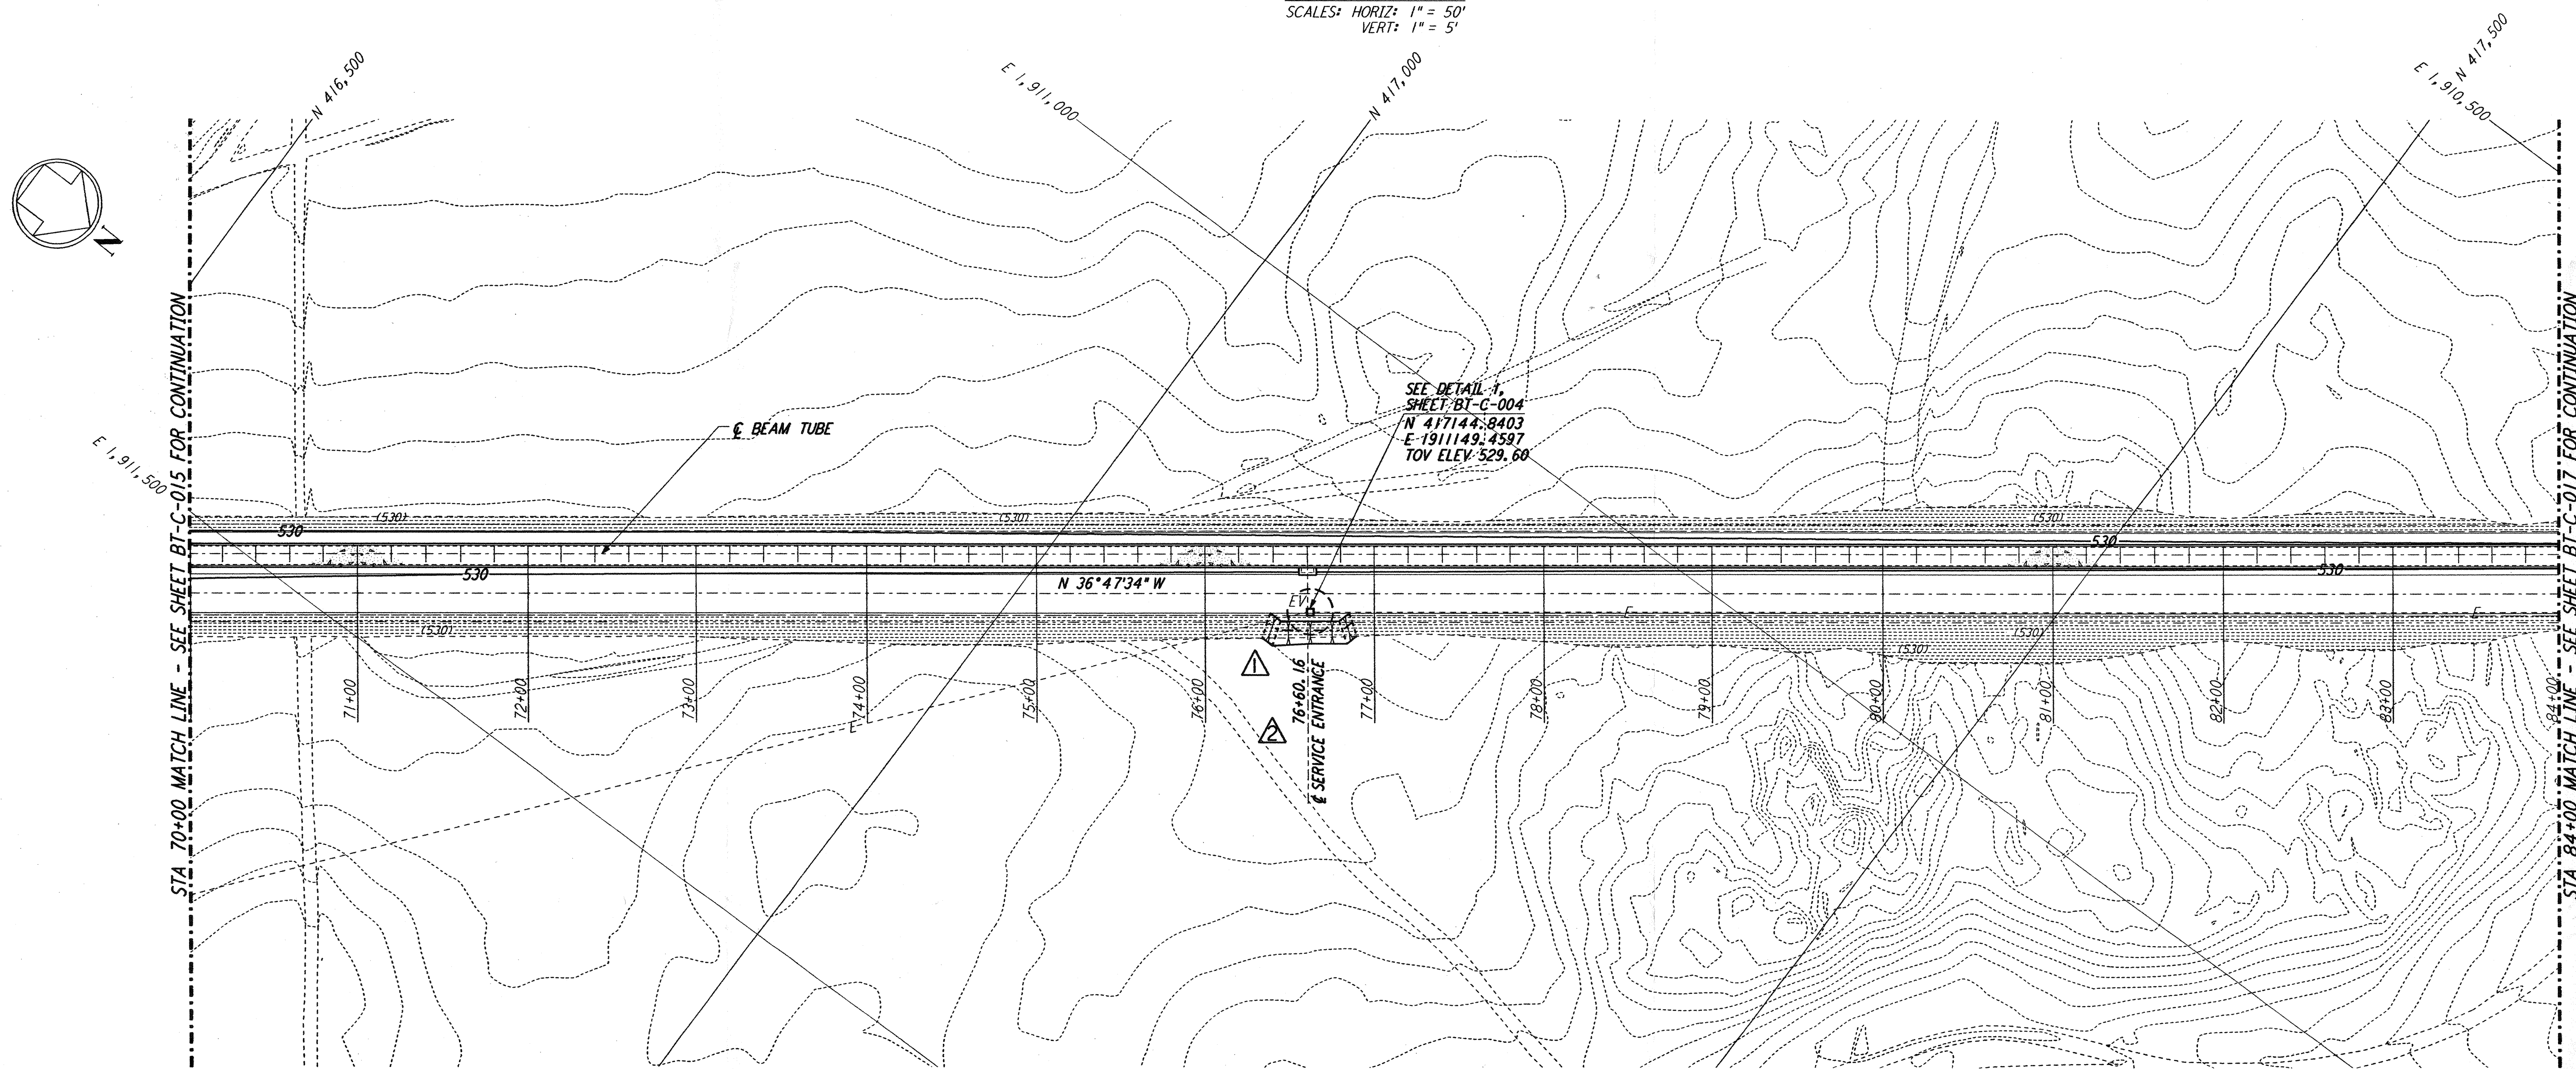

PLAN  
SCALE: 1" = 50'

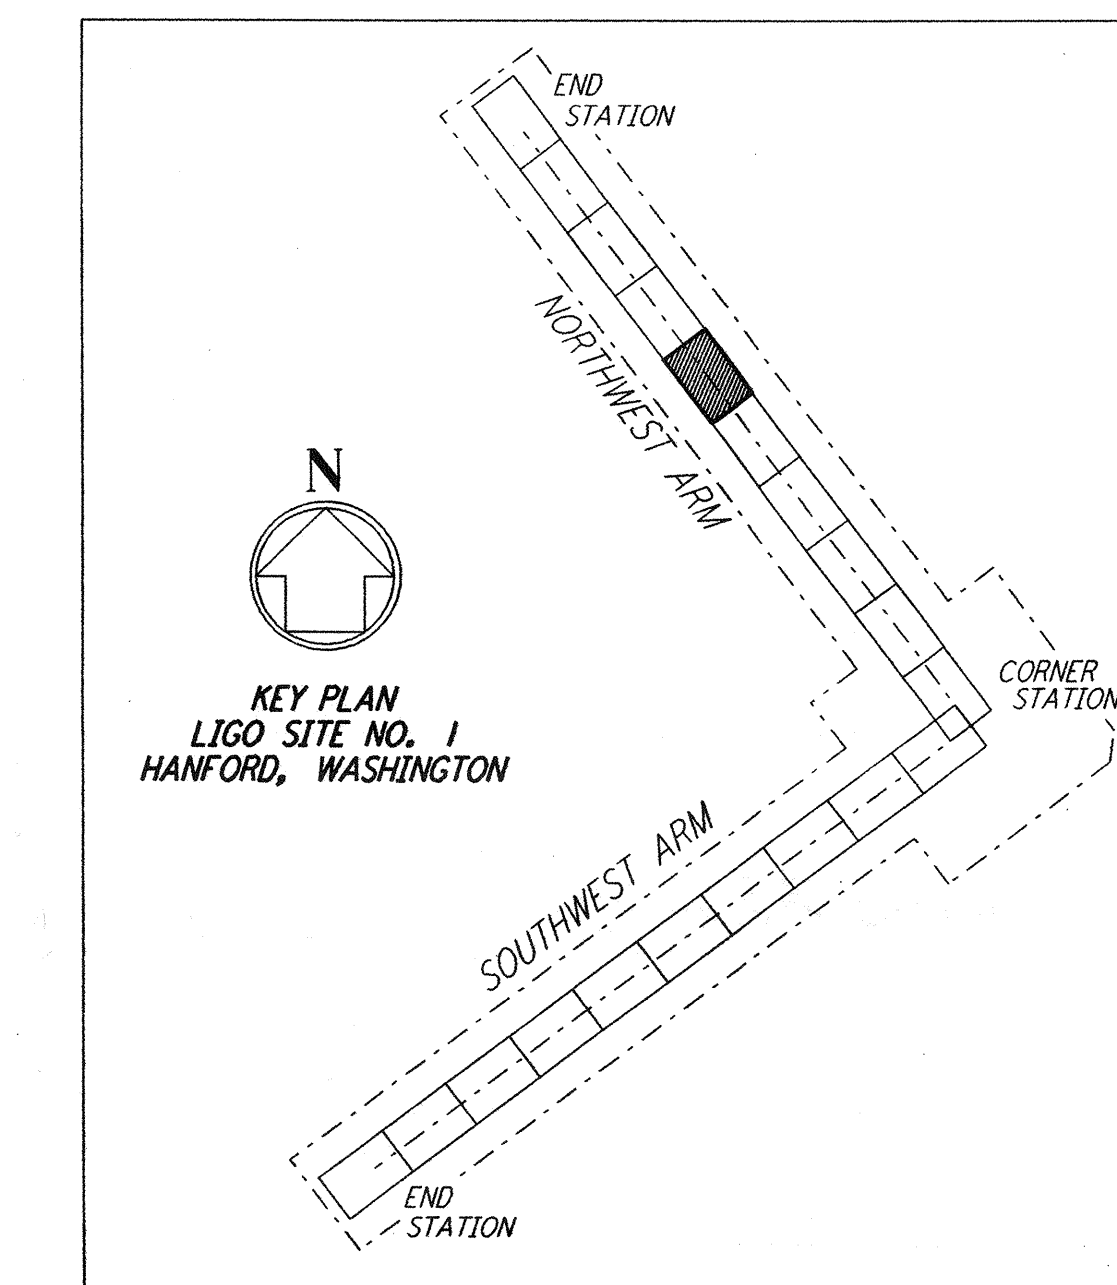

LIGO-D960171-03-O

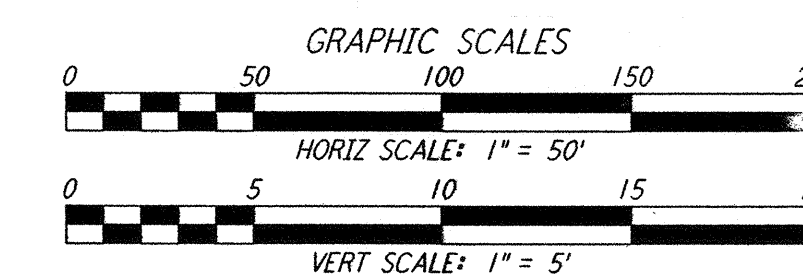

NO.	DATE	BY	CHKD	ENGR	PROJ	DESCRIPTION
3	1-22-99	MEI	--	--	MDW	ISSUED FOR AS BUILT
2	5-10-96	WRB	TDM	JB	MDW	REVISED BEAM TUBE SERVICE ENTRANCES
1	2-29-96	WRB	TDM	JB	MDW	CHANGE ORDER NO. 2

ISSUED FOR CONSTRUCTION  
 DRAWN: WRB 1-19-96  
 CHECKED: MP 1-19-96  
 ENGINEER: JB 1-19-96  
 PROJ: MDW 1-19-96

AS-BUILT DRAWINGS



100 WEST WALNUT STREET  
PASADENA, CALIFORNIA



CALIFORNIA INSTITUTE OF TECHNOLOGY  
MASSACHUSETTS INSTITUTE OF TECHNOLOGY

LASER INTERFEROMETER  
GRAVITATIONAL-WAVE OBSERVATORY  
BTE SITework & FABRICATION - HANFORD, WA

TITLE	SCALE	CONTRACT NUMBER	PROJECT NUMBER
CIVIL NORTHWEST ARM PLAN AND PROFILE STA 70+00 TO STA 84+00	AS NOTED	PP150969	8094
SHEET NUMBER		REVISIONS	
BT-C-016		3	