



NOTES:



- 1. SEE SHEET BT-C-002 FOR GENERAL NOTES, LEGEND AND ABBREVIATIONS.
- 2. SEE SHEET BT-C-004 FOR TYPICAL SECTIONS AND DETAILS.

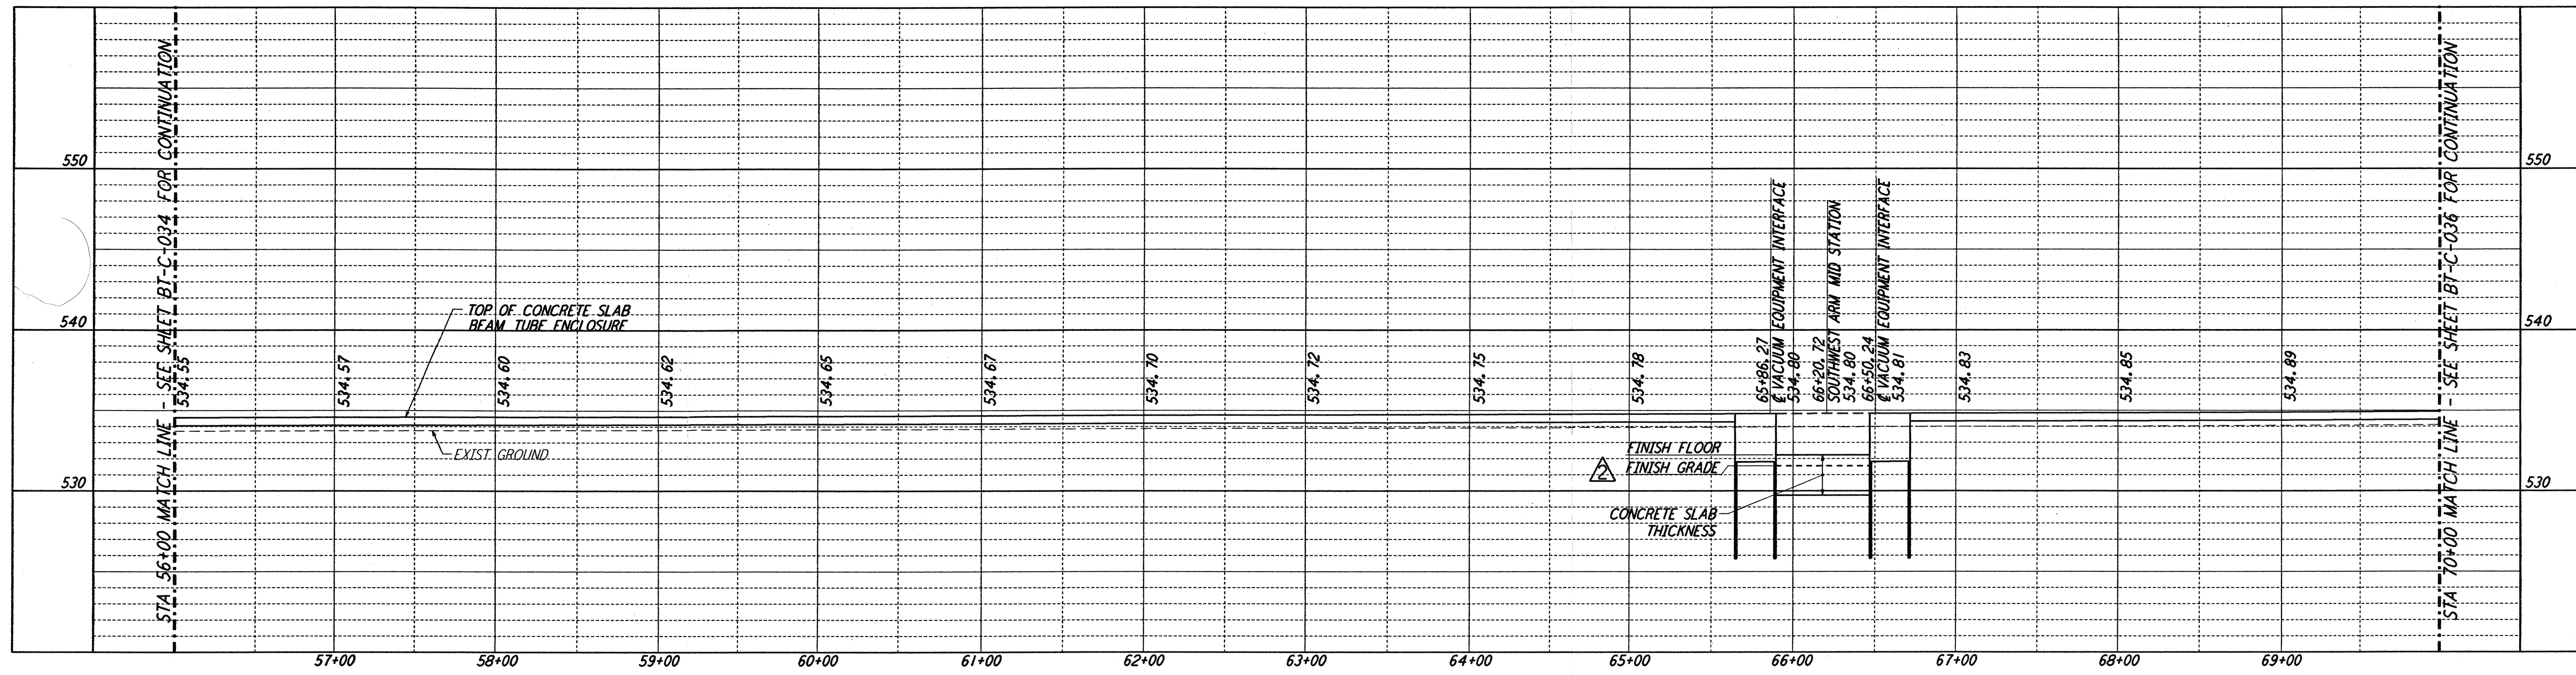


PROFILE  
SCALE: HORIZ: 1" = 50'  
VERT: 1" = 5'

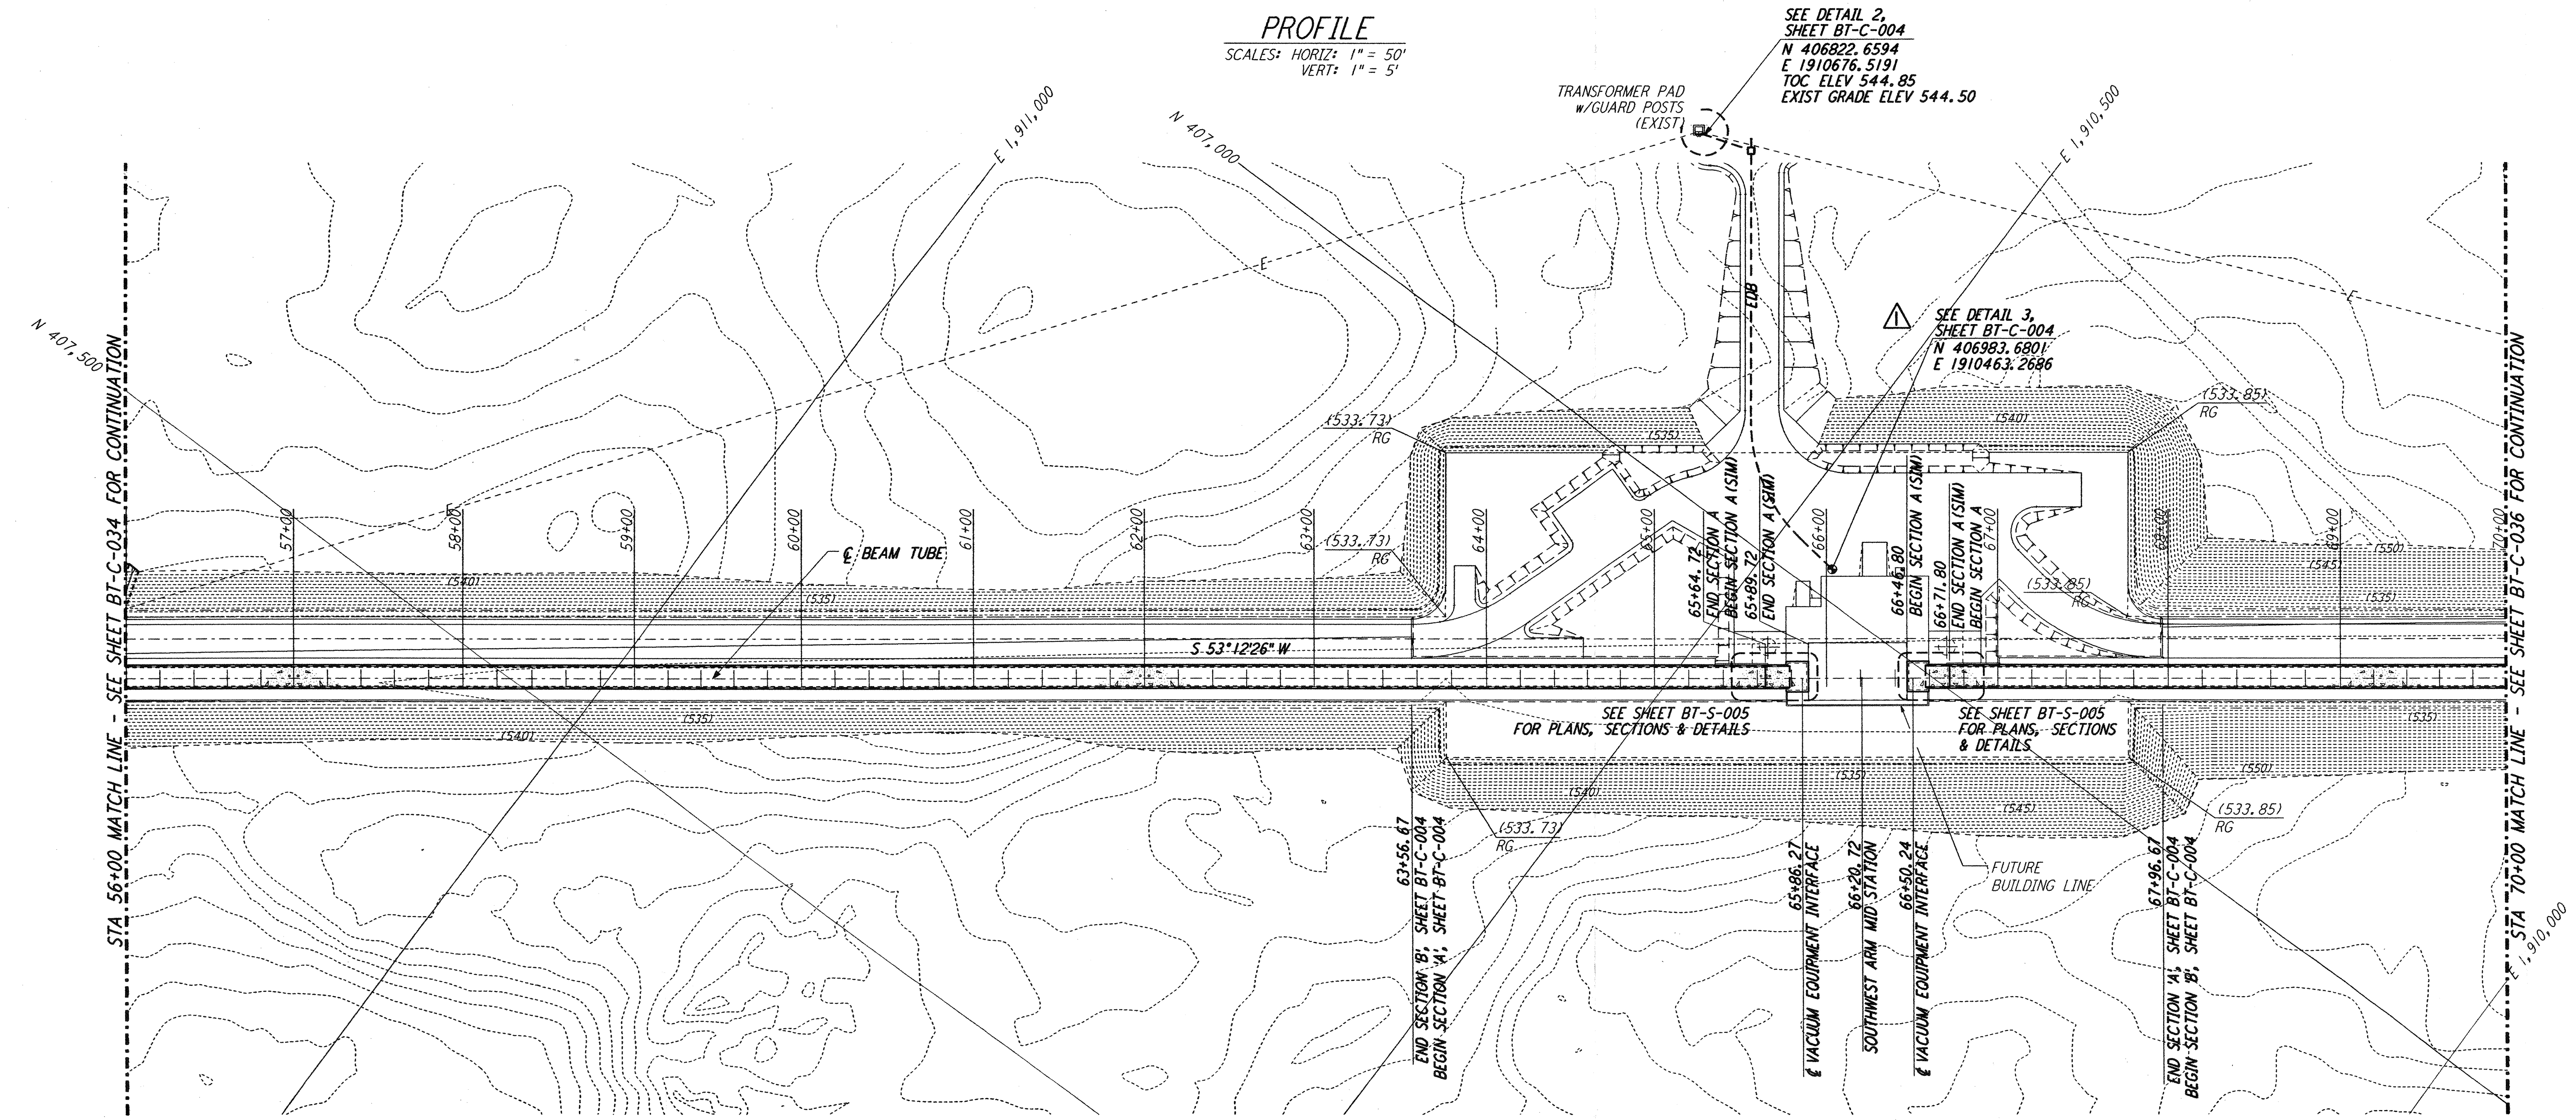

PLAN  
SCALE: 1" = 50'

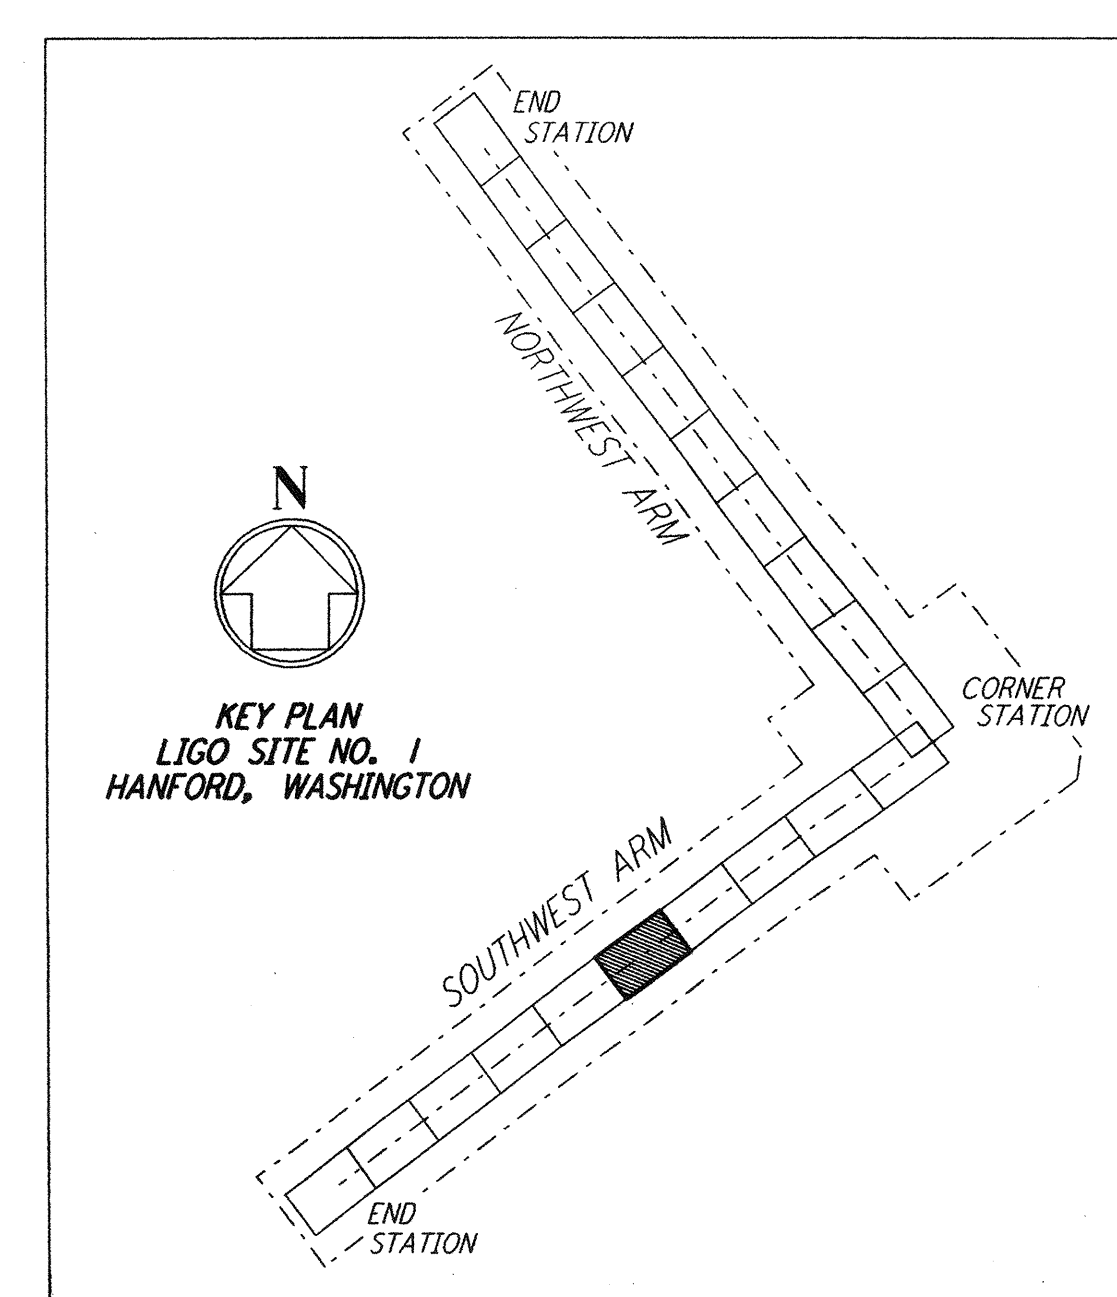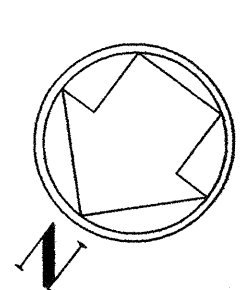

LIGO-D960180-03-O

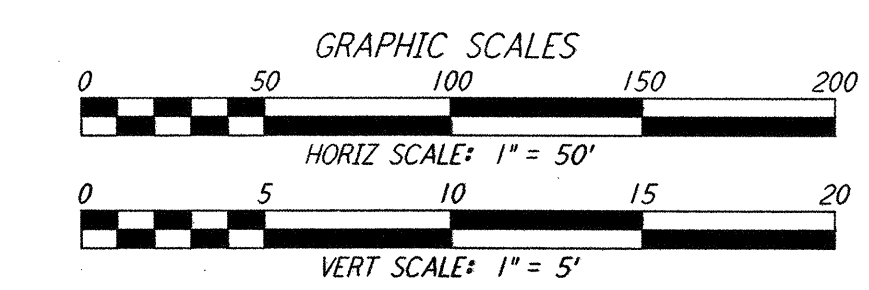

NOTE:  
SEE SHEET BT-C-041 FOR SITE PLAN,  
SHEET BT-C-042 FOR GRADING PLAN  
AND SHEET BT-C-043 FOR UTILITY PLAN  
AT MID-STATION (SOUTHWEST ARM)

NO.	DATE	BY	CHKD	ENGR	PROJ	DESCRIPTION
3	1-22-99	MET	--	--	MDW	ISSUED FOR AS BUILT
2	4-19-96	WRB	TDM	JB	MDW	CHANGE ORDER NO. 4
1	2-29-96	WRB	TDM	JB	MDW	CHANGE ORDER NO. 2

ISSUED FOR CONSTRUCTION	DRAWN	CHECKED	ENGINEER	PROJ
	WRB	MP	JB	MDW

**AS-BUILT DRAWINGS**

**PARSONS**  
100 WEST WALNUT STREET  
PASADENA, CALIFORNIA

**LIGO**  
CALIFORNIA INSTITUTE OF TECHNOLOGY  
MASSACHUSETTS INSTITUTE OF TECHNOLOGY

LASER INTERFEROMETER  
GRAVITATIONAL-WAVE OBSERVATORY  
BTE SITESWORK & FABRICATION - HANFORD, WA

TITLE	CIVIL SOUTHWEST ARM PLAN AND PROFILE STA 56+00 TO STA 70+00	SCALE	AS NOTED	CONTRACT NUMBER	PP150969	PROJECT NUMBER	8094
SHEET NUMBER	<b>BT - C - 035</b>		REVISED	3			

This document and the design it covers are the property of PARSONS. They are loaned only with the borrower's expressed written agreement that they will not be reproduced, copied, loaned, exhibited, or used in any other way, except by written consent from PARSONS to the borrower.