



not be reproduced, copied, loaned, exhibited, or used in any other way, except by written consent from PARSONS to the borrower.

This document and the design it covers are the property of PARSONS. They are loaned only with the borrower's expressed written agreement that they will

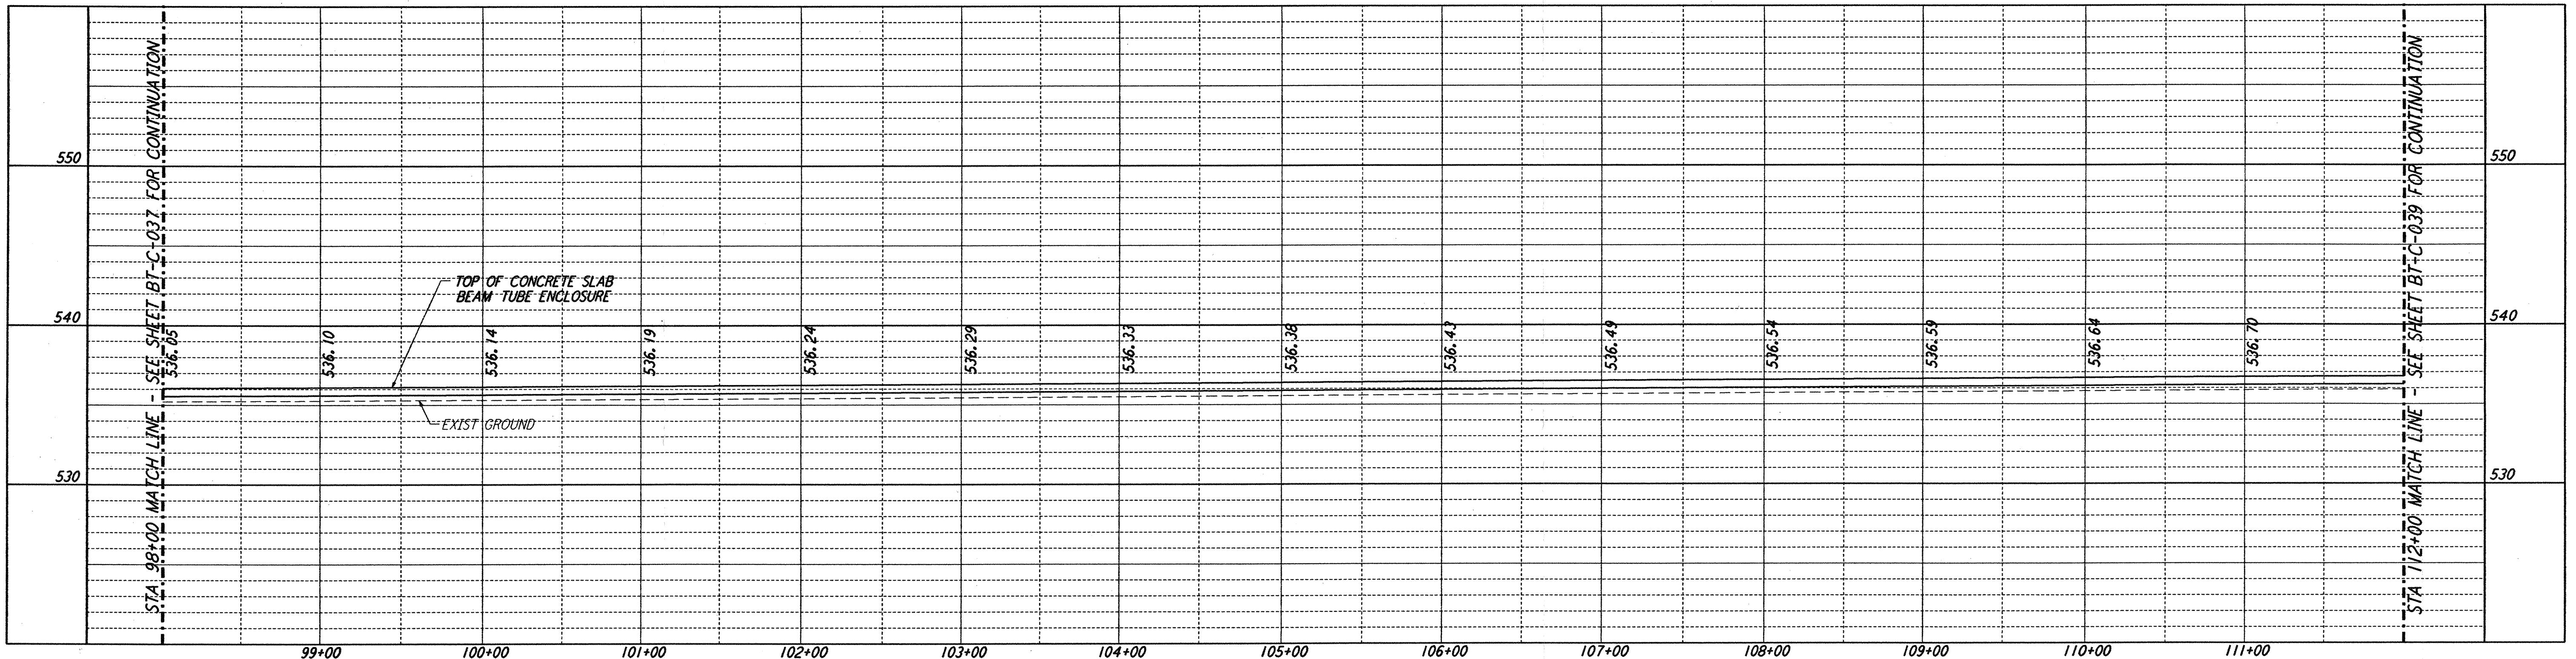


NOTES:


- SEE SHEET BT-C-002 FOR GENERAL NOTES, LEGEND AND ABBREVIATIONS.
- SEE SHEET BT-C-004 FOR TYPICAL SECTIONS AND DETAILS.
- TRANSITION BETWEEN SECTIONS, AS SHOWN ON PLAN.

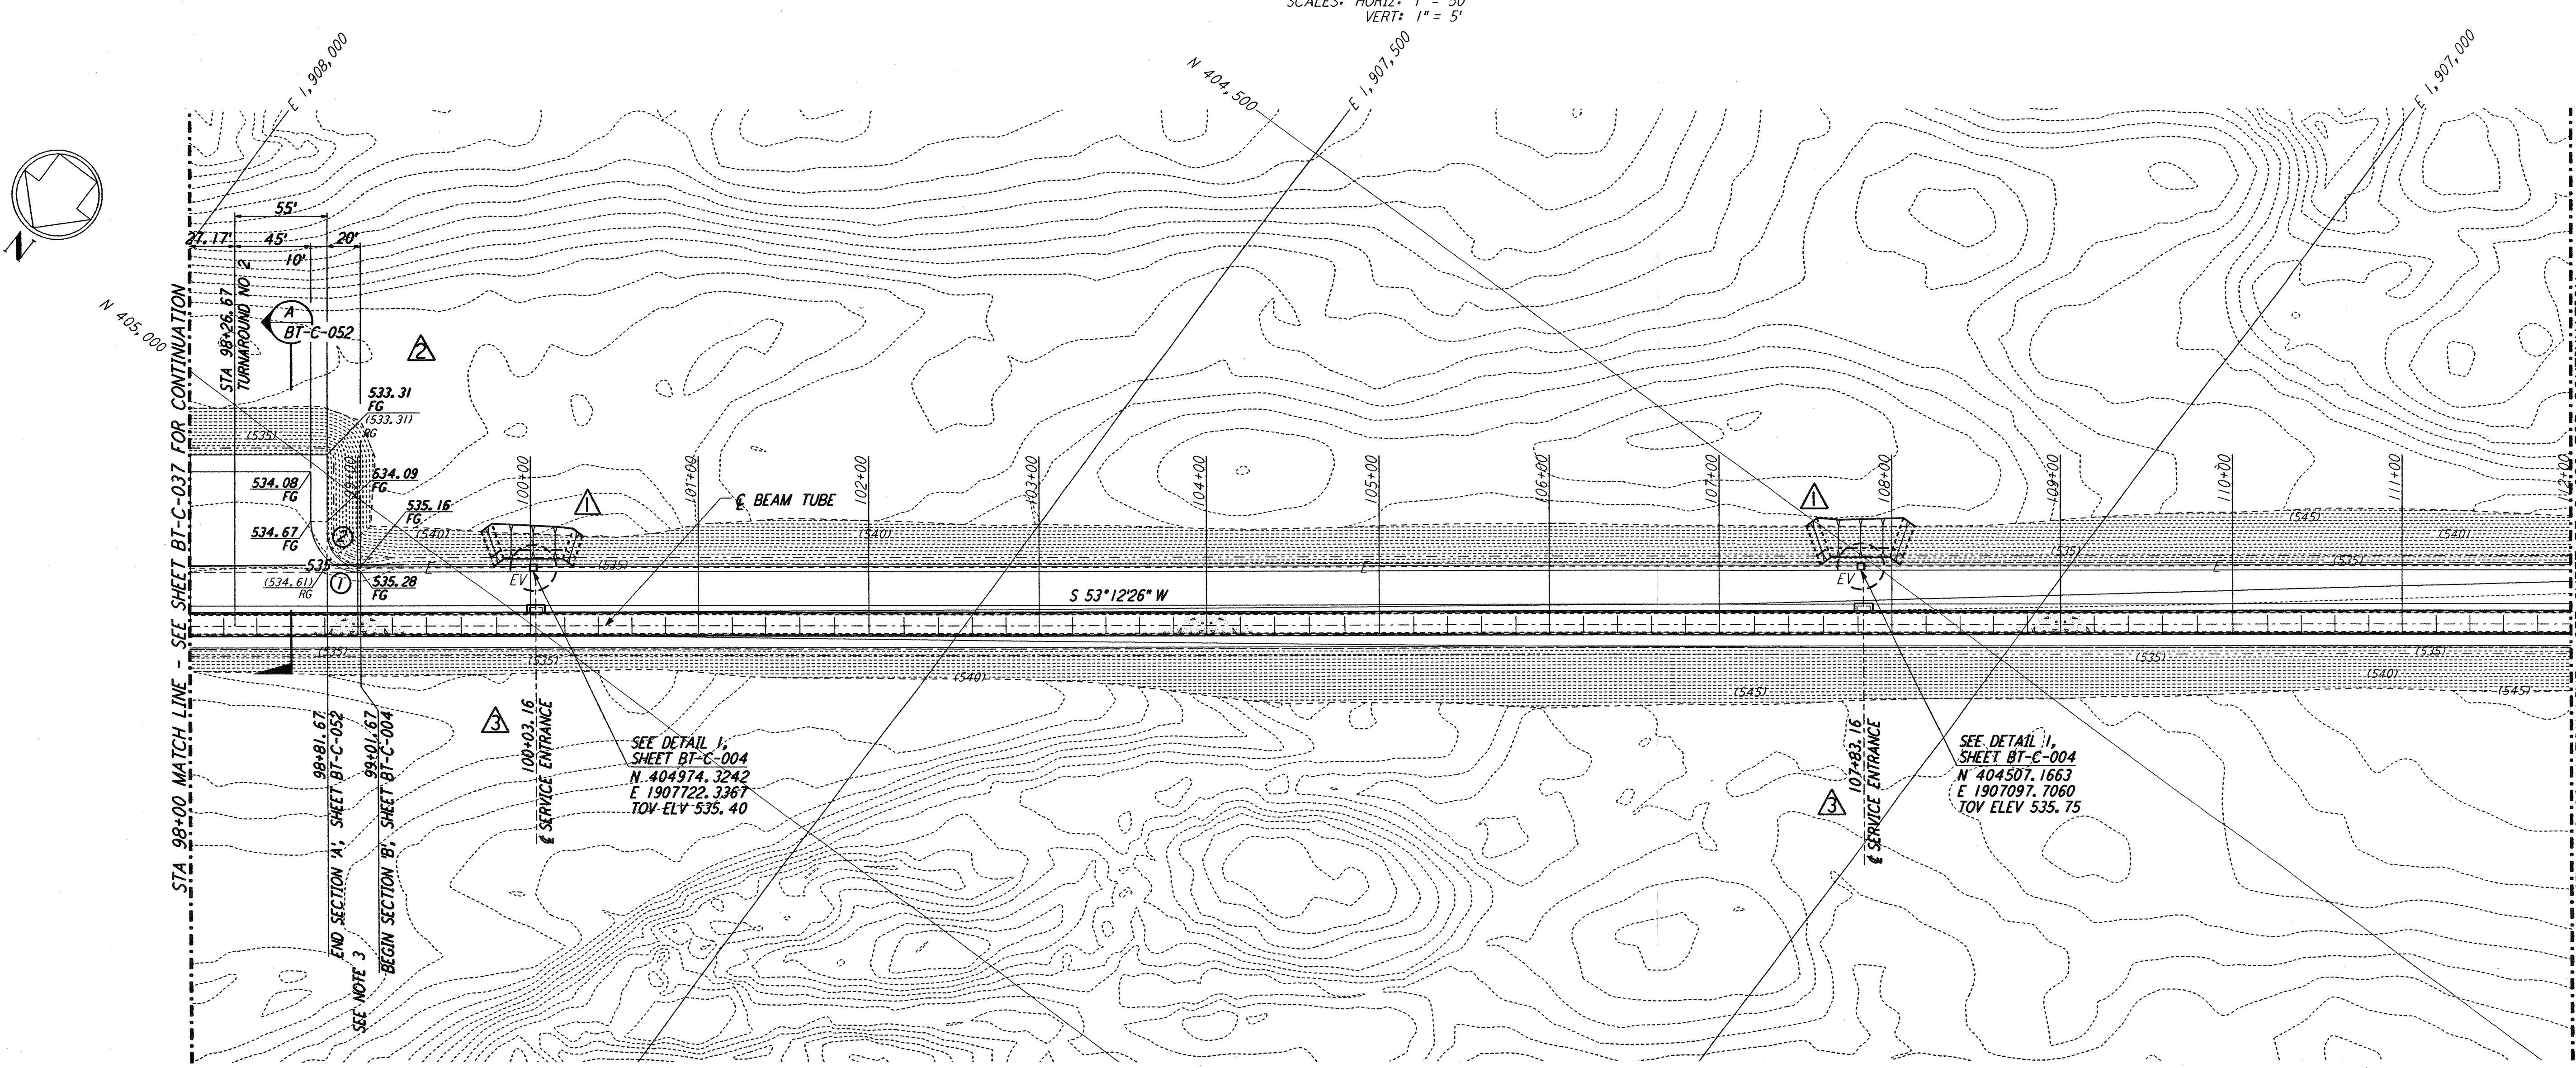

CURVE DATA				
○	Δ	RADIUS	LENGTH	TANGENT
1	90°00'00"	30'	47.12'	30.00'
2	90°00'00"	20'	31.42'	20.00'

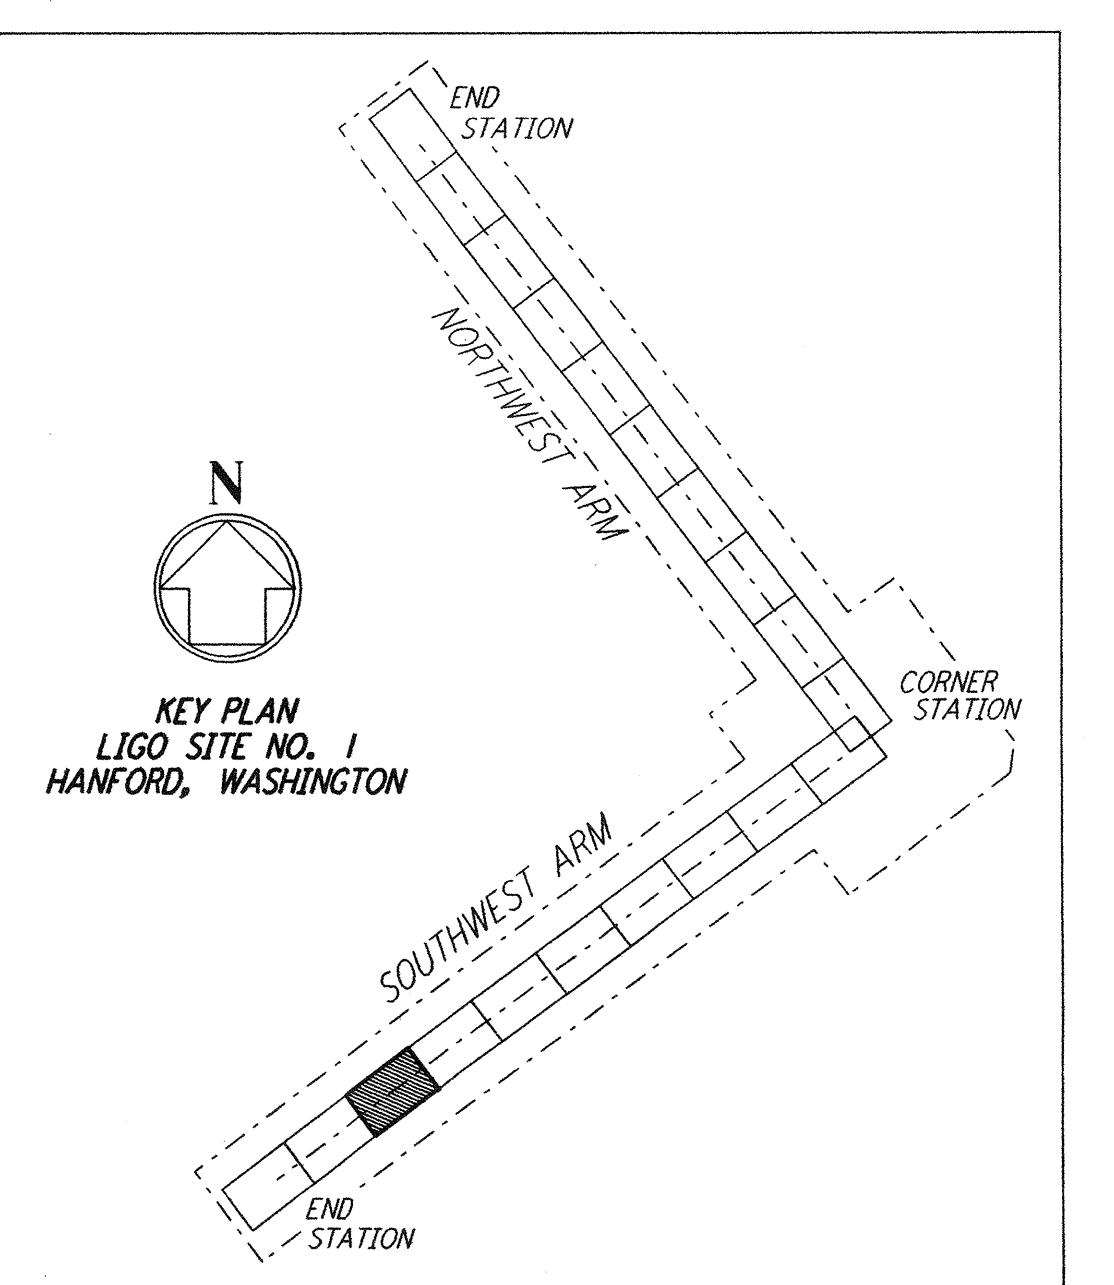

LIGO-D960183-04-O

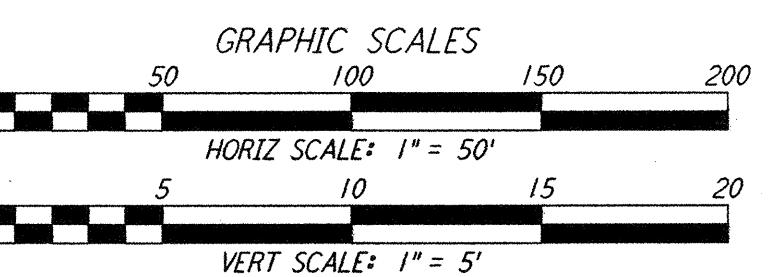

PLAN

SCALE: 1" = 50'

REFERENCES		REVISONS		ISSUED FOR CONSTRUCTION			
4	I-22-99	MEI	--	DRAWN	WRB	1-19-96	
3	5-10-96	WRB	TDM	CHECKED	MP	1-19-96	
				ENGINEER	JB	1-19-96	
				PROJ	MDW	1-19-96	
ISSUED FOR AS BUILT							
REVISED BEAM TUBE SERVICE ENTRANCES							
CHANGE ORDER NO. 4							
CHANGE ORDER NO. 2							
NO.	DATE	BY	CHKD	ENGR	PROJ	DESCRIPTION	

AS-BUILT DRAWINGS

**P** PARSONS  
100 WEST WALNUT STREET  
PASADENA, CALIFORNIA

**LIGO**  
CALIFORNIA INSTITUTE OF TECHNOLOGY  
MASSACHUSETTS INSTITUTE OF TECHNOLOGY

LASER INTERFEROMETER  
GRAVITATIONAL-WAVE OBSERVATORY  
BTE SITEWORK & FABRICATION - HANFORD, WA  
TITLE CIVIL  
SHEET NUMBER AS NOTED PP150969 8094  
PROJECT NUMBER  
SOUTHWEST ARM  
PLAN AND PROFILE  
STA 98+00 TO STA 112+00  
**BT - C - 038** 4