


This document and the design it covers are the property of PARSONS. They are loaned only with the borrower's expressed written agreement that they will not be reproduced, copied, loaned, exhibited, or used in any other way, except by written consent from PARSONS to the borrower.

This document and the design it covers are the property of PARSONS. They are loaned only with the borrower's expressed written agreement that they will not be reproduced, copied, loaned, exhibited, or used in any other way, except by written consent from PARSONS to the borrower.

NOTE:
 1. FOR GENERAL NOTES, ABBREVIATIONS AND LEGEND SEE DRAWING BT-S-001.

LIGO-D960187-02-0

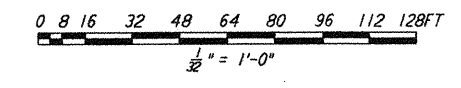

REV.	DATE	BY	CHKD	ENGR	PROJ.	DESCRIPTION
2	1-22-99	MEI			MDW	ISSUED FOR AS BUILT
1	3-25-96	TM	BP	TM		CHANGE ORDER #3

ISSUED FOR CONSTRUCTION	DATE
DRAWN	SH 1-19-96
CHECKED	RM 1-19-96
ENGINEER	FD 1-19-96
PROJ.	MW 1-19-96

AS-BUILT DRAWINGS

PARSONS
 100 WEST WALNUT STREET
 PASADENA, CALIFORNIA

LIGO
 CALIFORNIA INSTITUTE OF TECHNOLOGY
 MASSACHUSETTS INSTITUTE OF TECHNOLOGY

LASER INTERFEROMETER
 GRAVITATIONAL-WAVE OBSERVATORY
 BTE SITENWORK & FABRICATION - HANFORD, WA

TITLE: STRUCTURAL KEY PLAN OF BEAM TUBE ENCLOSURE & PARTIAL ENLARGED PLAN
 SCALE: AS NOTED
 SHEET NUMBER: PPI150969
 PROJECT NUMBER: 8094
 DRAWING NUMBER: BT-S-002

Thu Jan 21 13:17:28 1999 CA:\PLOT\LDUE\33-V9682.DWG 52885 K:\V9682\180202.prf LIGOBTF.BDR