

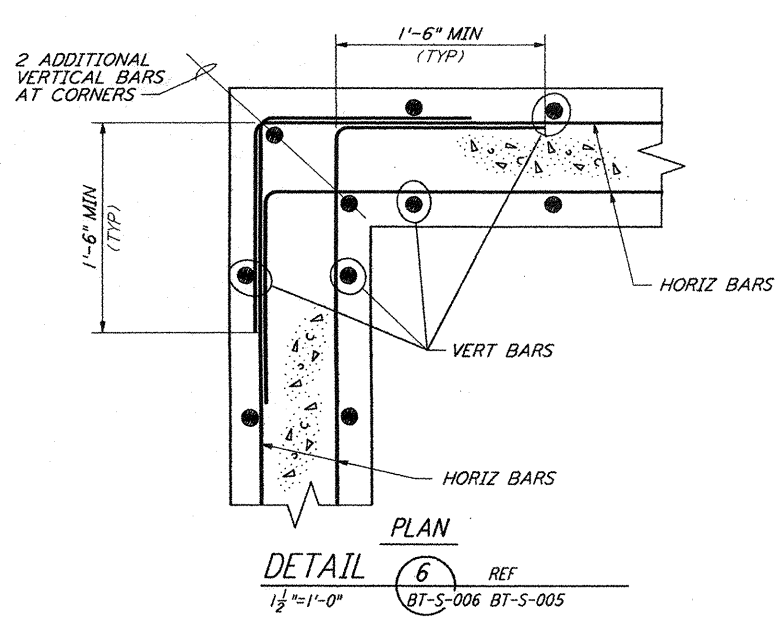
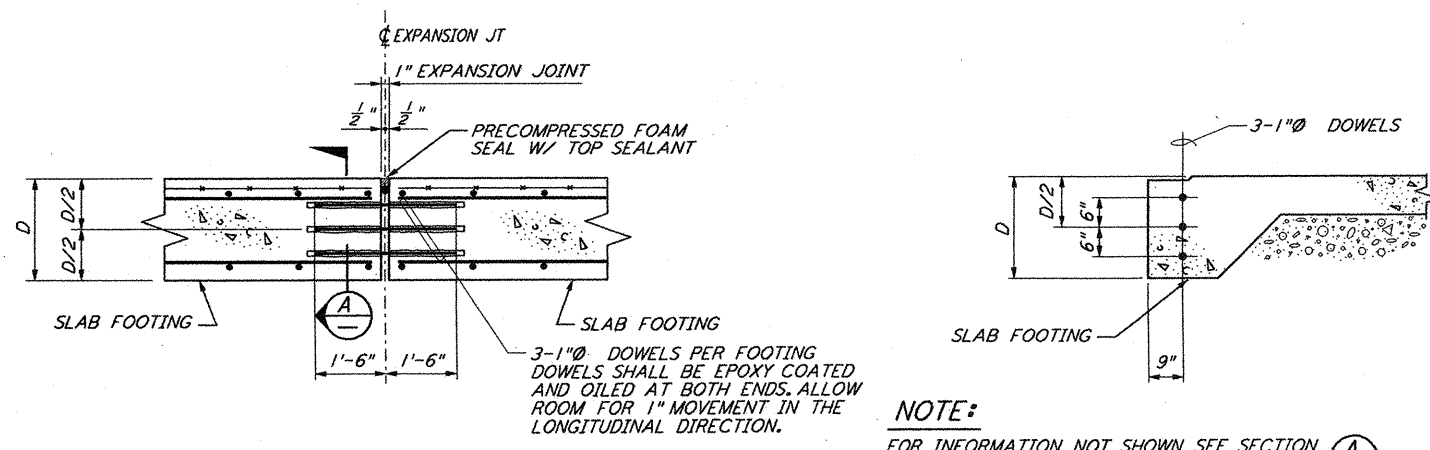


not be reproduced, copied, loaned, exhibited, or used in any other way, except by written consent from PARSONS to the borrower.

This document and the design it covers are the property of PARSONS. They are loaned only with the borrower's expressed written agreement that they will

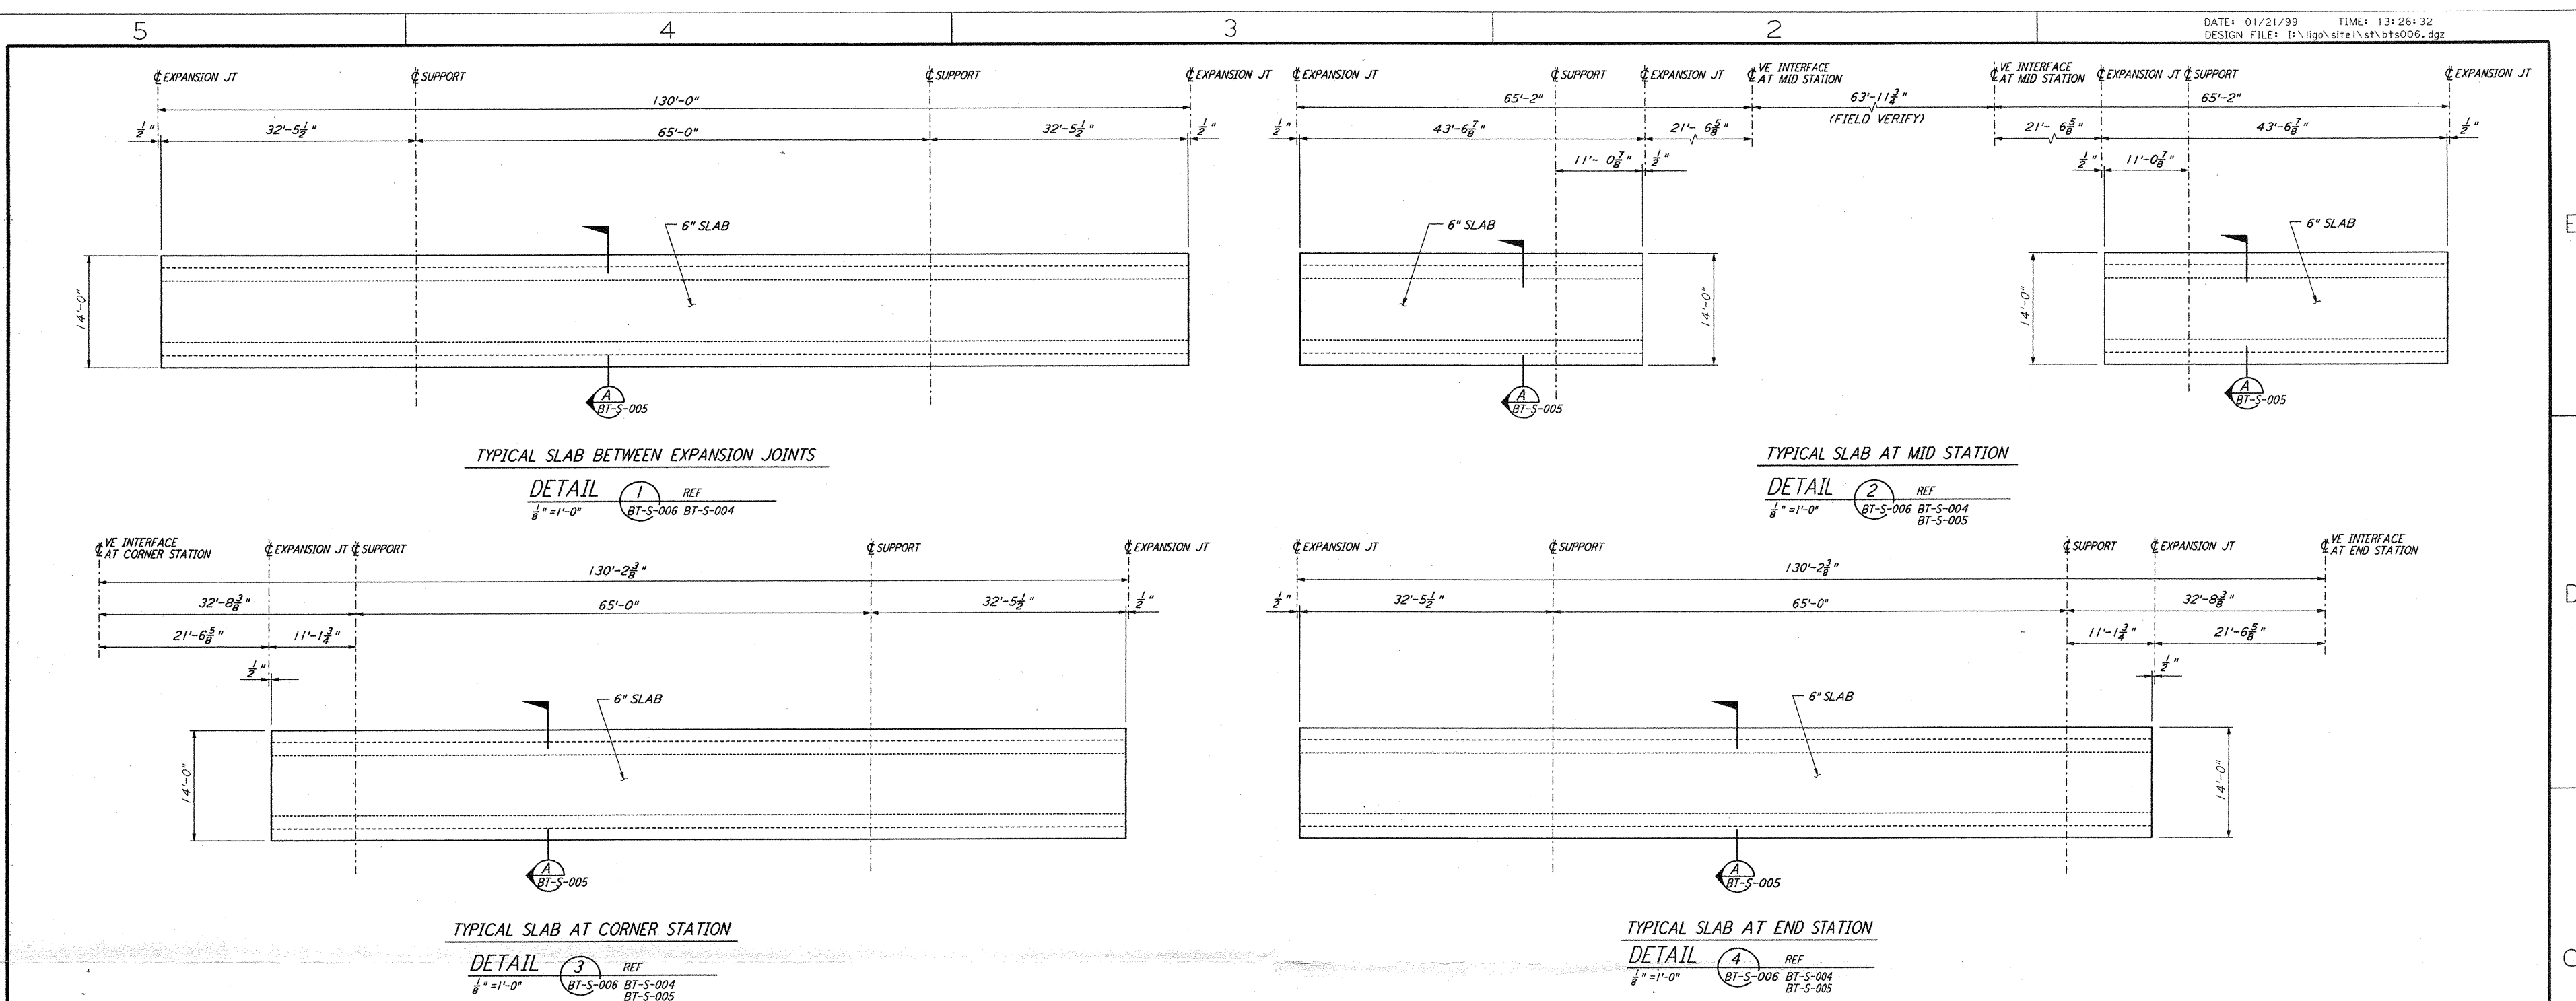

NOTE:
 1. FOR GENERAL NOTES, ABBREVIATIONS AND LEGEND SEE DRAWING BT-S-001.

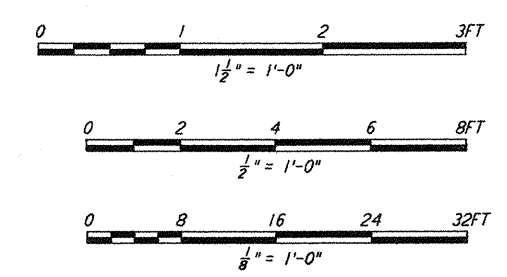

LIGO-D960192-01-0

| DRAWING NO. | DESCRIPTION | NO. | DATE | BY | CHKD | ENGR | PROJ | DESCRIPTION |
|-------------|-------------|-----|---------|-----|------|------|------|---------------------|
| | | 1 | 1-22-99 | MEI | -- | -- | MDW | ISSUED FOR AS BUILT |

| ISSUED FOR CONSTRUCTION | | | |
|-------------------------|-----|---------|--|
| DRAWN | MCS | 1-19-96 | |
| CHECKED | RM | 1-19-96 | |
| ENGINEER | FD | 1-19-96 | |
| PROJ | MW | 1-19-96 | |

AS-BUILT DRAWINGS

PARSONS
 100 WEST WALNUT STREET
 PASADENA, CALIFORNIA

LIGO
 CALIFORNIA INSTITUTE OF TECHNOLOGY
 MASSACHUSETTS INSTITUTE OF TECHNOLOGY

LASER INTERFEROMETER
 GRAVITATIONAL-WAVE OBSERVATORY
 BTE SITENWORK & FABRICATION - HANFORD, WA

TITLE: STRUCTURAL BEAM TUBE ENCLOSURE SECTIONS & DETAILS SHEET 2

AS NOTED PP150969 8094

BT-S-006

Thu Jan 21 13:26:36 1999 C:\PLOT\VIEW\USA\PARSONS\BTE\006.dwg 52096 KAVASER\V\006.dwg