



This document and the design it covers are the property of PARSONS. They are loaned only with the borrower's expressed written agreement that they will not be reproduced, copied, loaned, exhibited, or used in any other way, except by written consent from PARSONS to the borrower.

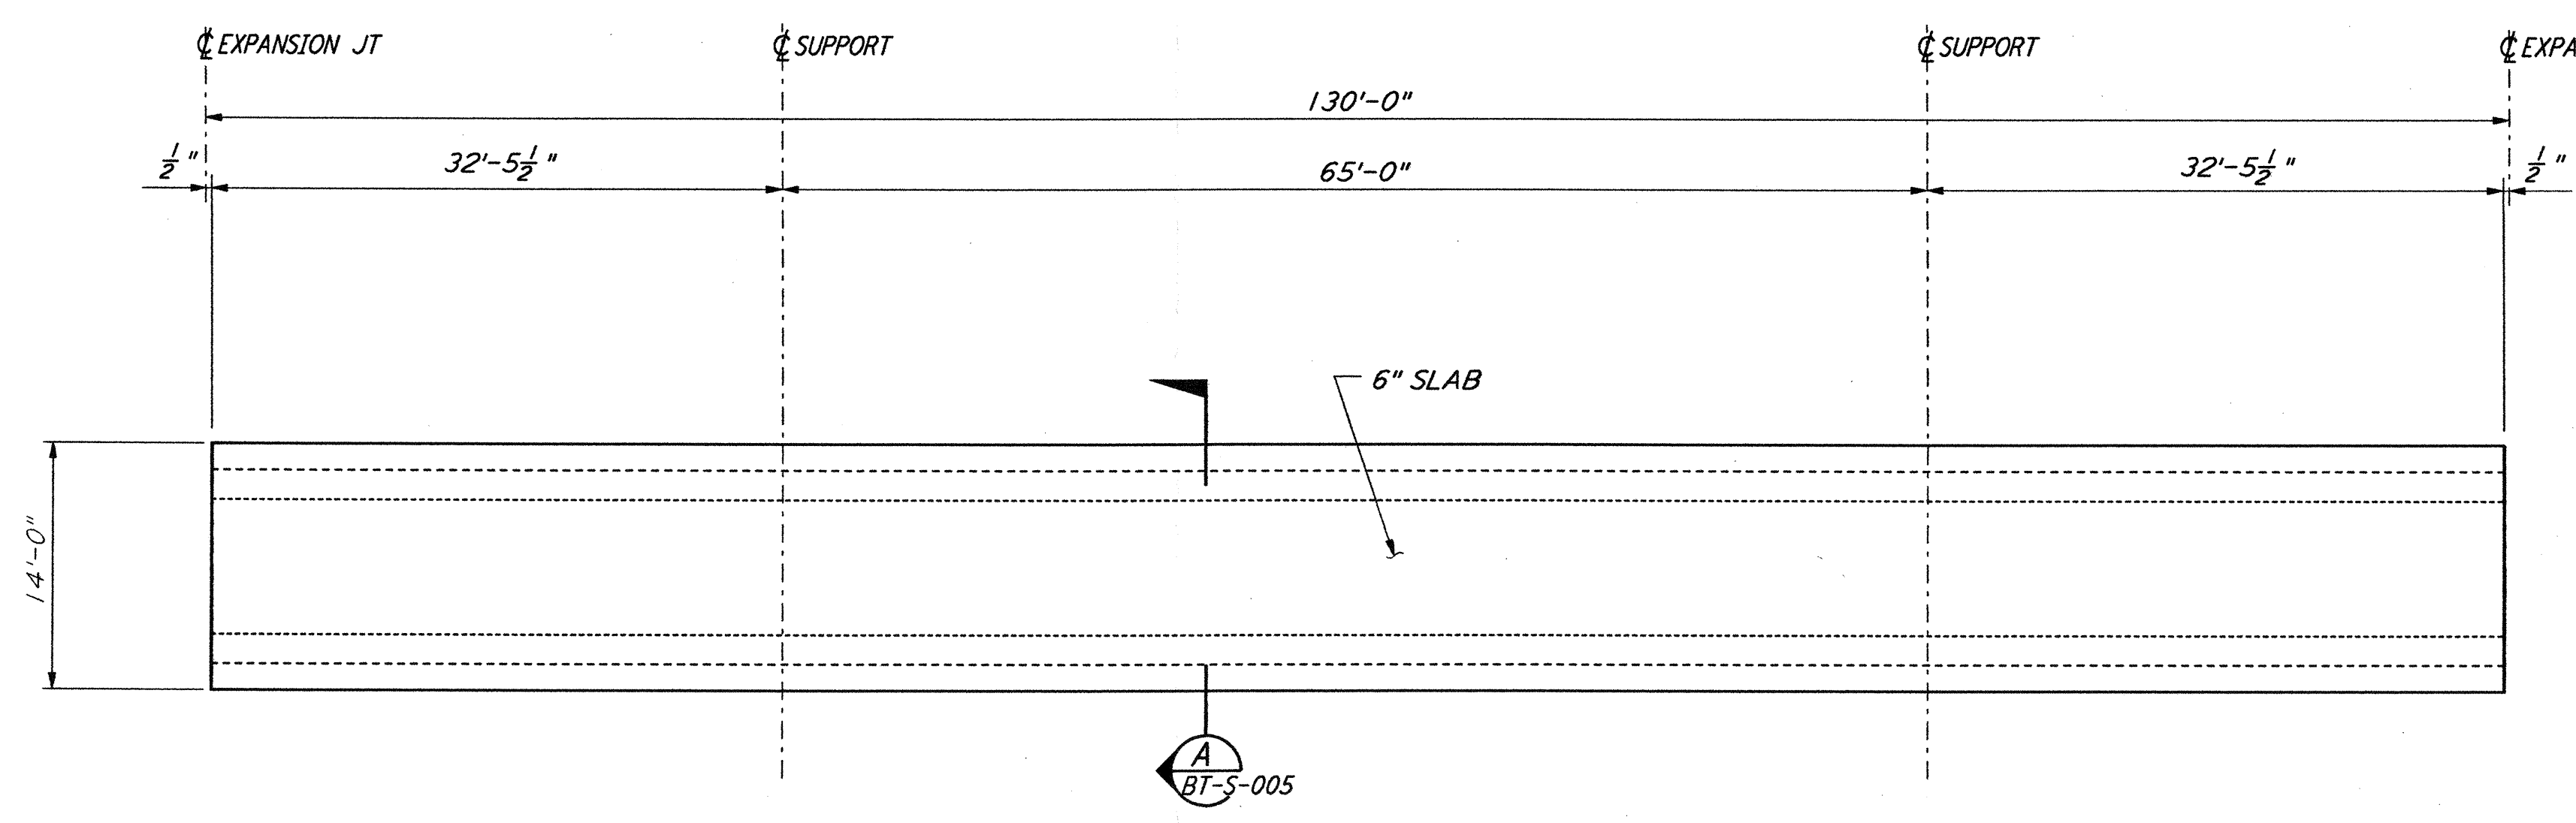


TYPICAL SLAB BETWEEN EXPANSION JOINTS

DETAIL 1 REF  
 $\frac{1}{8}'' = 1'-0''$  BT-S-006 BT-S-004

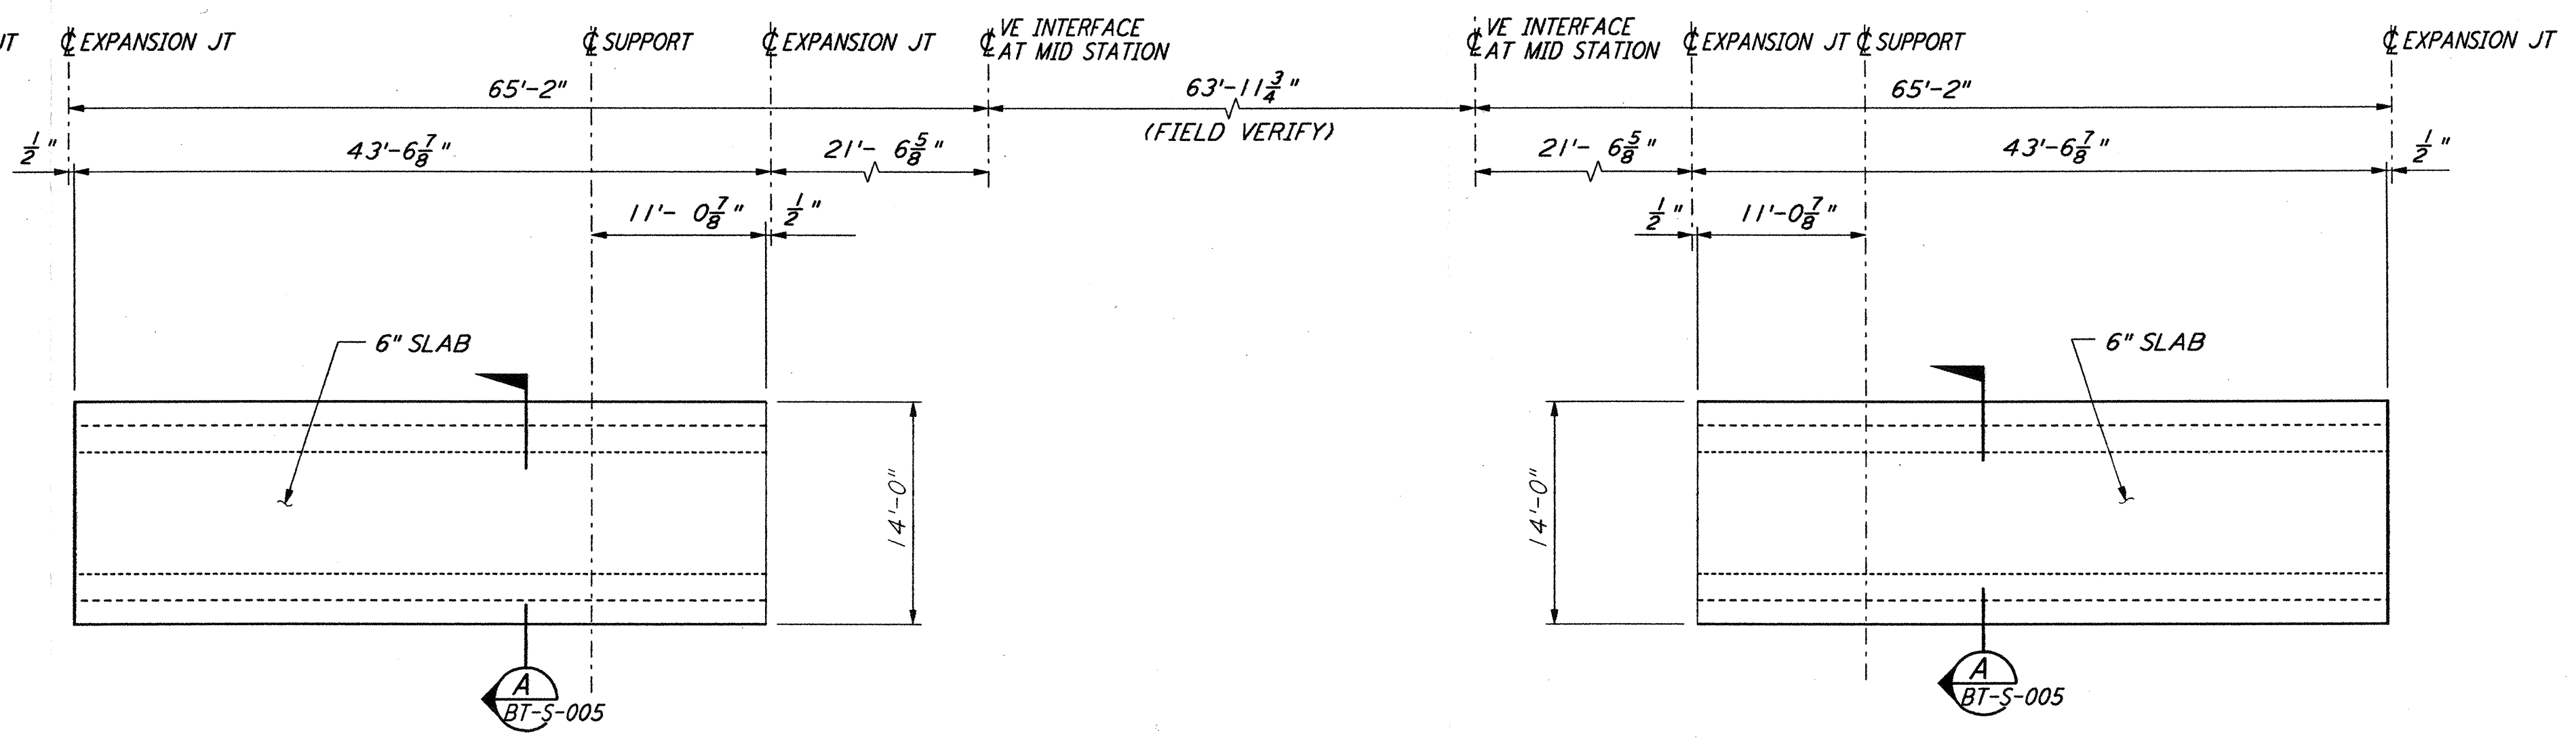


TYPICAL SLAB AT MID STATION

DETAIL 2 REF  
 $\frac{1}{8}'' = 1'-0''$  BT-S-006 BT-S-004 BT-S-005

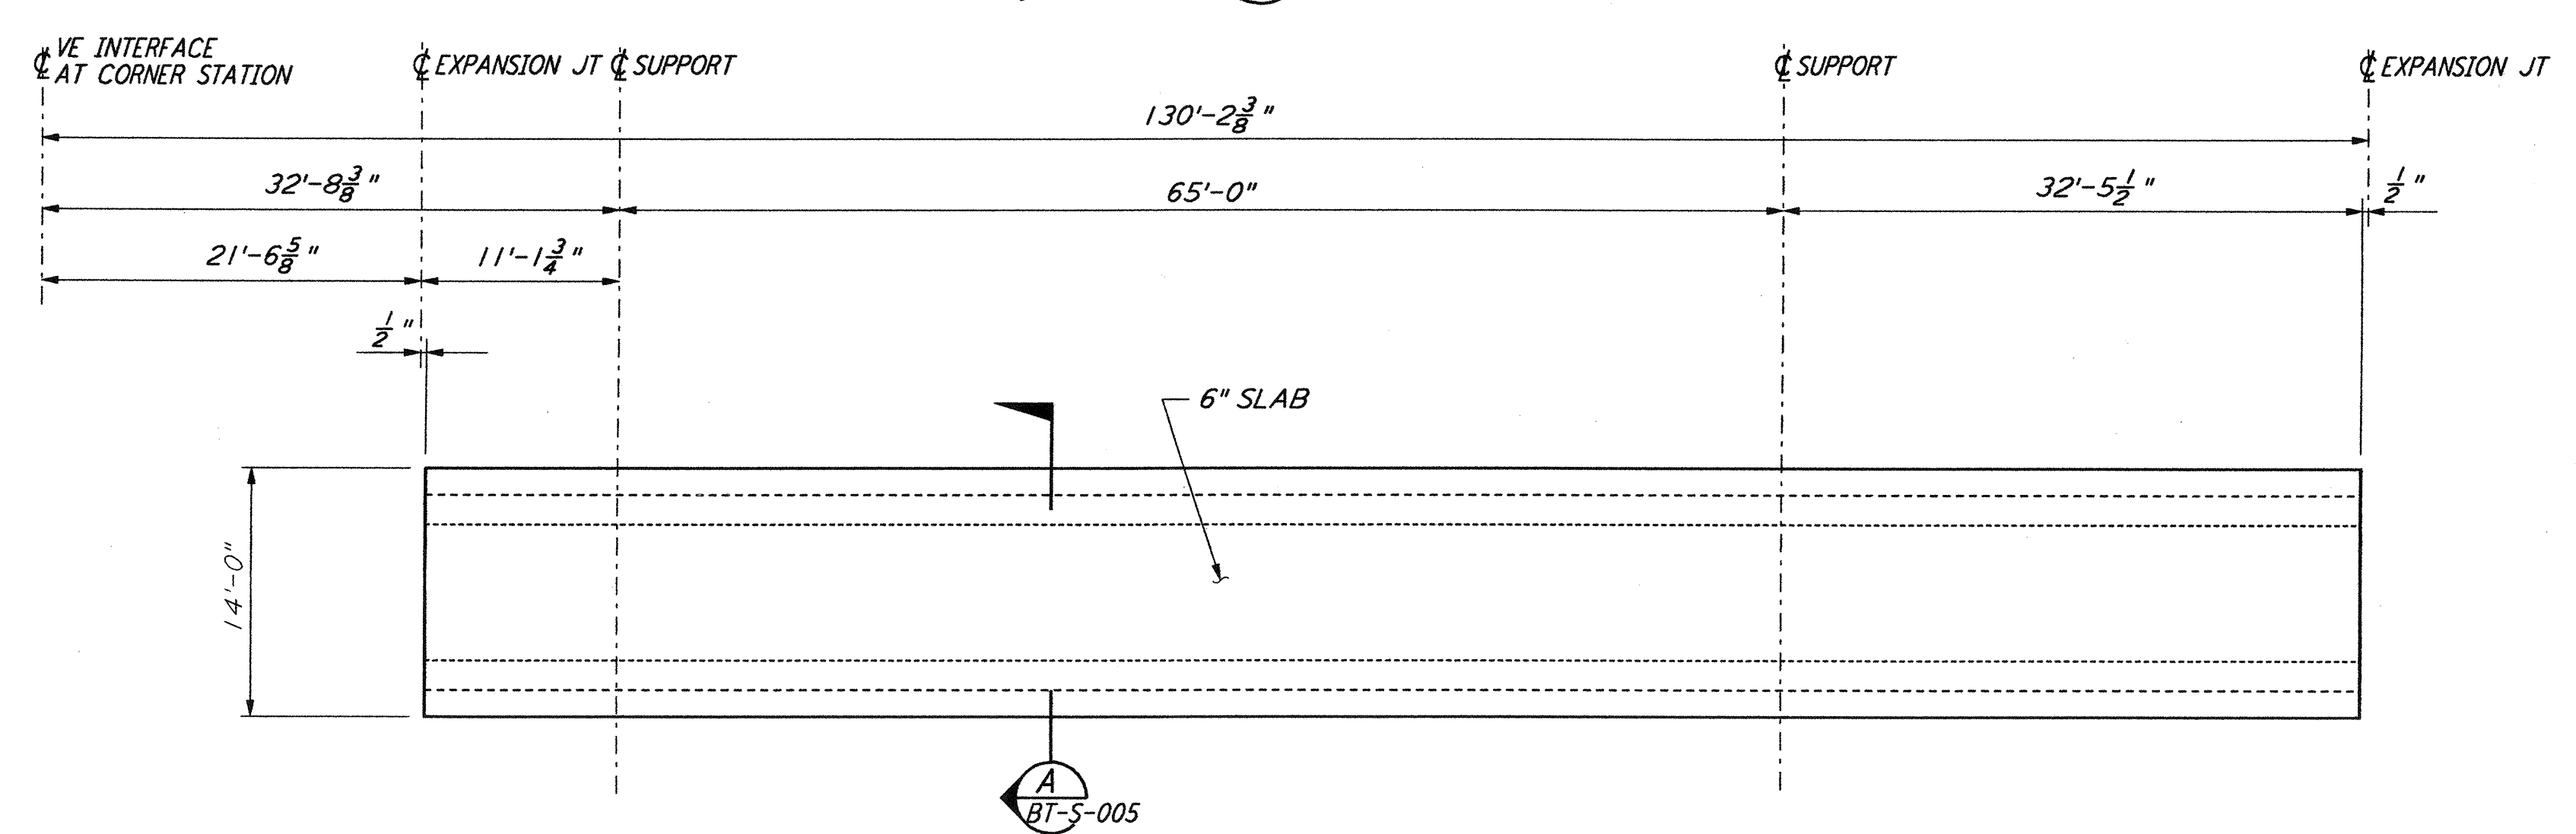


TYPICAL SLAB AT CORNER STATION

DETAIL 3 REF  
 $\frac{1}{8}'' = 1'-0''$  BT-S-006 BT-S-004 BT-S-005

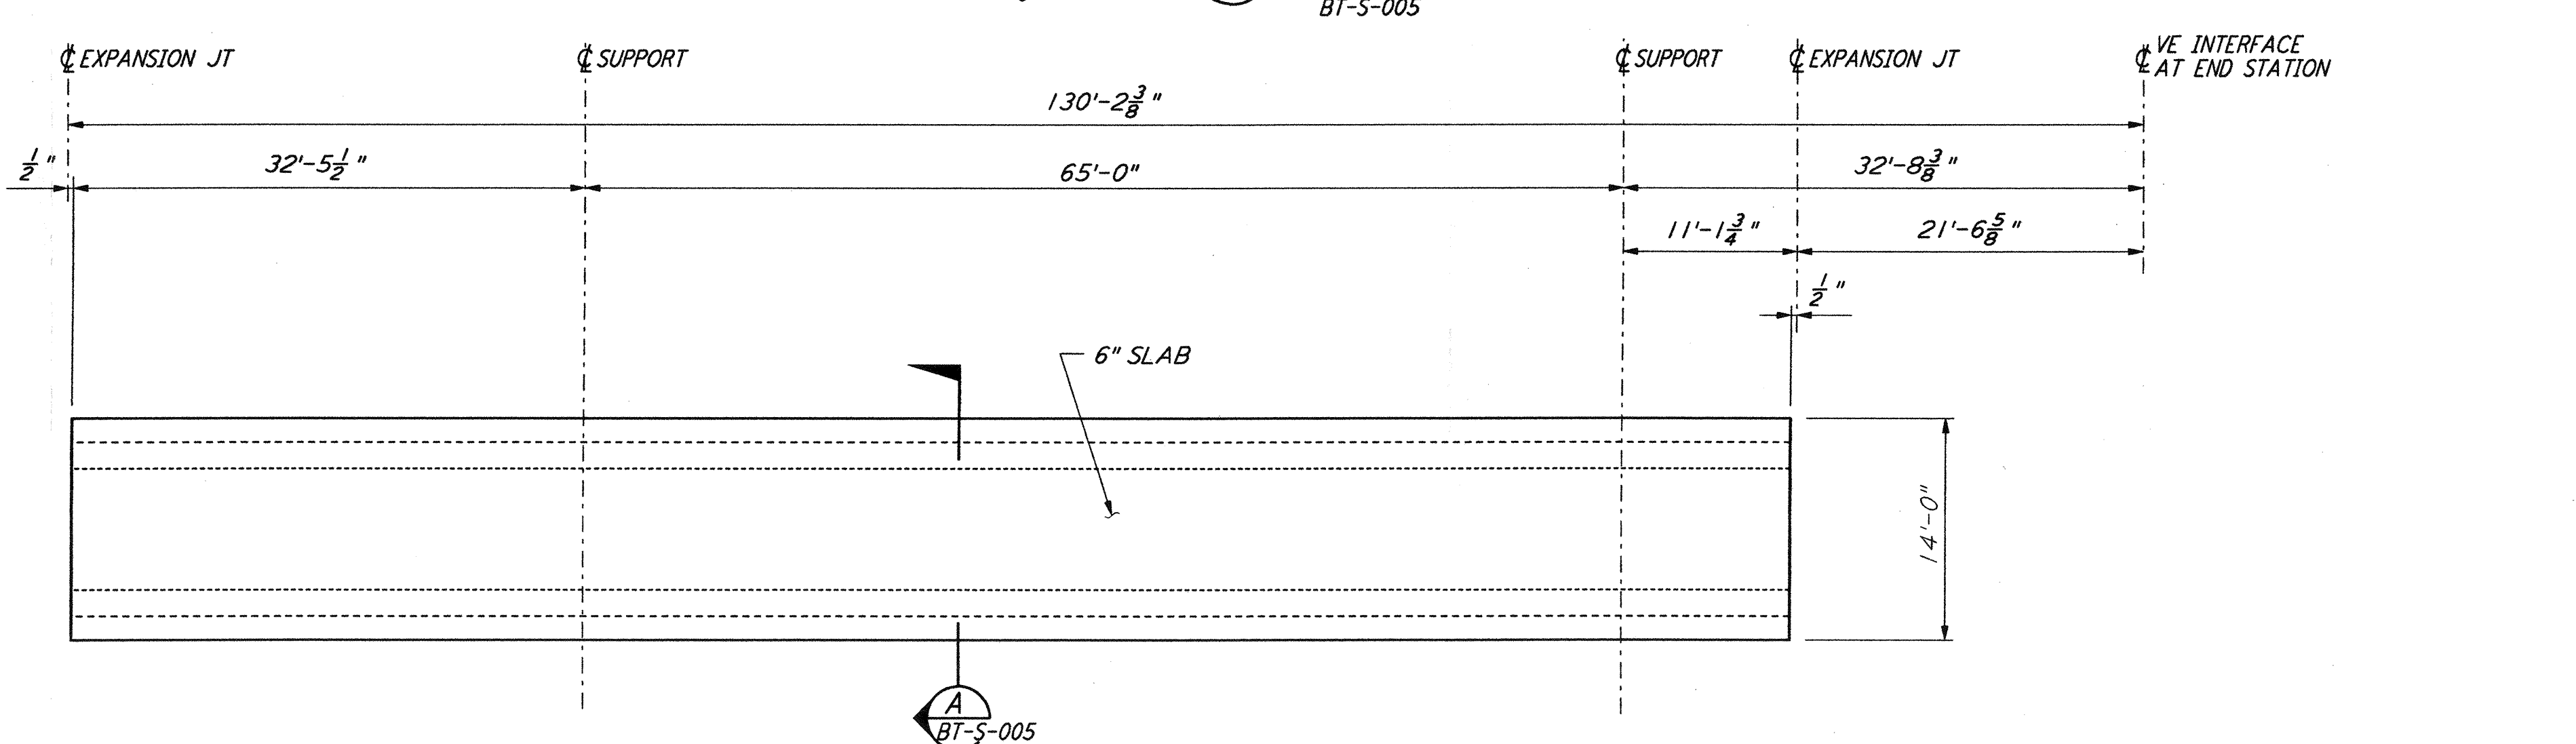


TYPICAL SLAB AT END STATION

DETAIL 4 REF  
 $\frac{1}{8}'' = 1'-0''$  BT-S-006 BT-S-004 BT-S-005

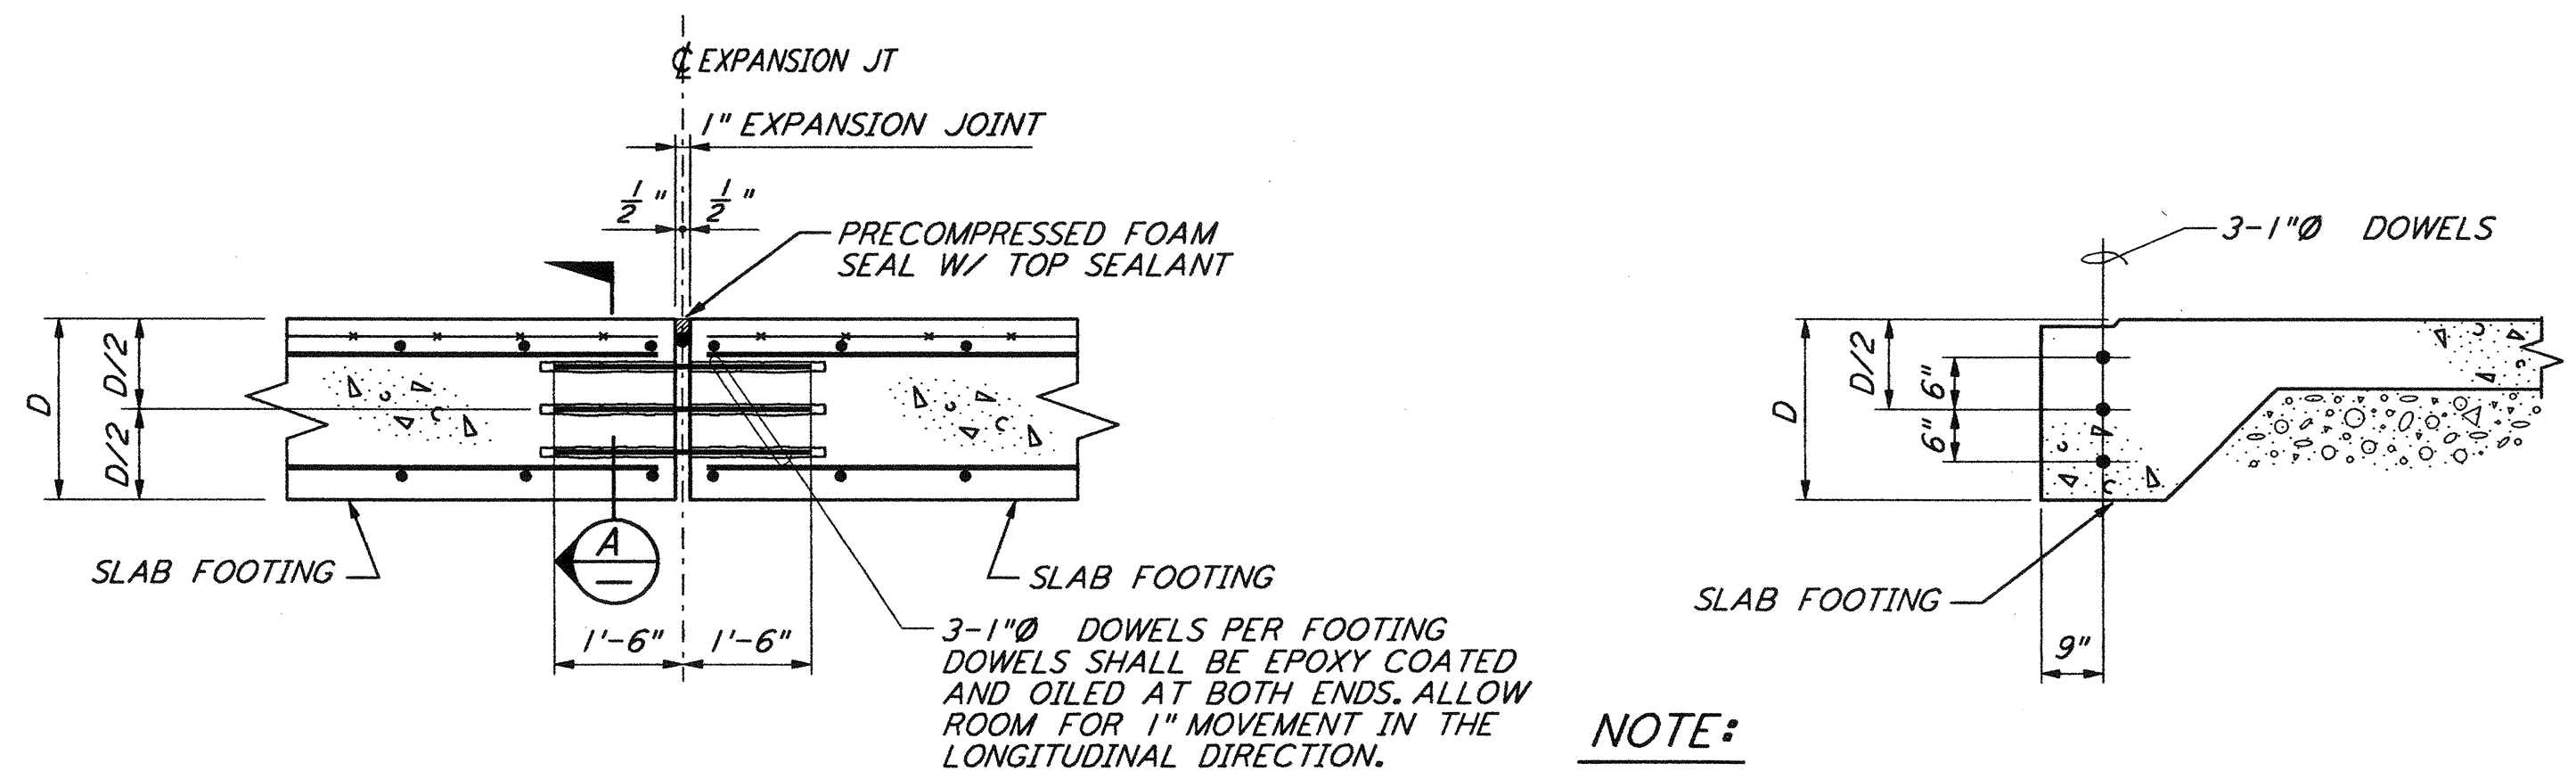


TYPICAL EXPANSION JOINT AT SLAB FOOTING

DETAIL 5 REF  
 $\frac{1}{2}'' = 1'-0''$  BT-S-006 BT-S-004

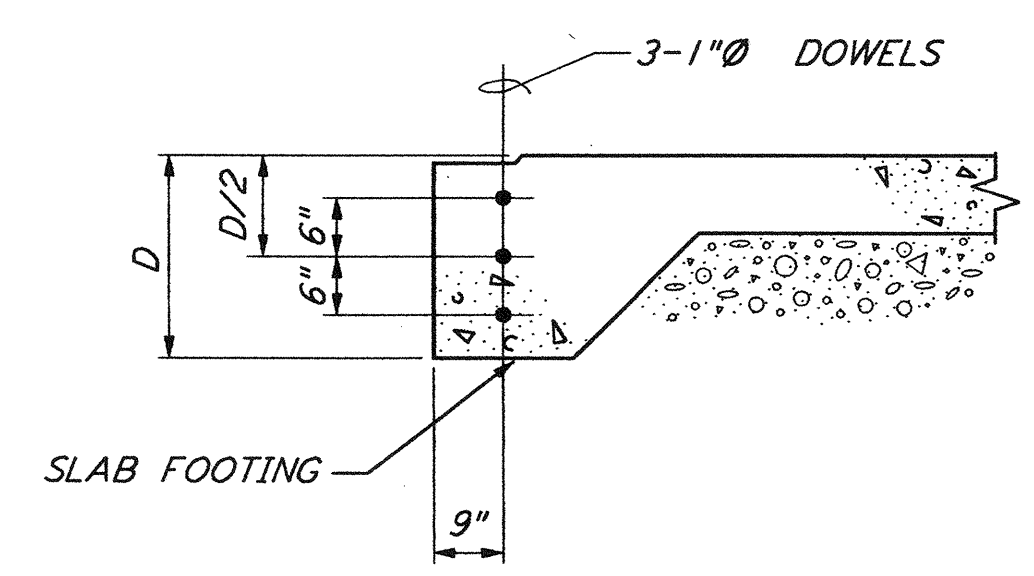


SECTION A REF  
 $\frac{1}{2}'' = 1'-0''$

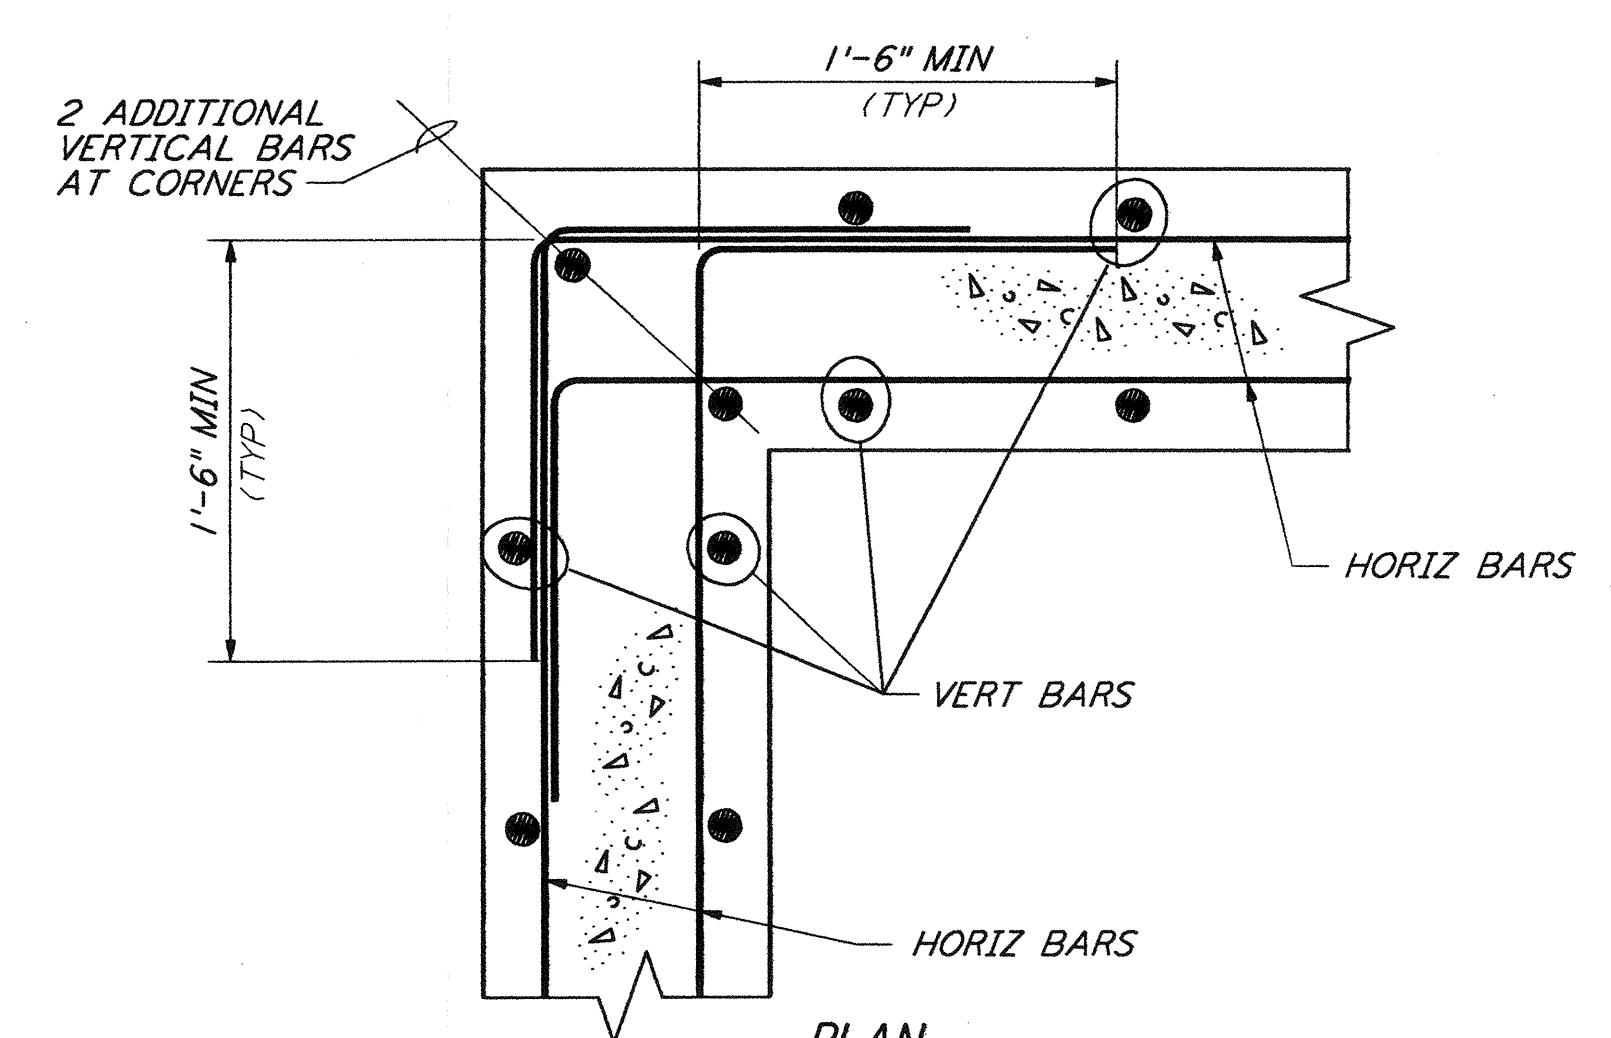

DETAIL 6 REF  
 $\frac{1}{2}'' = 1'-0''$  BT-S-006 BT-S-005

NOTE:  
 1. FOR GENERAL NOTES, ABBREVIATIONS AND LEGEND SEE DRAWING BT-S-001.

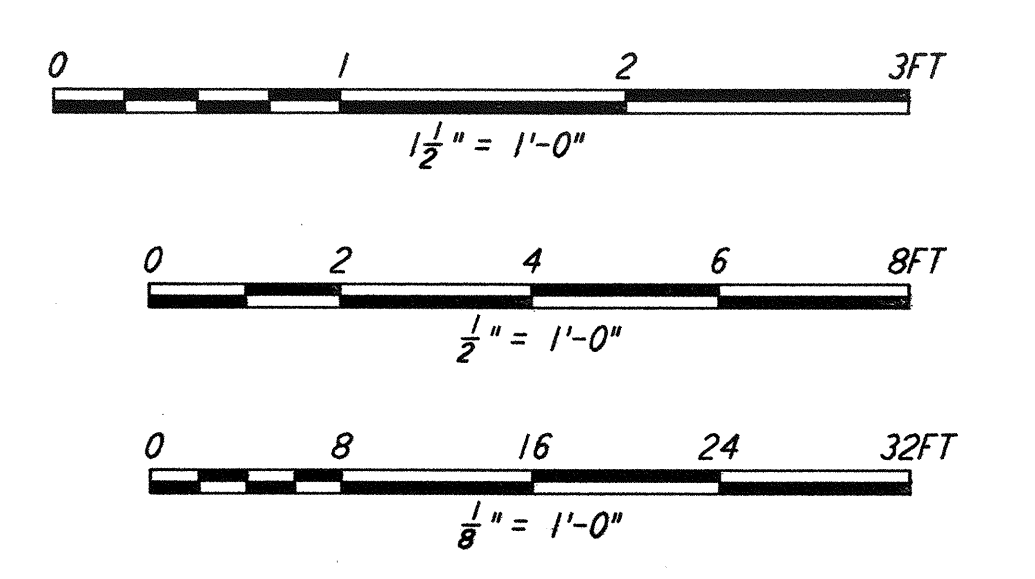

LIGO-D960192-01-0

DRAWING NO.	DESCRIPTION	NO.	DATE	BY	CHKD	ENGR	PROJ	DESCRIPTION
5		1	1-22-99	MEI	--	--	MOW	ISSUED FOR AS BUILT

ISSUED FOR CONSTRUCTION		
DRAWN	MCS	1-19-96
CHECKED	RM	1-19-96
ENGINEER	FD	1-19-96
PROJ	MW	1-19-96

**AS-BUILT DRAWINGS**

**PARSONS**  
 100 WEST WALNUT STREET  
 PASADENA, CALIFORNIA

**LIGO**  
 CALIFORNIA INSTITUTE OF TECHNOLOGY  
 MASSACHUSETTS INSTITUTE OF TECHNOLOGY

LASER INTERFEROMETER  
 GRAVITATIONAL-WAVE OBSERVATORY  
 BTE SITWORK & FABRICATION - HANFORD, WA

TITLE: STRUCTURAL BEAM TUBE ENCLOSURE SECTIONS & DETAILS SHEET 2

AS NOTED PPI50969 8094

**BT-S-006**