
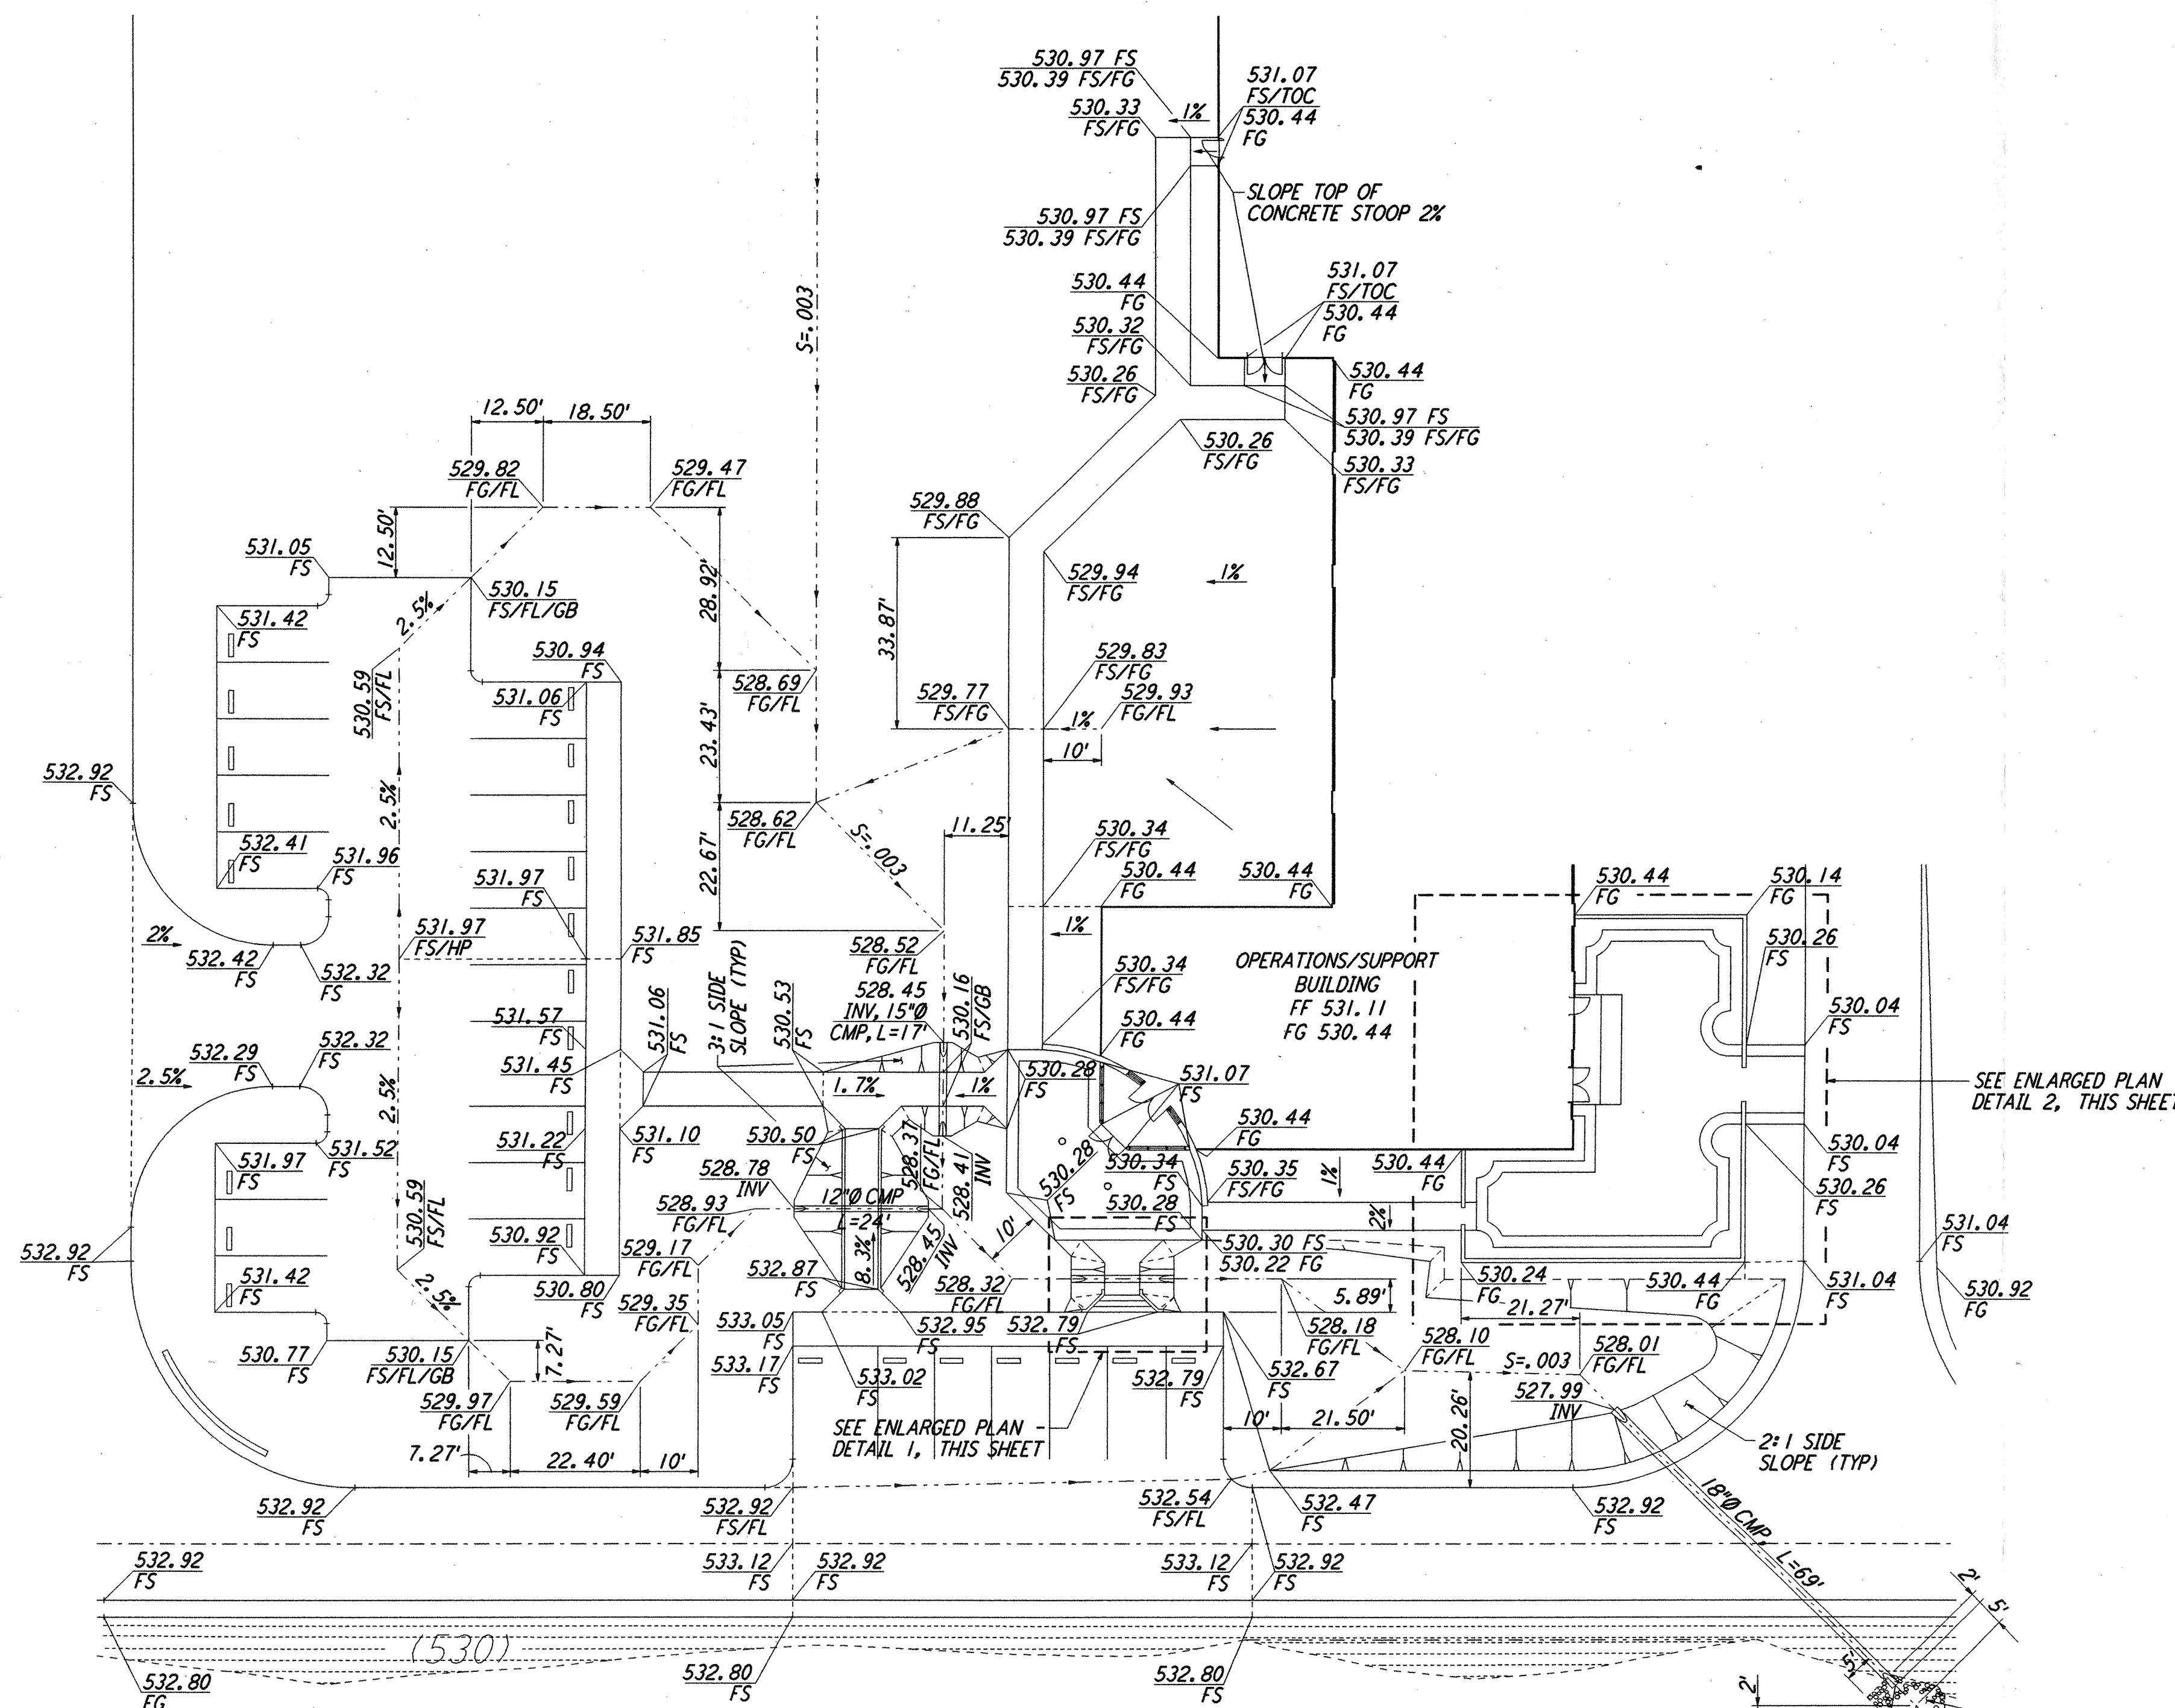



NOTES:

1. SEE SHEET WA-C-002 FOR GENERAL NOTES, LEGEND AND ABBREVIATIONS.

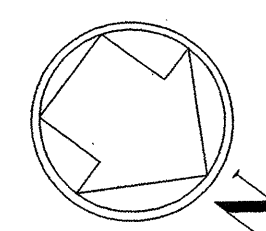


ENLARGED AREA - BUILDING ENTRANCE

SCALE: 1" = 20'

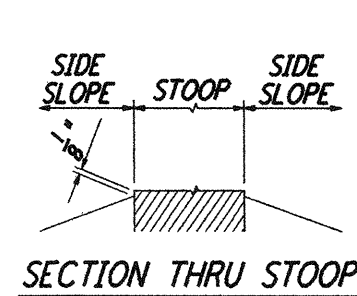


OPERATIONS/SUPPORT BUILDING FF 531.11

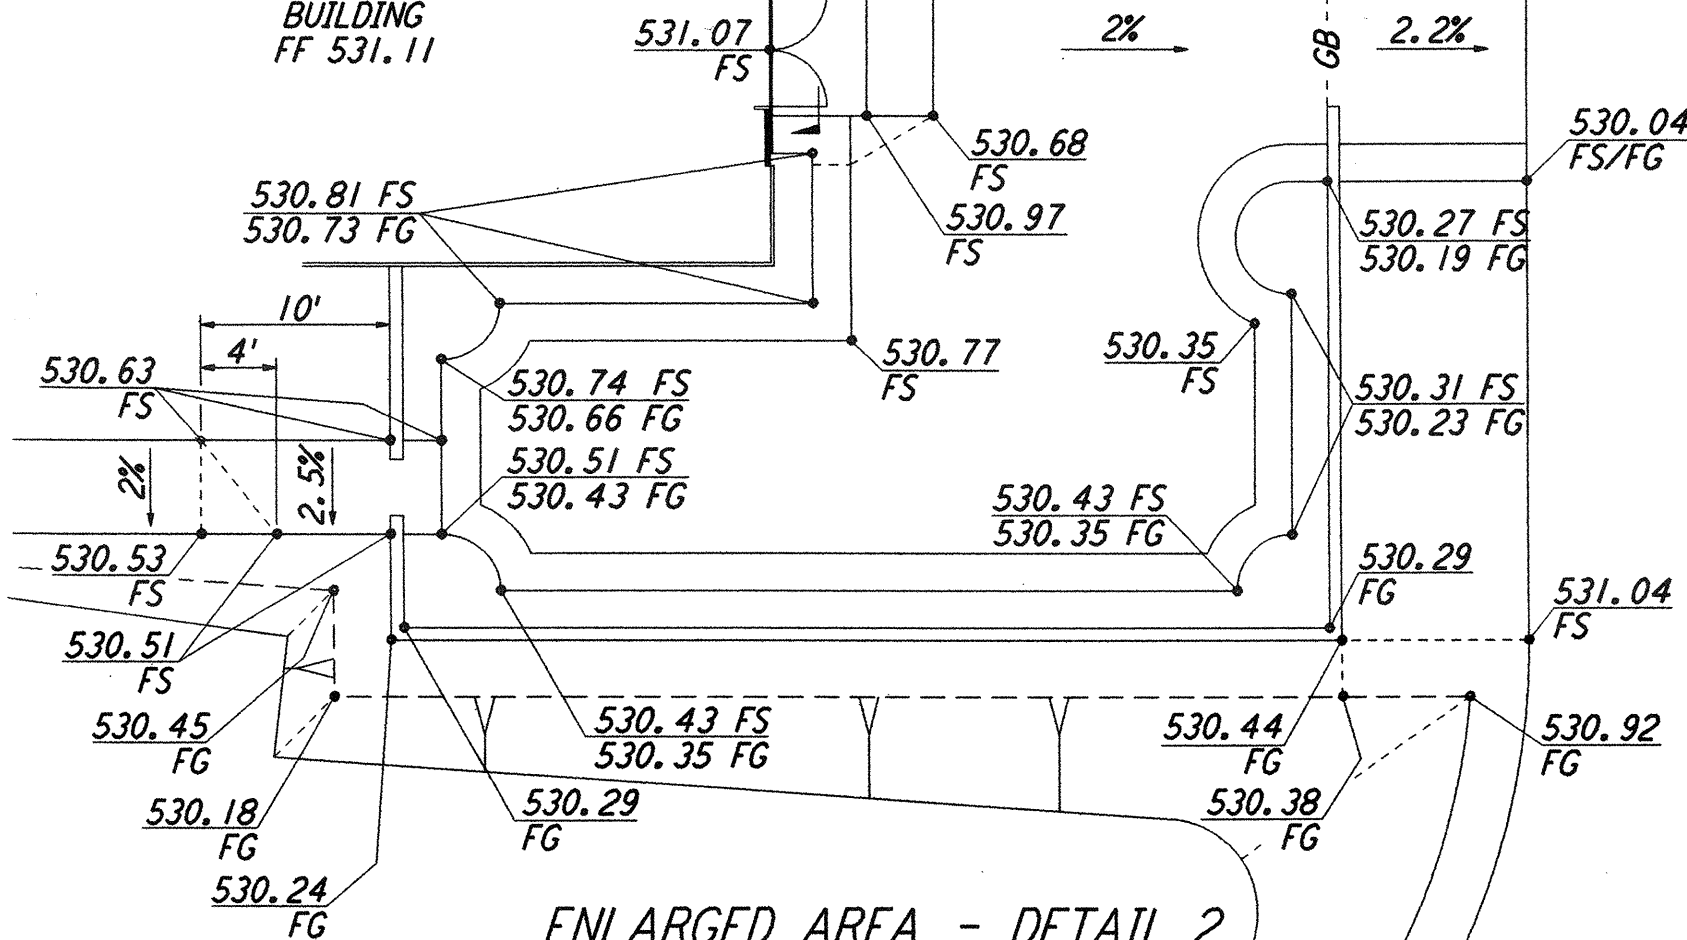


ENLARGED AREA - DETAIL 2

SCALE: 1" = 10'

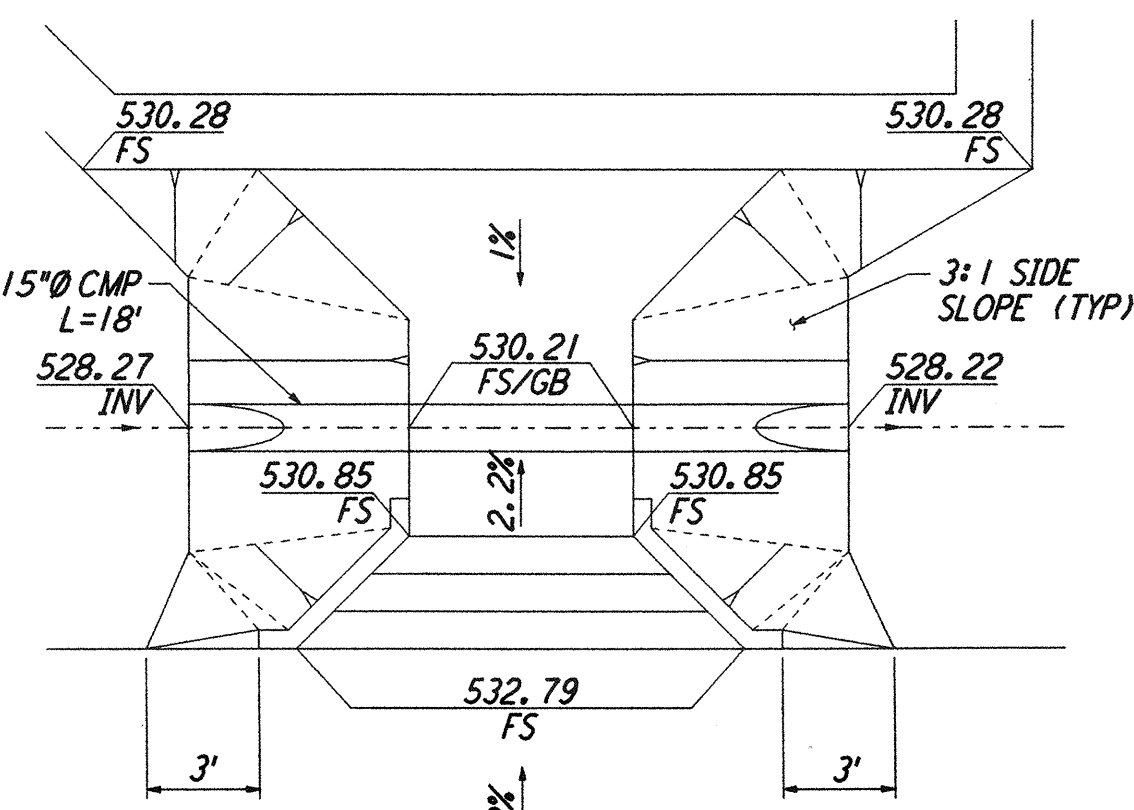



ENLARGED AREA - DETAIL 1

SCALE: 1" = 5'

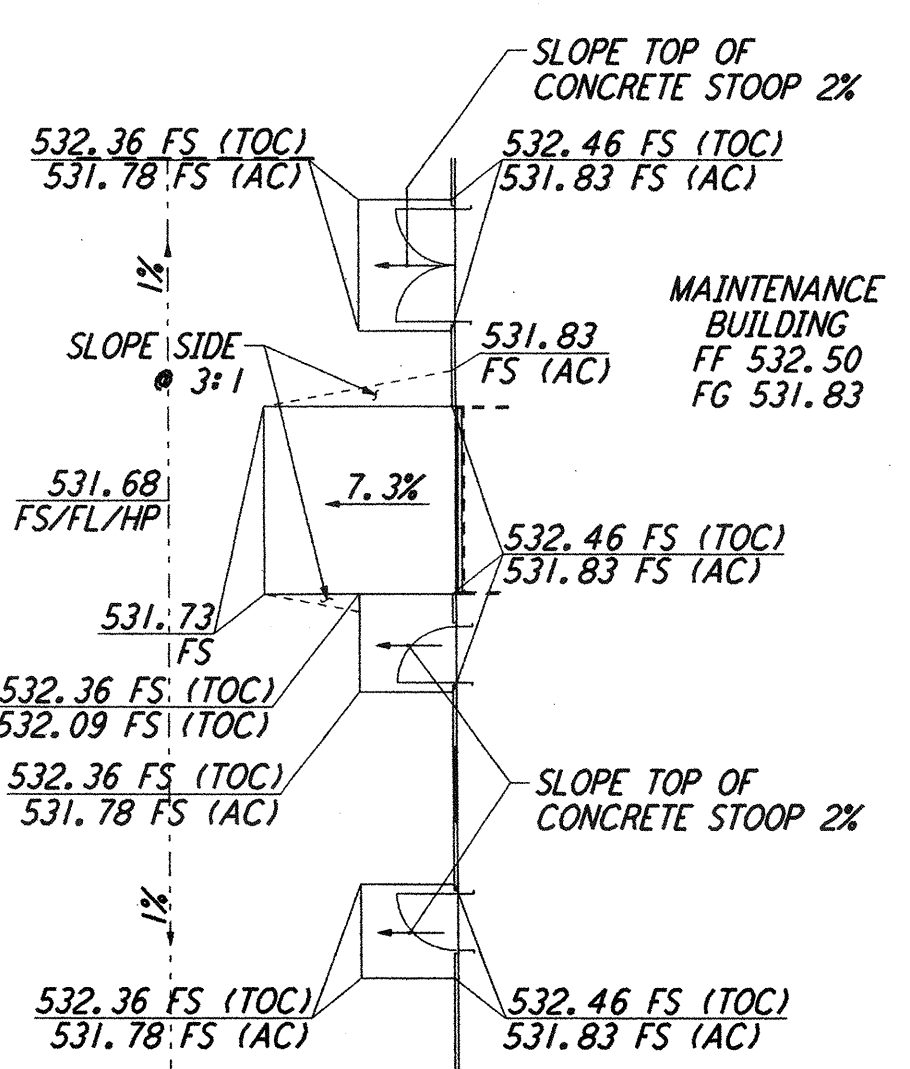


ENLARGED AREA - DETAIL 3

SCALE: 1" = 10'

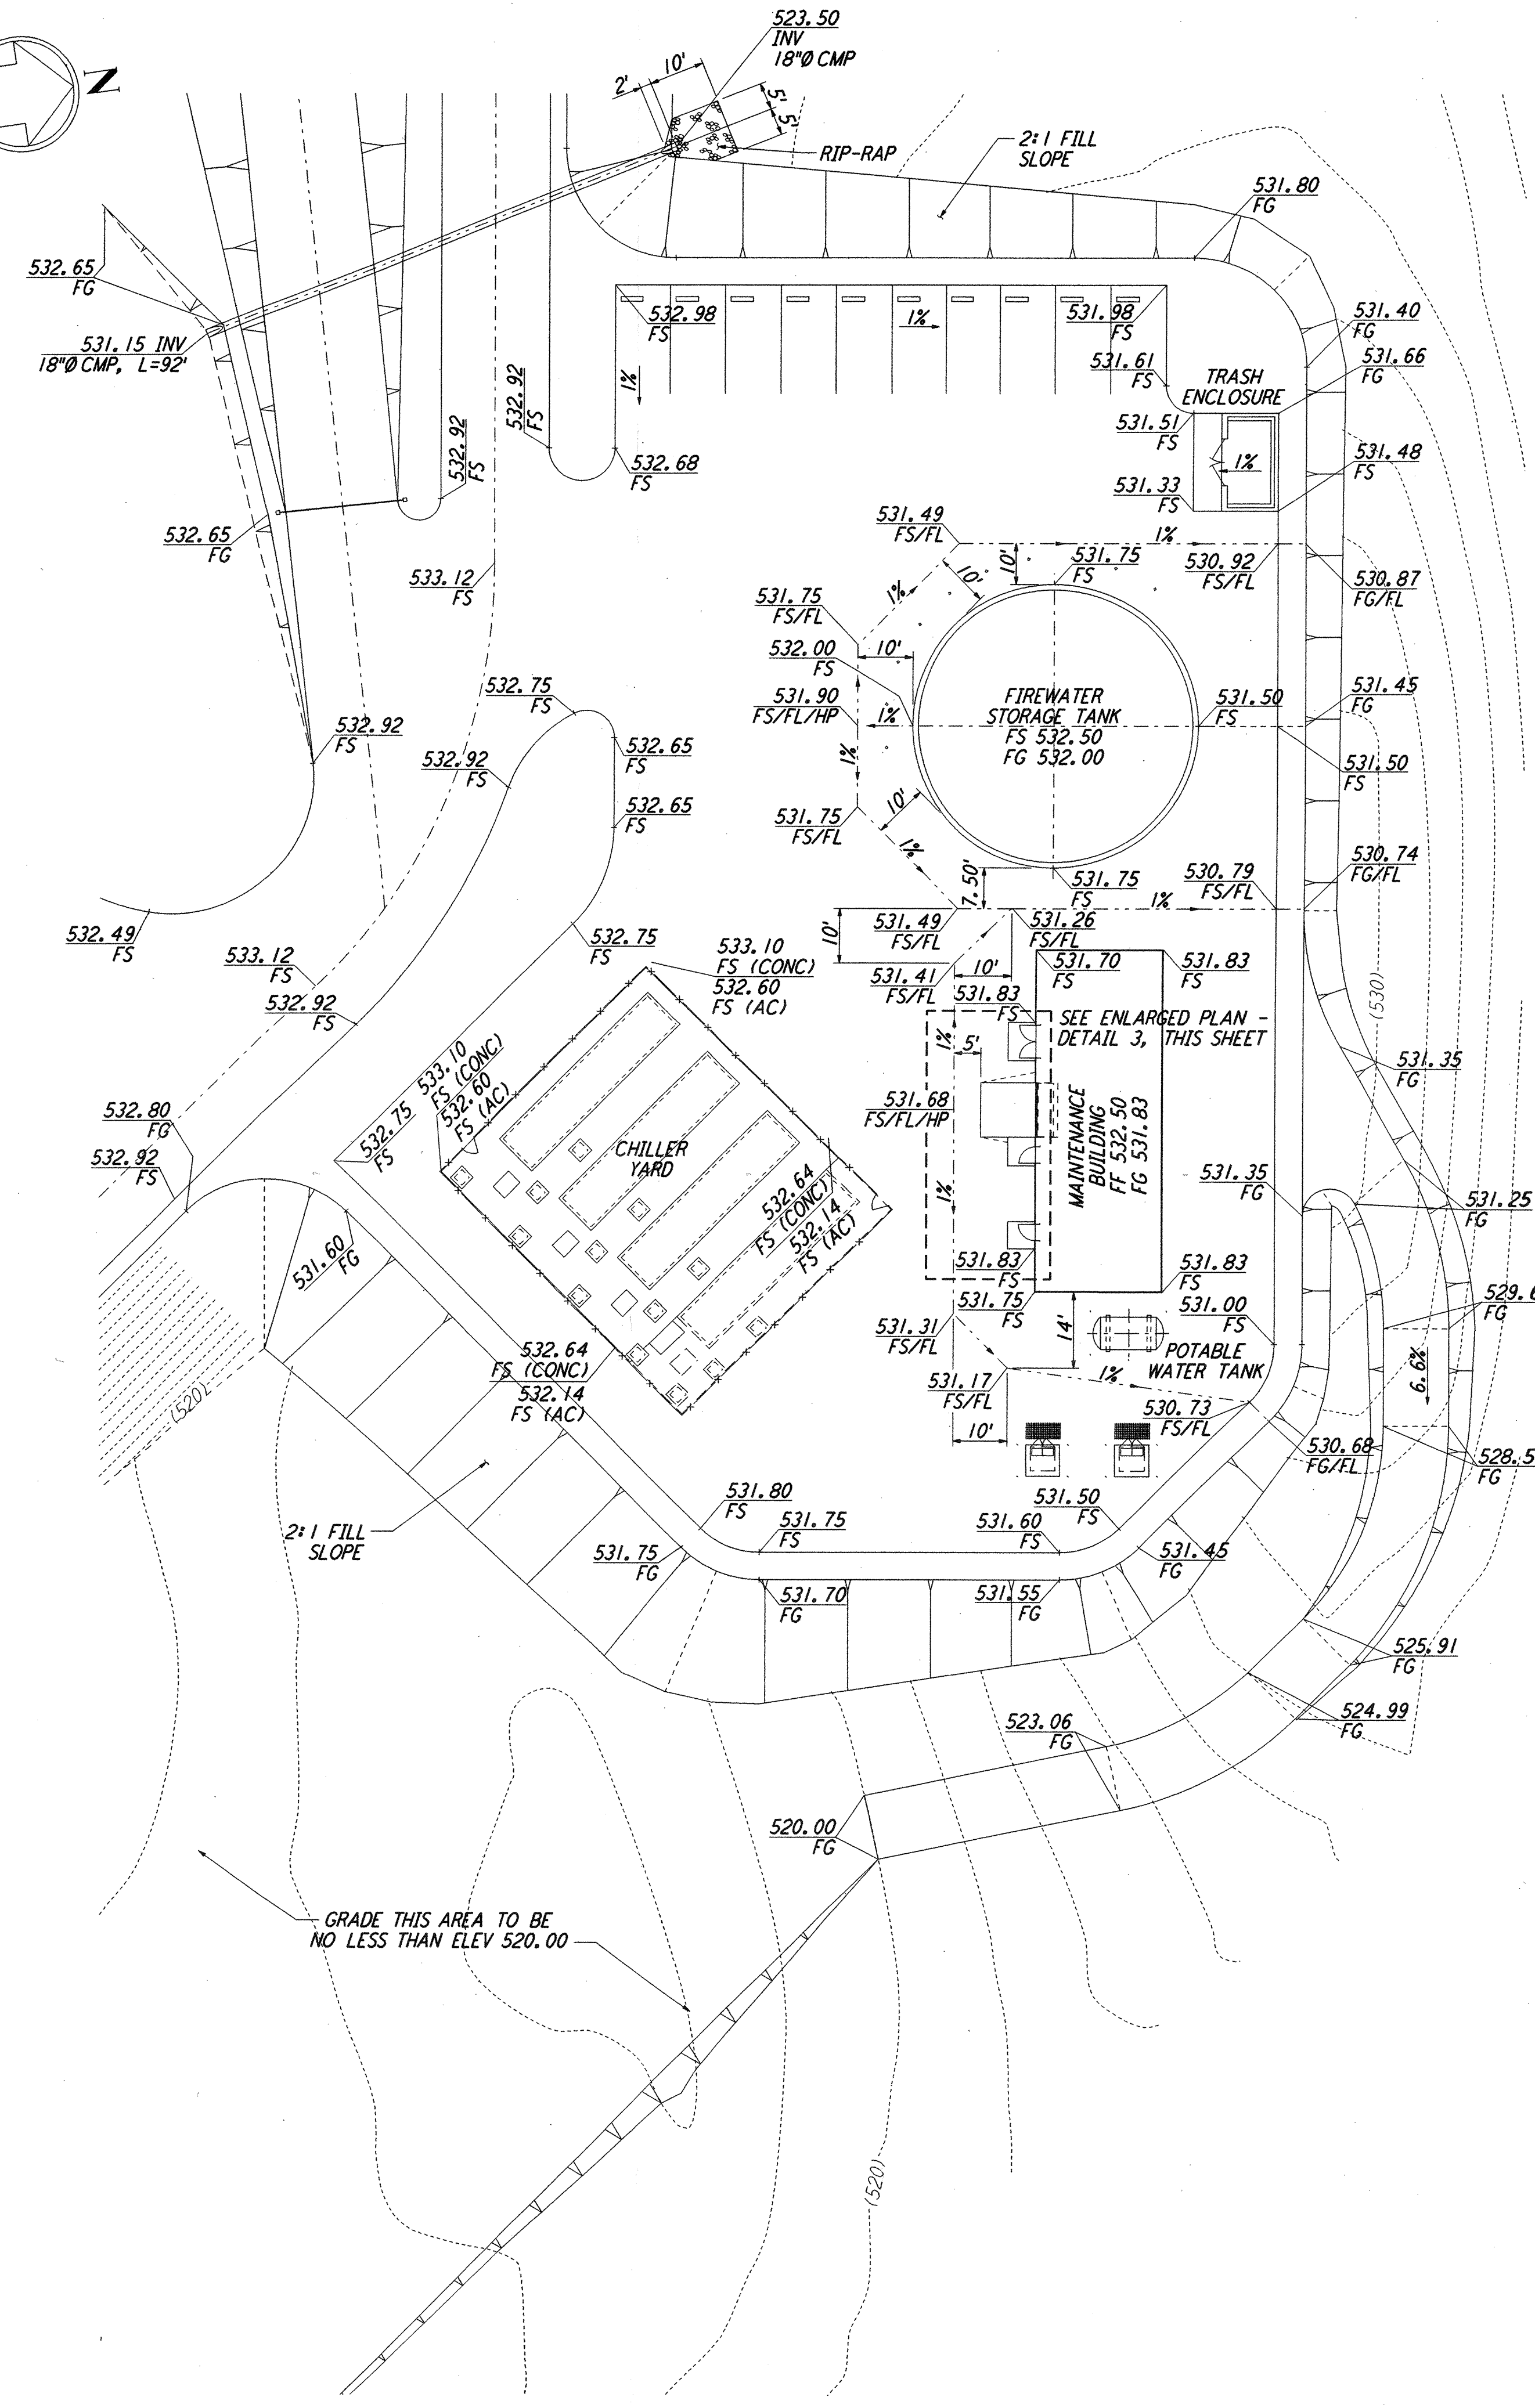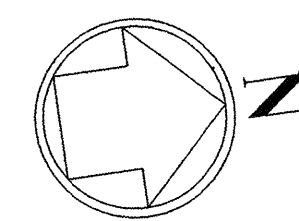

ENLARGED AREA - MAINTENANCE YARD

SCALE: 1" = 20'

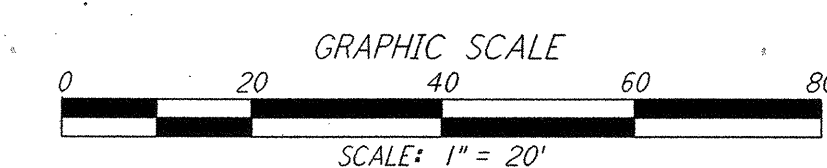

LIGO-D960201-02-O

This document and the design it covers are the property of PARSONS. They are loaned only with the understanding that they are not to be reproduced, copied, loaned, exhibited, or used in any other way, except by written consent from PARSONS to the borrower.

NO.	DATE	BY	CHKD	ENGR	PROJ	DESCRIPTION
2	5/15/98	WRB	ML	JB	MDW	ISSUED FOR AS-BUILT
1	2-28-97	WRB	ML	JB	MDW	ADDED WALK/WALL OPENING, REVISED GRADING

FOR CONSTRUCTION			
DRAWN	WRB	9/28/95	
CHECKED	ML	7/9/96	
ENGINEER	JB	7/9/96	
PROJ	MDW	7/9/96	

AS-BUILT DRAWINGS



100 WEST WALNUT STREET
PASADENA, CALIFORNIA



CALIFORNIA INSTITUTE OF TECHNOLOGY
MASSACHUSETTS INSTITUTE OF TECHNOLOGY

LASER INTERFEROMETER GRAVITATIONAL-WAVE OBSERVATORY SITE NO. 1 - HANFORD, WASHINGTON			
TITLE	SCALE	CONTRACT NUMBER	PROJECT NUMBER
CIVIL CORNER STATION GRADING PLAN ENLARGED PLANS	AS NOTED	PP150969	8094
SHEET NUMBER WA-C-008			REVISIONS