

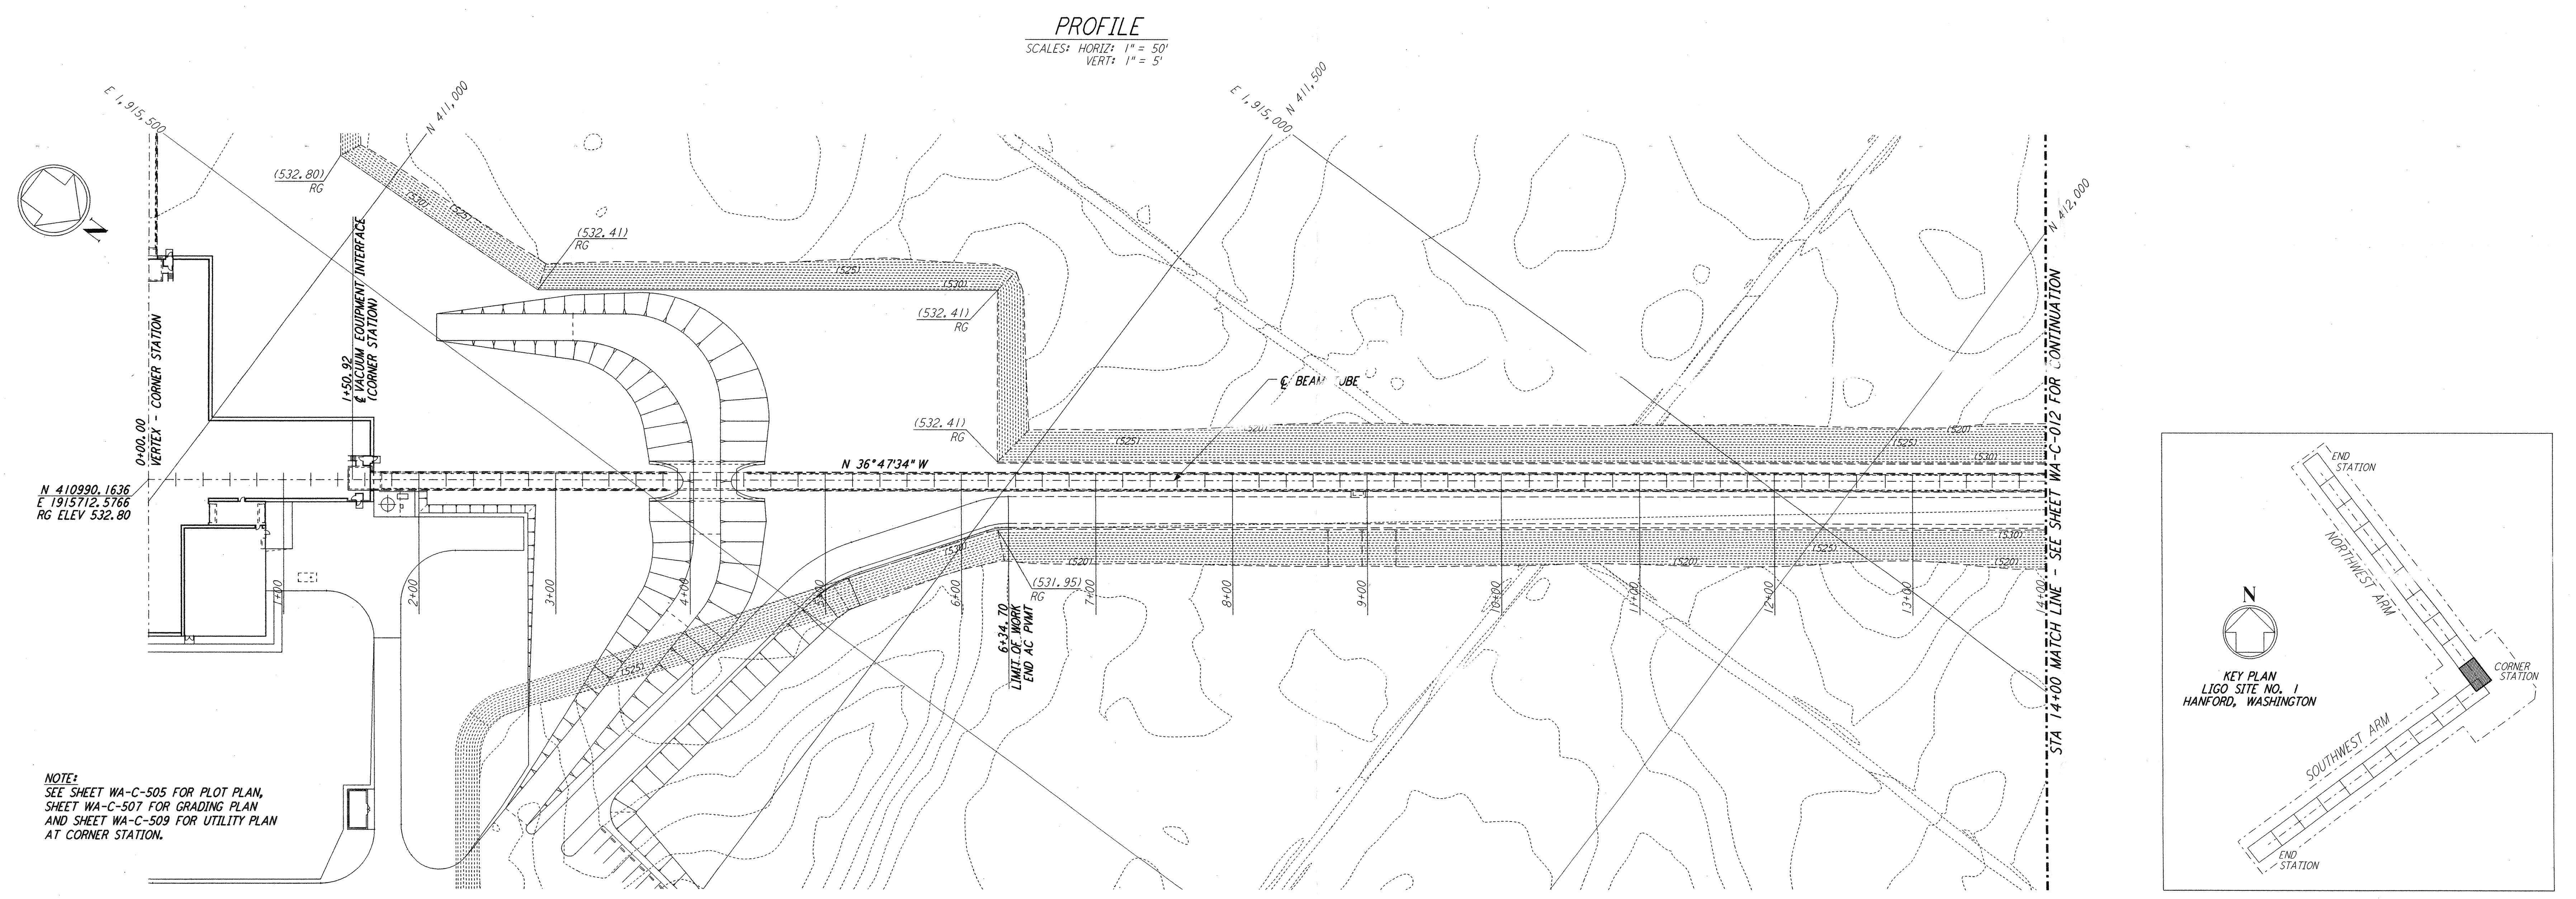


This document and the design it covers are the property of **PARSONS**. They are loaned only with the borrower's expressed written agreement that they will not be reproduced, copied, loaned, exhibited, or used in any other way, except by written consent from **PARSONS** to the borrower.

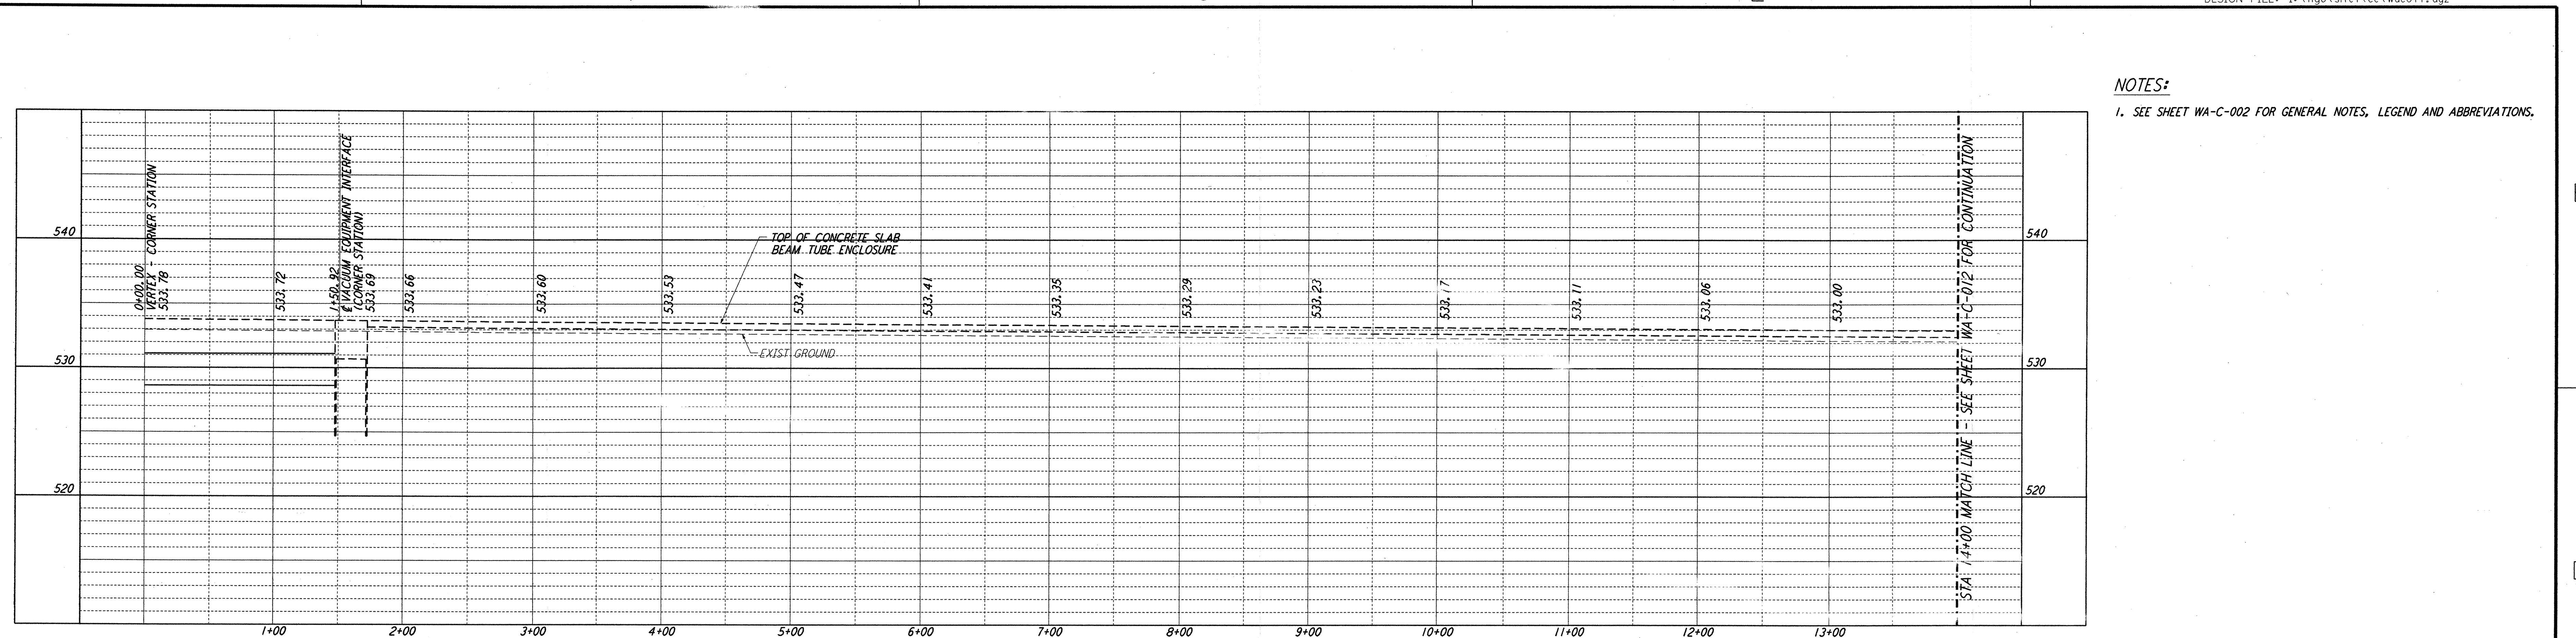

LIGO-D960202-01-O

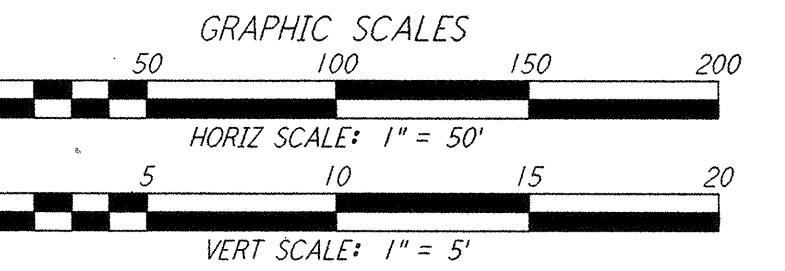


REFERENCES		REVISIOnS		FOR CONSTRUCTION			
DRAWING NO.	DESCRIPTION	NO.	DATE	DRAWN	WRB	CHECKED	ML
1	5/15/98	WRB	CB	GB	9/28/95		
						7/9/96	
						JB	7/9/96
						MDW	7/9/96

AS-BUILT DRAWINGS

ISSUED FOR AS-BUILT

DESCRIPTION

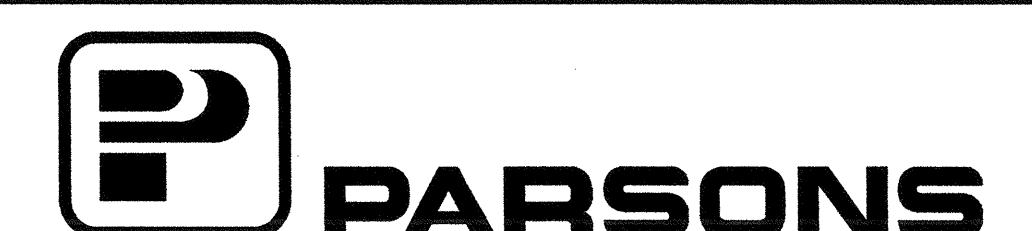

100 WEST WALNUT STREET
PASADENA, CALIFORNIA



CALIFORNIA INSTITUTE OF TECHNOLOGY
MASSACHUSETTS INSTITUTE OF TECHNOLOGY

TITLE	SCALE	CONTRACT NUMBER	PROJECT NUMBER
CIVIL NORTHWEST ARM PLAN AND PROFILE STA 0+00 TO STA 14+00	AS NOTED	PP150969	8094
SHEET NUMBER			
WA-C-011			