


This document and the design it covers are the property of PARSONS. They are loaned only with the borrower's expressed written agreement that they will not be reproduced, copied, loaned, exhibited, or used in any other way, except by written consent from PARSONS to the borrower.



This document and the design it covers are the property of PARSONS. They are loaned only with the borrower's expressed written agreement that they will not be reproduced, copied, loaned, exhibited, or used in any other way, except by written consent from PARSONS to the borrower.

**NOTES:**  
 1. SEE SHEET WA-C-002 FOR GENERAL NOTES, LEGEND AND ABBREVIATIONS.

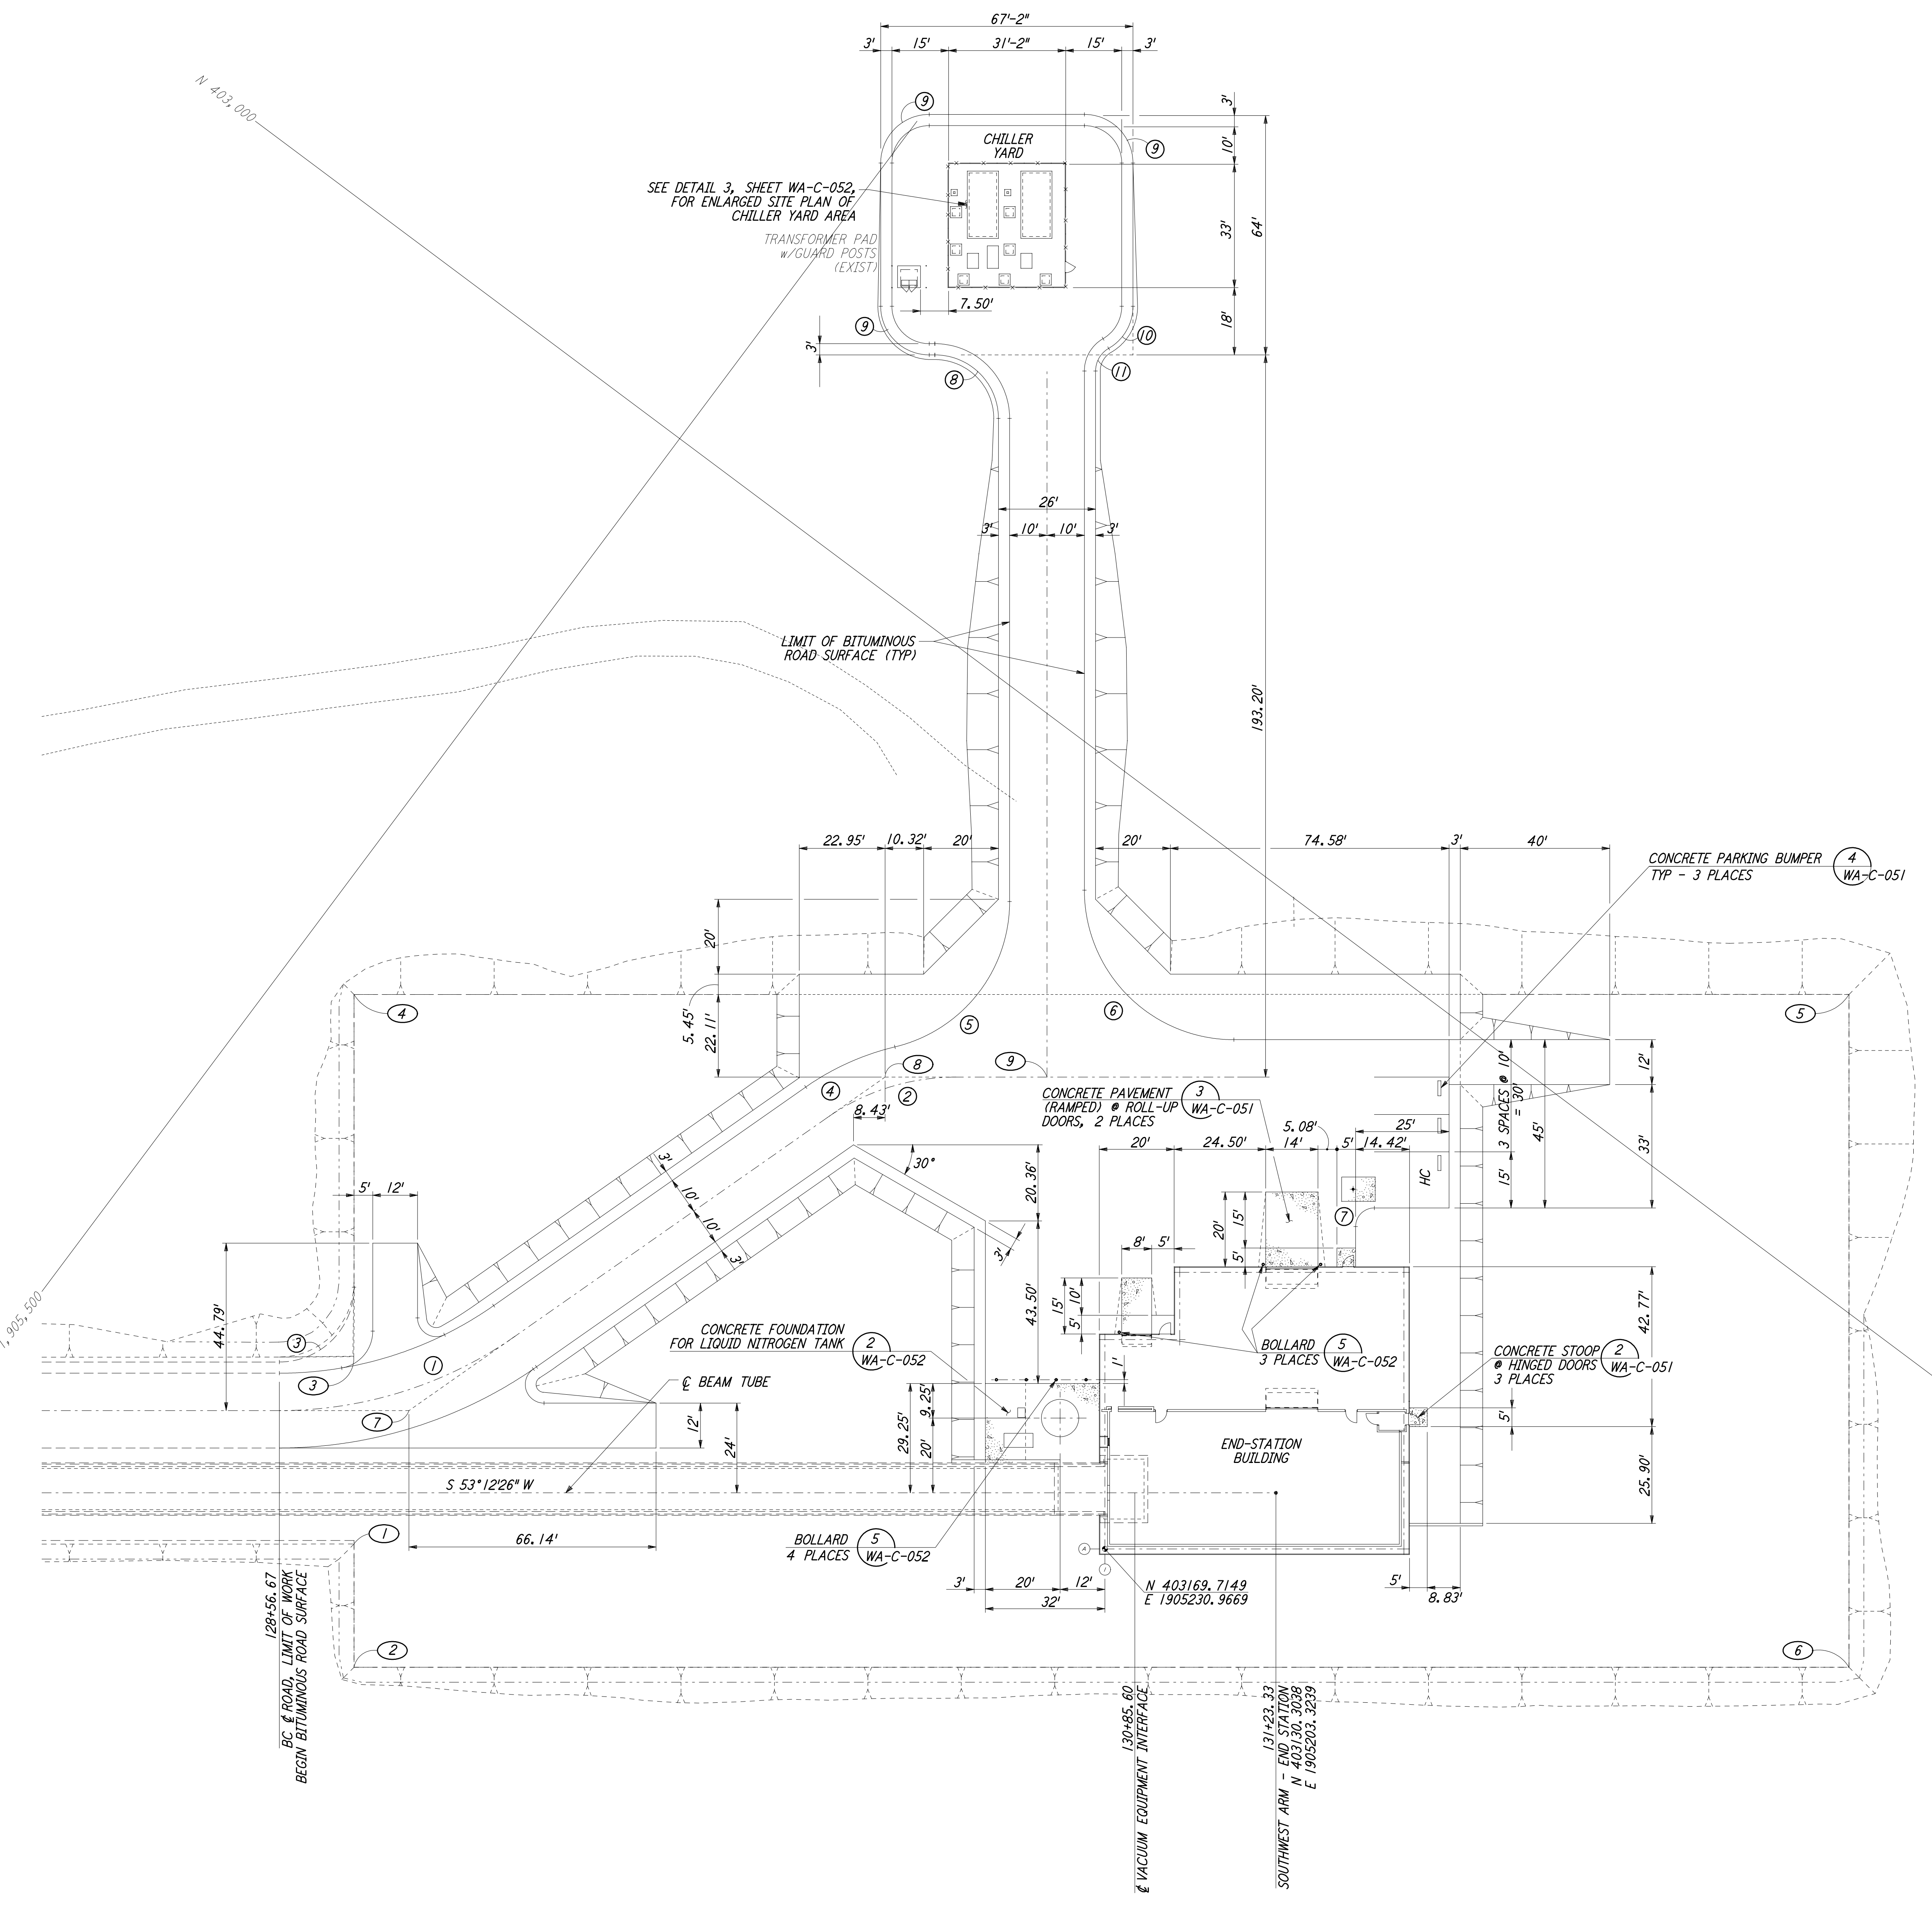

CURVE DATA					
Curve No.	Δ	RADIUS	LENGTH	TANGENT	REMARK
1	35°00'00"	110'	67.19'	34.68'	℄ ROAD
2	35°00'00"	60'	36.65'	18.92'	℄ ROAD
3	90°00'00"	20'	31.42'	20.00'	EDGE OF PAD (EXIST)
4	21°32'41"	70'	26.32'	13.32'	
5	76°32'48"	40'	53.44'	31.56'	
6	90°00'00"	40'	62.83'	40.00'	
7	90°00'00"	5'	7.85'	5.00'	
8	90°00'00"	17'	26.70'	17.00'	
9	90°00'00"	13'	20.42'	13.00'	
10	60°00'00"	13'	13.61'	7.51'	
11	60°00'00"	7'	7.33'	4.04'	

COORDINATES			
Point No.	NORTH	EAST	REMARK
1	403288.9810	1905392.6680	PI EDGE OF PAD (EXIST)
2	403315.4070	1905372.9040	PI EDGE OF PAD (EXIST)
3	403248.9398	1905422.6147	PI EDGE OF PAD (EXIST)
4	403171.2620	1905480.7100	PI EDGE OF PAD (EXIST)
5	402931.6922	1905160.3876	PI EDGE OF PAD (EXIST)
6	403075.8373	1905052.5815	PI EDGE OF PAD (EXIST)
7	403251.6246	1905402.2720	PI ℄ ROAD
8	403103.8631	1905353.6693	PI ℄ ROAD
9	403077.9173	1905318.9776	℄ ROAD INTERSECTION

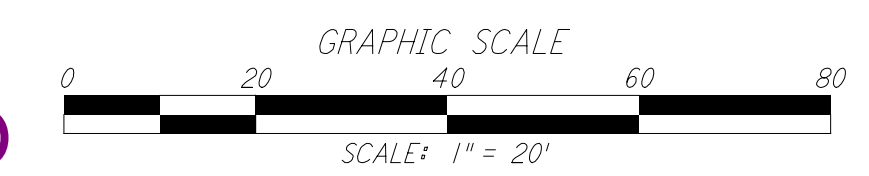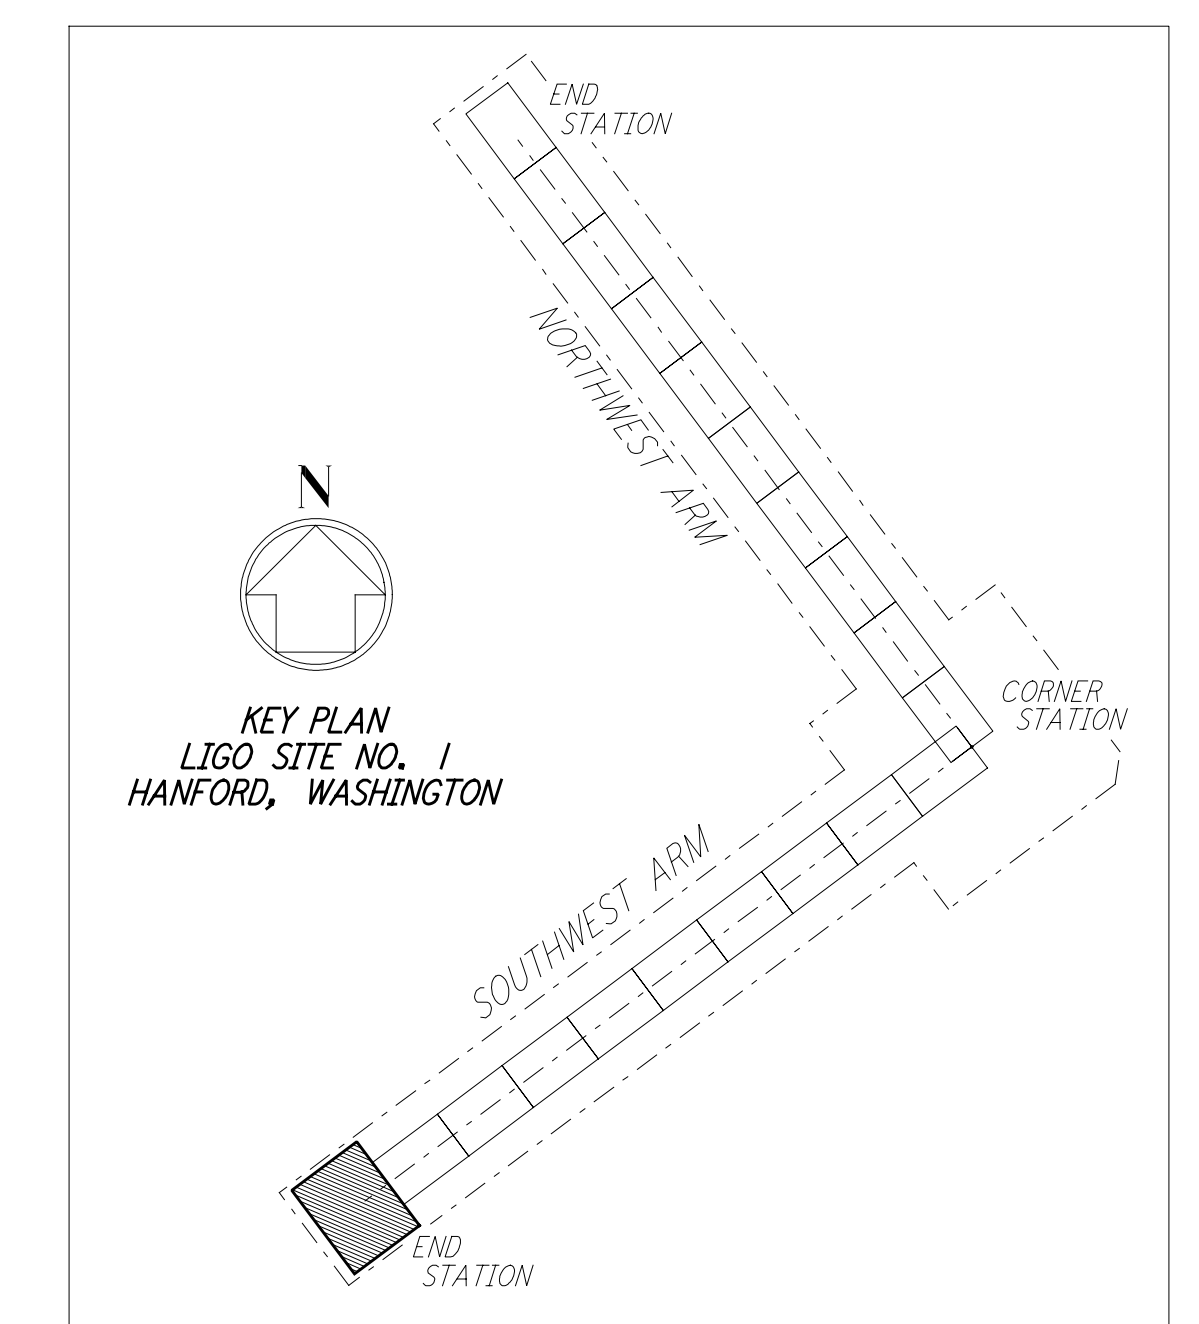

LIGO-D960231-01-O

NO.	DATE	BY	CHKD	ENGR	PROJ	DESCRIPTION
1	5/15/98	WRB				ISSUED FOR AS-BUILT

NO.	DATE	BY	CHKD	ENGR	PROJ	DESCRIPTION

FOR CONSTRUCTION  
 DRAWN WRB 9/28/95  
 CHECKED ML 7/9/96  
 ENGINEER JB 7/9/96  
 PROJ MDW 7/9/96

**AS-BUILT DRAWINGS**

100 WEST WALNUT STREET  
 PASADENA, CALIFORNIA

CALIFORNIA INSTITUTE OF TECHNOLOGY  
 MASSACHUSETTS INSTITUTE OF TECHNOLOGY

LASER INTERFEROMETER  
 GRAVITATIONAL-WAVE OBSERVATORY  
 SITE NO. I - HANFORD, WASHINGTON

CIVIL  
 SOUTHWEST ARM  
 END-STATION  
 PLOT PLAN

SCALE: 1" = 20'  
 SHEET NUMBER: PPI50969  
 PROJECT NUMBER: 8094

**WA-C-045**