

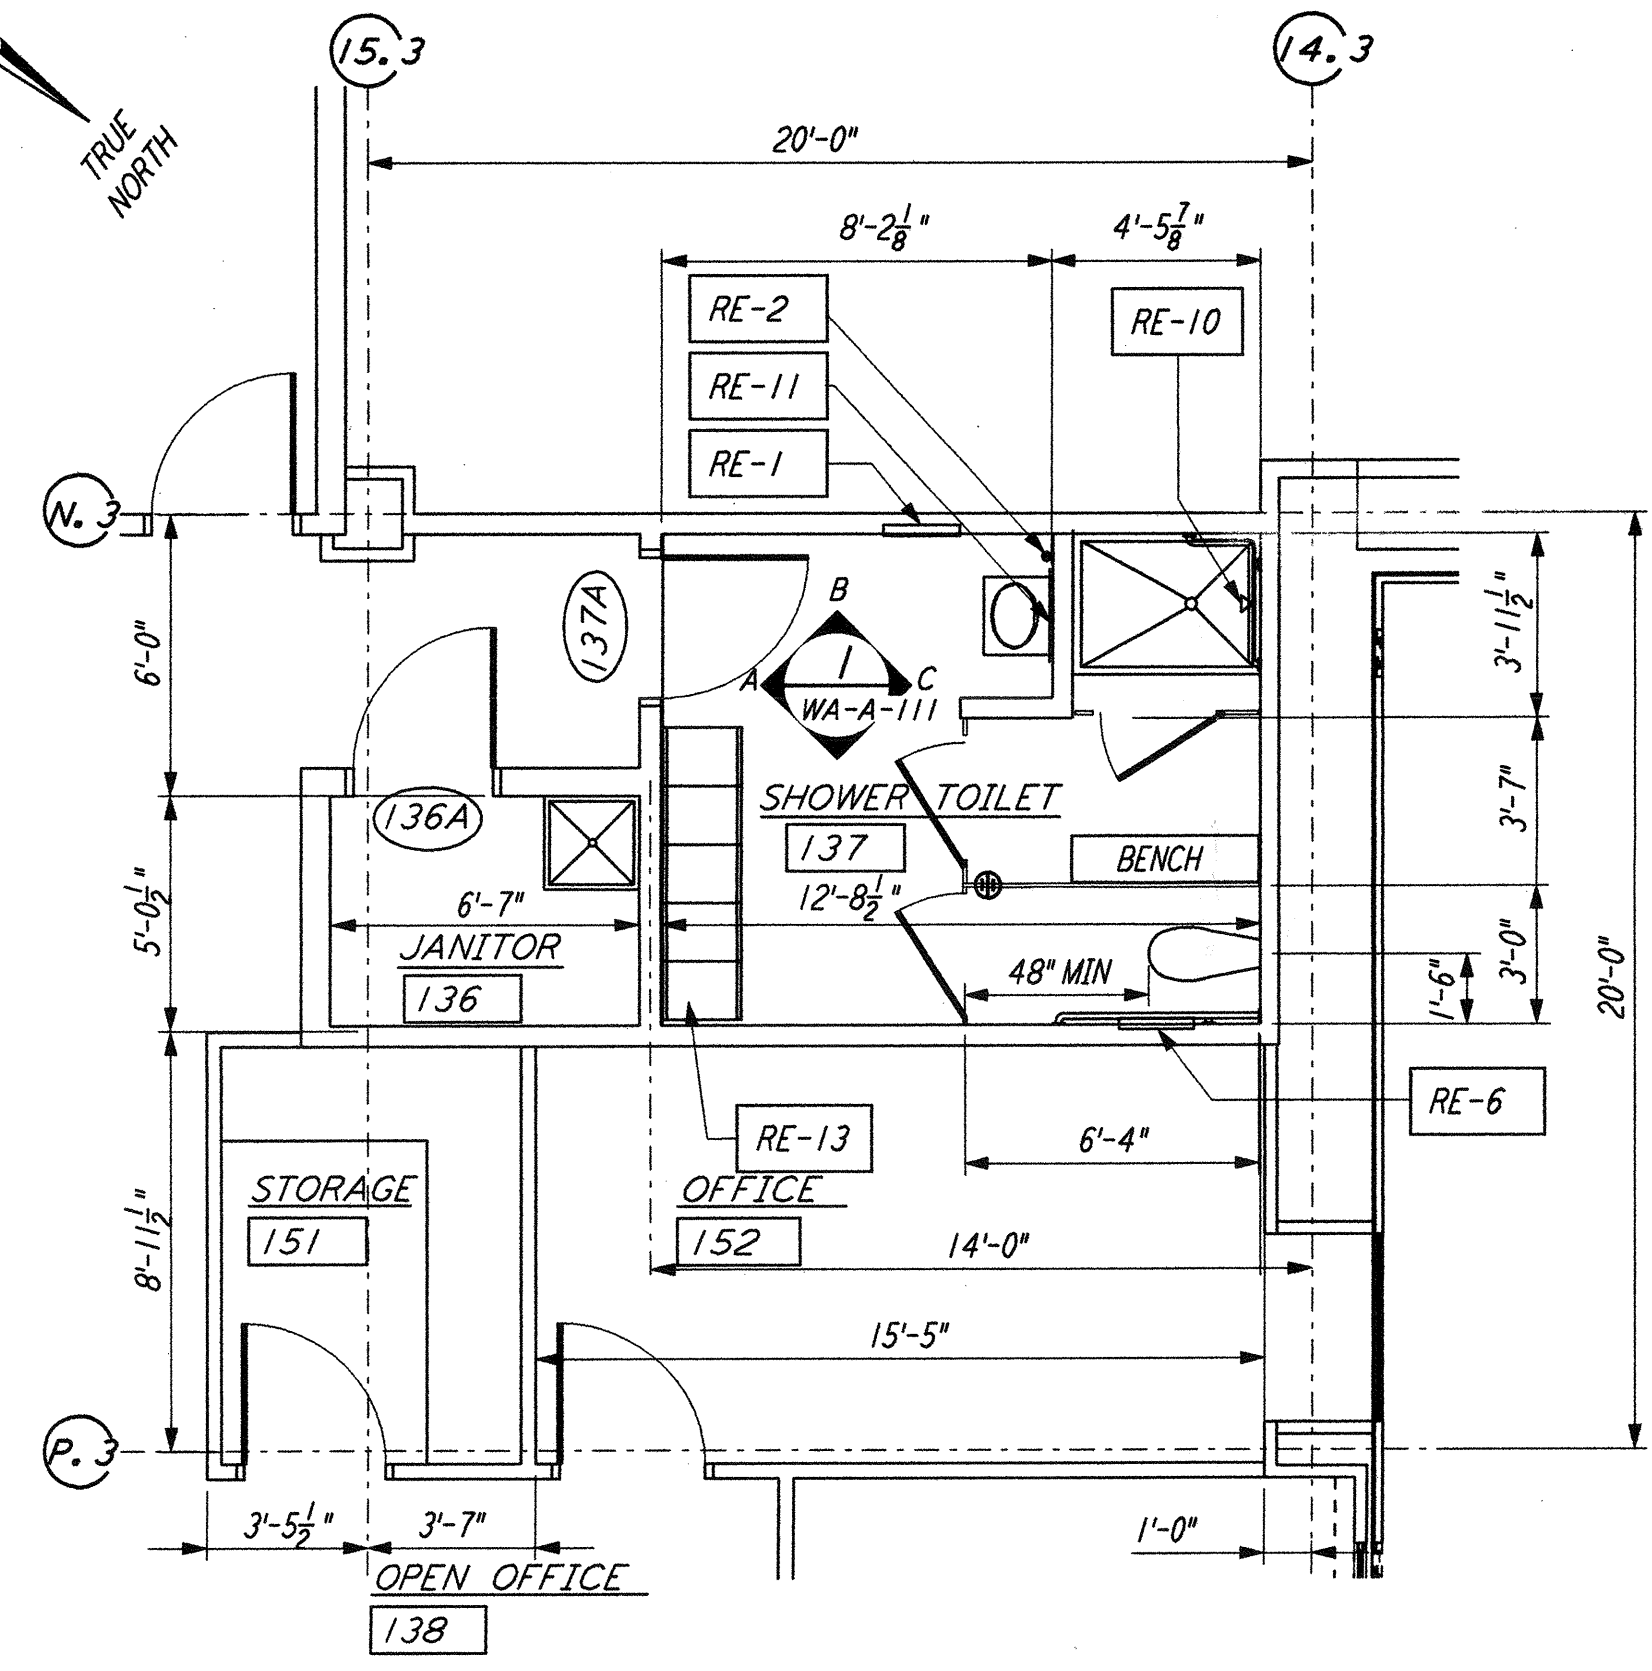


NOTE: SEE SPECIFICATIONS FOR
 ADDITIONAL INFORMATION
 AND SCHEDULES

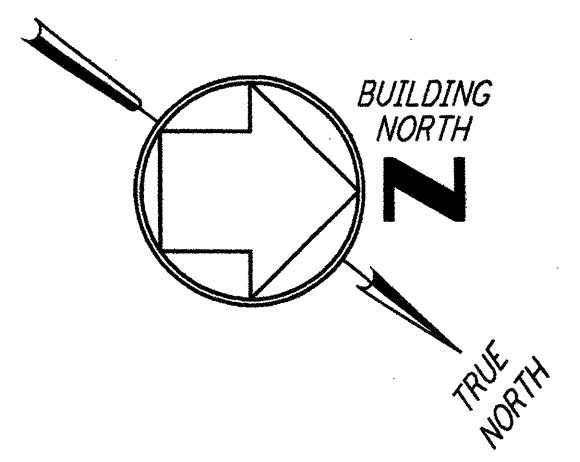


ENLARGED PLAN


JANITOR 136 / SHOWER TOILET 137
 $\frac{1}{4}'' = 1'-0''$

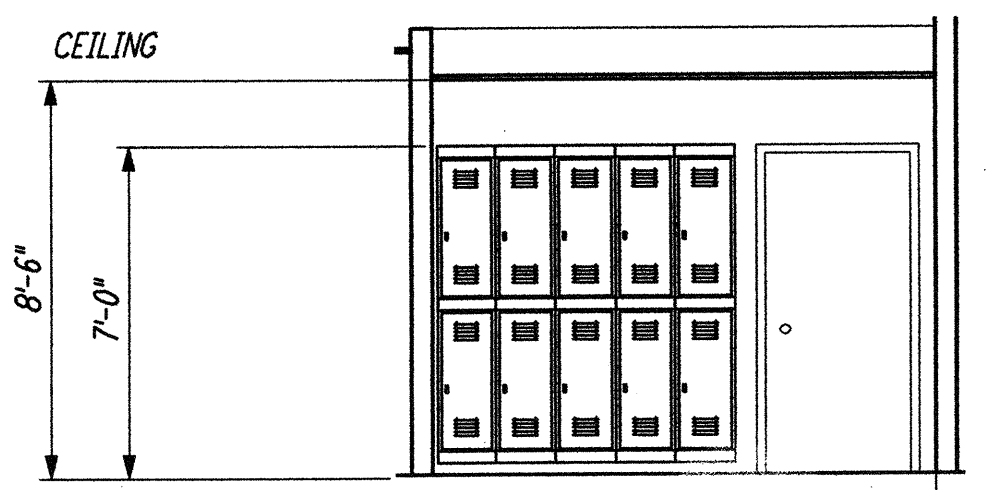


ELEVATION A

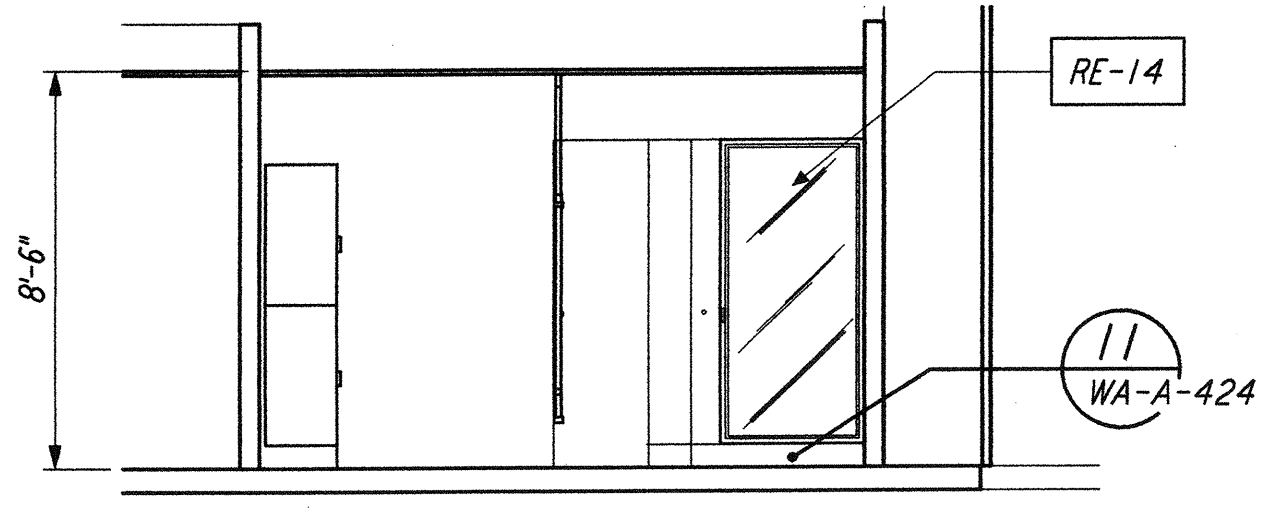

ELEVATION B

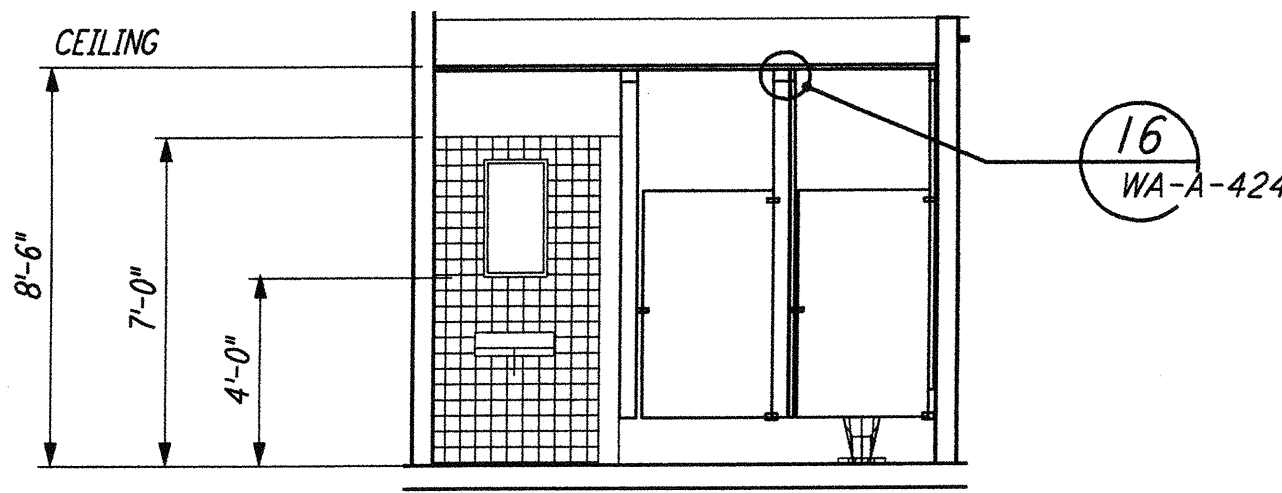


ELEVATION C

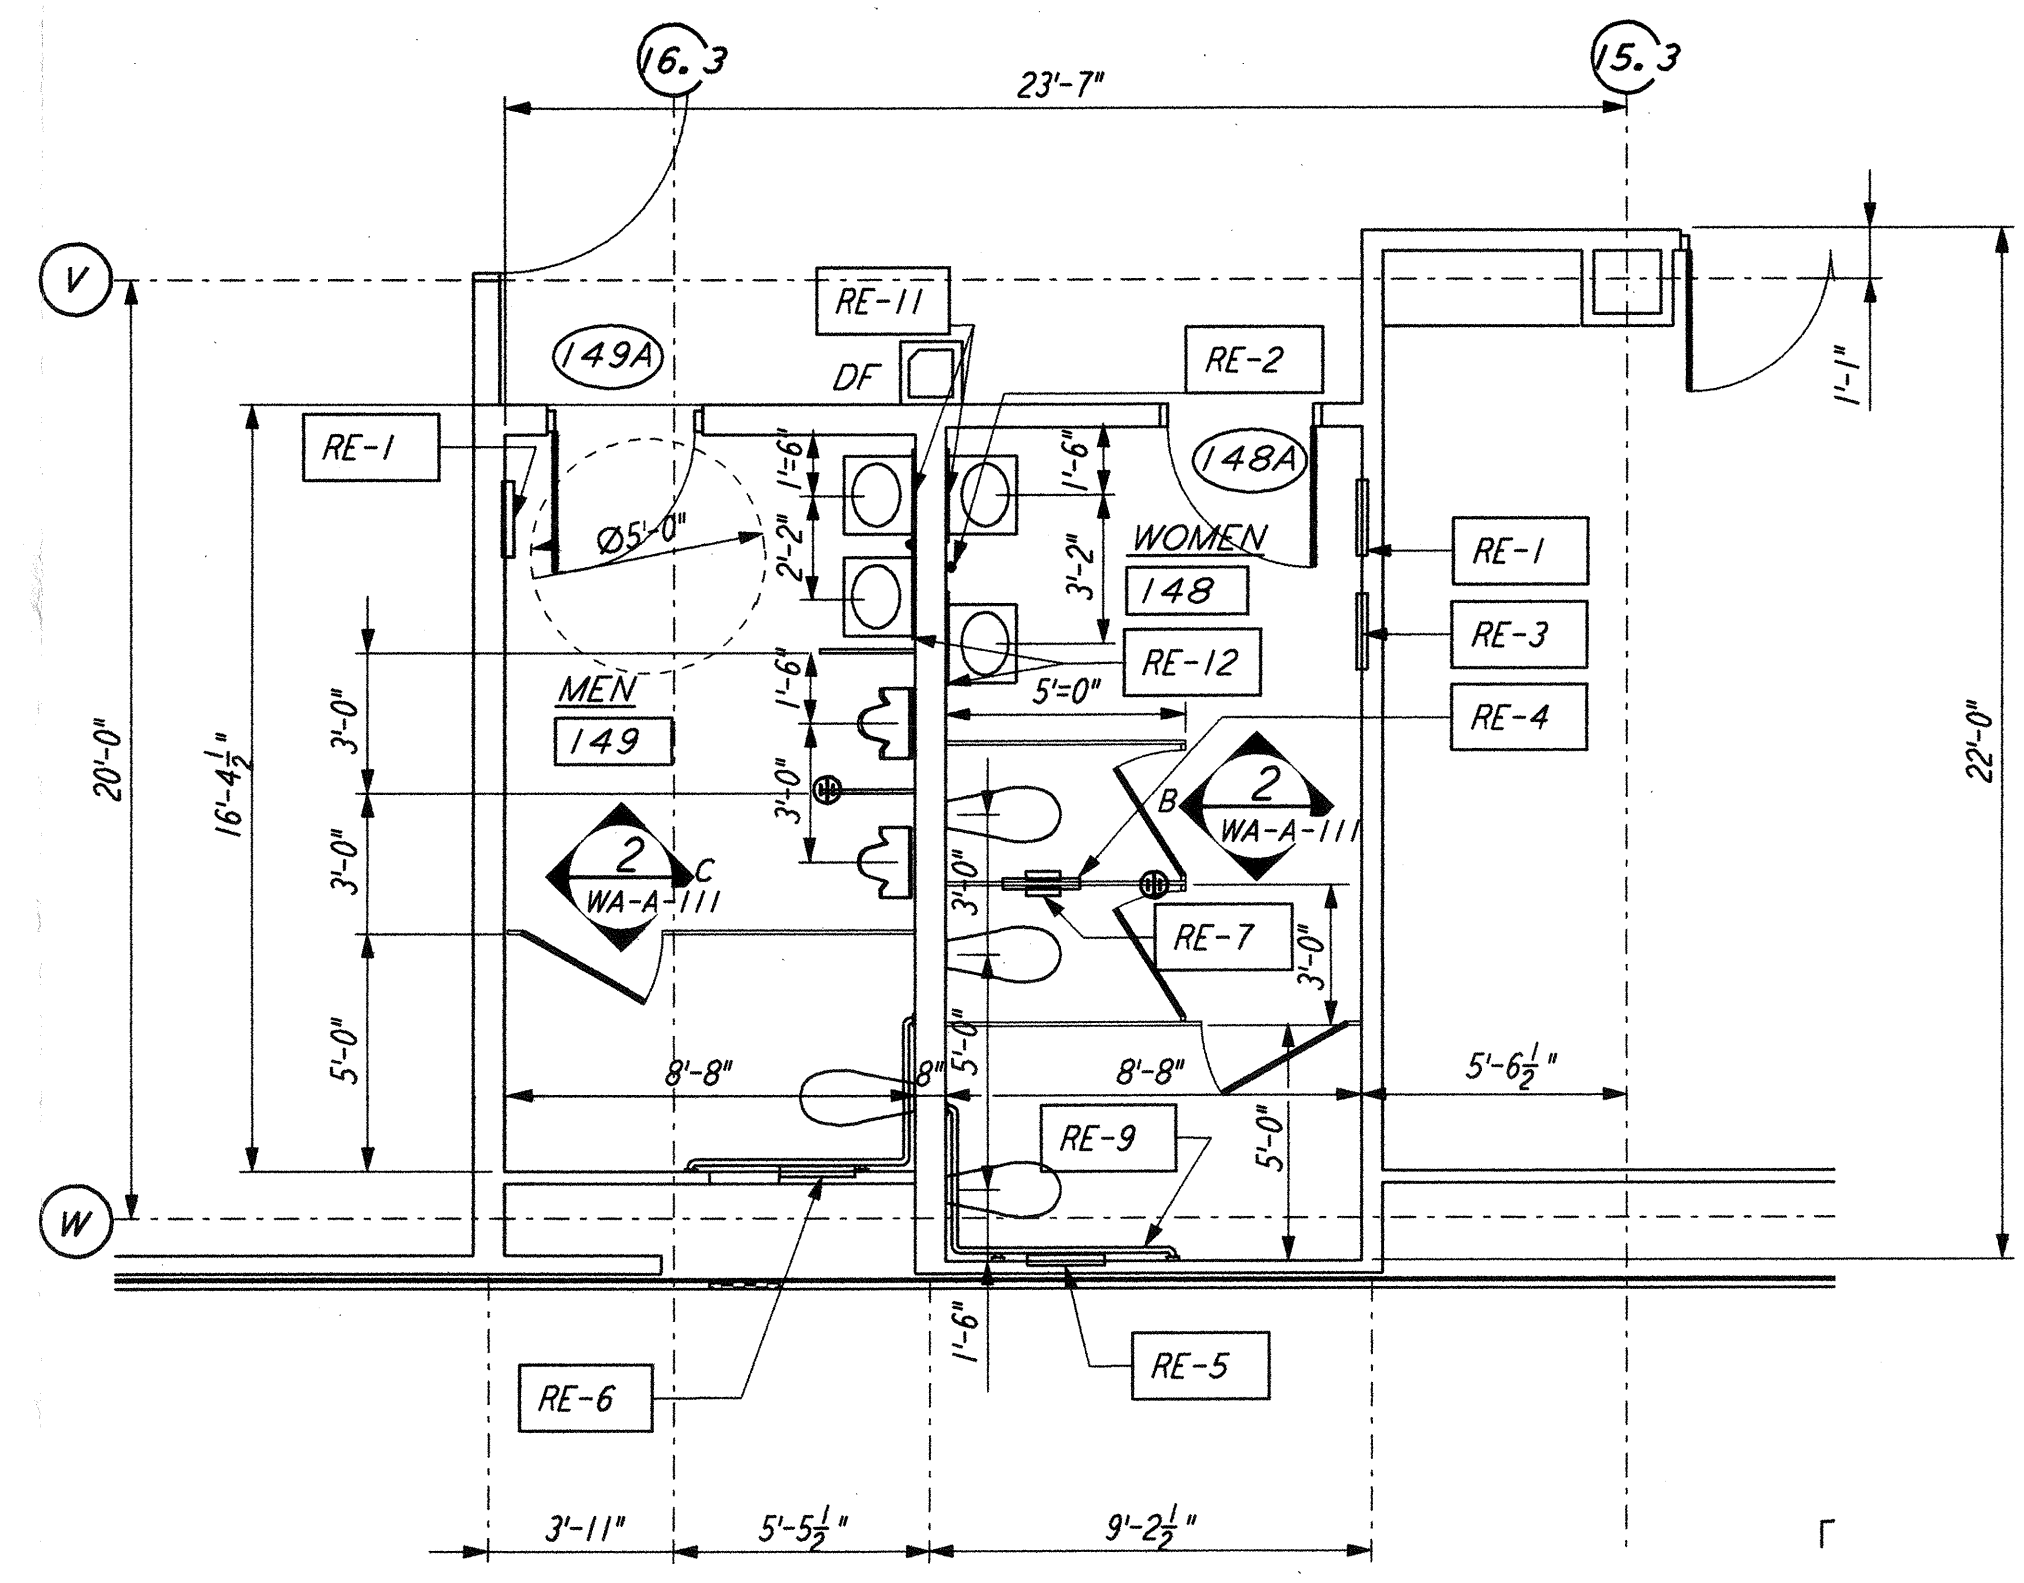


ENLARGED TOILET PLAN


MEN 149 / WOMEN 148
 $\frac{1}{4}'' = 1'-0''$

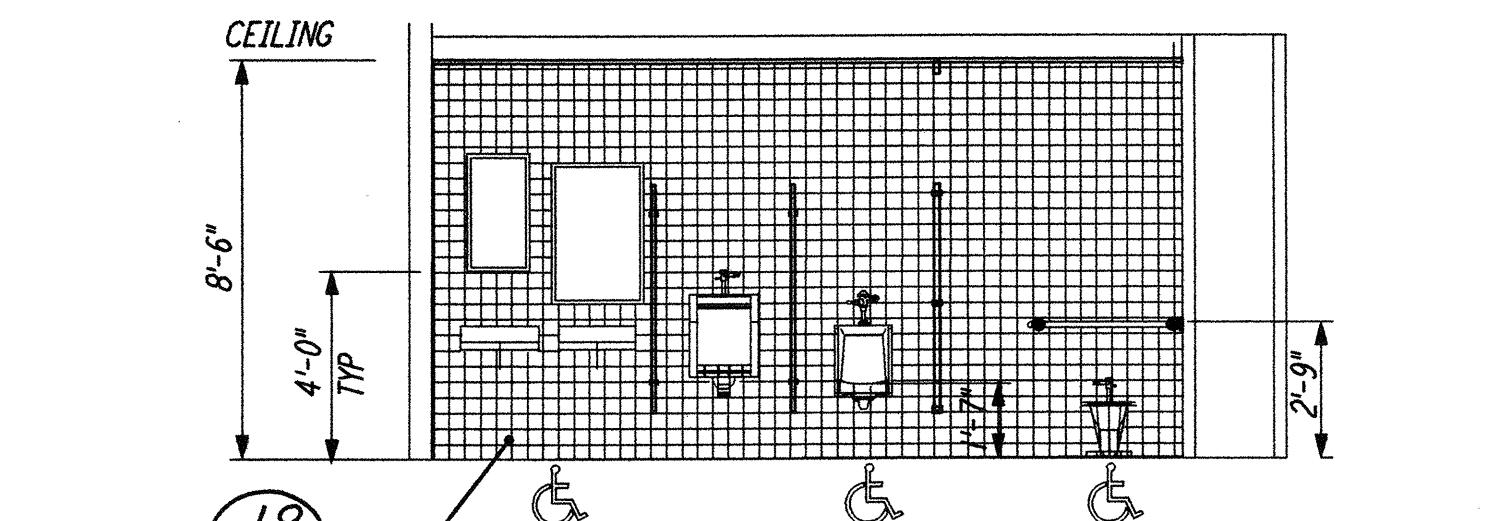

ELEVATION C

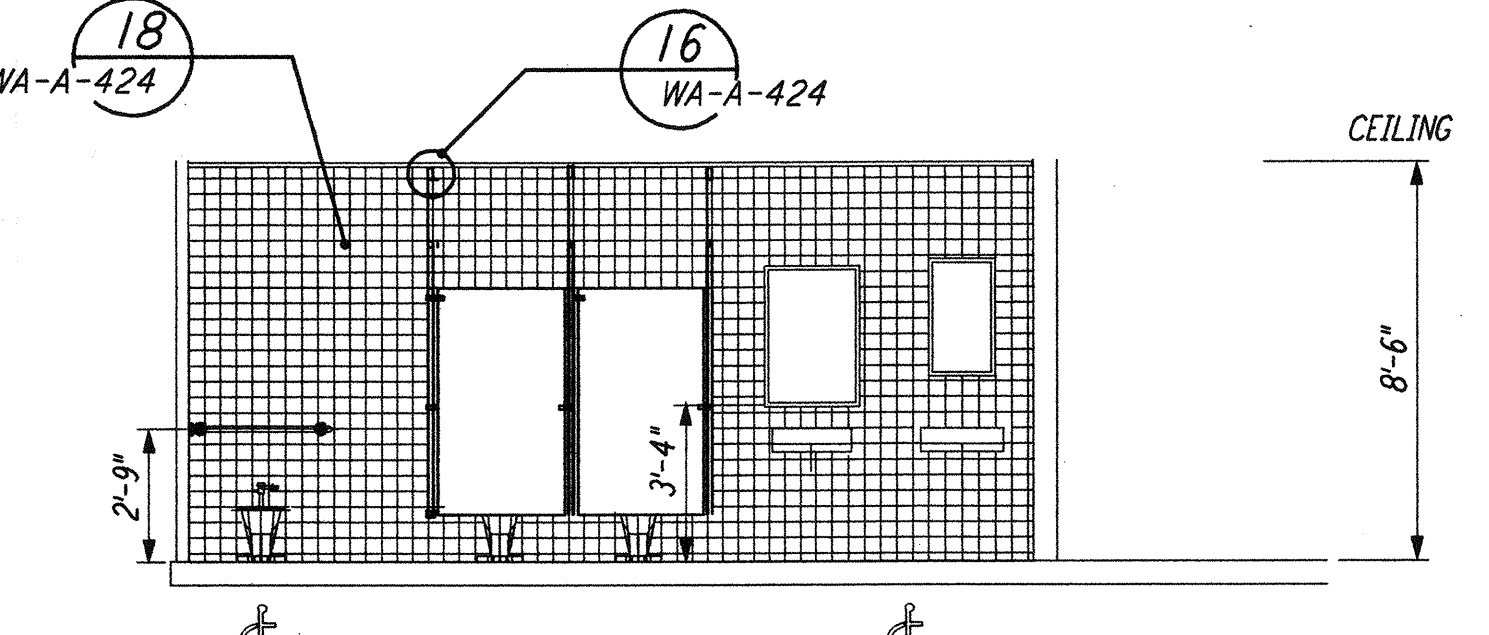


ELEVATION B

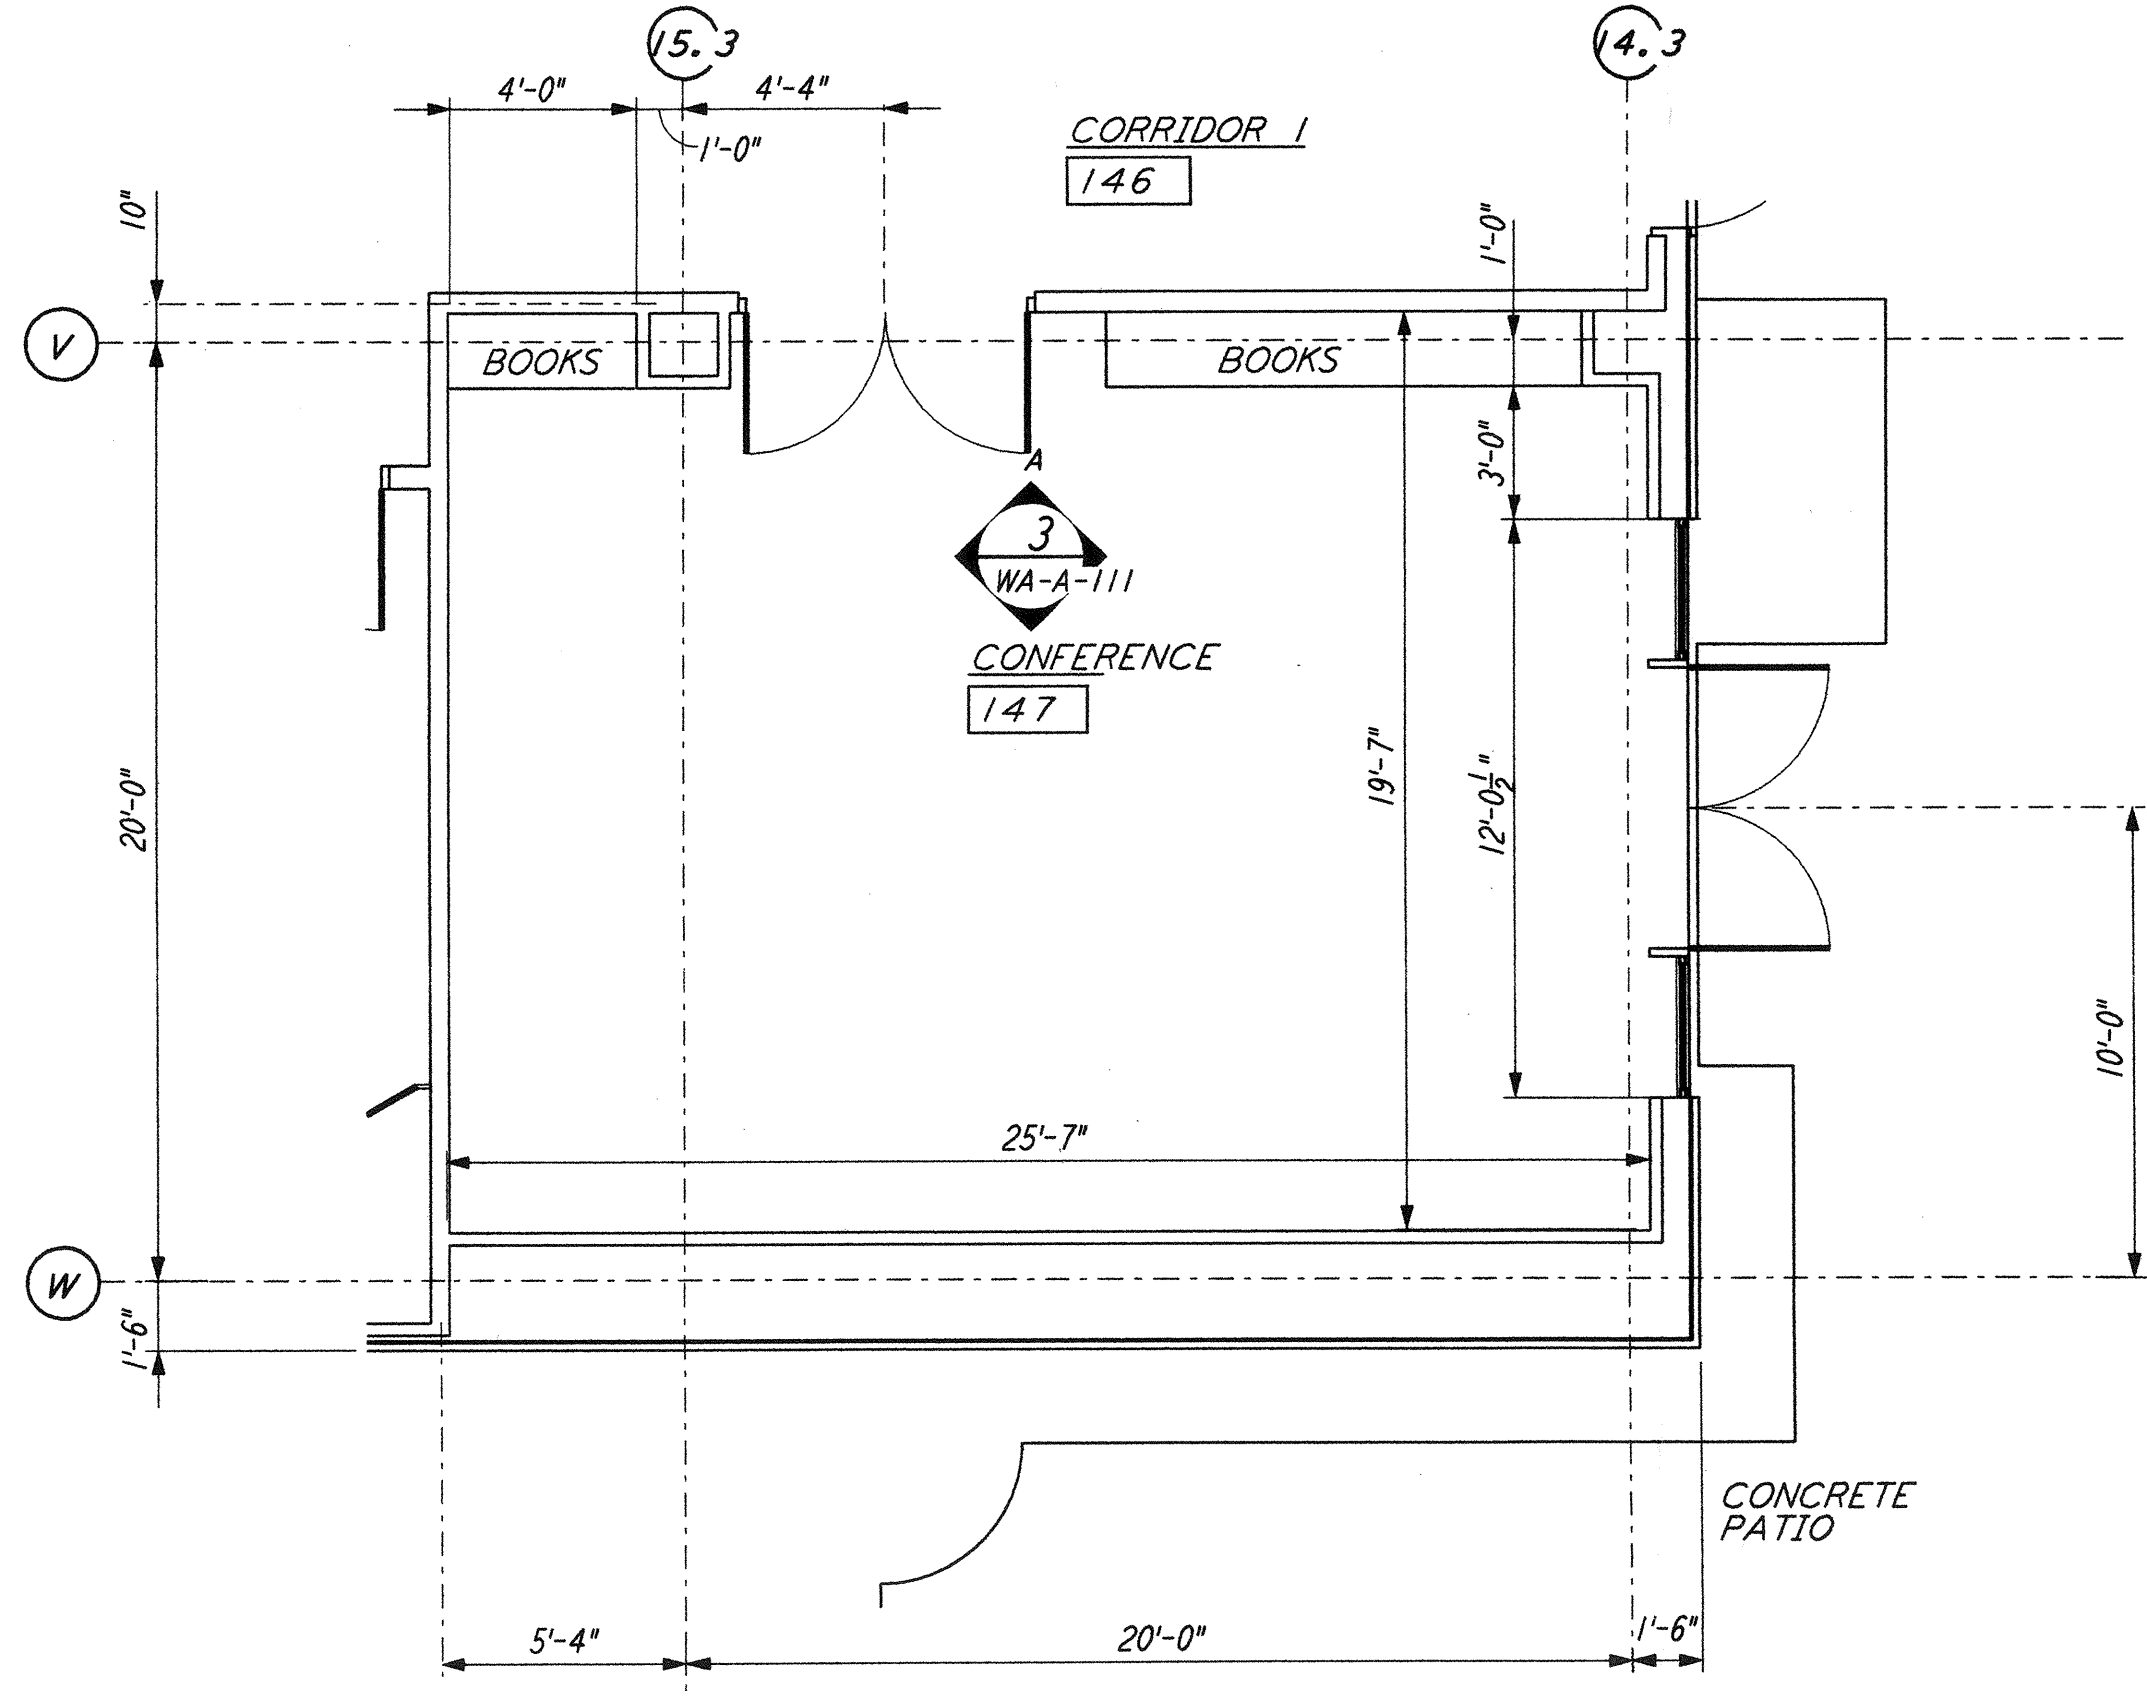


ENLARGED PLAN

CONFERENCE ROOM 147
 $\frac{1}{4}'' = 1'-0''$

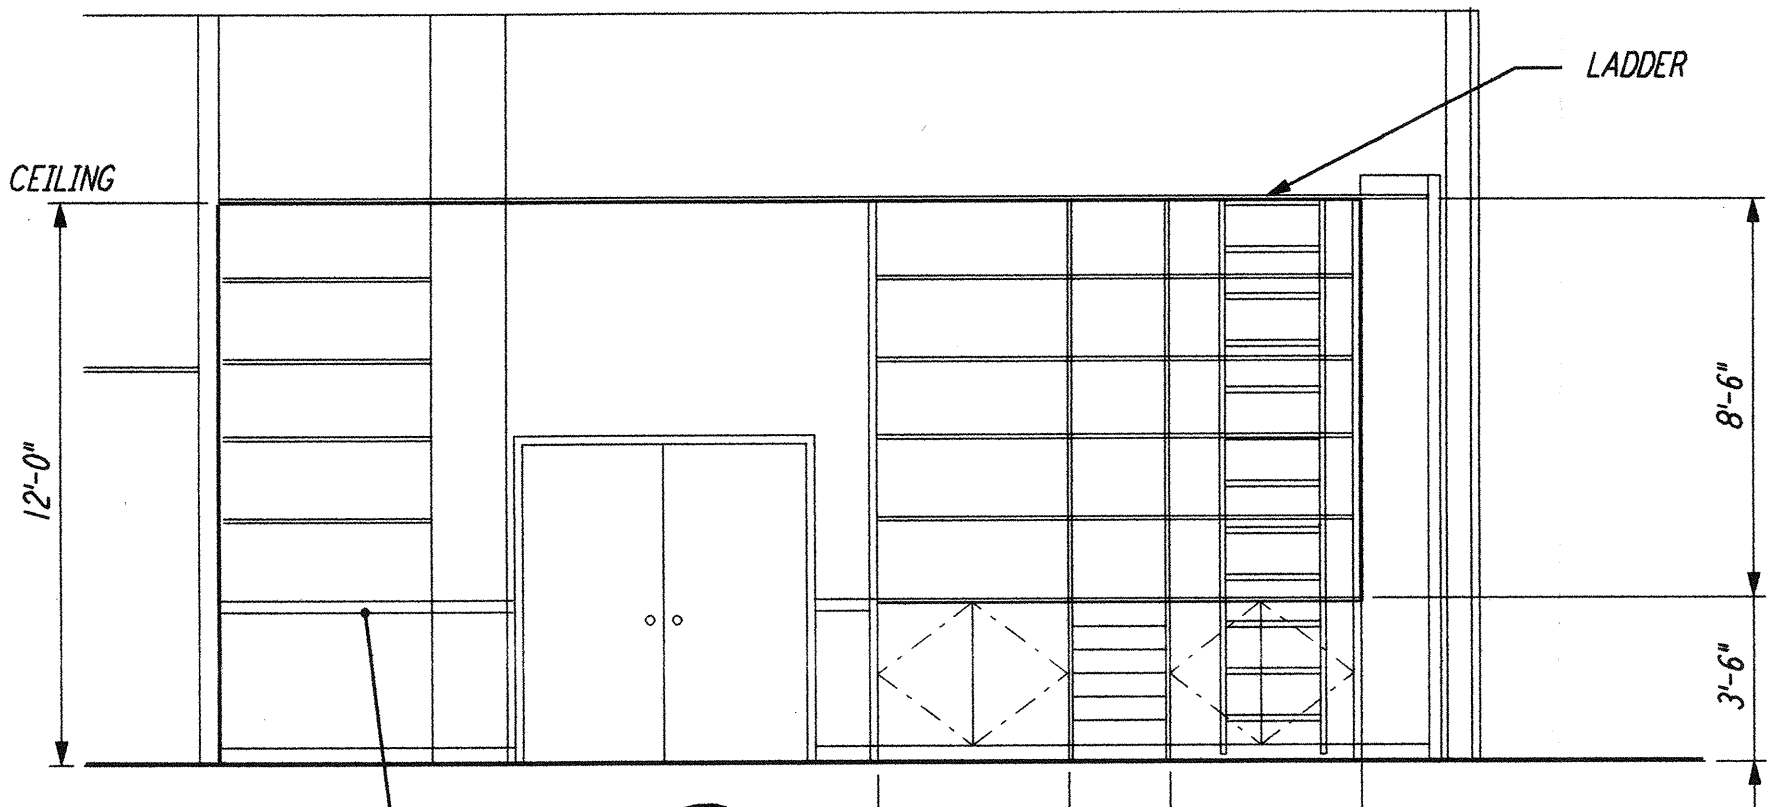


ELEVATION A

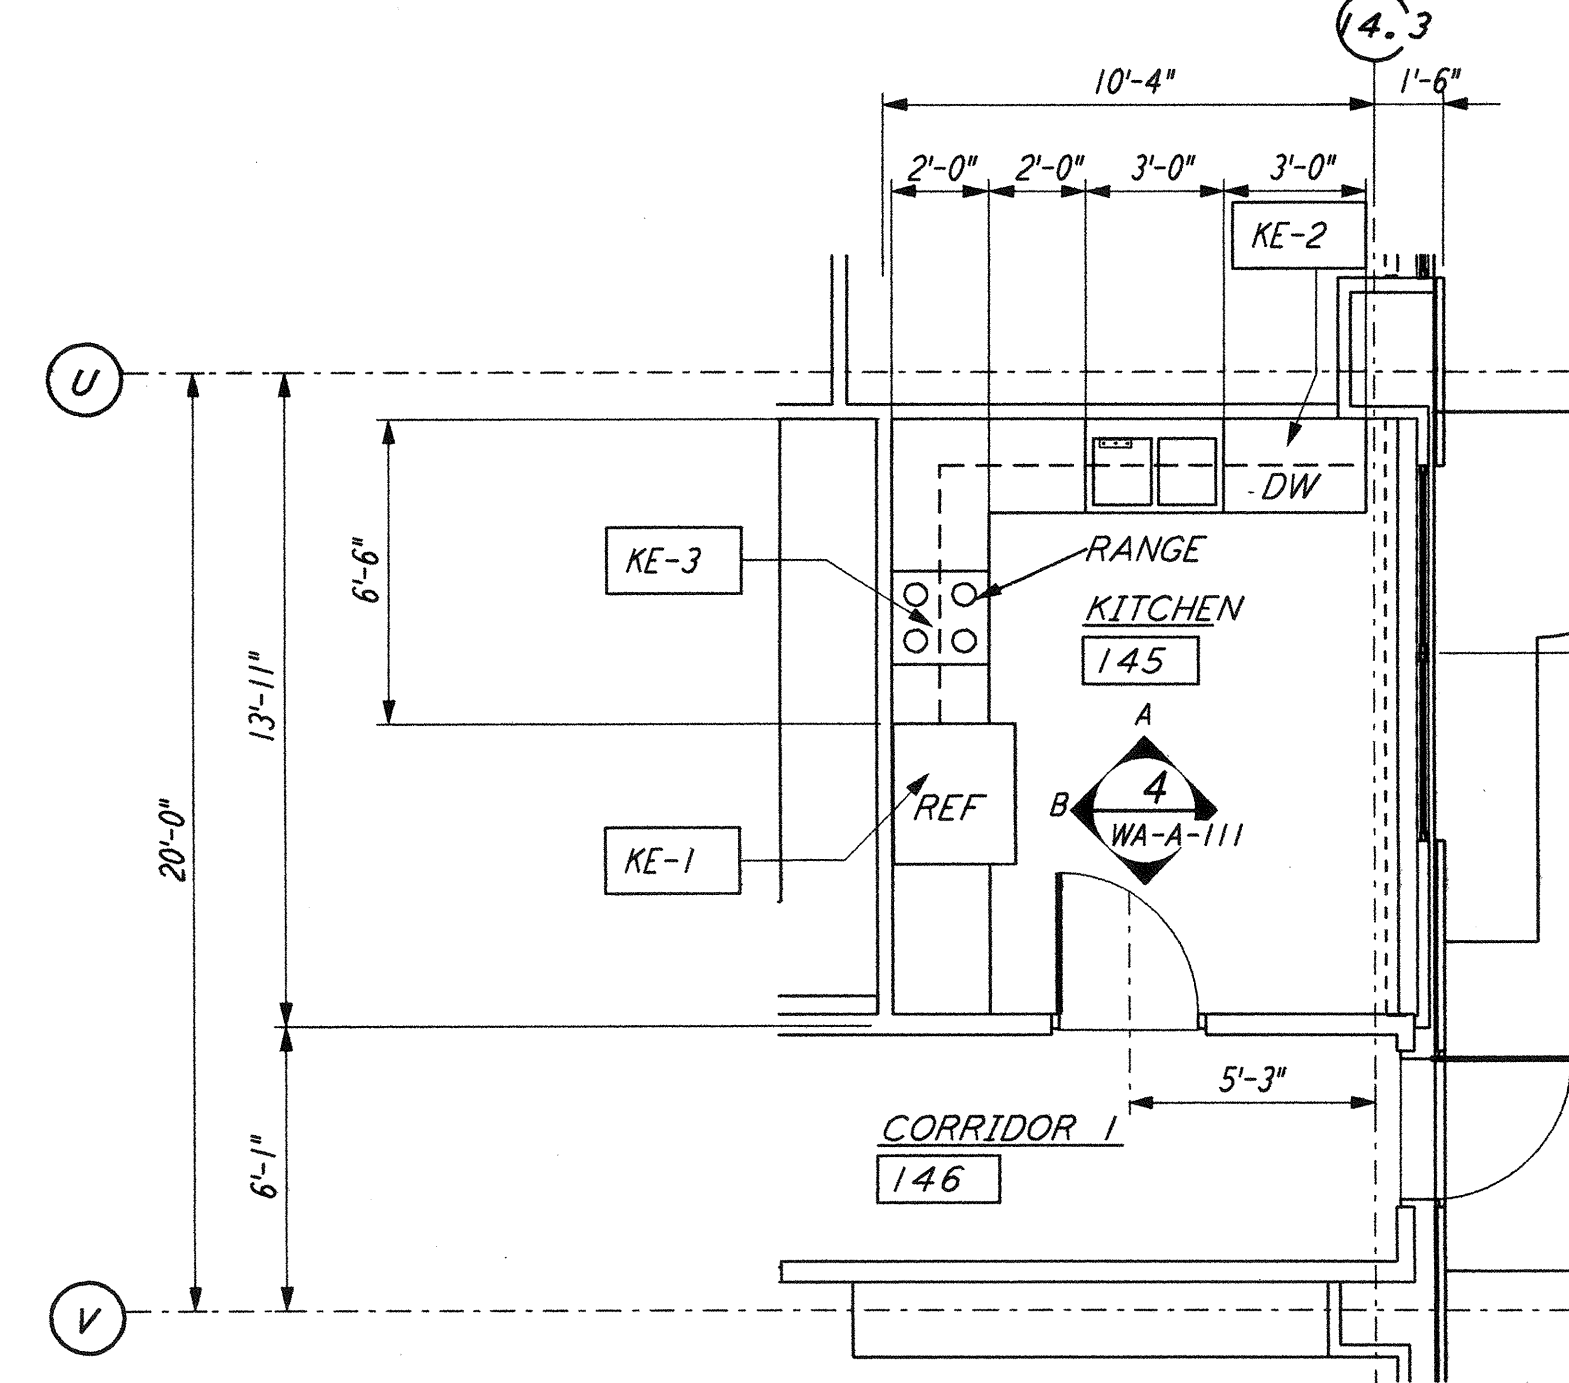


ENLARGED KITCHEN PLAN

KITCHEN PLAN 145
 $\frac{1}{4}'' = 1'-0''$

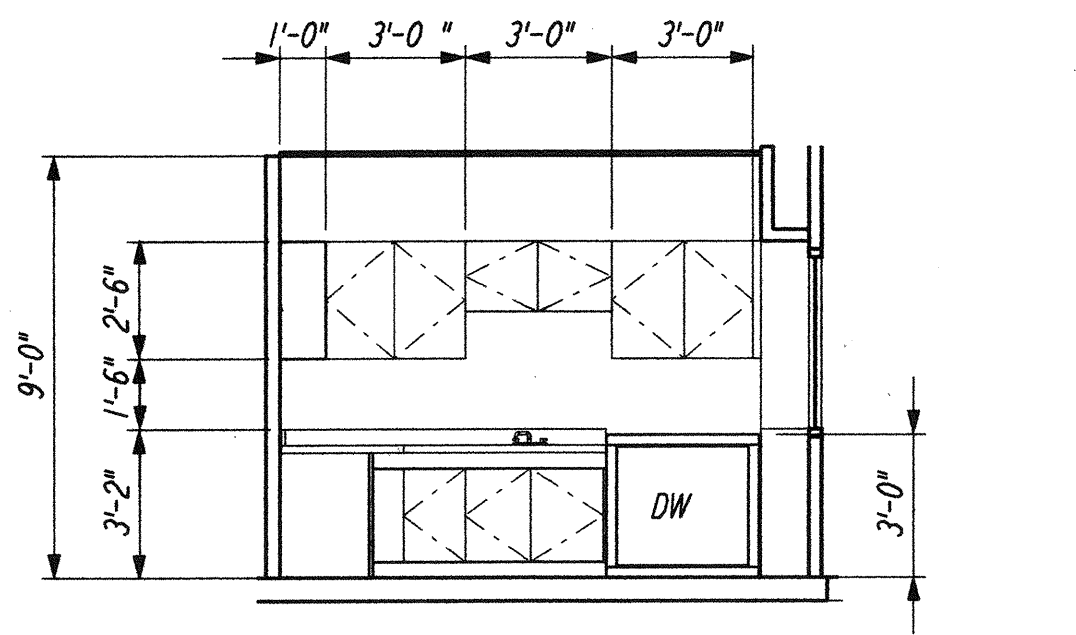

ELEVATION A

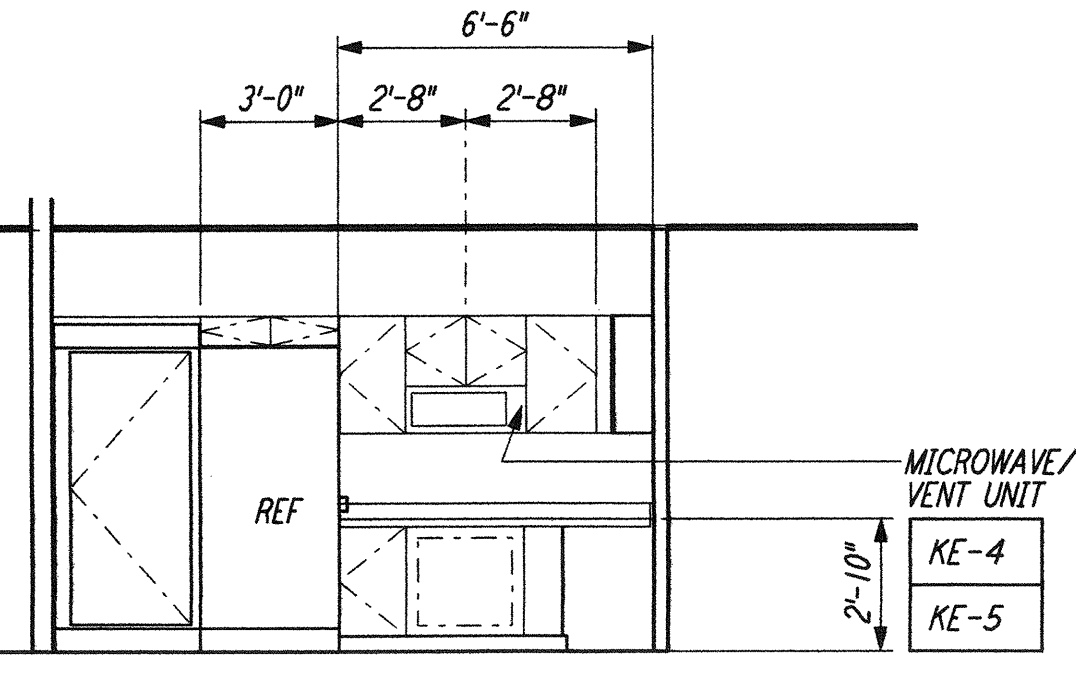

ELEVATION B

0 4 8 12 16 FT
 $\frac{1}{4}'' = 1'-0''$

This document and the design it covers are the property of PARSONS. They are loaned only with the borrower's expressed written agreement that they will not be reproduced, copied, loaned, exhibited, or used in any other way, except by written consent from PARSONS to the borrower.

NO.	DATE	BY	CHKD	ENGR	PROJ	DESCRIPTION
2	5-15-98	CKT	AK	AK	TDM	ISSUED FOR AS-BUILT
1	2-28-97	CKT	TB	AK	TDM	OSB REVISION

AS-BUILT DRAWINGS		
DRAWN	CKT	5-12-96
CHECKED	TB	5-26-96
ENGINEER	BKK	7-12-96
PROJ	MDW	7-12-96

100 WEST WALNUT STREET
 PASADENA, CALIFORNIA

CALIFORNIA INSTITUTE OF TECHNOLOGY
 MASSACHUSETTS INSTITUTE OF TECHNOLOGY

LASER INTERFEROMETER
 GRAVITATIONAL-WAVE OBSERVATORY
 SITE NO. 1 - HANFORD, WASHINGTON

ARCHITECTURAL CORNER STATION
 OSB ENLARGED PLANS

SCALE AS NOTED
 SHEET NUMBER: PP150969
 PROJECT NUMBER: 8094

WA-A-111