




NOTE: SEE SPECIFICATIONS FOR ADDITIONAL INFORMATION AND SCHEDULES

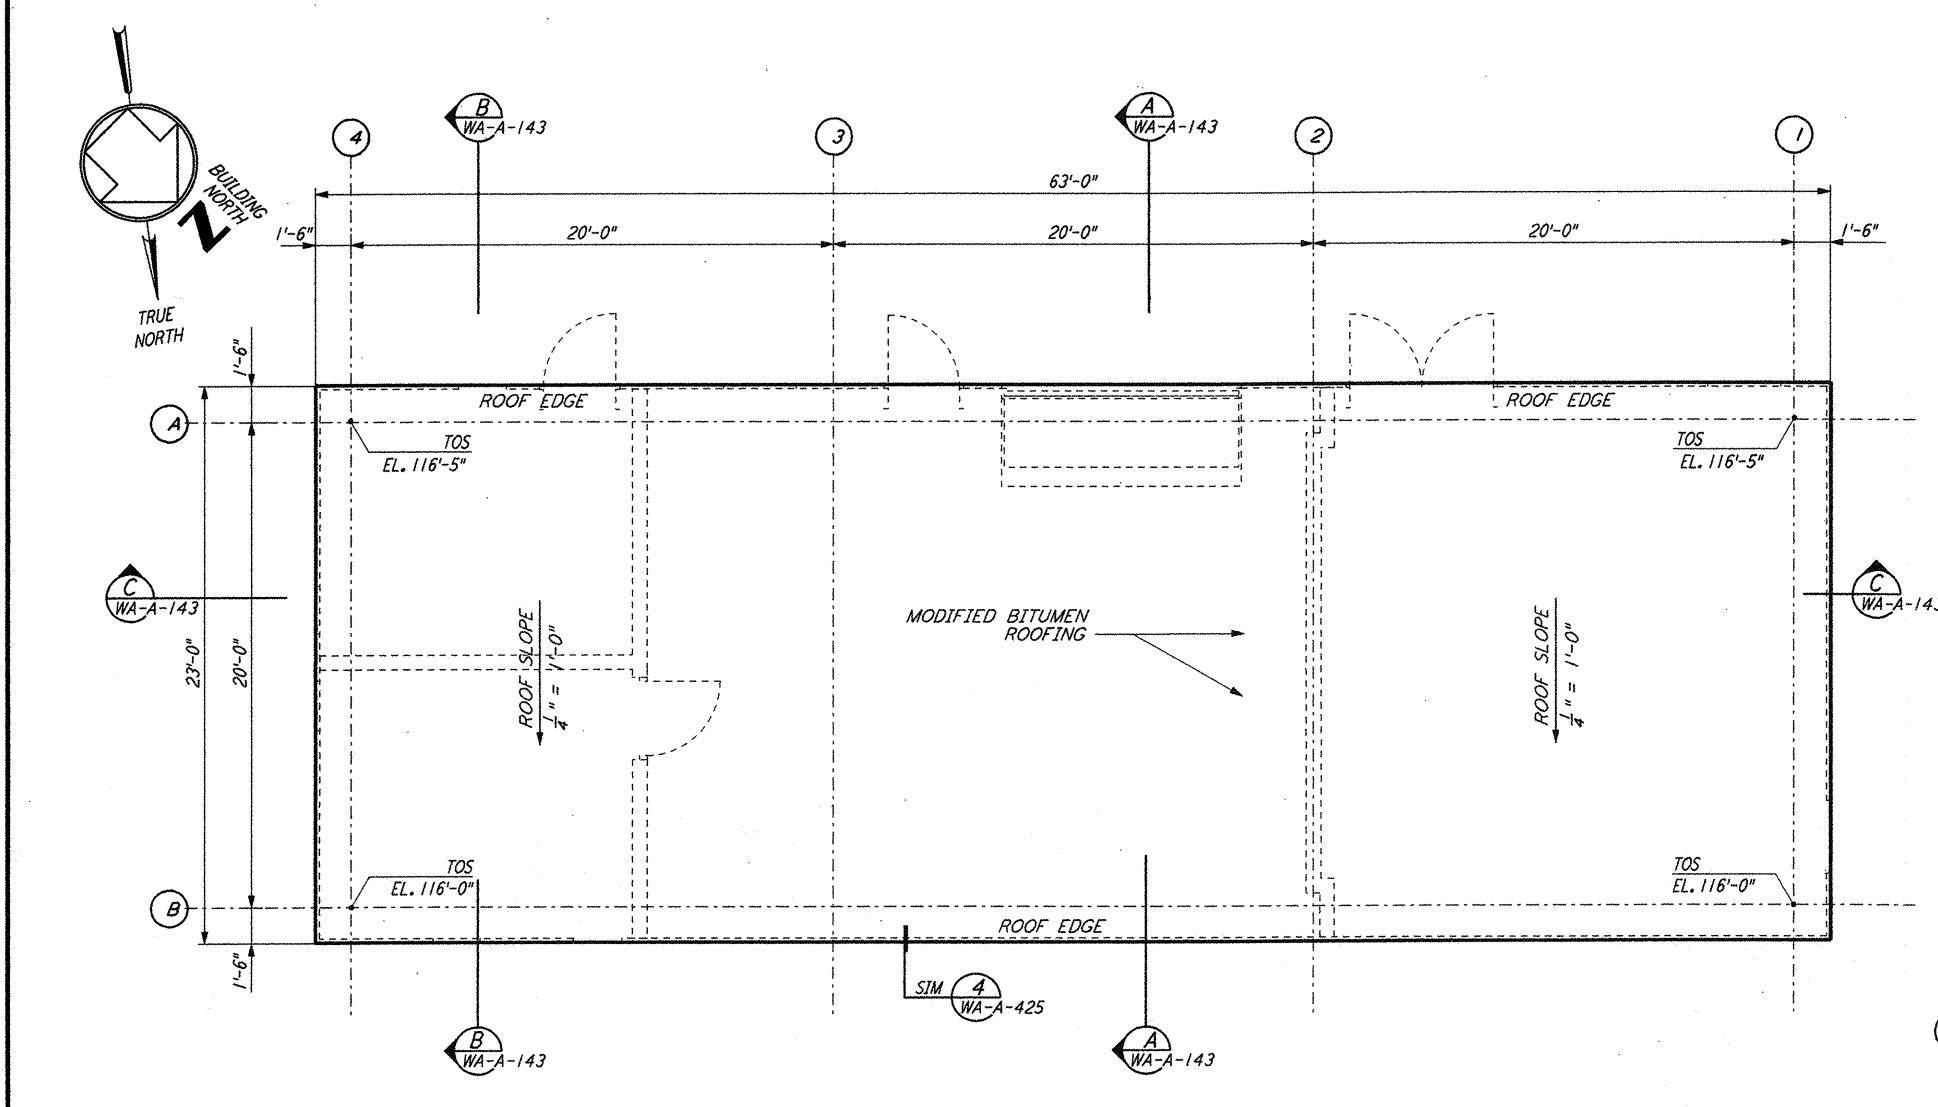


MAINTENANCE BUILDING ROOF PLAN (2) WA-A-112
 1/4" = 1'-0"

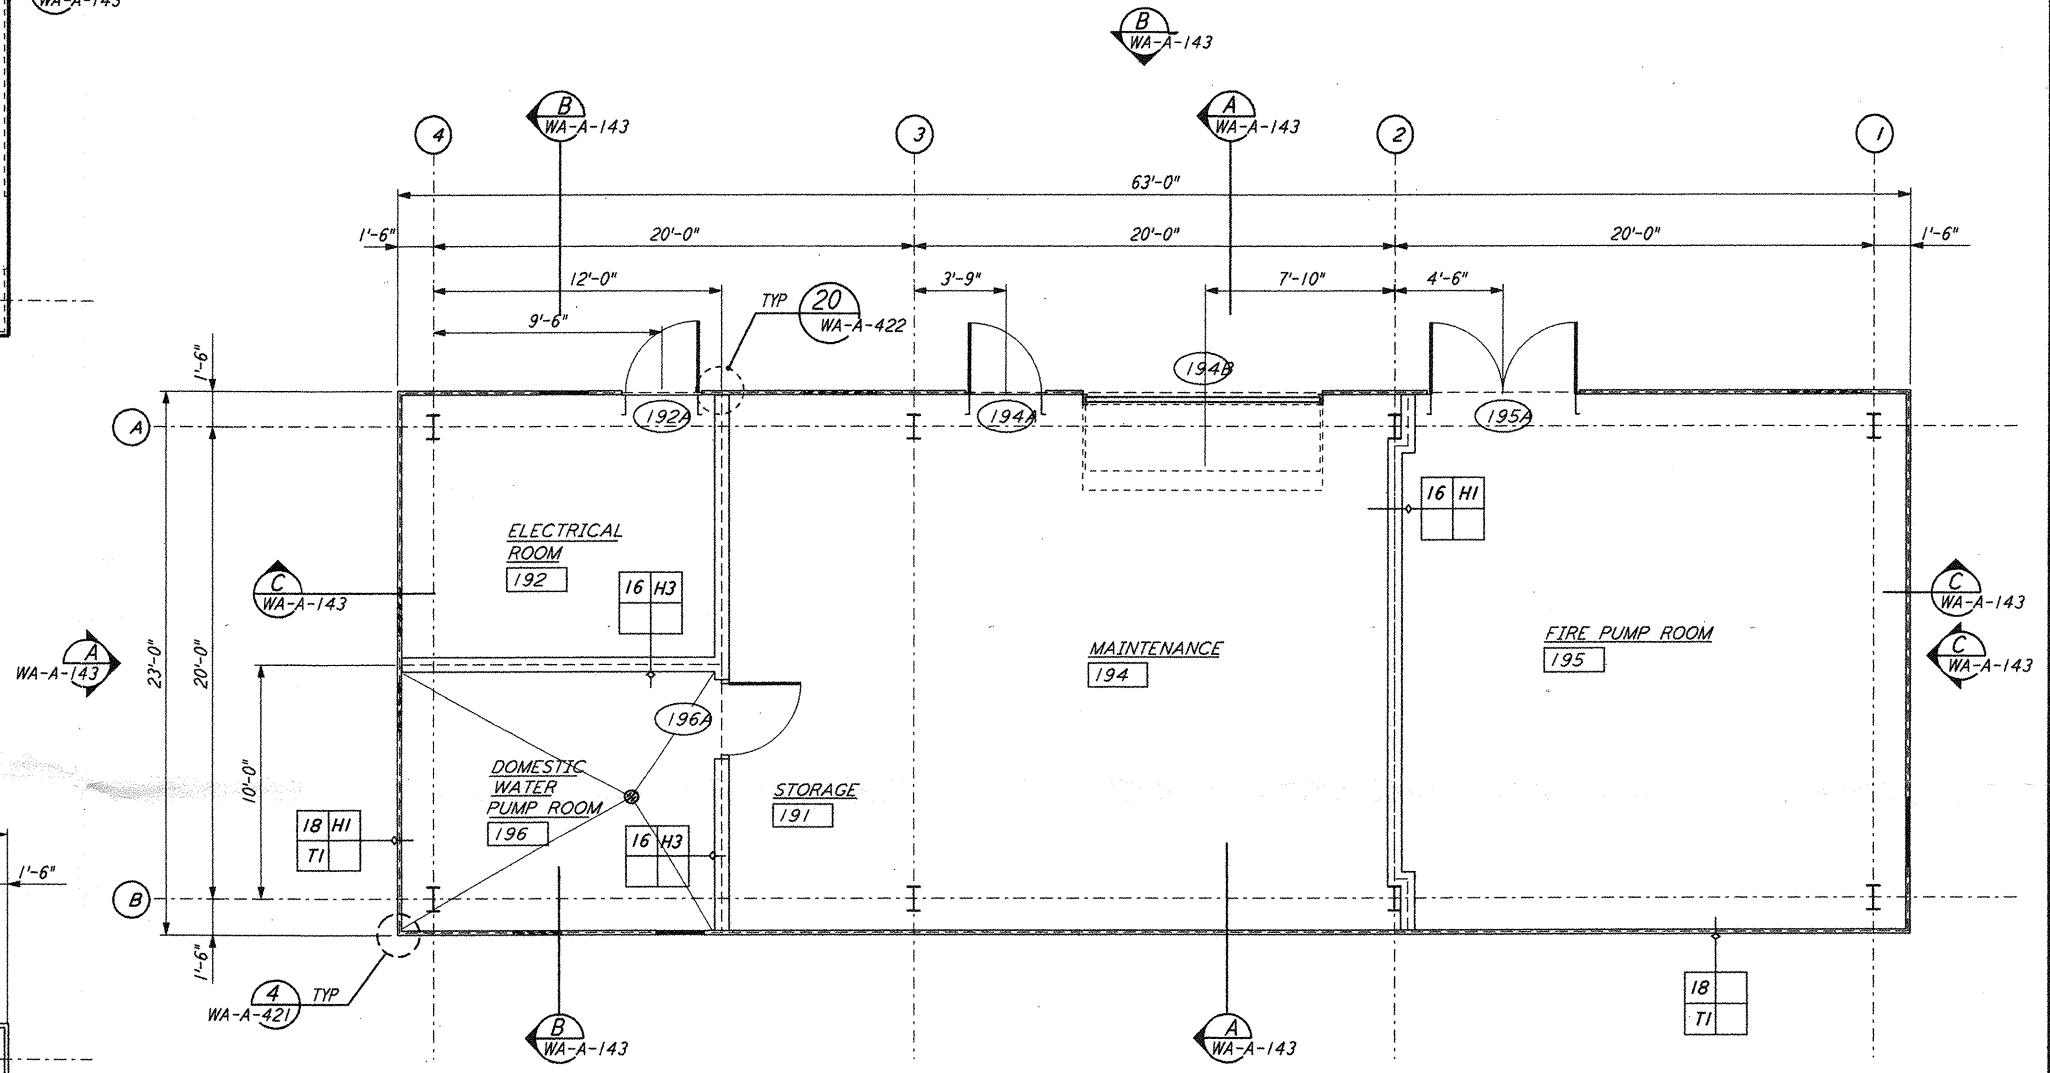

MAINTENANCE BUILDING PLAN (1) WA-A-112
 1/4" = 1'-0"

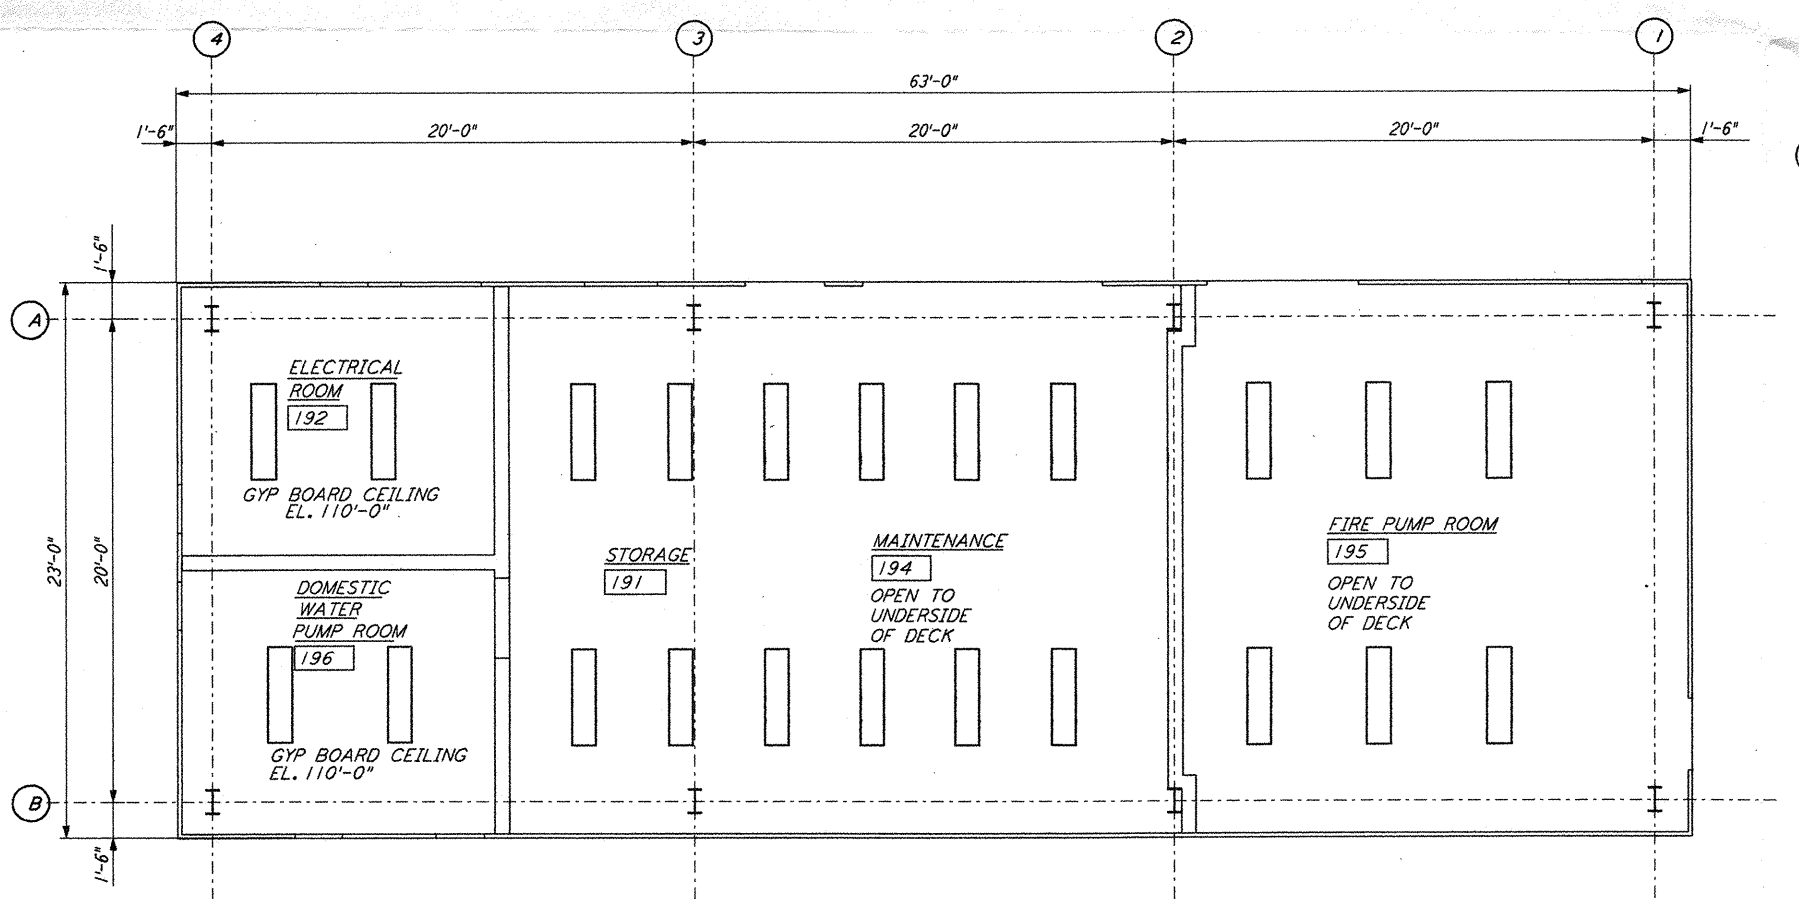

MAINTENANCE BUILDING REFLECTED CEILING PLAN (3) WA-A-112
 1/4" = 1'-0"

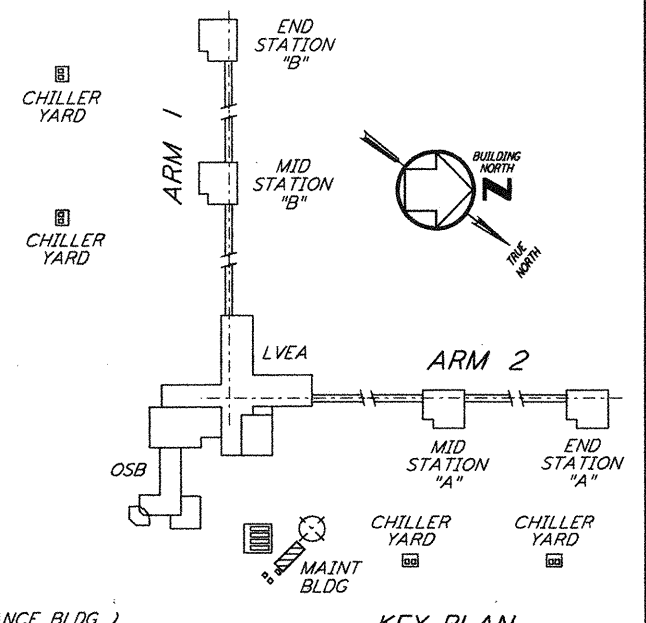

DATUM POINT EL +100, 00 = 531.11' (LVEA)
 DATUM POINT EL +100, 00 = 531.11' (OSB)
 DATUM POINT EL +100, 00 = 532.50' (MAINTENANCE BLDG)

KEY PLAN
 LIGO-D960251-01-0

This document and the design it covers are the property of PARSONS. They are loaned only with the borrower's expressed written agreement that they will not be reproduced, copied, loaned, exhibited, or used in any other way, except by written consent from PARSONS to the borrower.

NO.	DATE	BY	CHKD	ENGR	PROJ	DESCRIPTION
1	5-15-98	CKT	MDW	MDW	MDW	ISSUED FOR AS-BUILT

ISSUED FOR CONSTRUCTION
 DRAWN CKT 7-12-96
 CHECKED TB 5-26-96
 ENGINEER BKR 7-12-96
 PROJ MDW 7-12-96

AS-BUILT DRAWINGS

PARSONS
 100 WEST WALNUT STREET
 PASADENA, CALIFORNIA

LIGO
 CALIFORNIA INSTITUTE OF TECHNOLOGY
 MASSACHUSETTS INSTITUTE OF TECHNOLOGY

LASER INTERFEROMETER
 GRAVITATIONAL-WAVE OBSERVATORY
 SITE NO. 1 - HANFORD, WASHINGTON

ARCHITECTURAL CORNER STATION
 MAINTENANCE BUILDING PLANS

AS NOTED PPI50969 8094
WA-A-112