



MID/END STATIONS ROOF PLAN
 1/8" = 1'-0" (2)

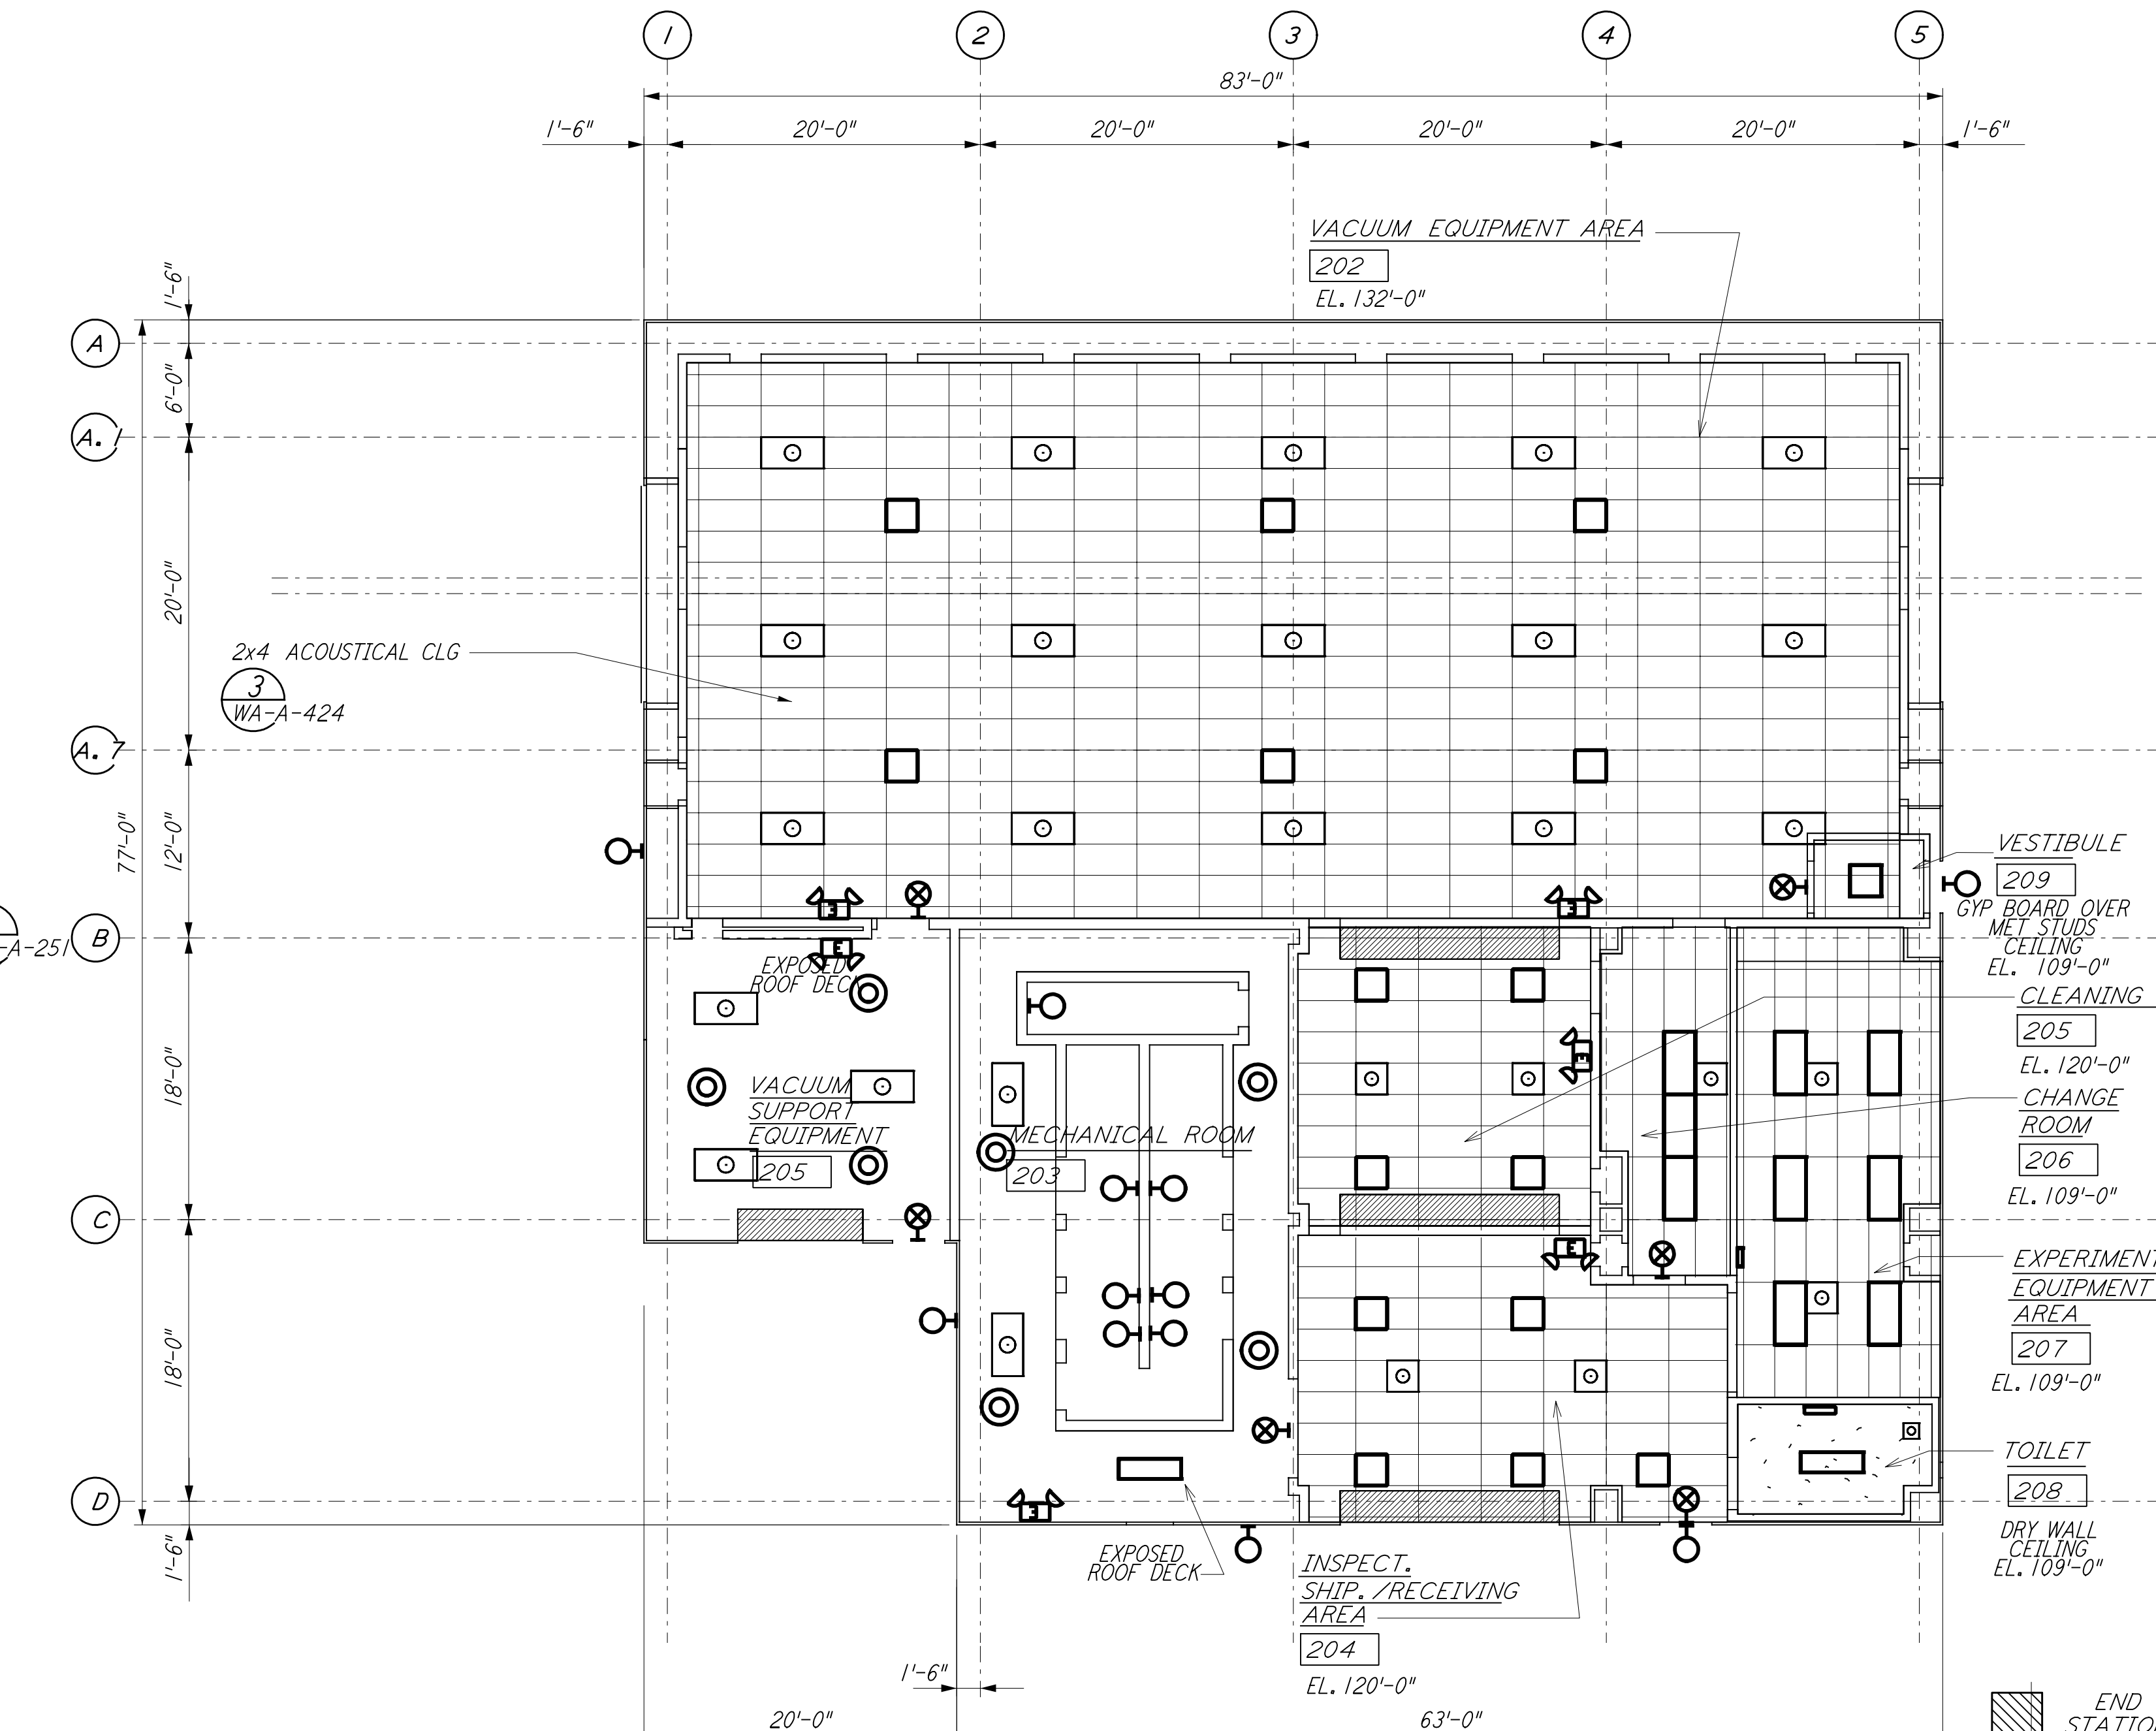

MID/END STATIONS REFLECTED CEILING PLAN
 1/8" = 1'-0" (1)

0 8 16 24 32 FT
 1/8" = 1'-0"

DATUM POINT EL +100.00 = 531.11' (LVEA)
 DATUM POINT EL +100.00 = 531.11' (OSB)
 DATUM POINT EL +100.00 = 528.07' (MID NORTH)
 DATUM POINT EL +100.00 = 527.05' (END NORTH)
 DATUM POINT EL +100.00 = 532.22' (MID SOUTH WEST)
 DATUM POINT EL +100.00 = 535.26' (END SOUTH WEST)

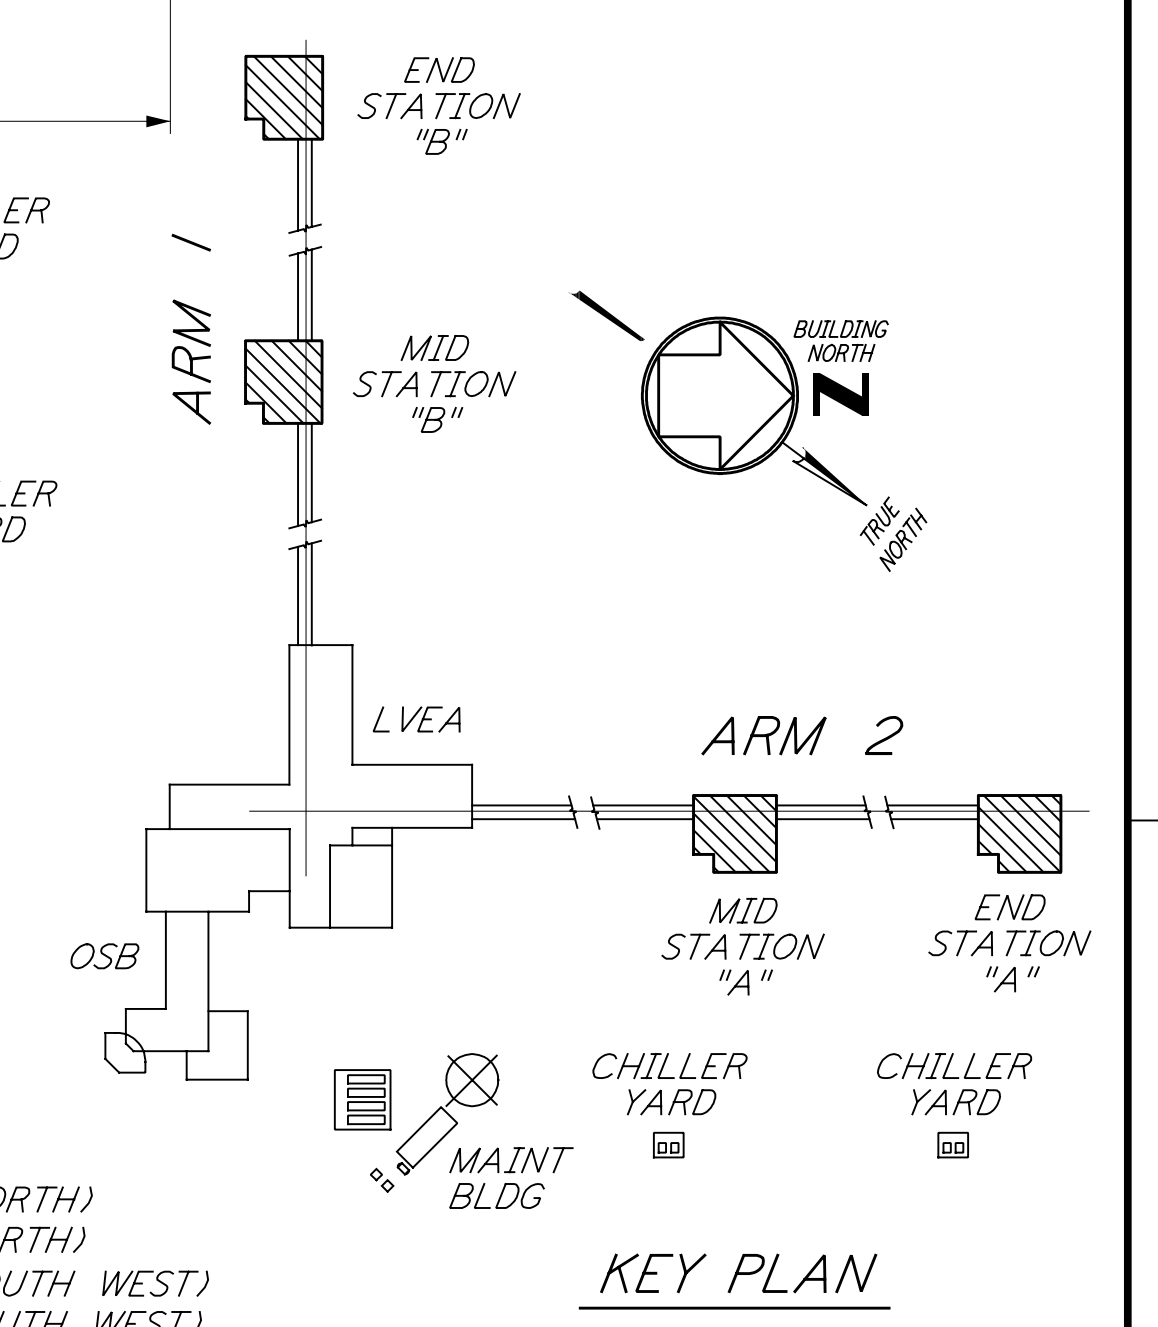

KEY PLAN

This document and the design it covers are the property of PARSONS. They are loaned only with the borrower's expressed written agreement that they will not be reproduced, copied, loaned, exhibited, or used in any other way, except by written consent from PARSONS to the borrower.

NO.	DATE	BY	CHKD	ENGR	PROJ	DESCRIPTION
1	5-15-98	CKT				ISSUED FOR AS-BUILT

ISSUED FOR CONSTRUCTION		
DRAWN	CKT	5-12-96
CHECKED	TB	5-26-96
ENGINEER	bkk	7-12-96
PROJ	MDW	7-12-96

AS-BUILT DRAWINGS



LASER INTERFEROMETER GRAVITATIONAL-WAVE OBSERVATORY SITE NO. 1 - HANFORD, WASHINGTON

TITLE	ARCHITECTURAL MID & END STATIONS REFLECTED CEILING PLAN & ROOF PLAN	SCALE	AS NOTED	SHEET NUMBER	PP150969	PROJECT NUMBER	8094
			SHEET NUMBER		PROJECT NUMBER		
			WA-A-221				

Note 1, Linda L Turner, 04/14/99 08:50:57 AM
LIGO-D960261-01-O