




This document and the design it covers are the property of PARSONS. They are loaned only with the borrower's expressed written agreement that they will not be reproduced, copied, loaned, exhibited, or used in any other way, except by written consent from PARSONS to the borrower.

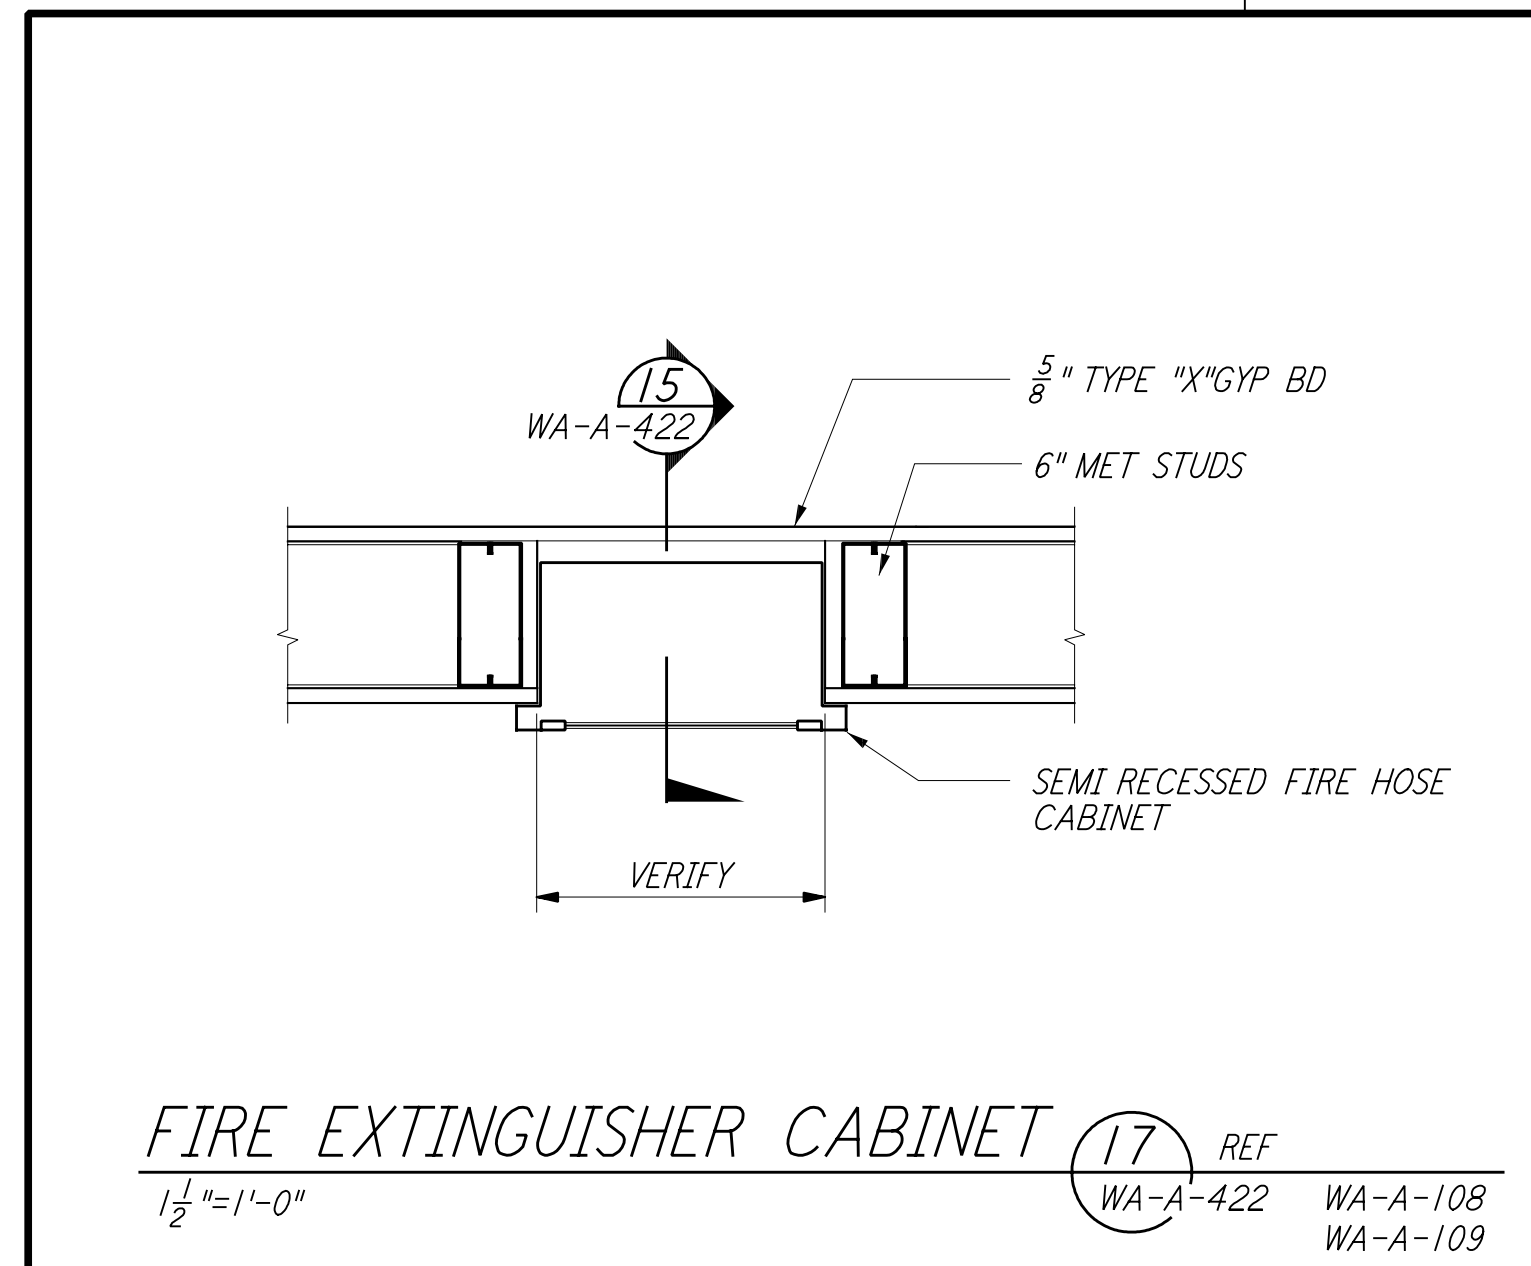


17 FIRE EXTINGUISHER CABINET
 1 1/2\"/>

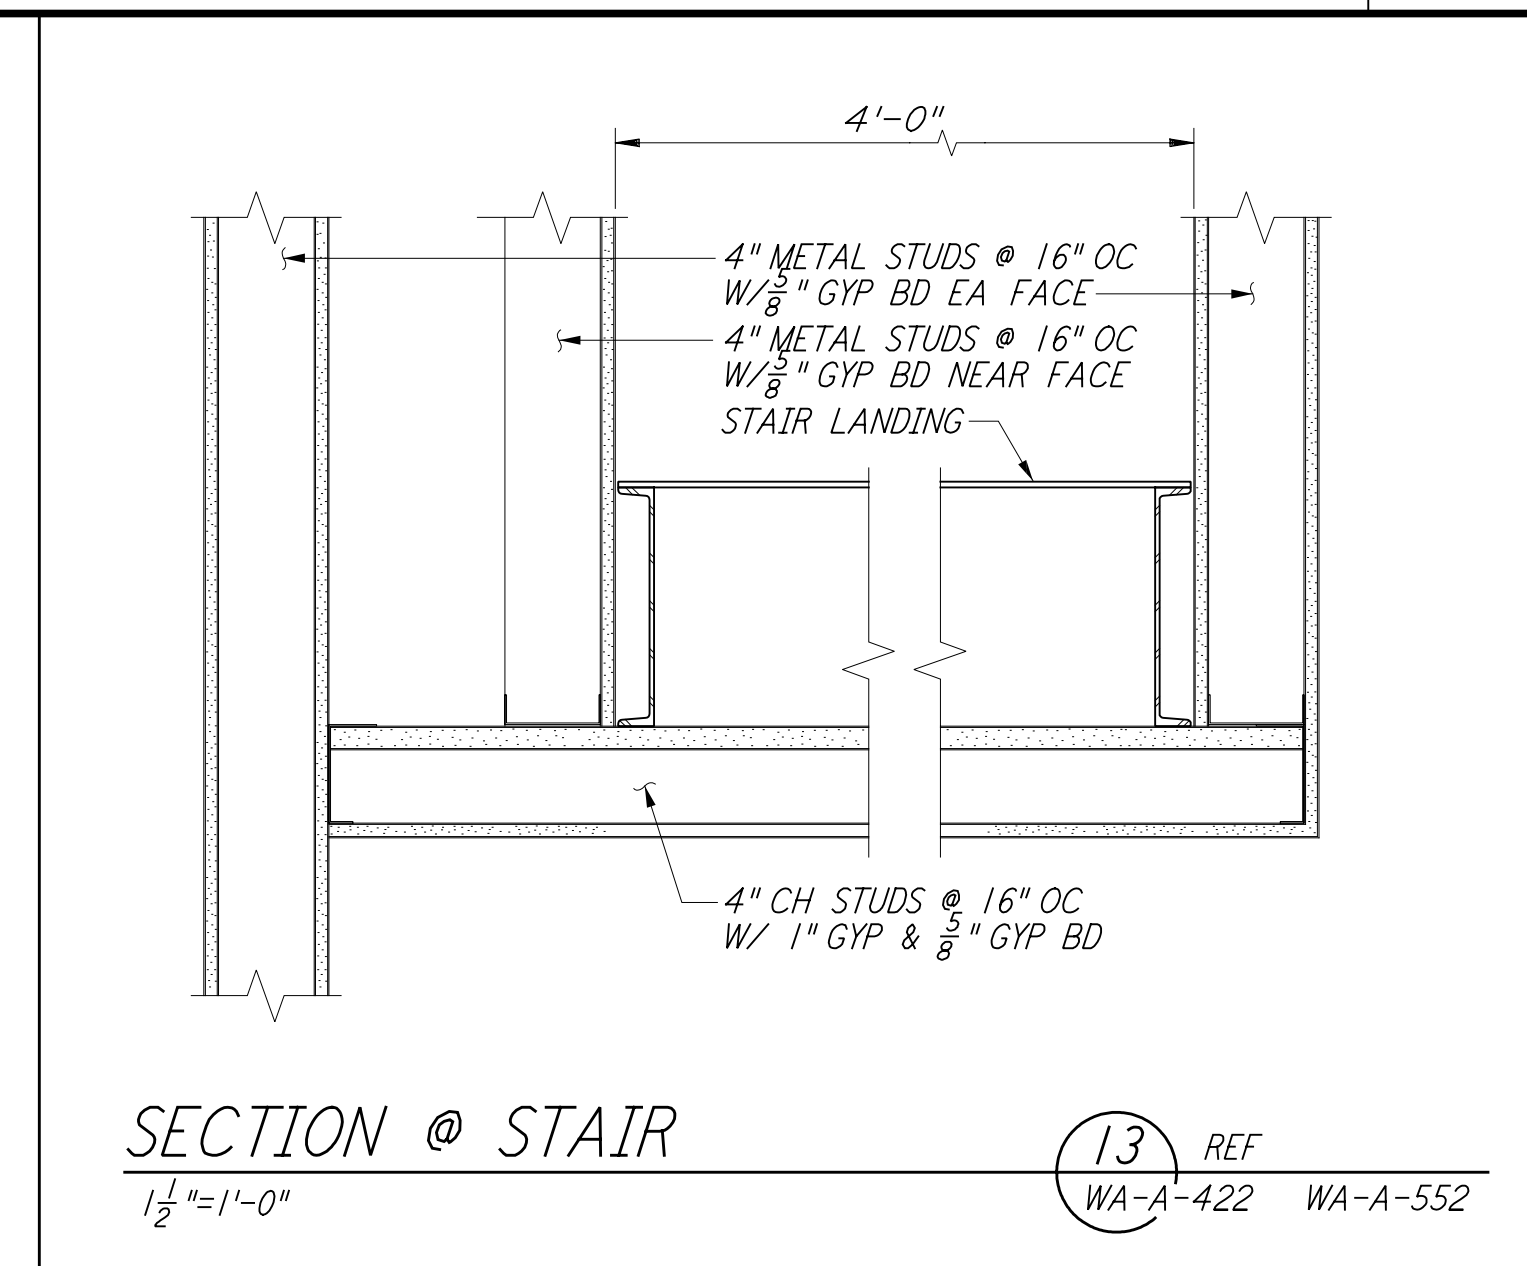


13 SECTION @ STAIR
 1 1/2\"/>

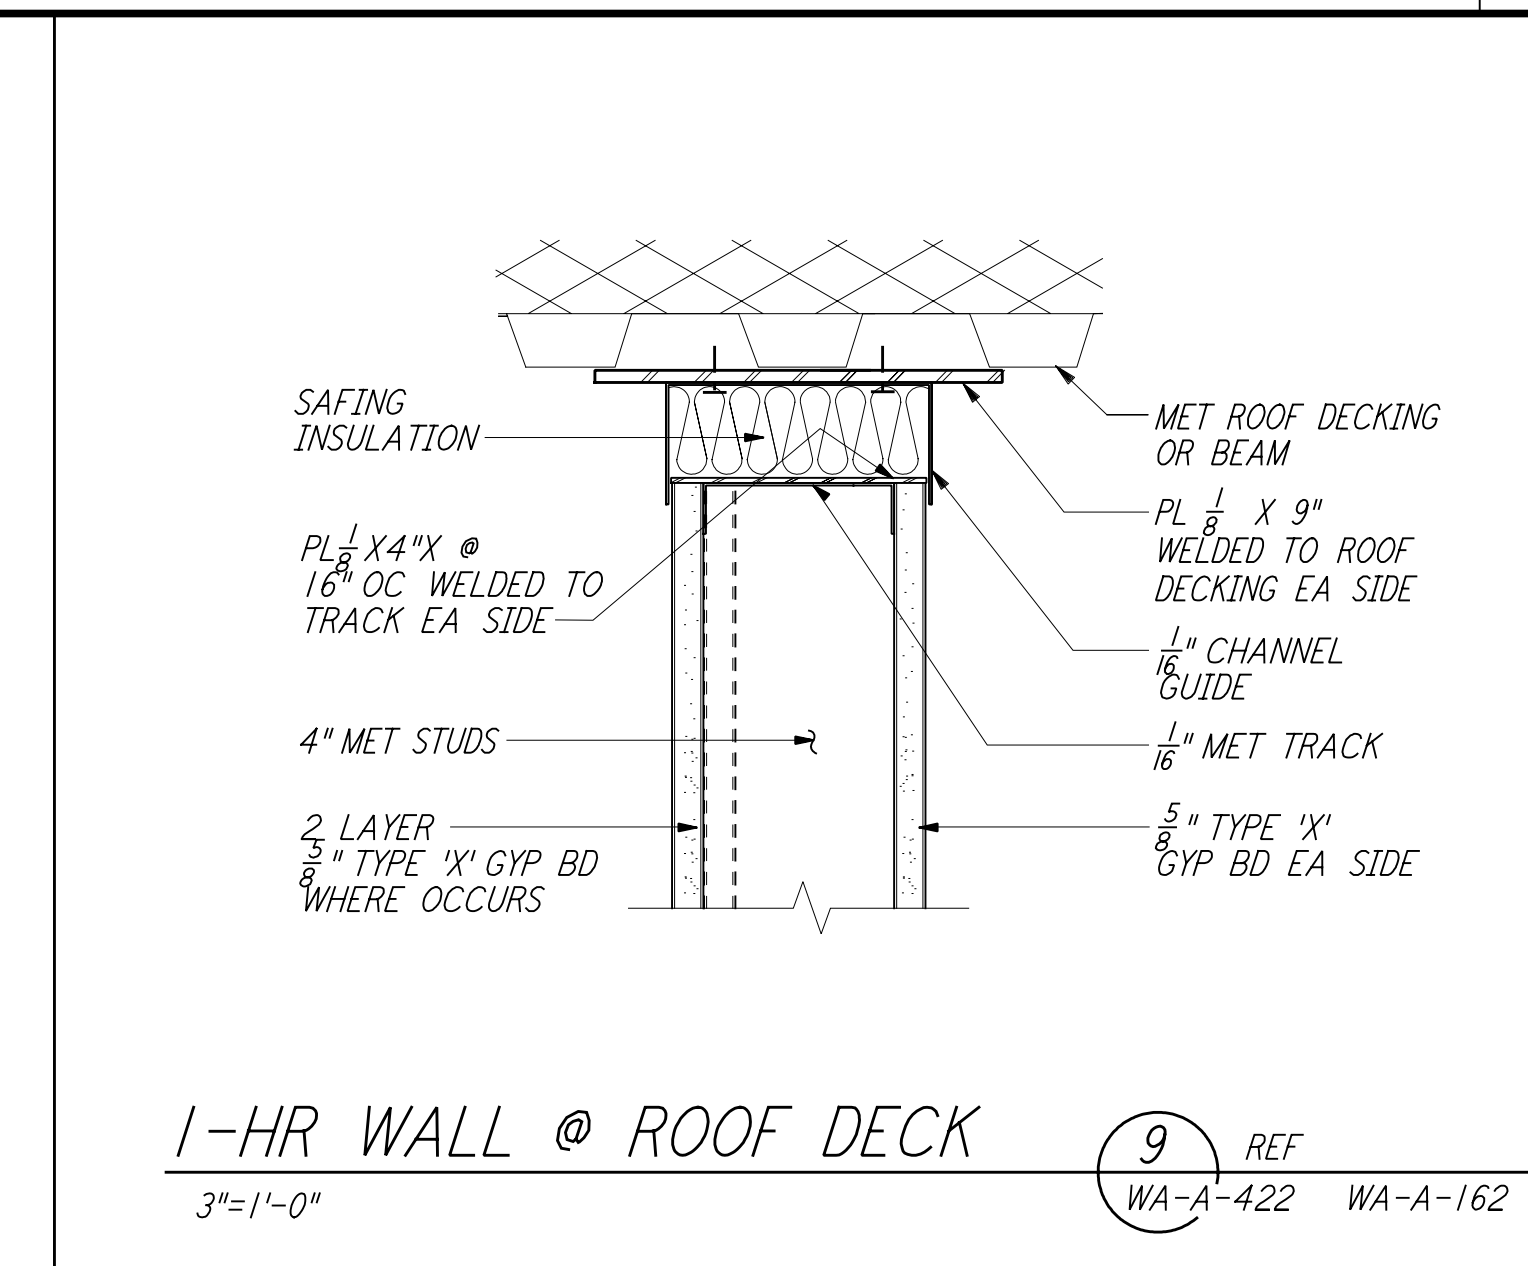


9 1-HR WALL @ ROOF DECK
 3\"/>

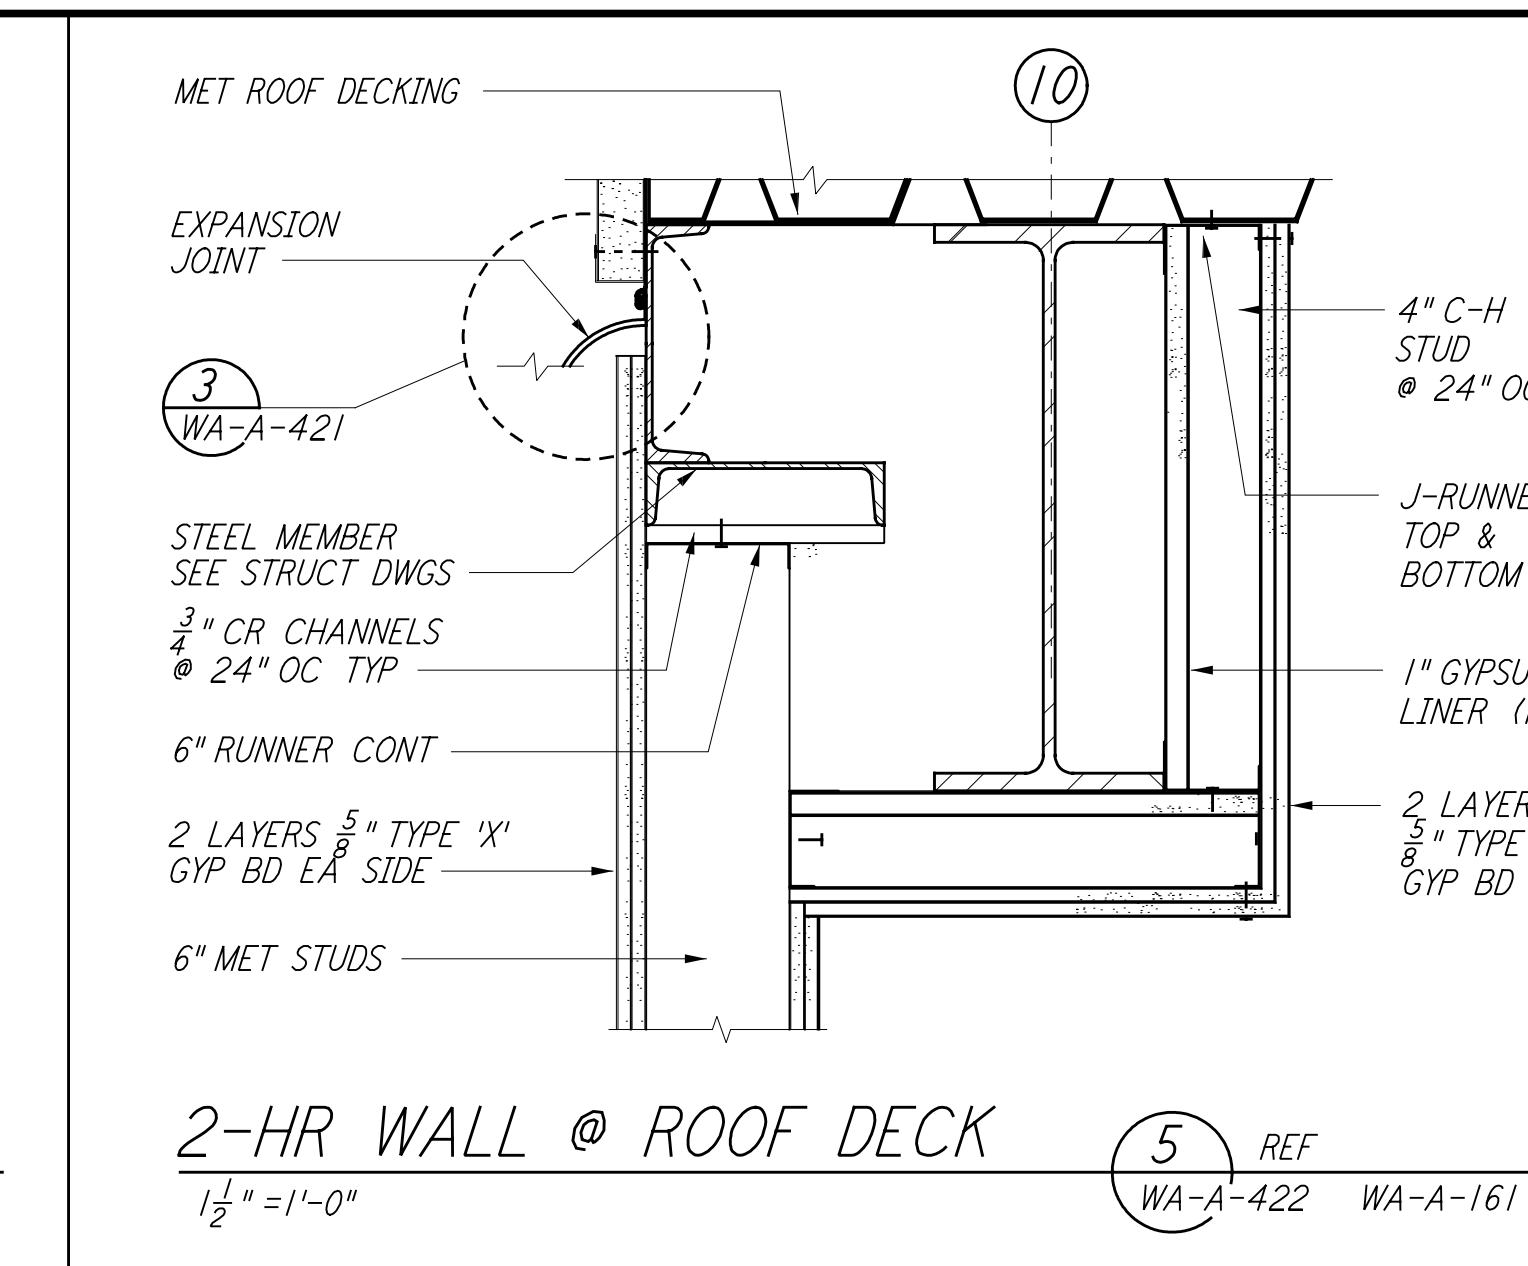


5 2-HR WALL @ ROOF DECK
 1 1/2\"/>

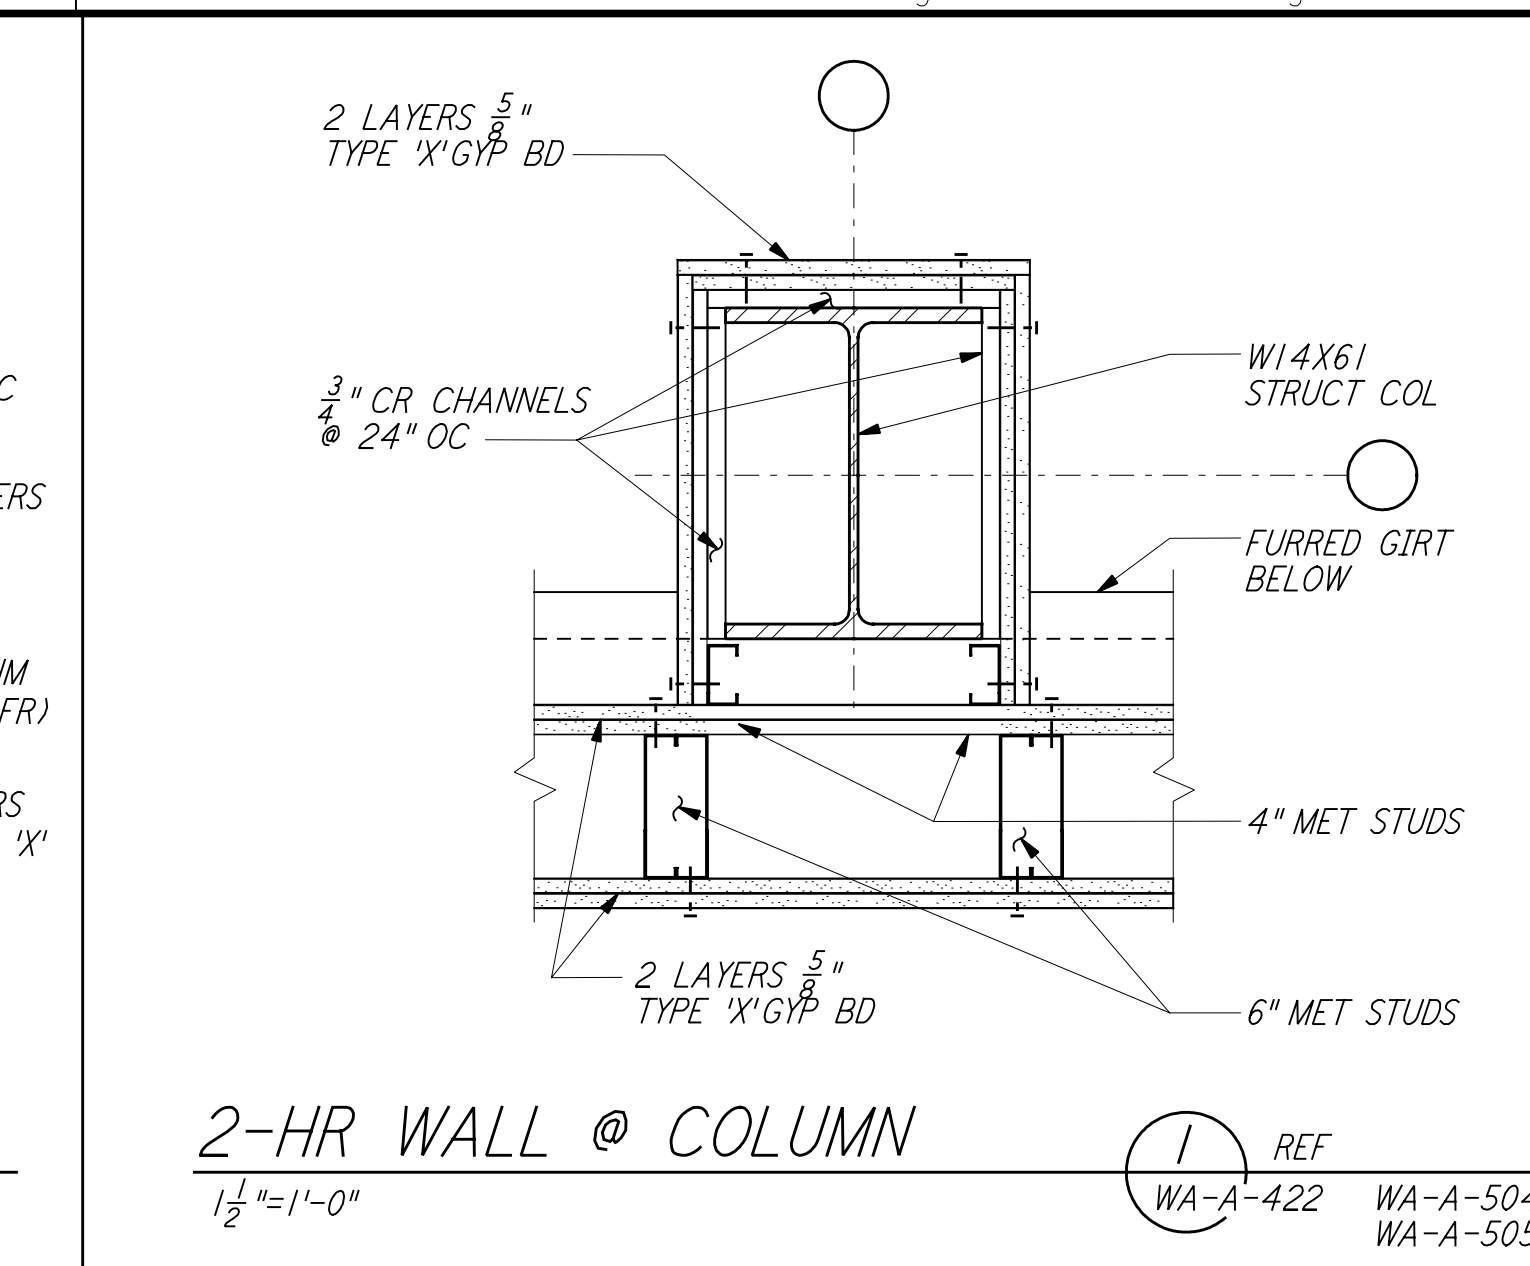


1 2-HR WALL @ COLUMN
 1 1/2\"/>

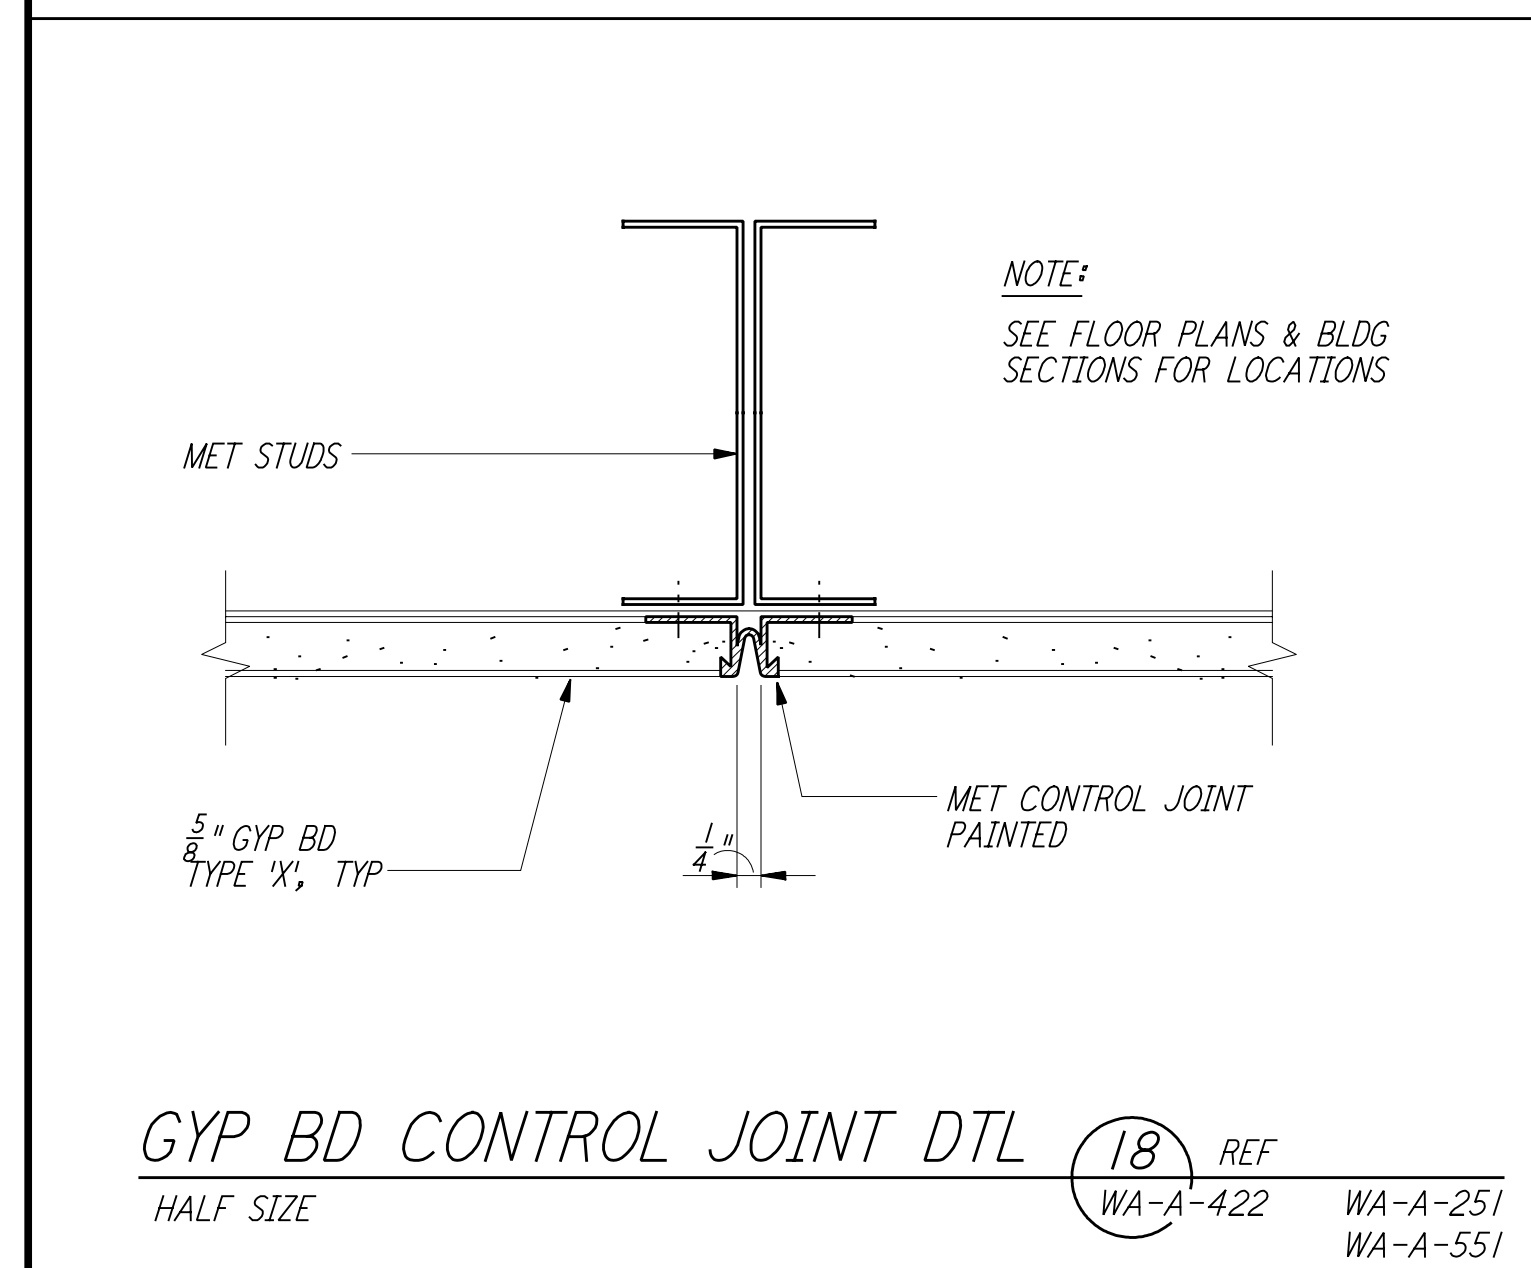


18 GYP BD CONTROL JOINT DTL
 HALF SIZE

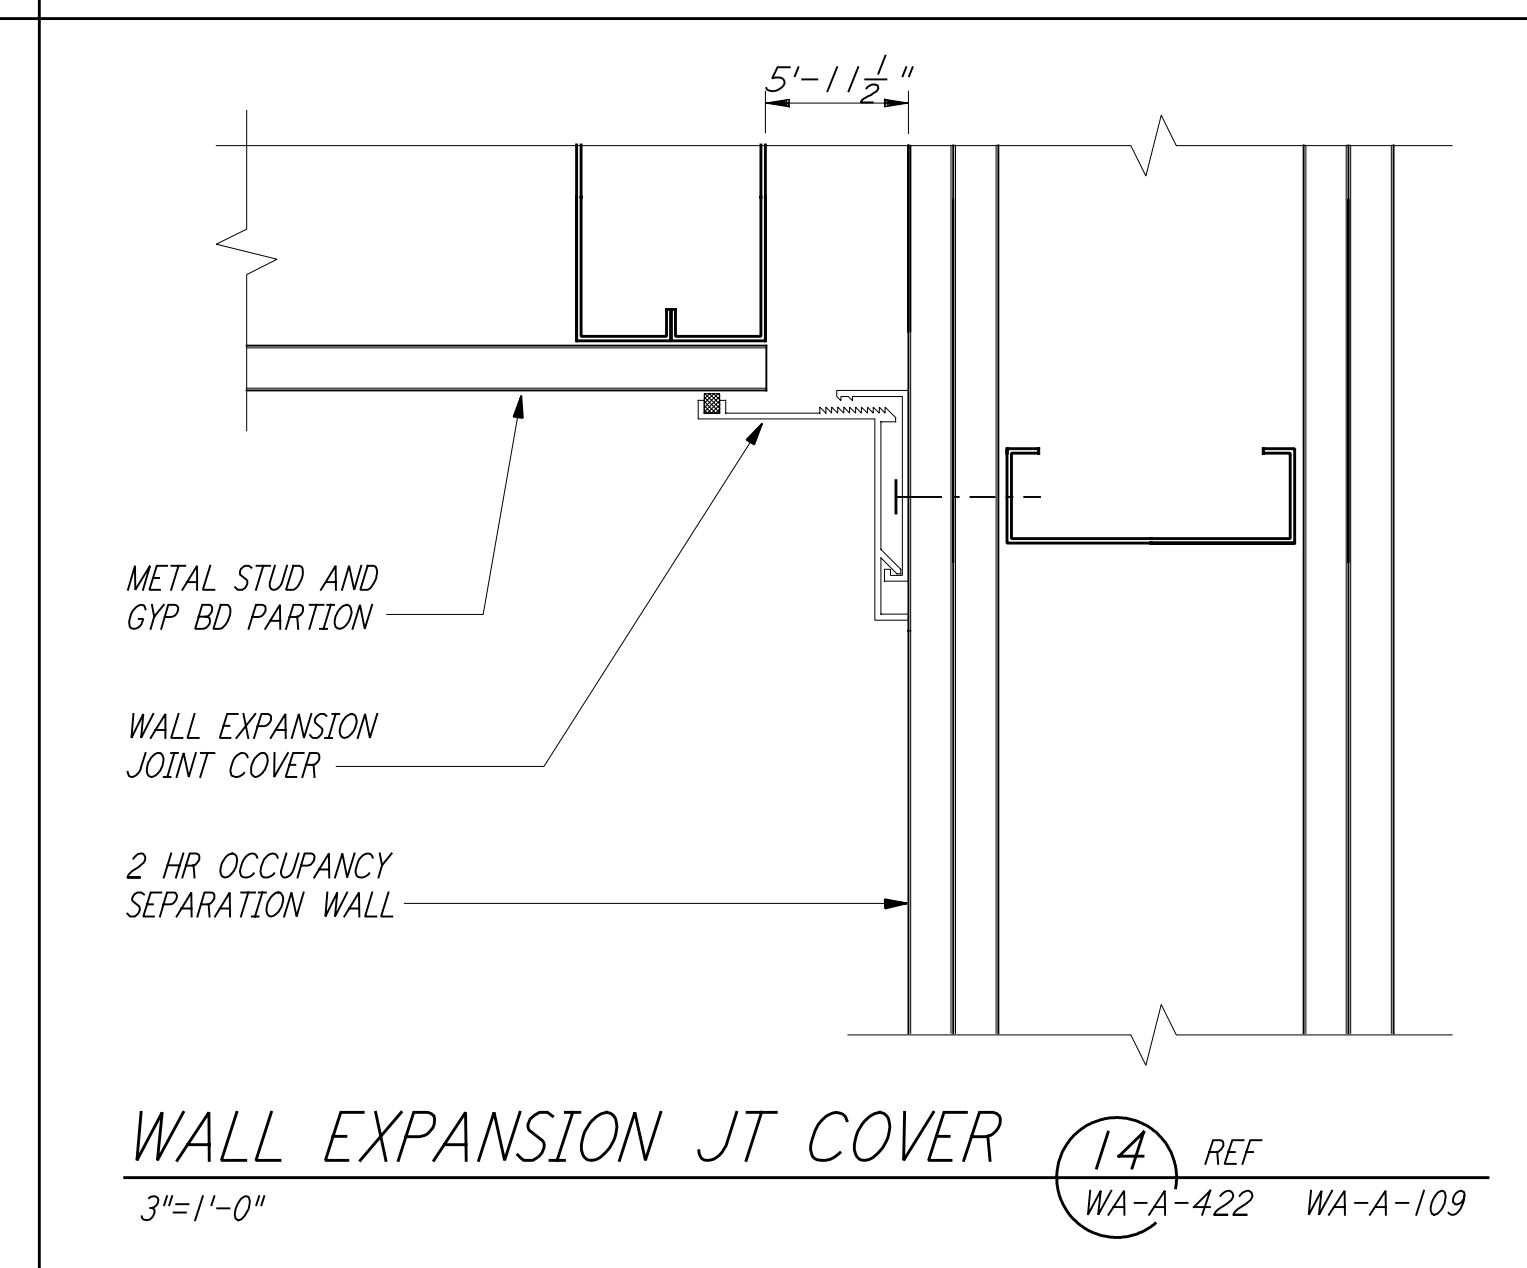


14 WALL EXPANSION JT COVER
 3\"/>

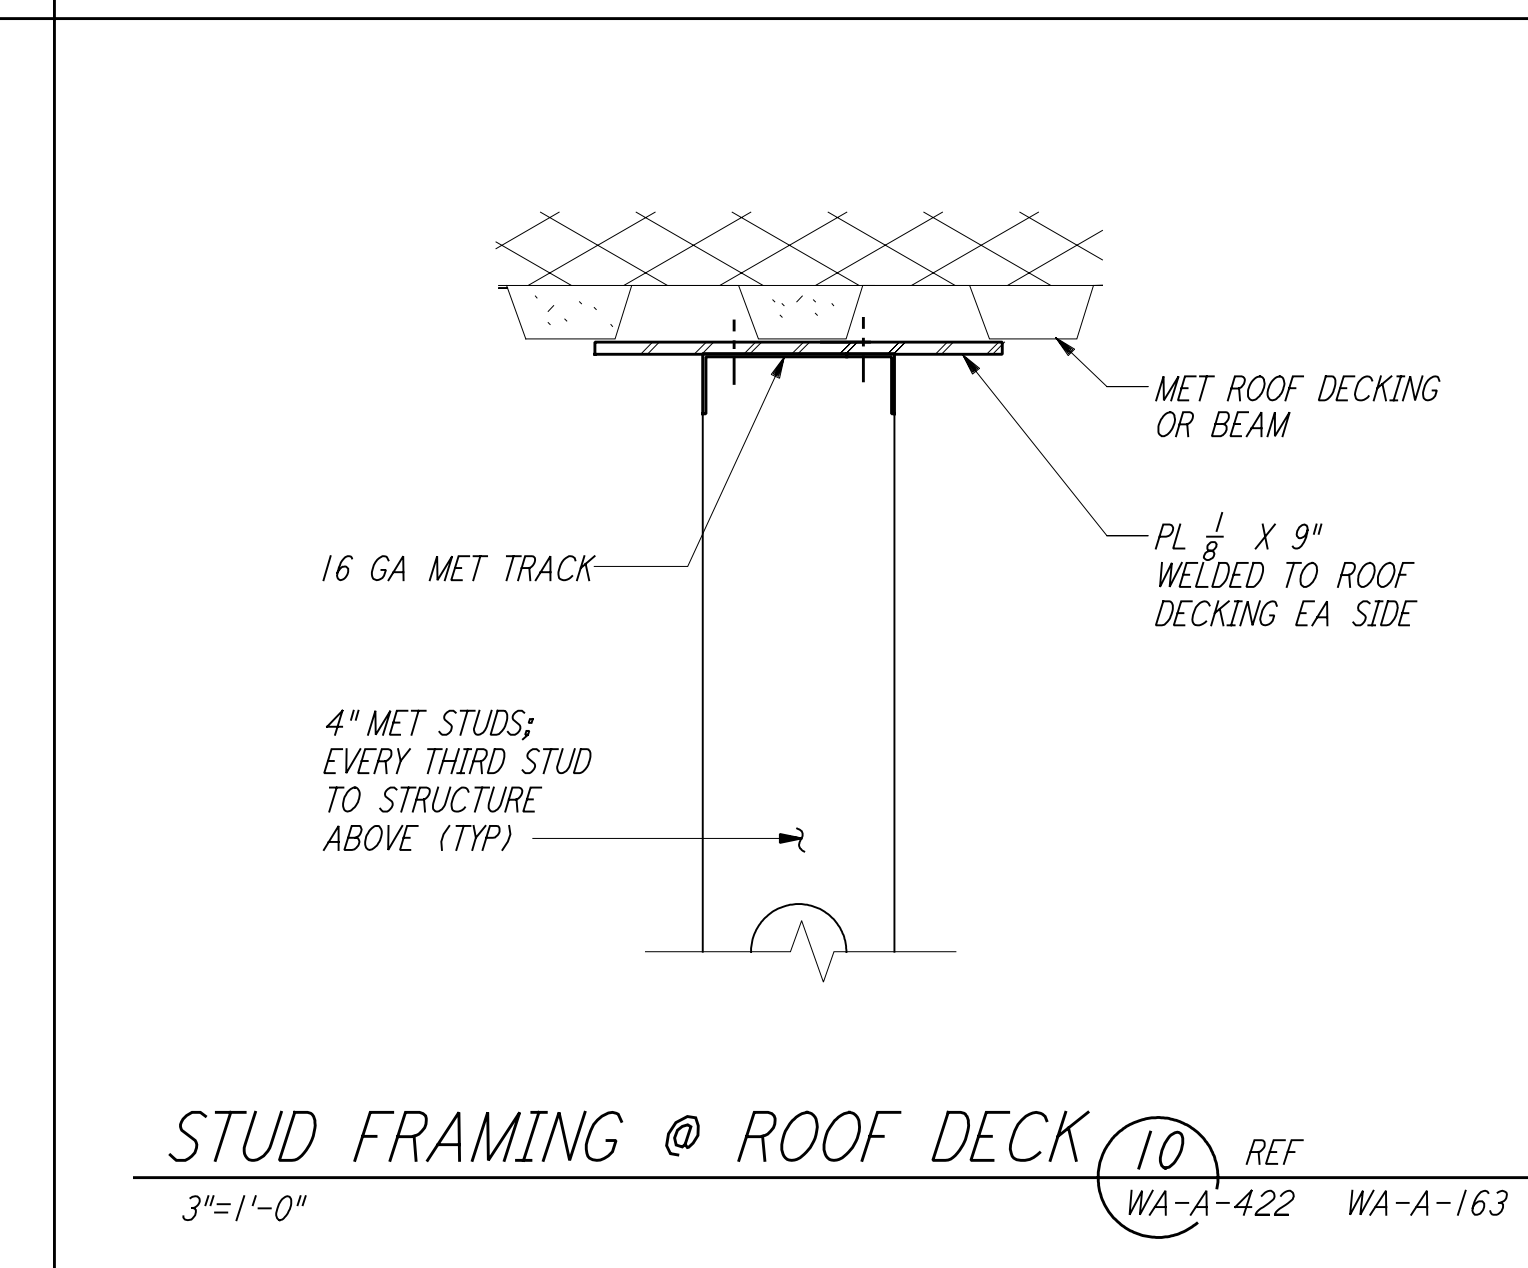


10 STUD FRAMING @ ROOF DECK
 3\"/>

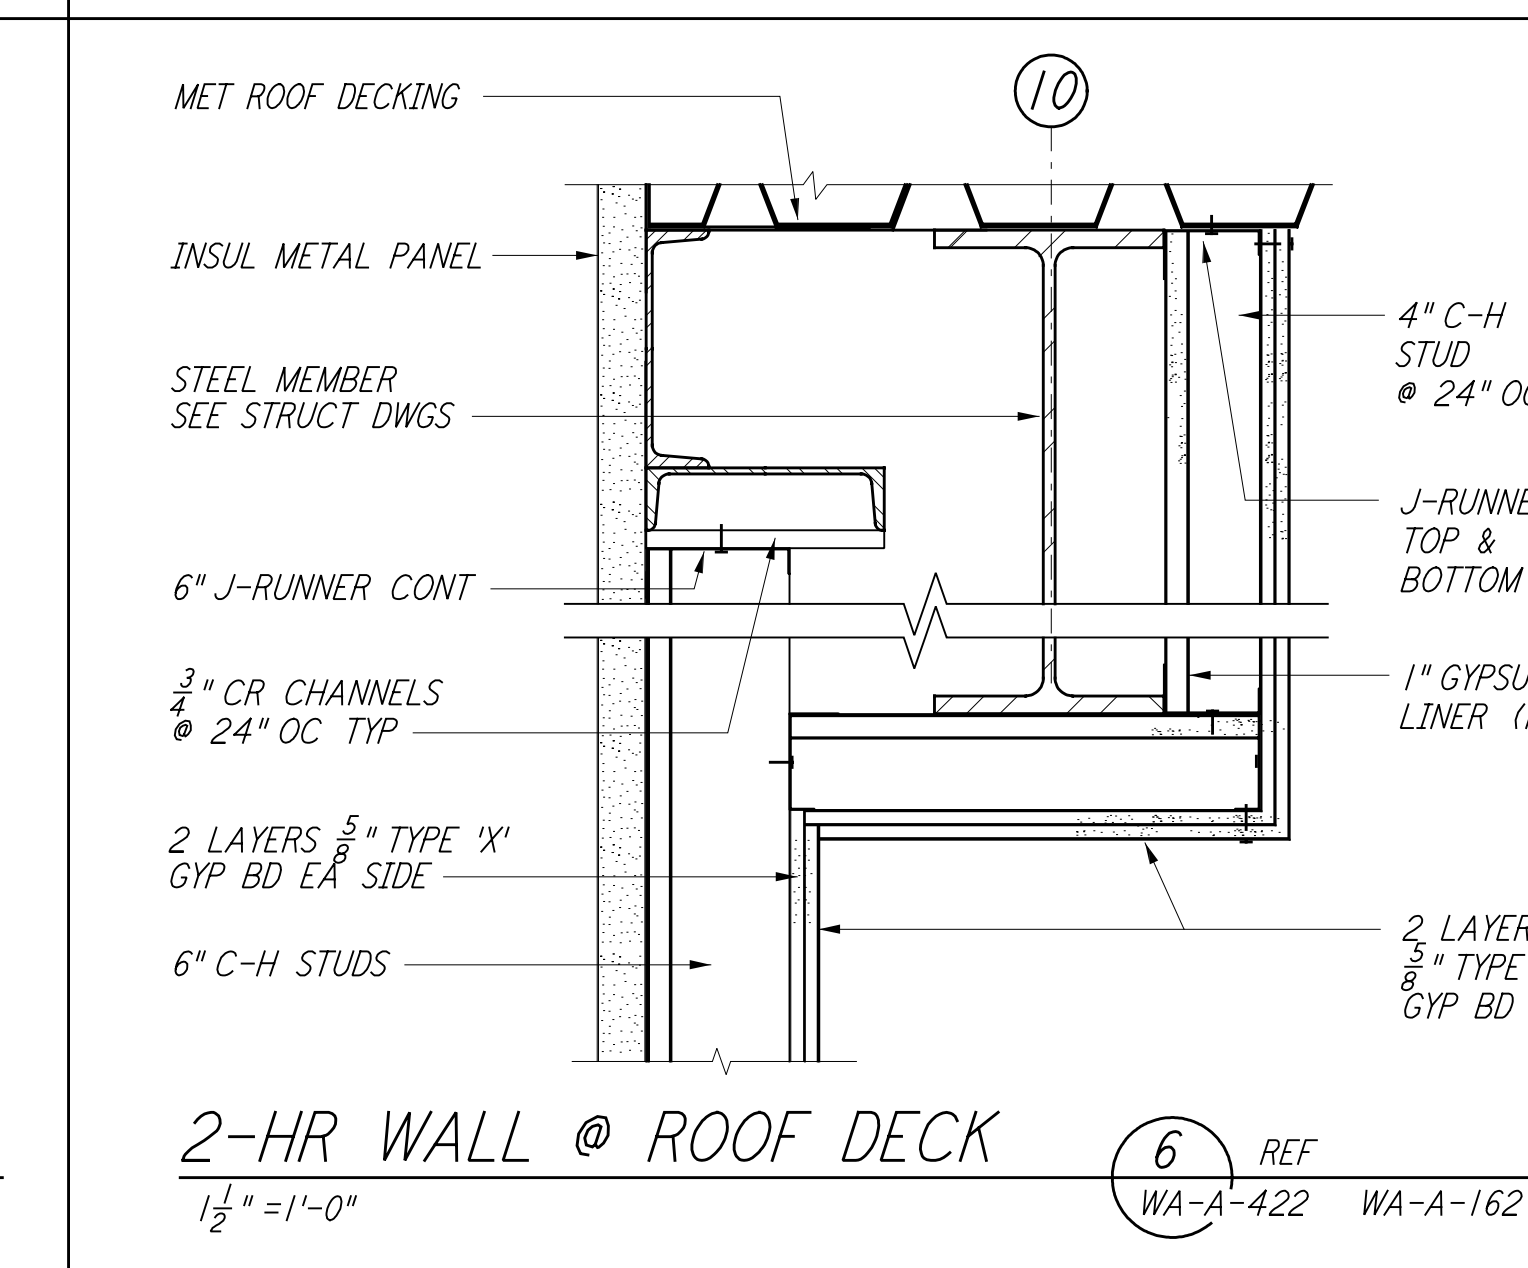


6 2-HR WALL @ ROOF DECK
 1 1/2\"/>

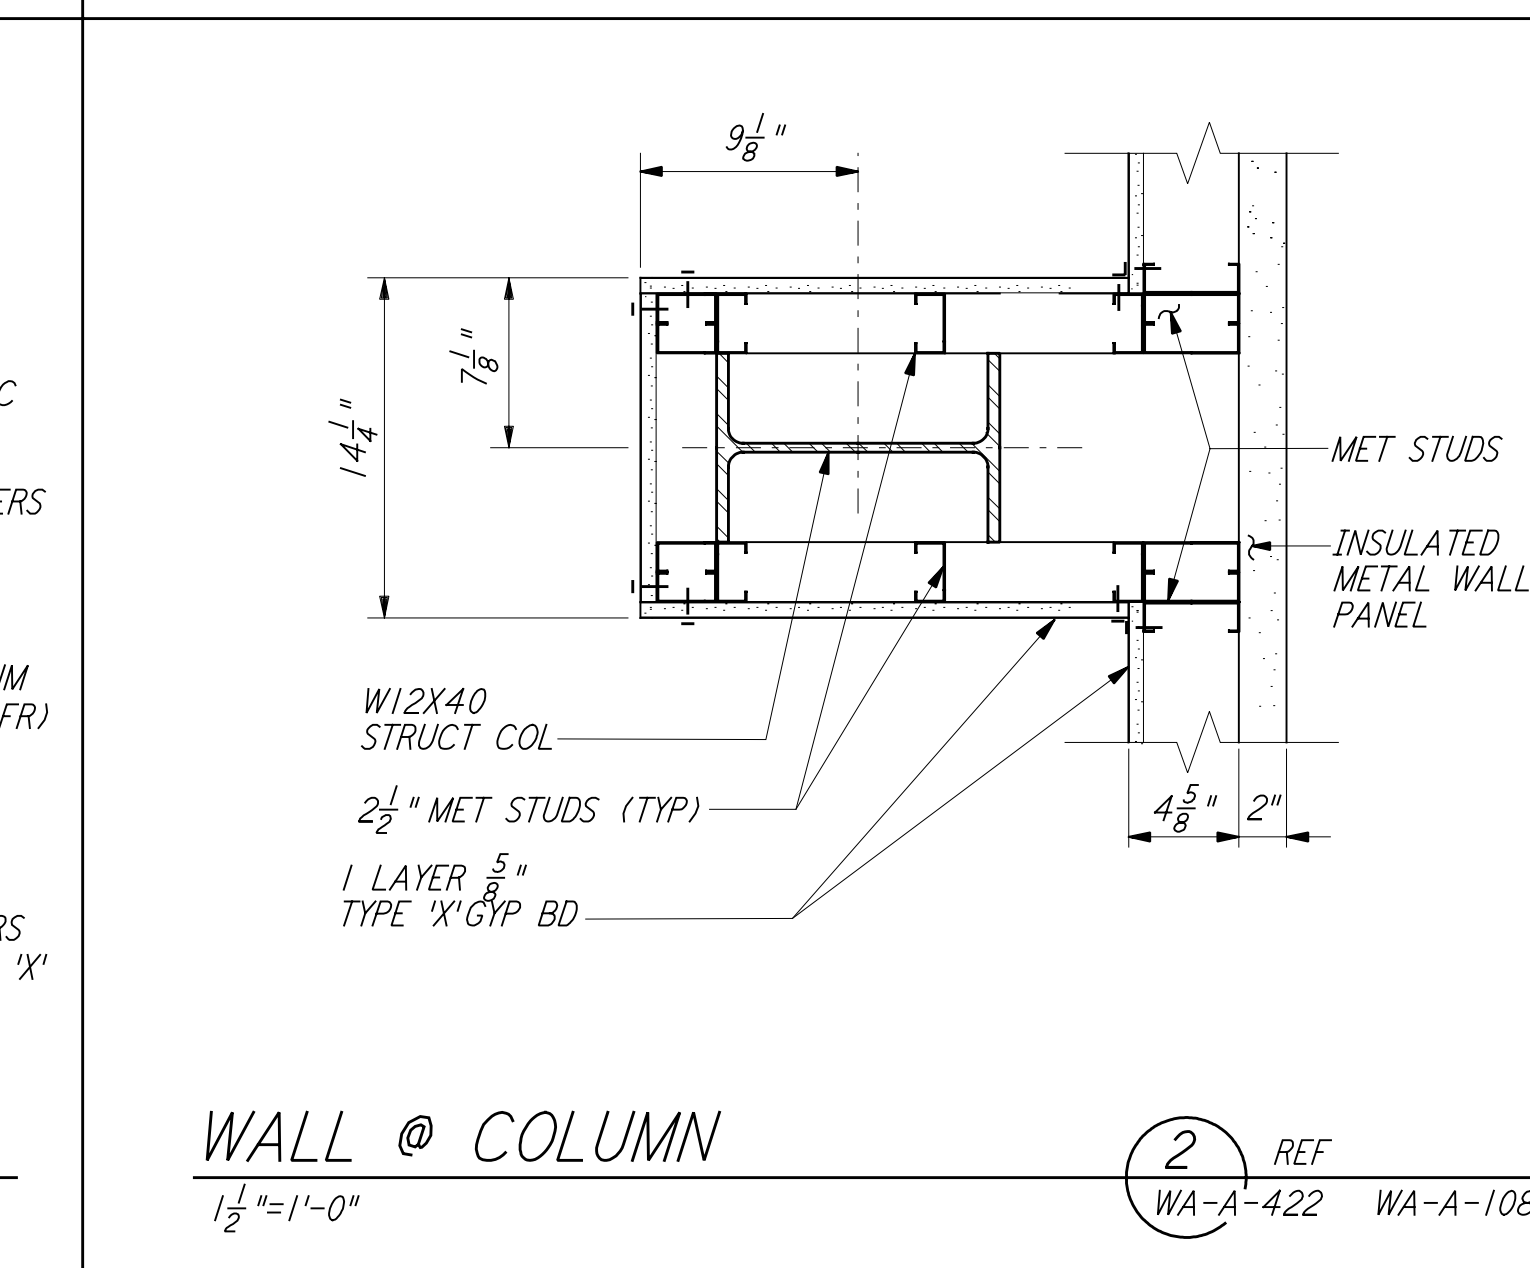


2 WALL @ COLUMN
 1 1/2\"/>

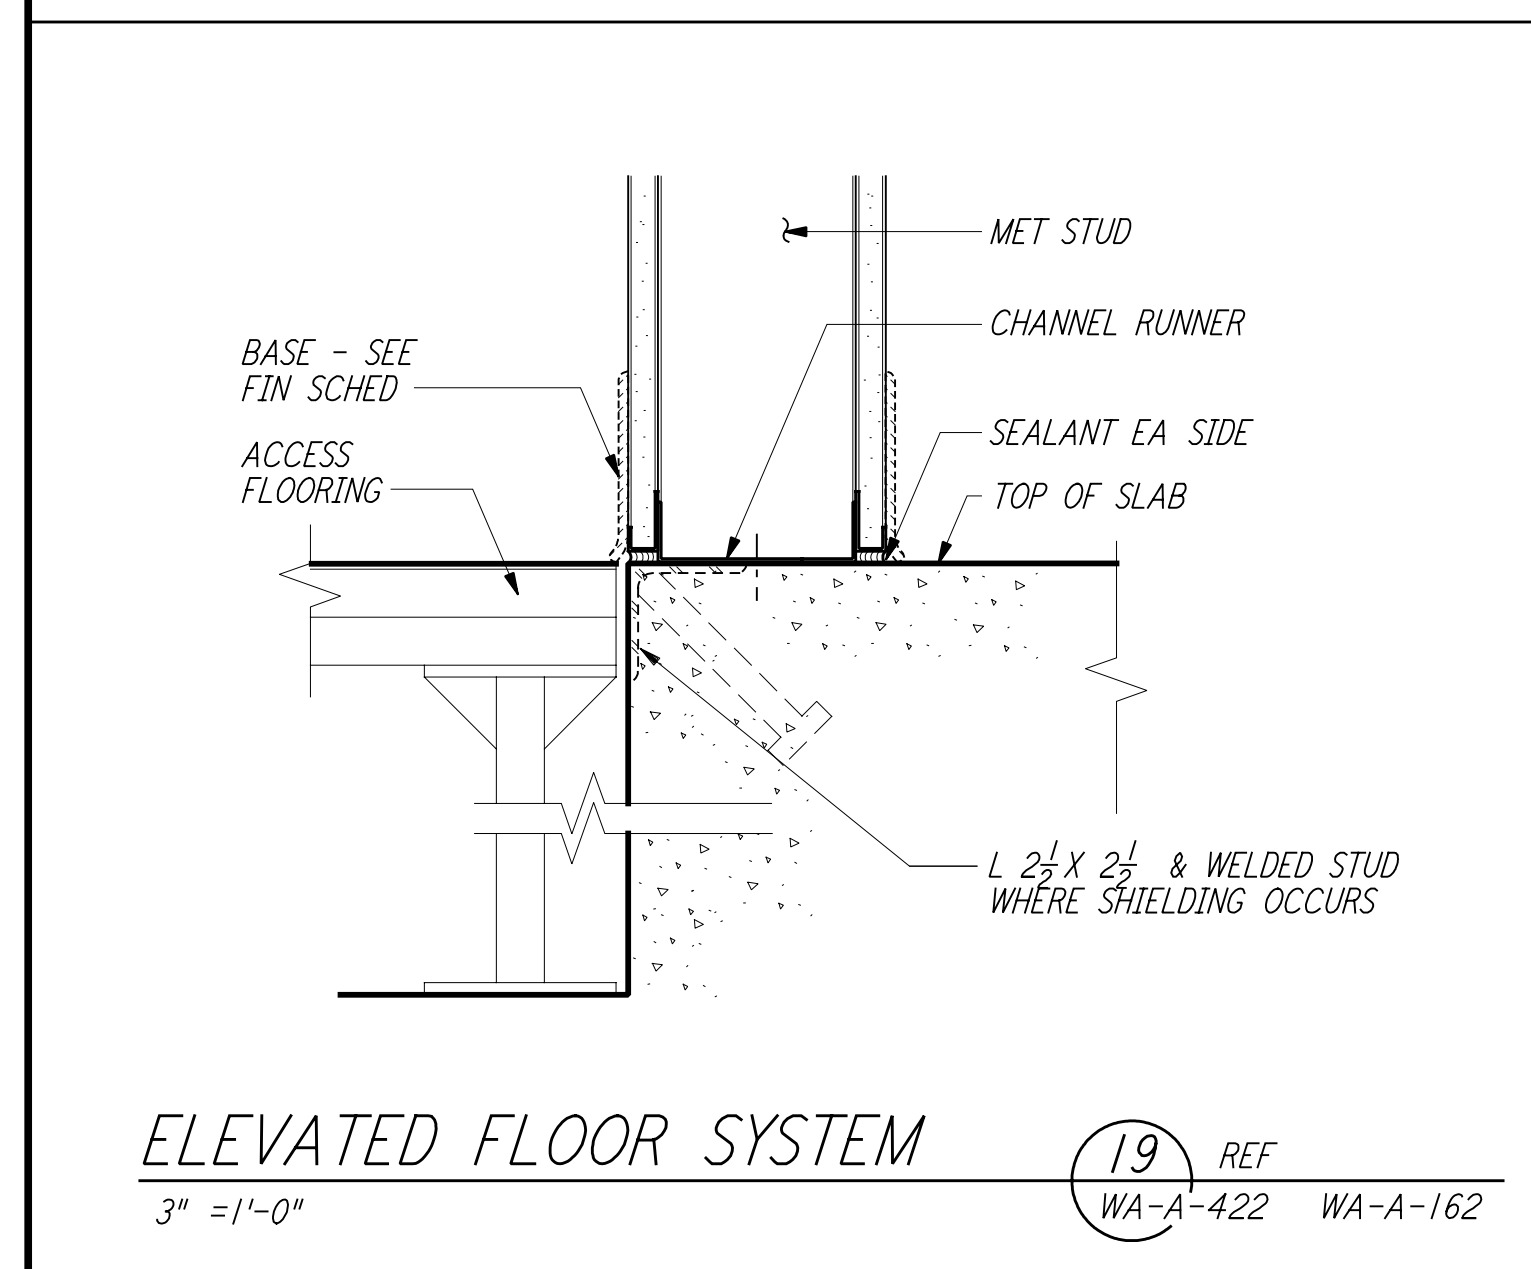


19 ELEVATED FLOOR SYSTEM
 3\"/>

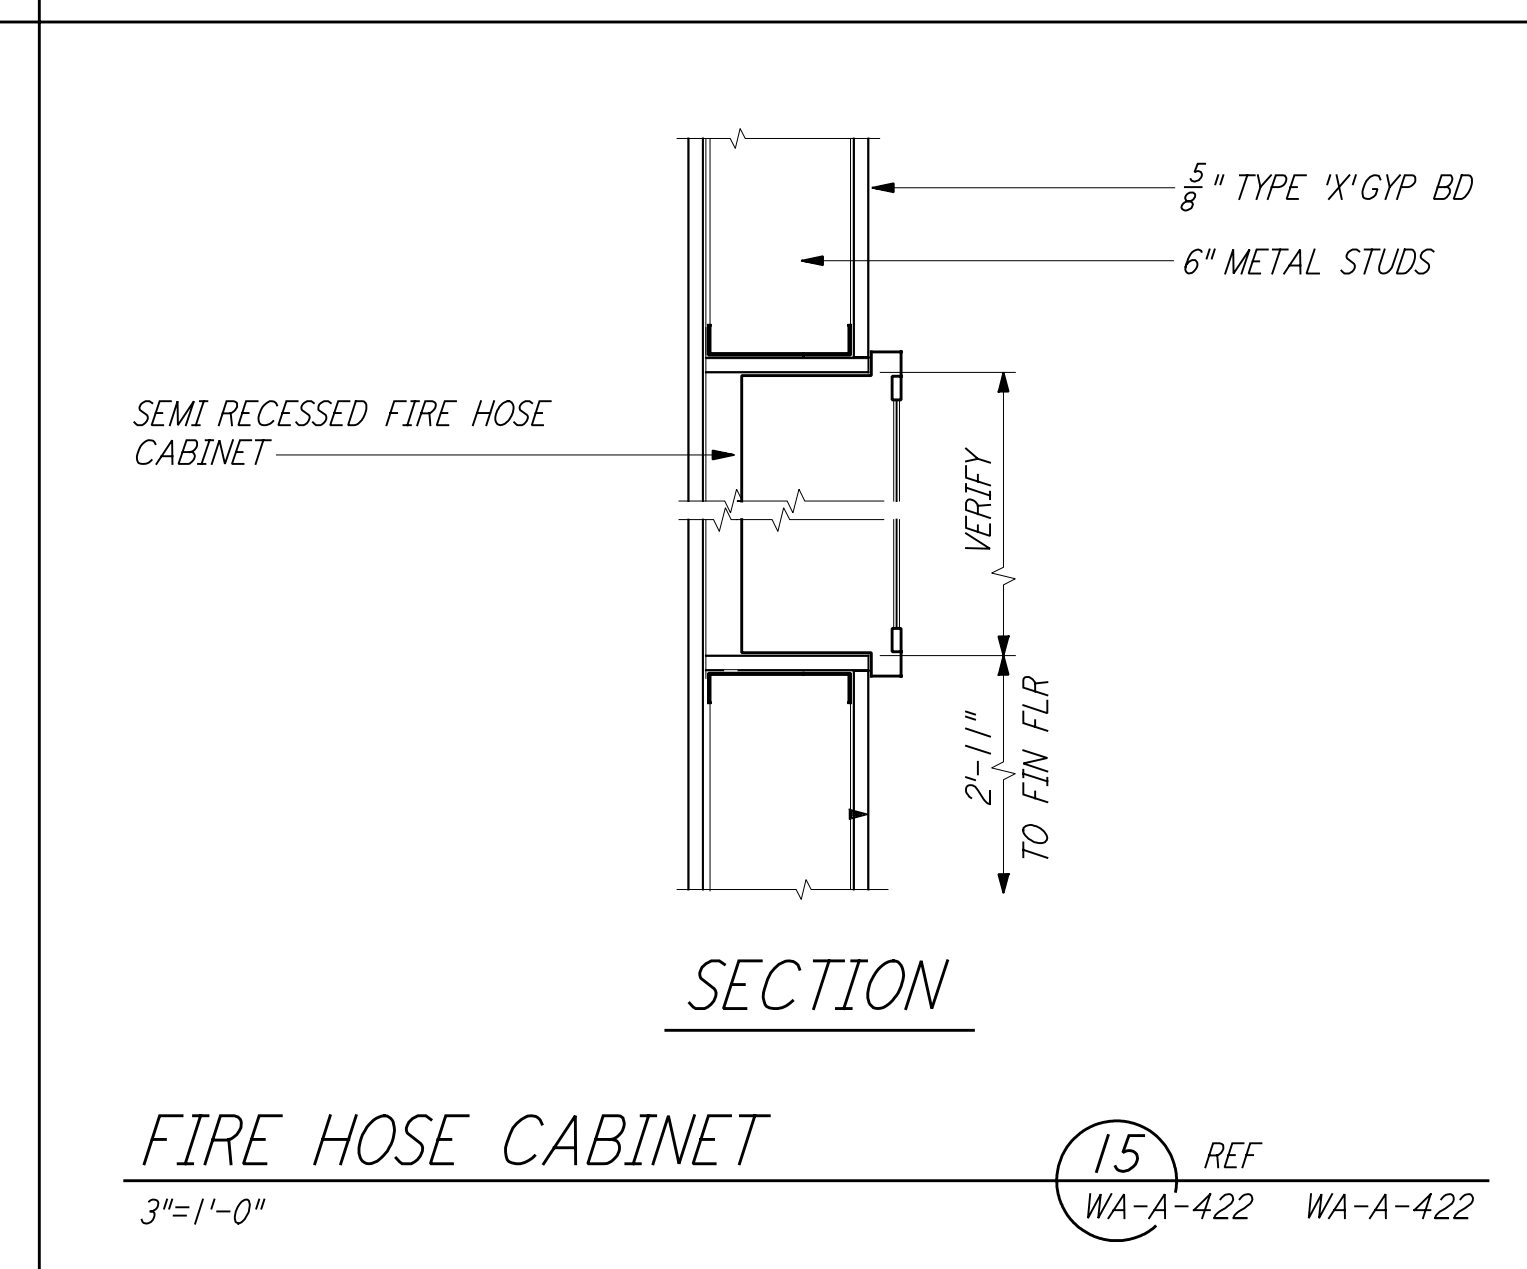


15 FIRE HOSE CABINET
 3\"/>

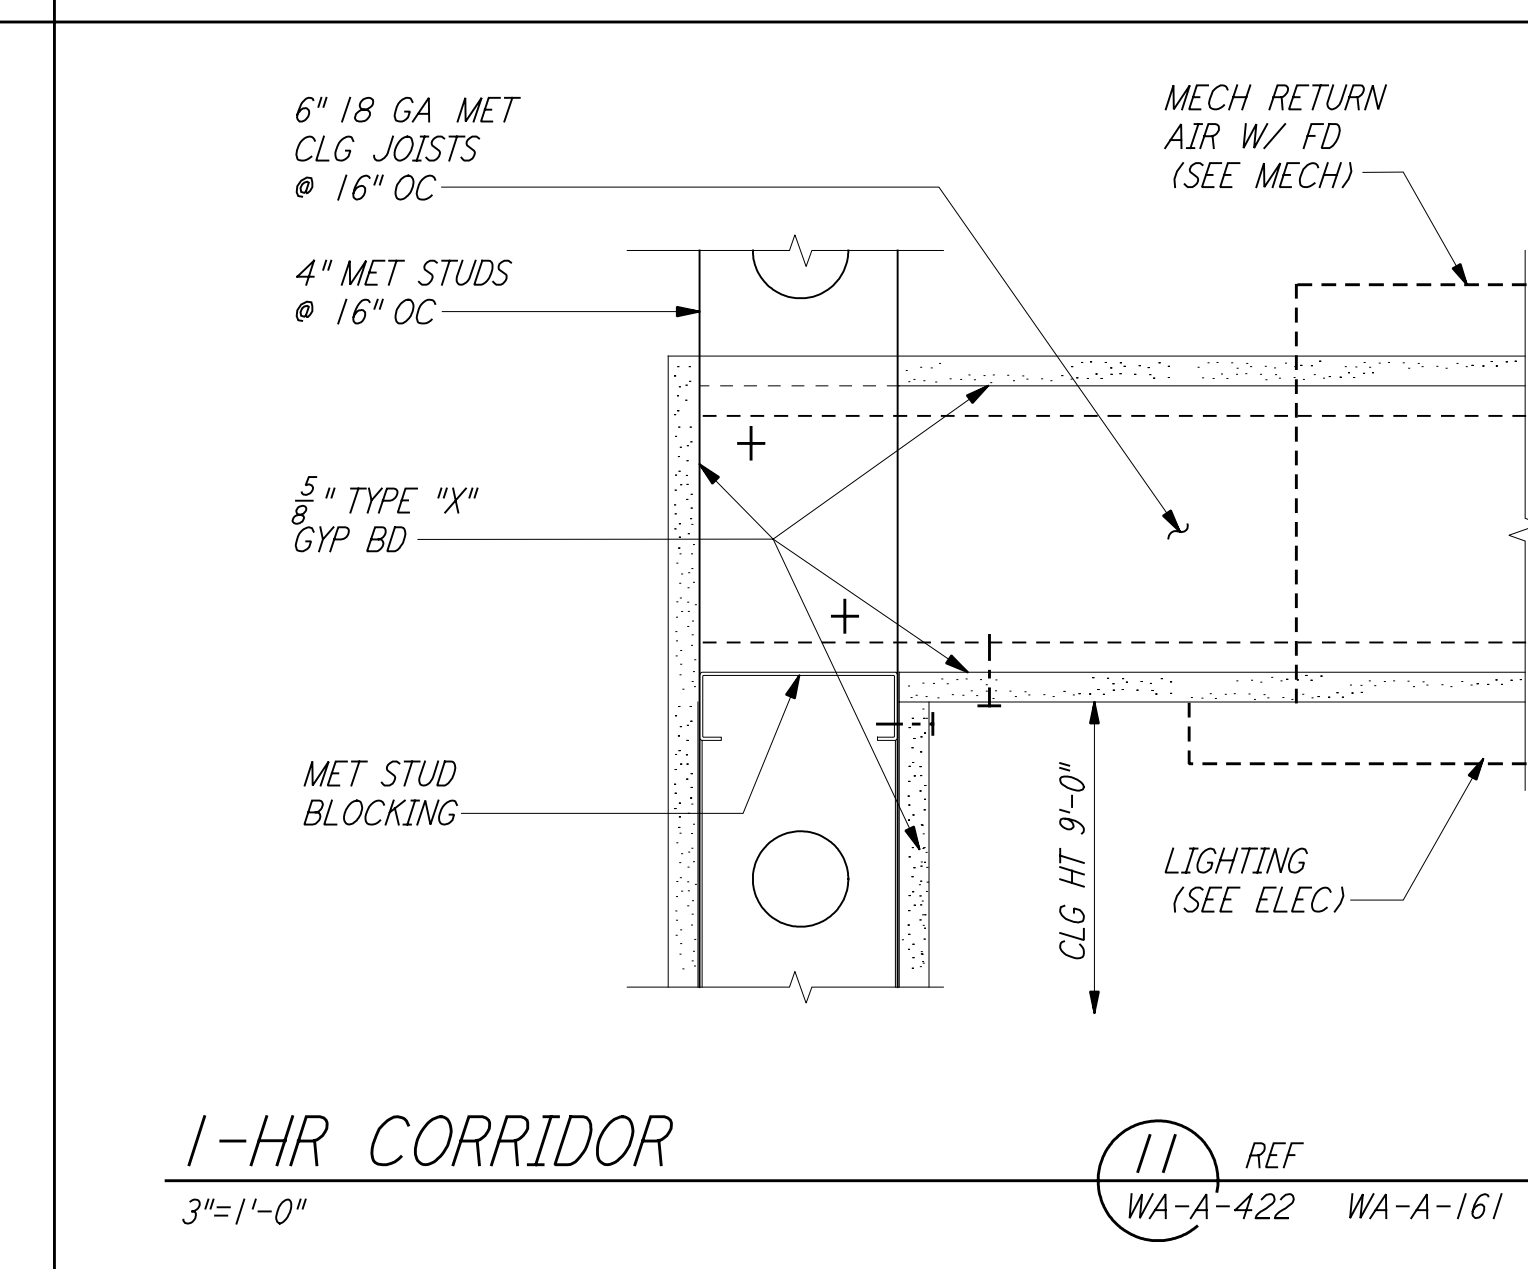


11 1-HR CORRIDOR
 3\"/>

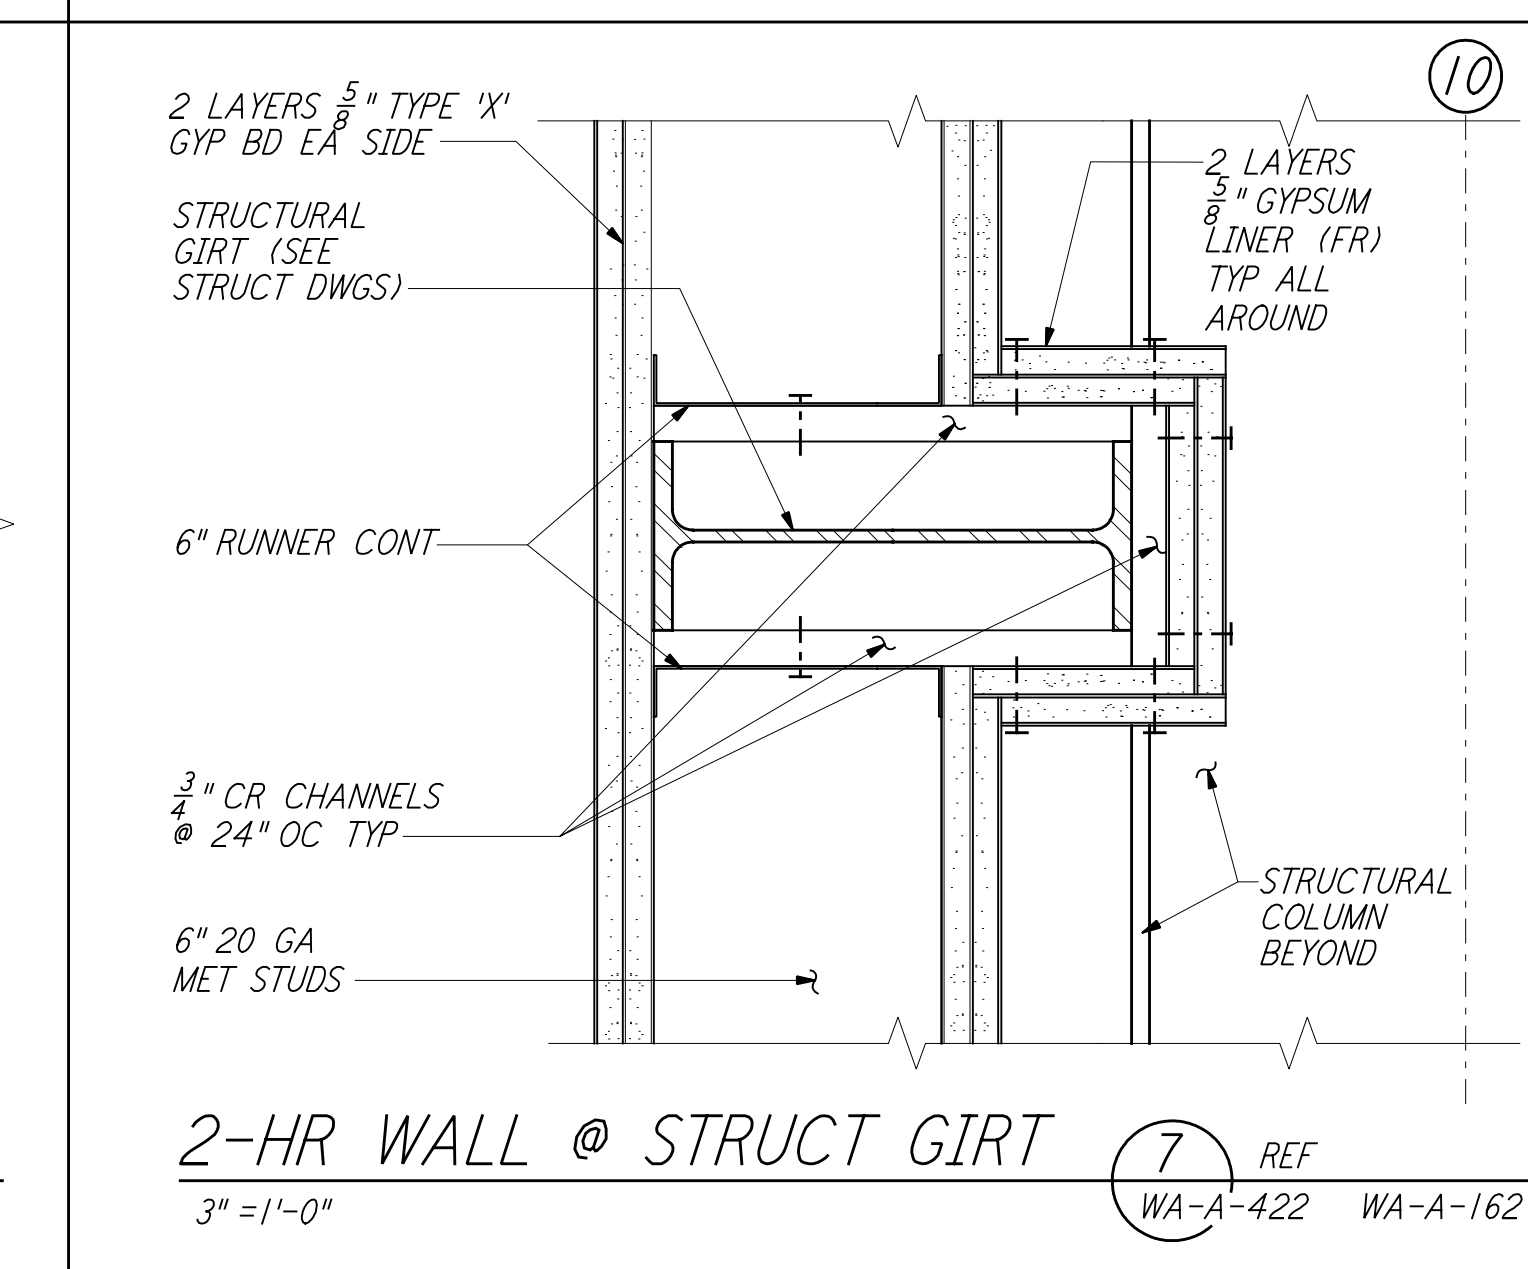


7 2-HR WALL @ STRUCT GIRT
 3\"/>

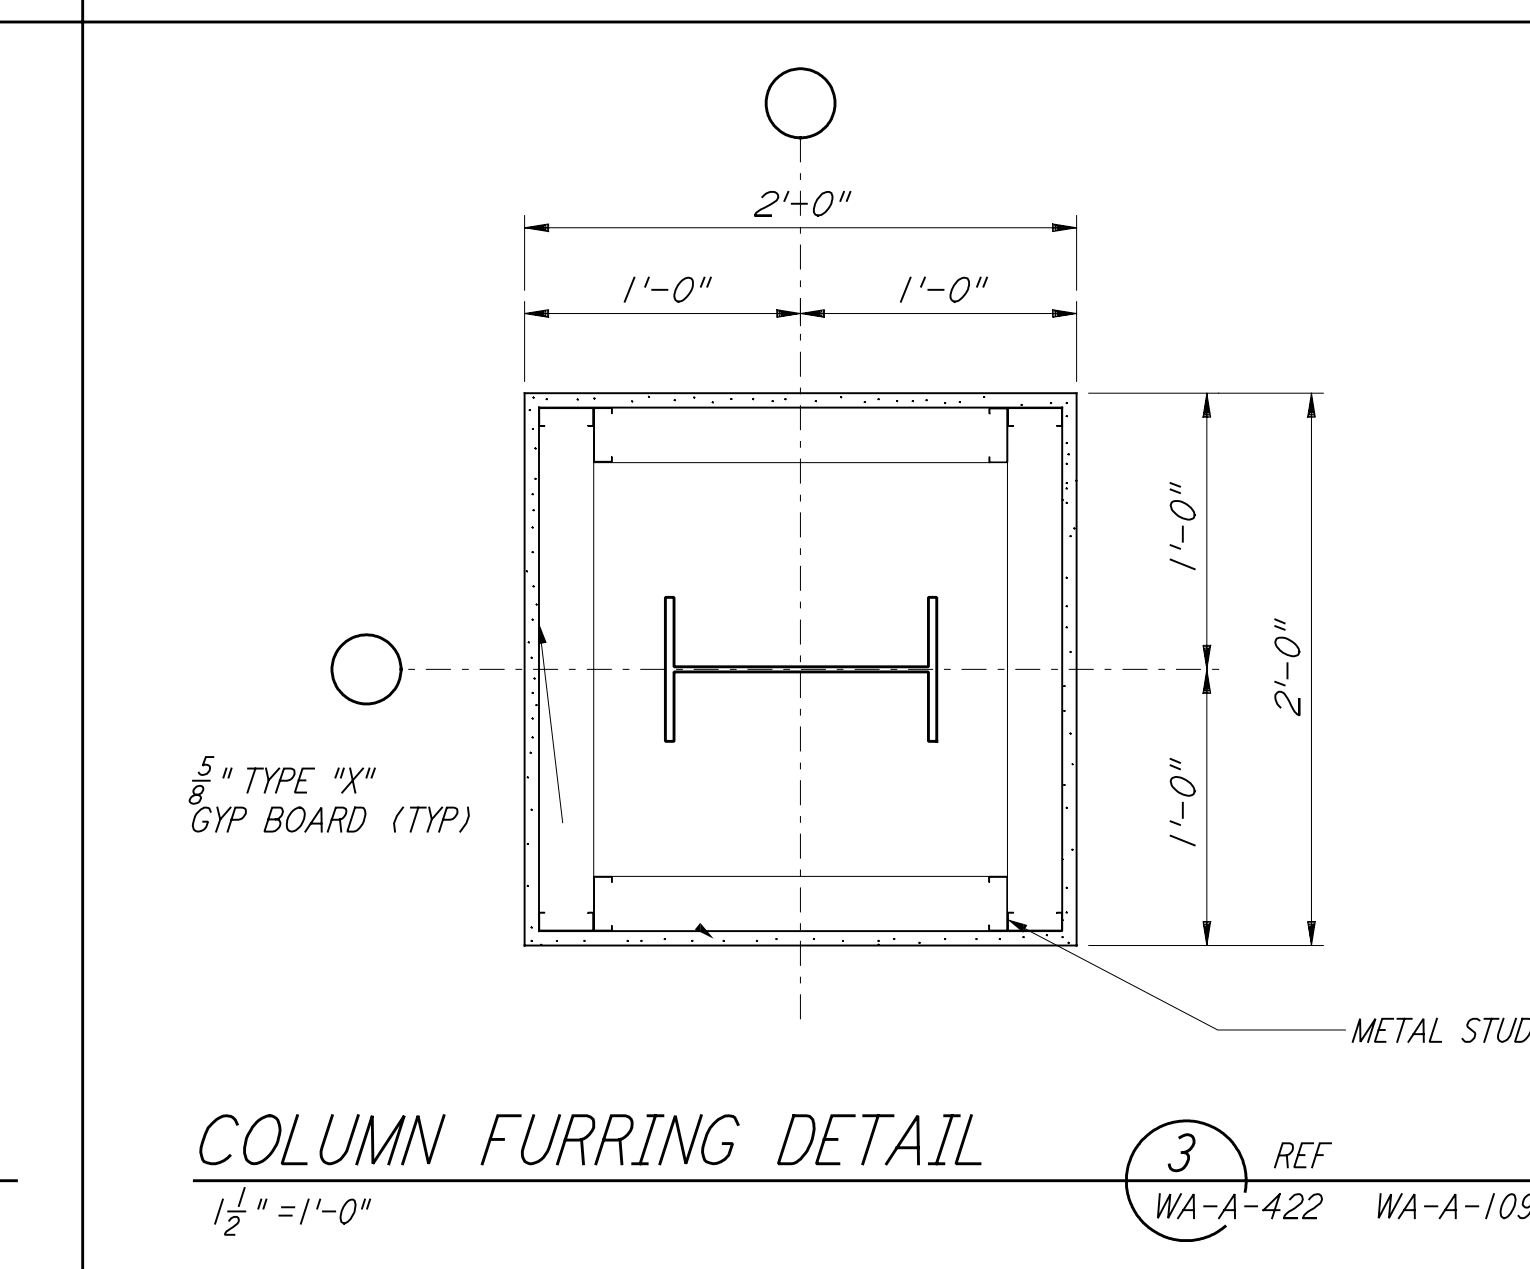


3 COLUMN FURRING DETAIL
 1 1/2\"/>

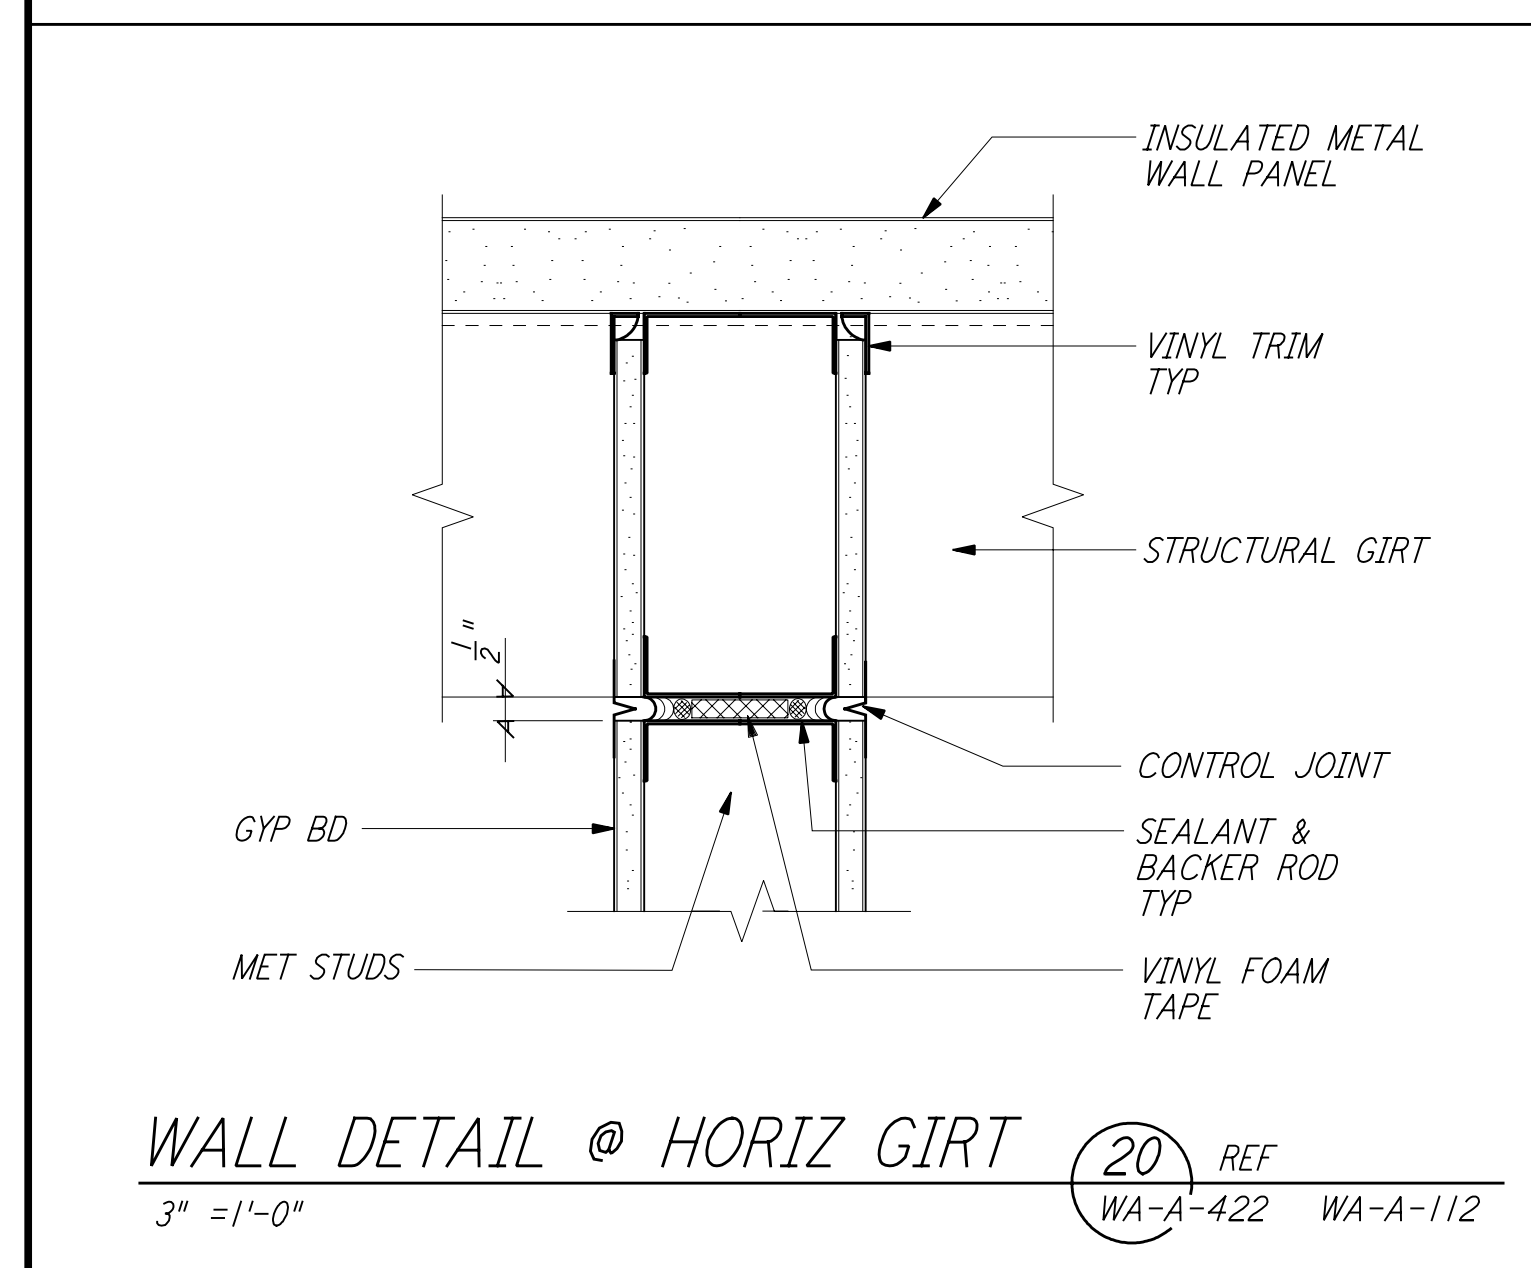


20 WALL DETAIL @ HORIZ GIRT
 3\"/>

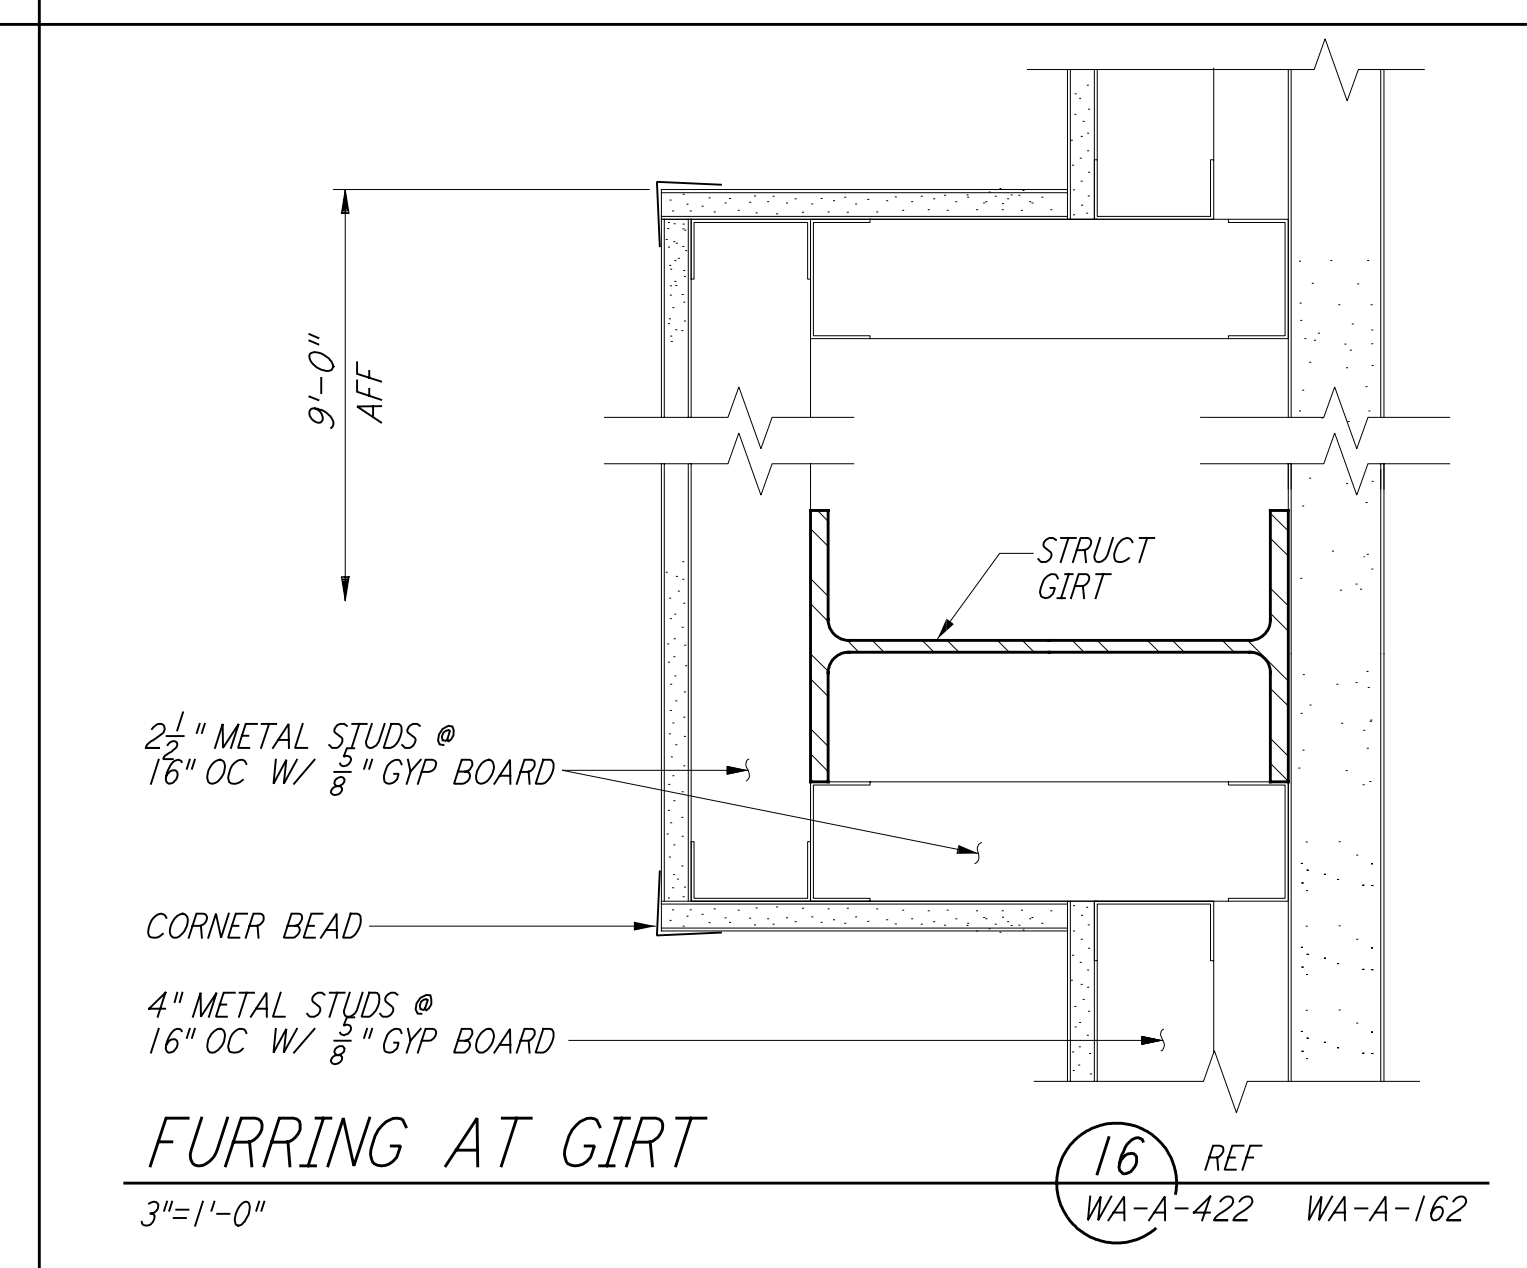

16 FURRING AT GIRT
 3\"/>

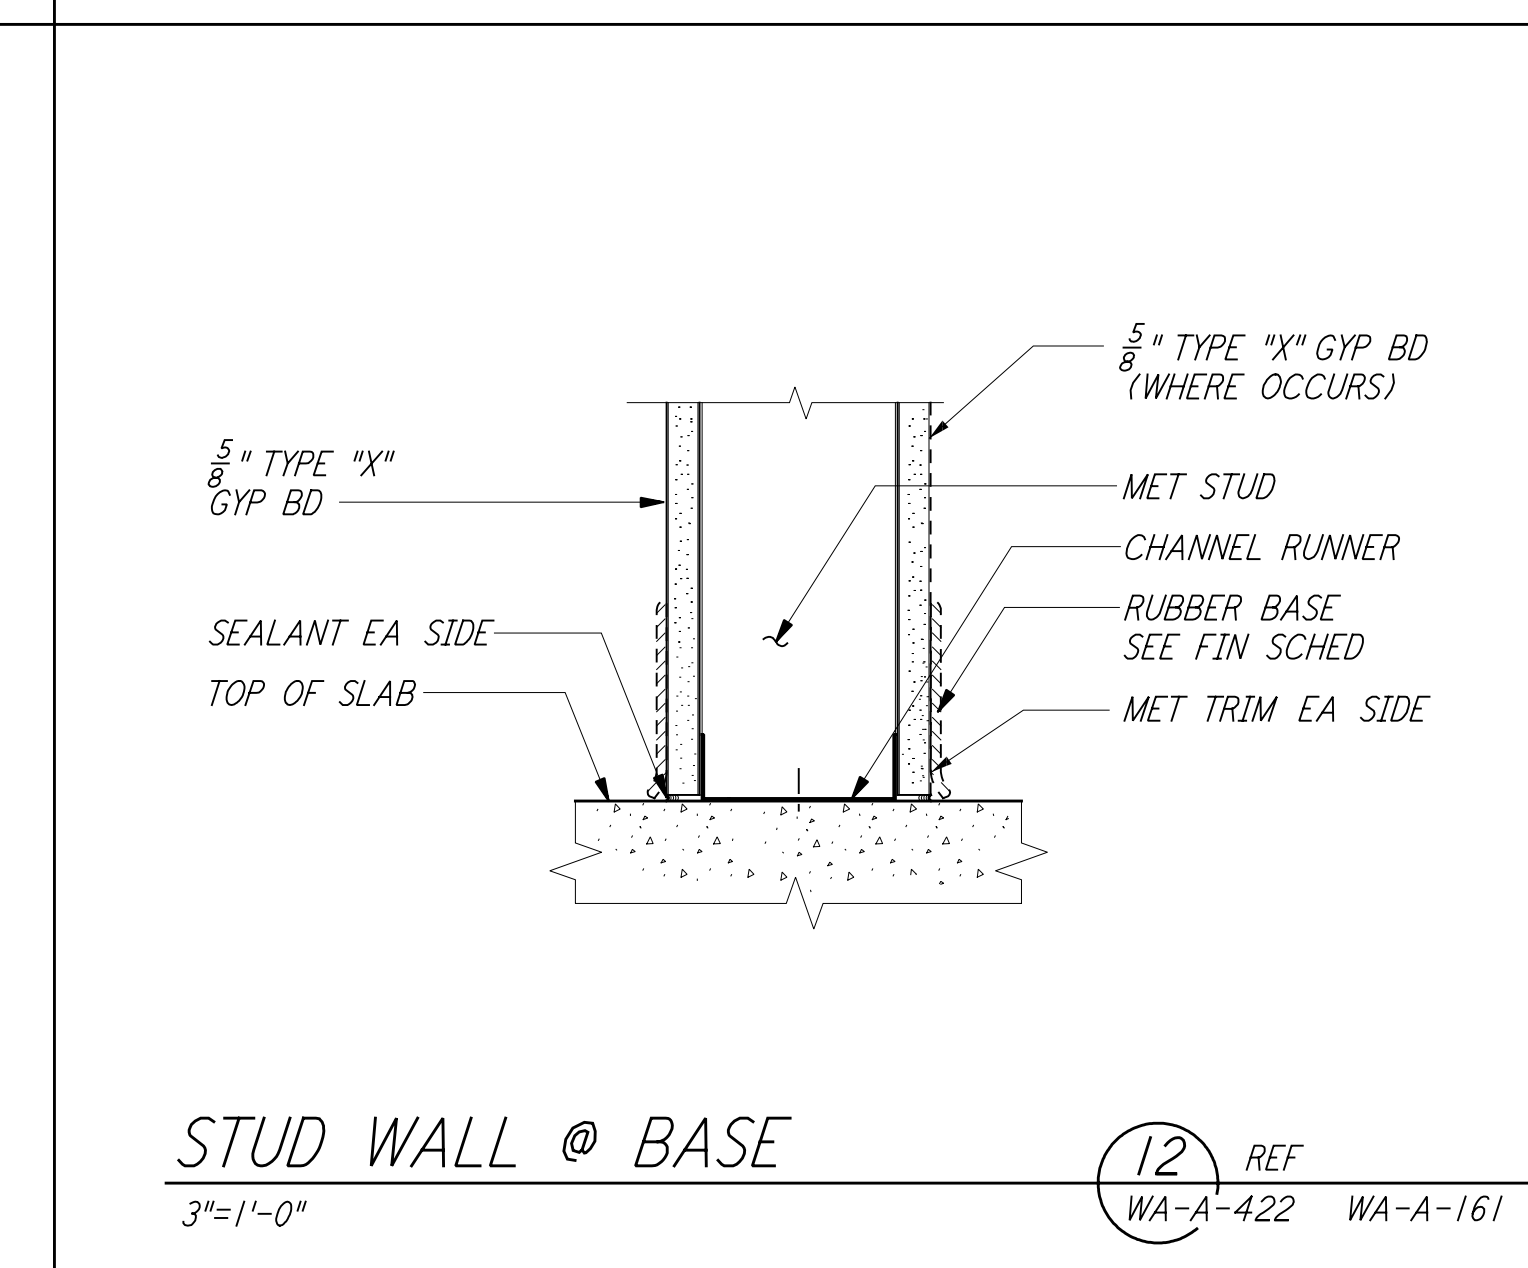

12 STUD WALL @ BASE
 3\"/>

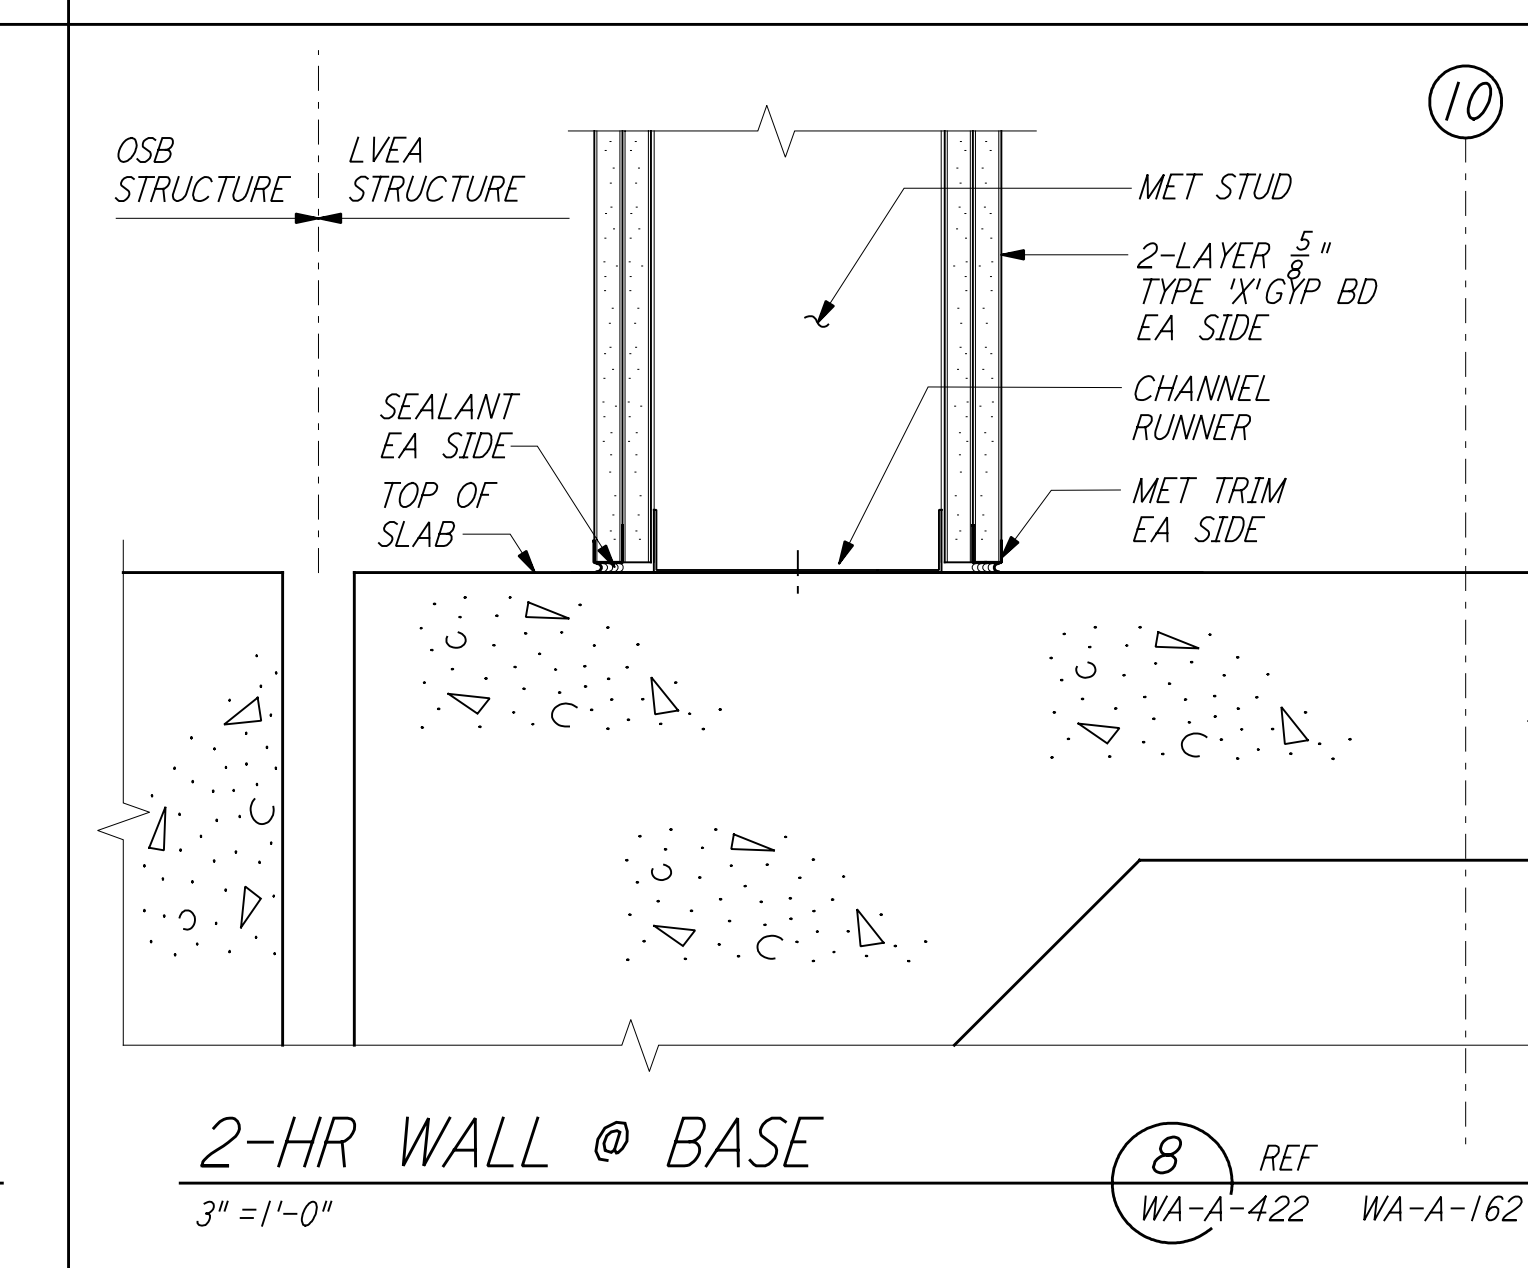

8 2-HR WALL @ BASE
 3\"/>

NO.	DATE	BY	CHKD	ENGR	PROJ	DESCRIPTION
2	5-15-98	CKT				ISSUED FOR AS-BUILT
1	2-28-97	CKT	TB	AK	TDM	CORNER STATION VSEA PARTITION

NO.	DATE	BY	CHKD	ENGR	PROJ	DESCRIPTION
1	7-12-96	bkk				ENGINEER
	5-26-96	TB				CHECKED
	5-12-96	BK/RR				DRAWN
	7-12-96	MDW				PROJ

ISSUED FOR CONSTRUCTION
 AS-BUILT DRAWINGS

100 WEST WALNUT STREET
 PASADENA, CALIFORNIA

PARSONS

LIGO
 CALIFORNIA INSTITUTE OF TECHNOLOGY
 MASSACHUSETTS INSTITUTE OF TECHNOLOGY

LIGO-D960266-02-0

LASER INTERFEROMETER
 GRAVITATIONAL-WAVE OBSERVATORY
 SITE NO. 1 - HANFORD, WASHINGTON

TITLE: ARCHITECTURAL INTERIOR WALL DETAILS

SHEET NUMBER: PPI50969 8094

SCALE: 1 1/2\"/>

Note 1, Linda L Turner, 04/14/99 09:00:19 AM
LIGO-D960266-02-O