
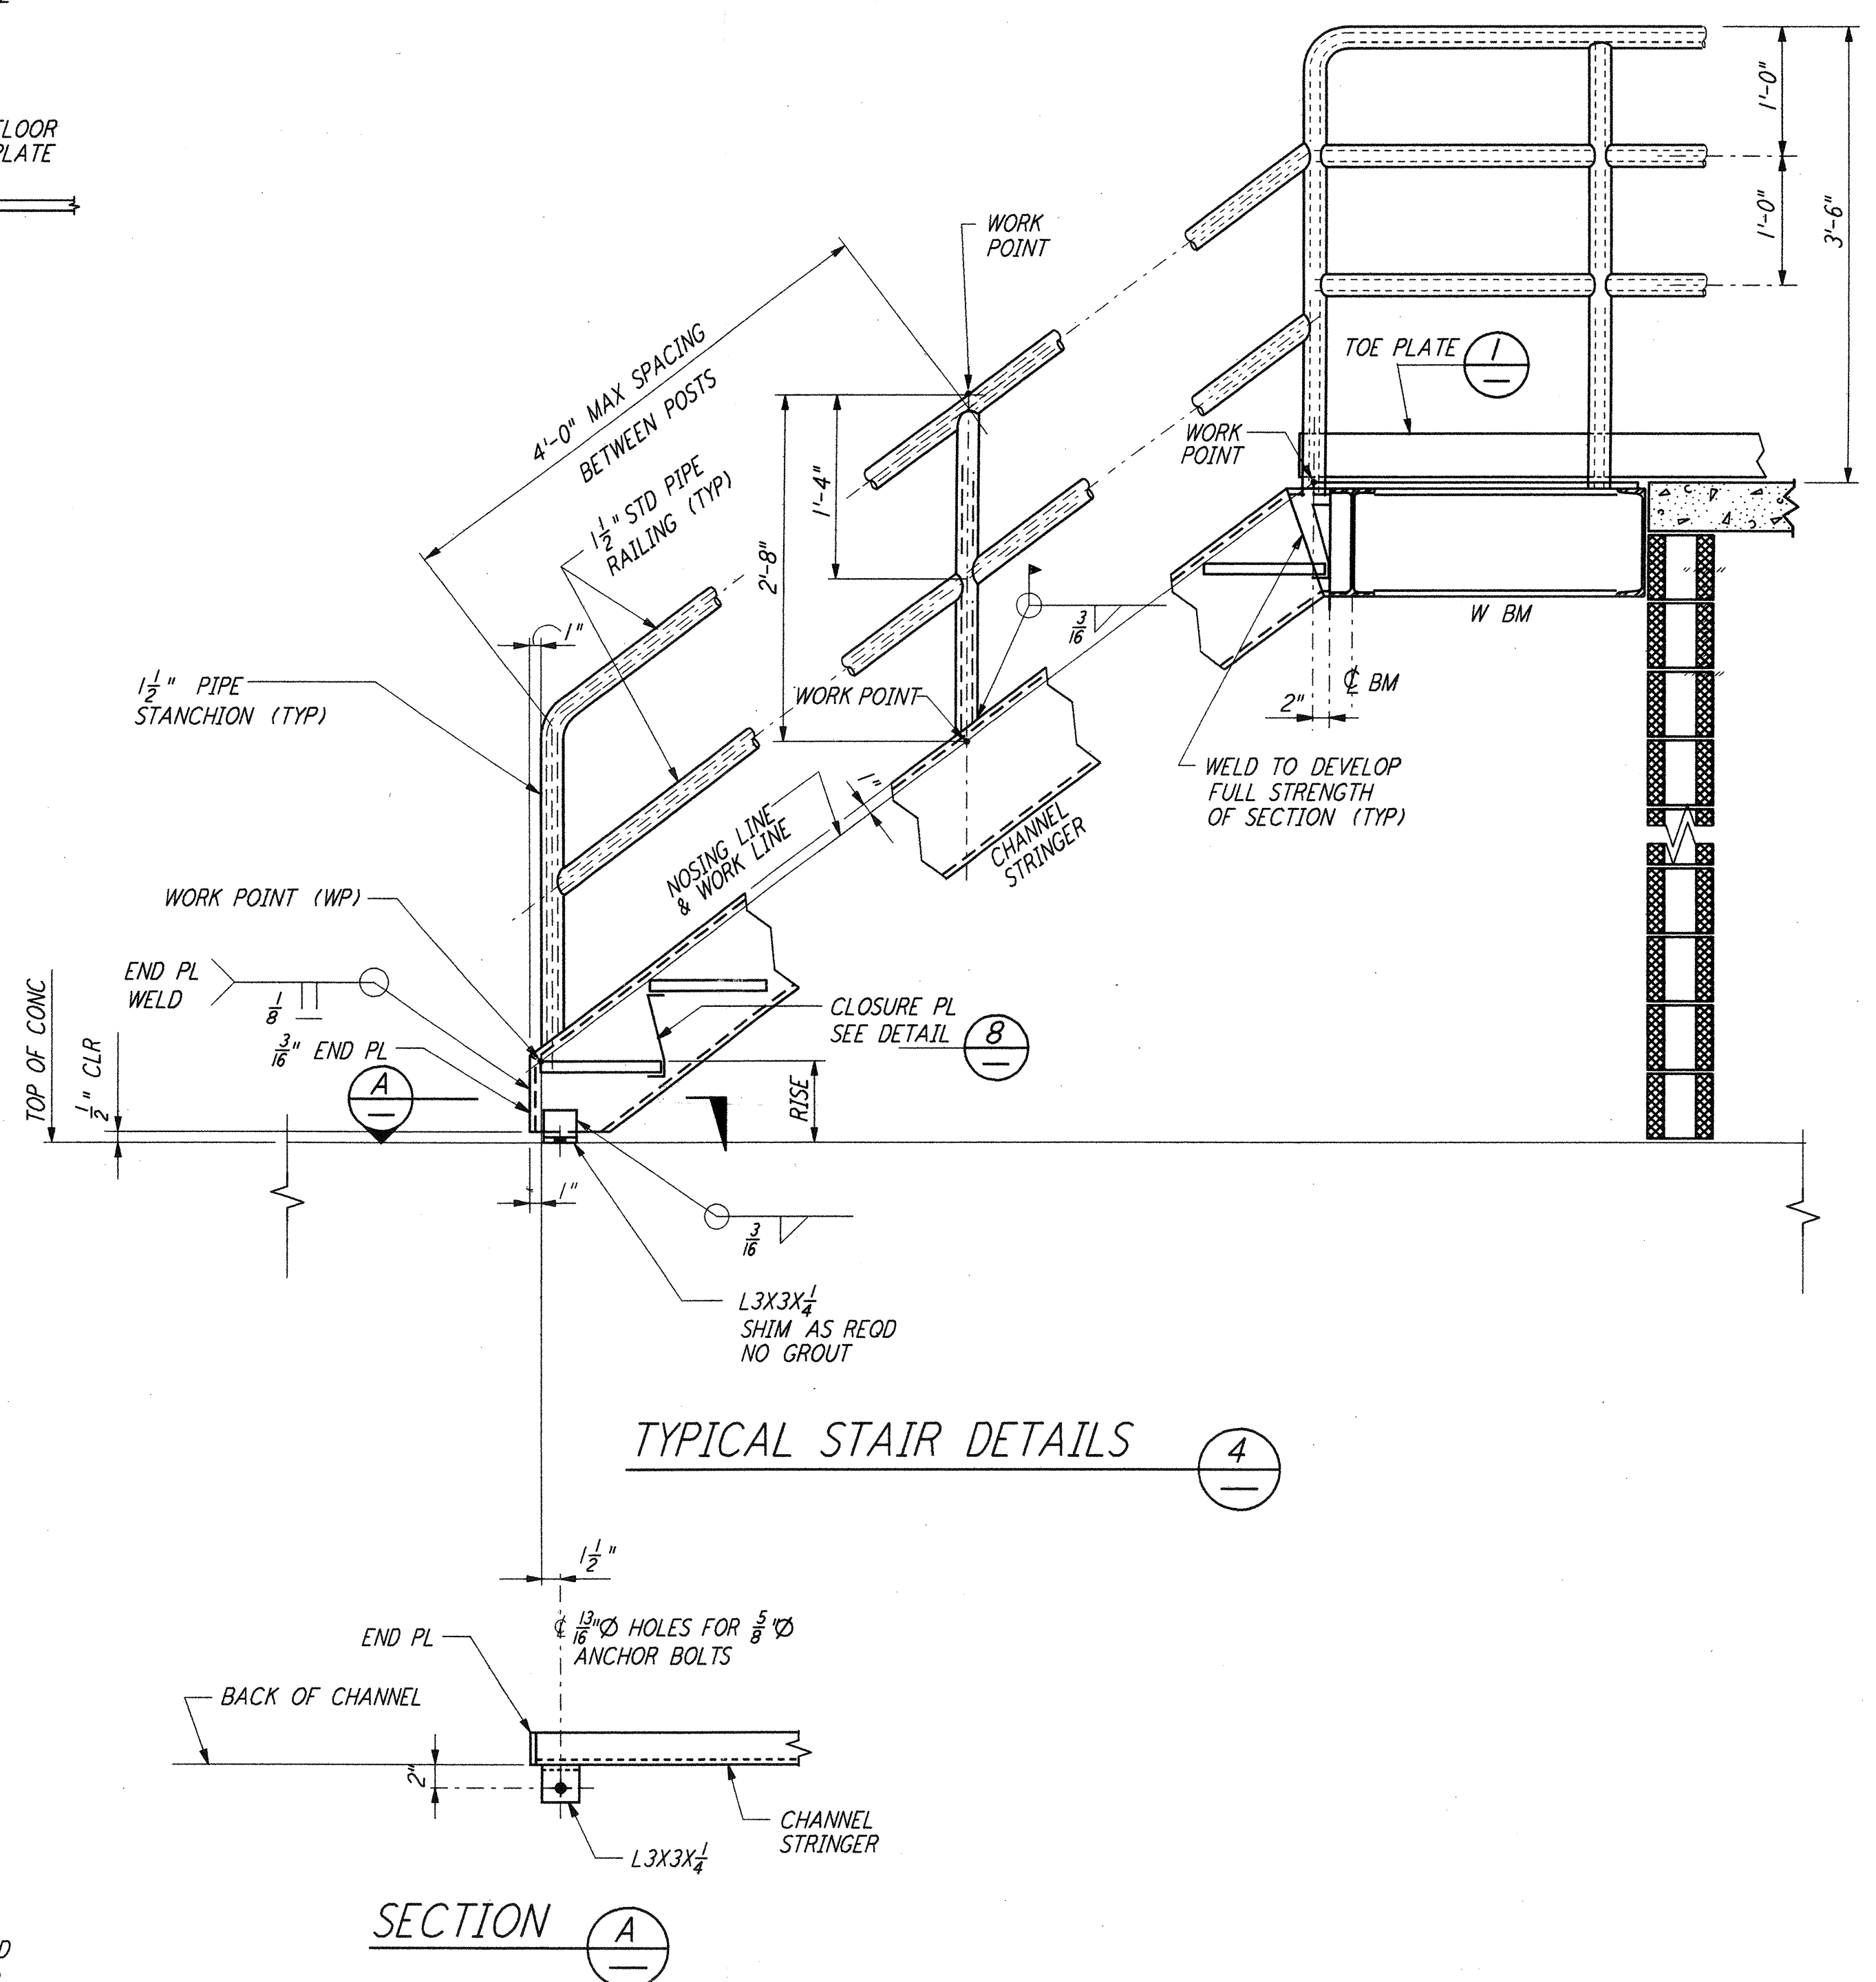
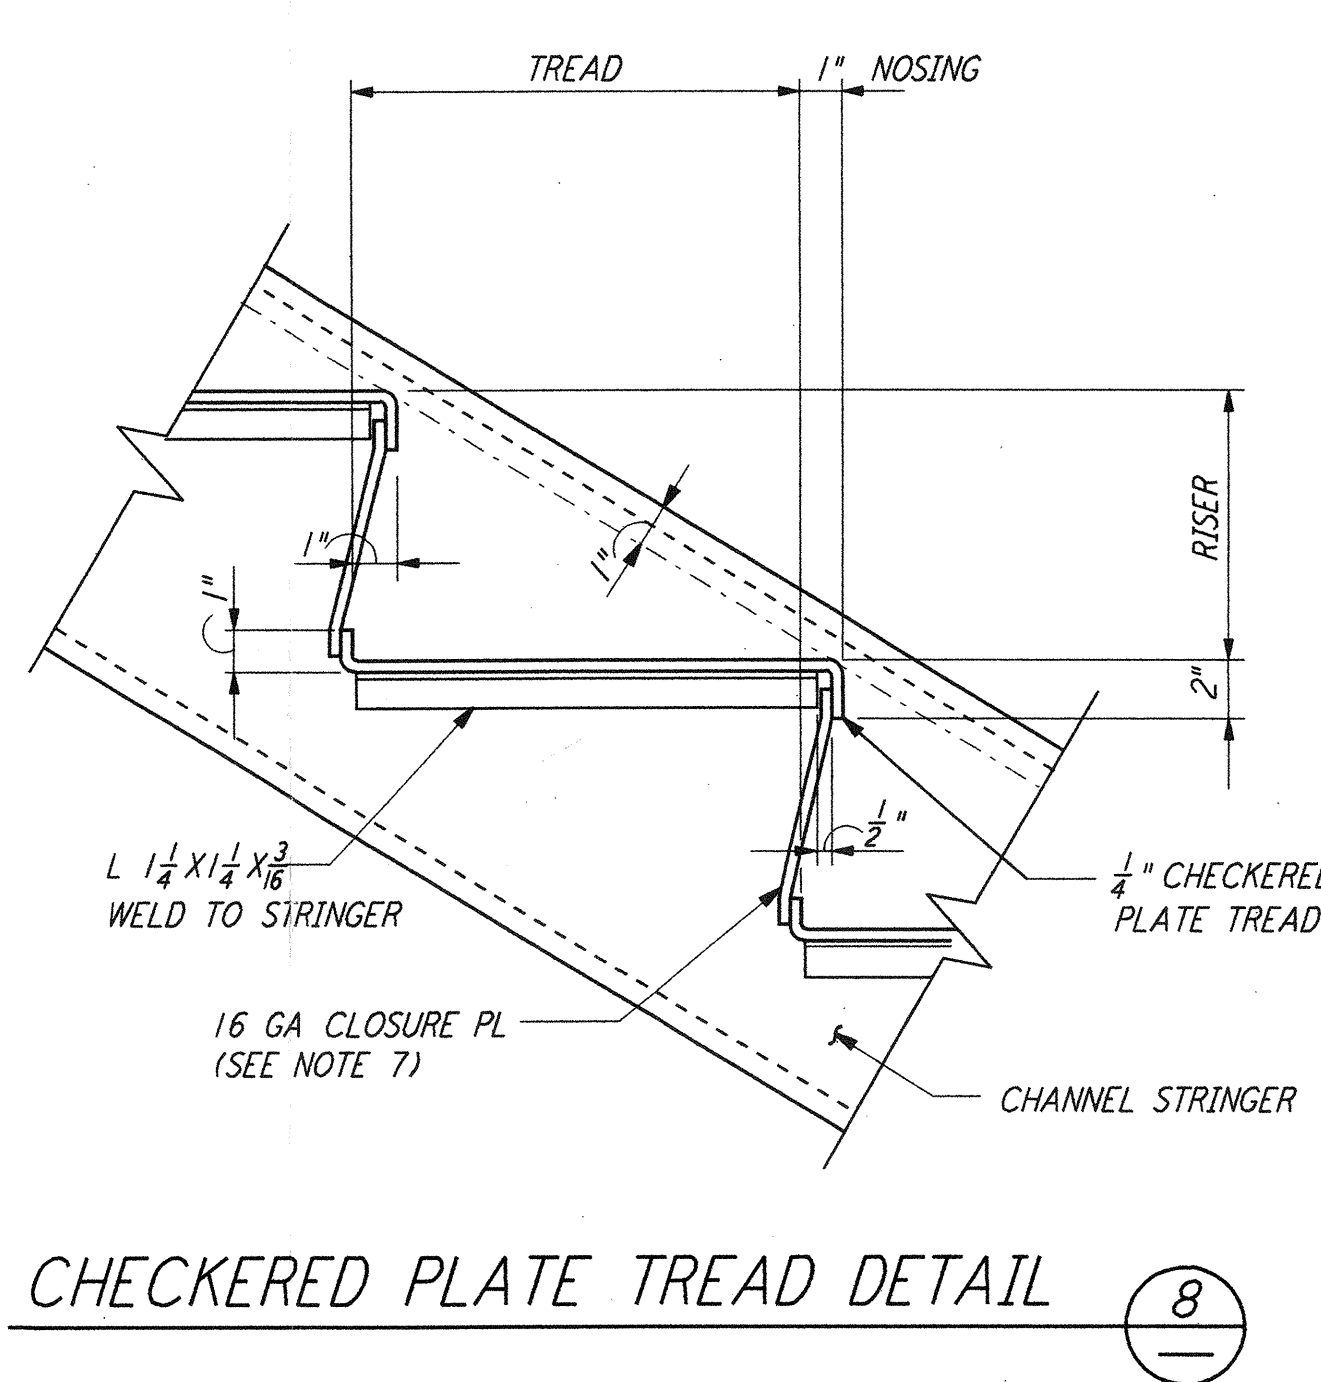
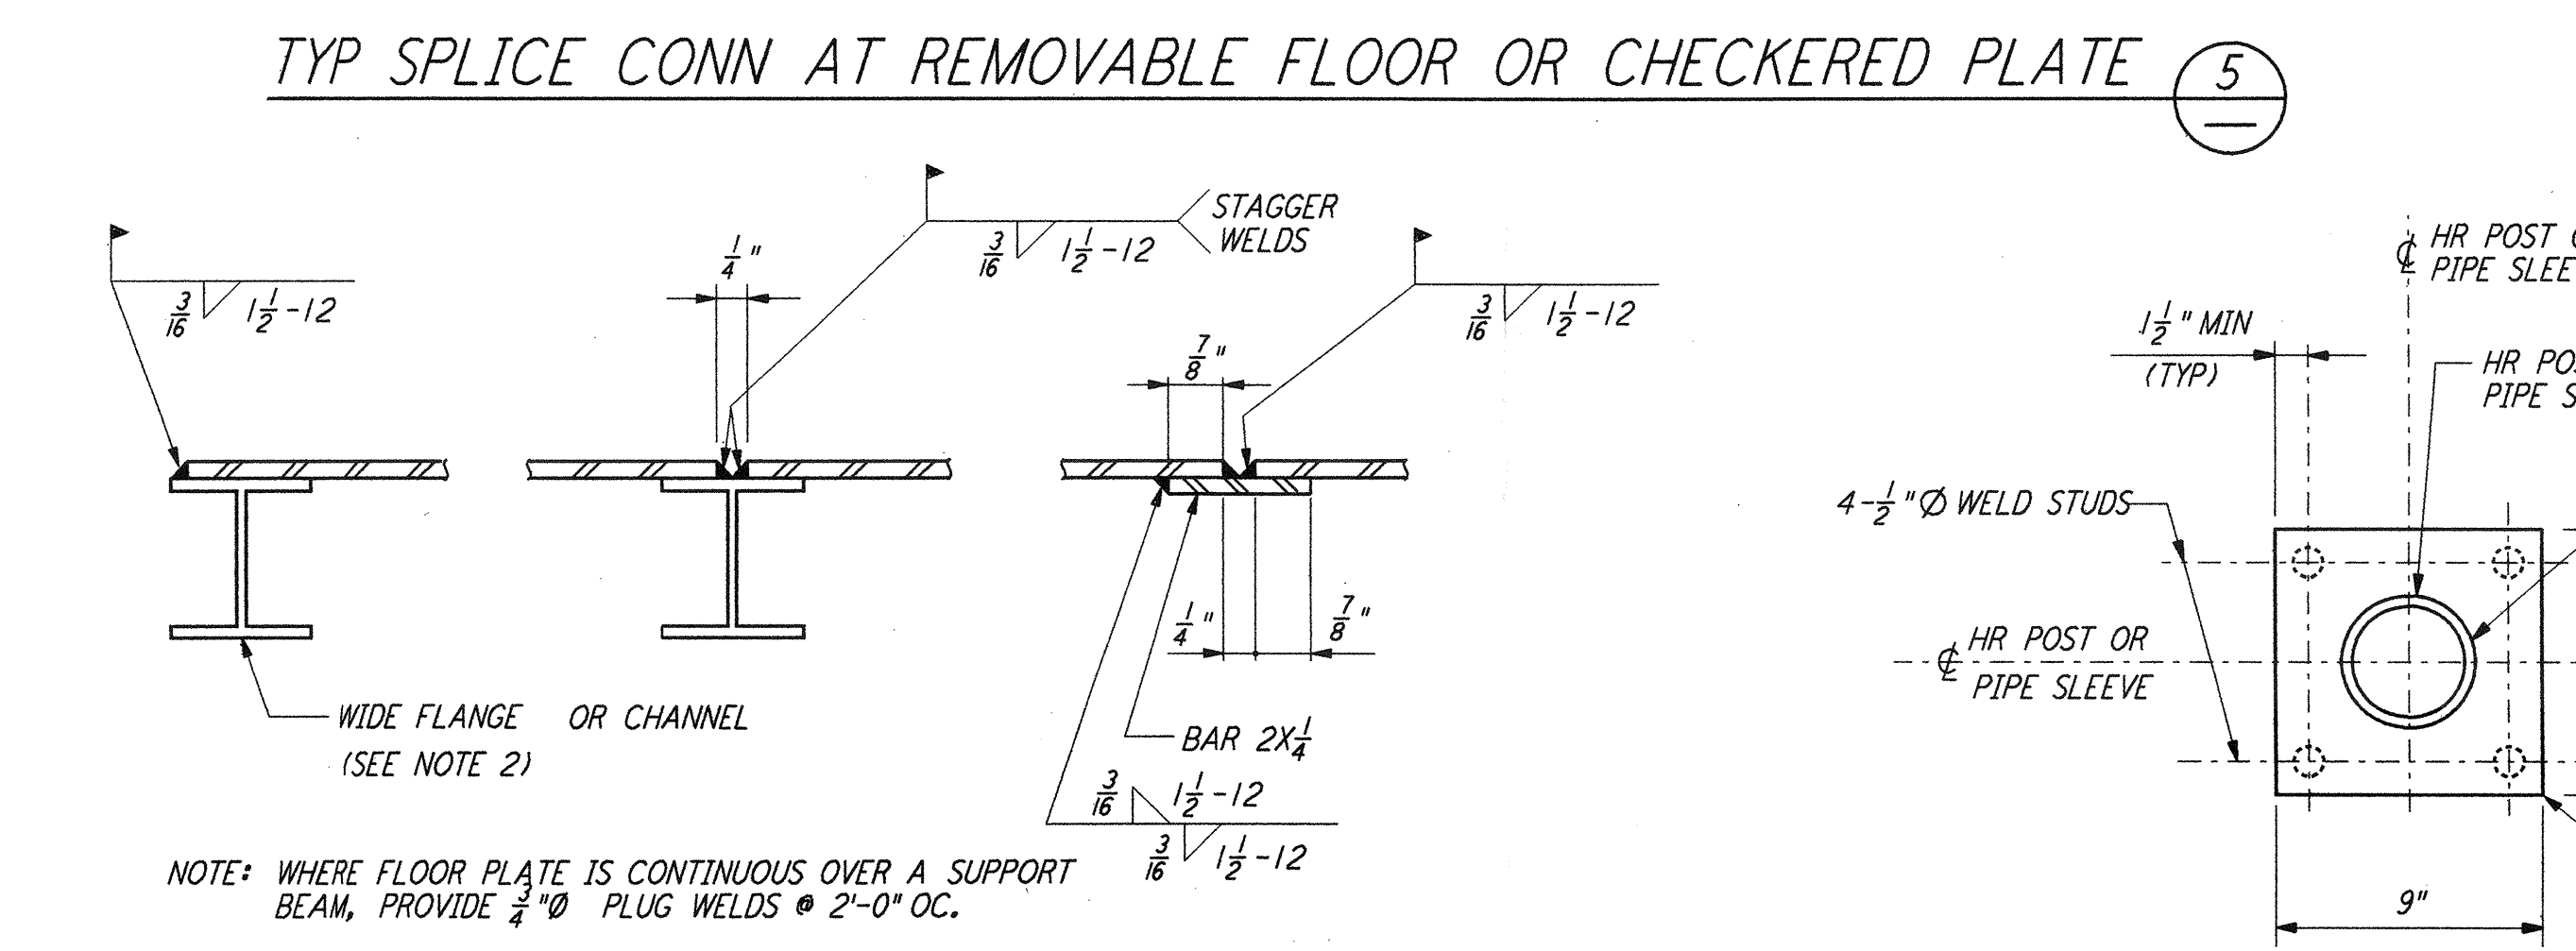
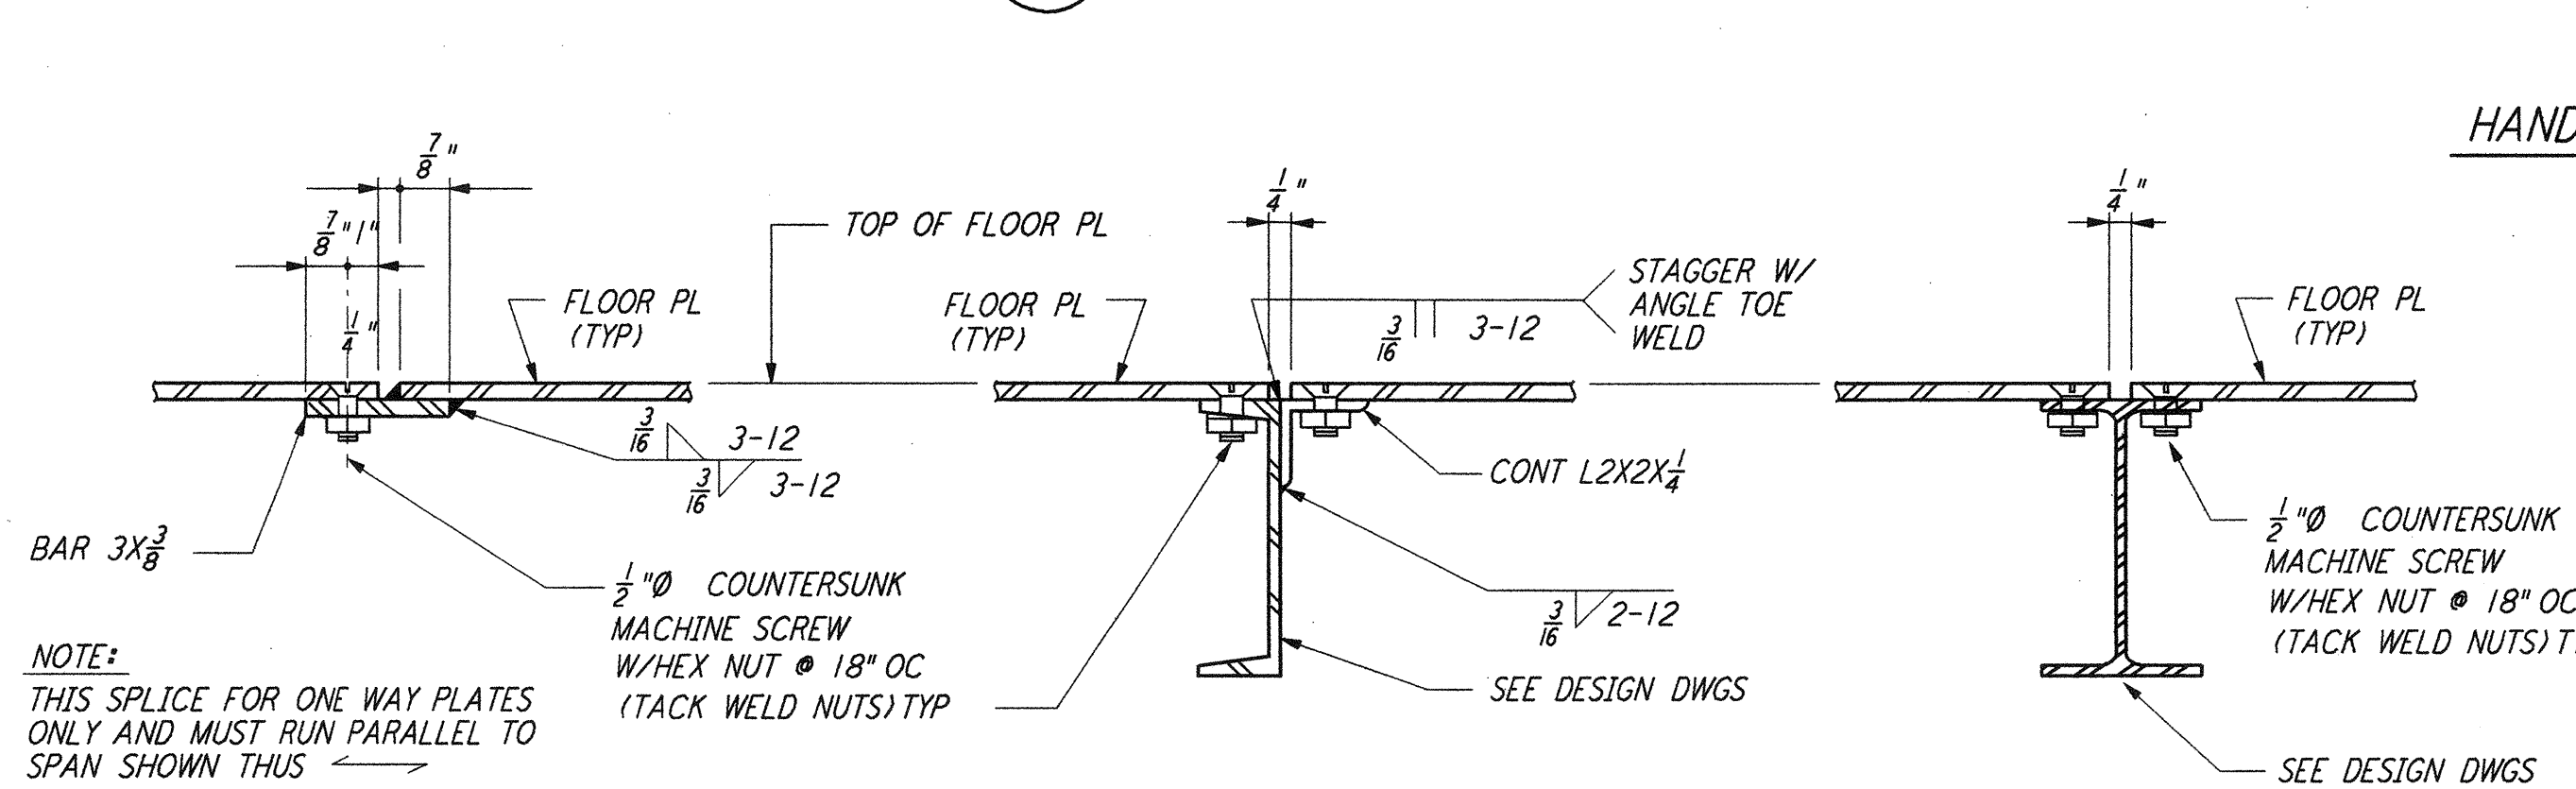
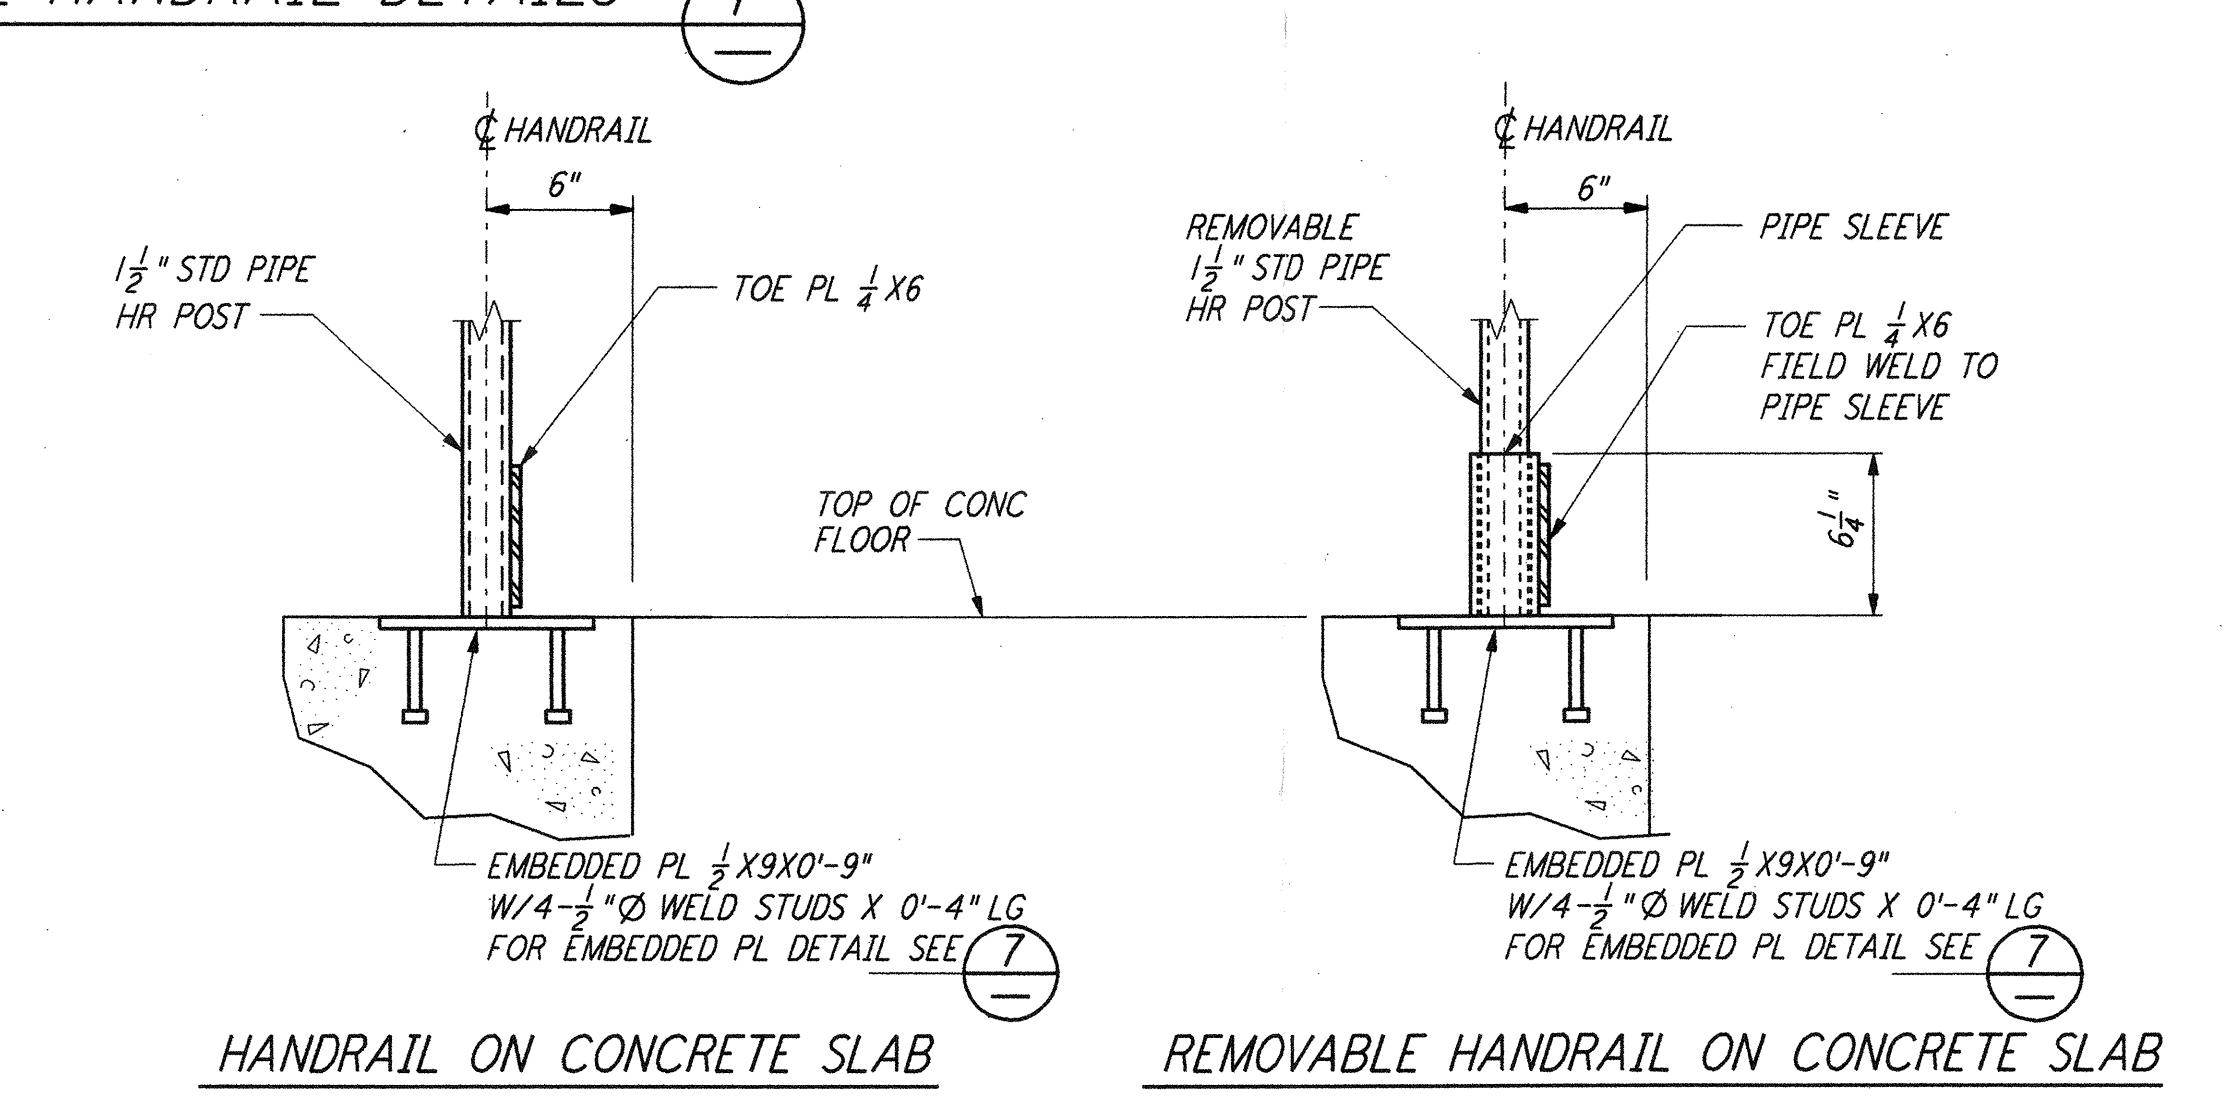
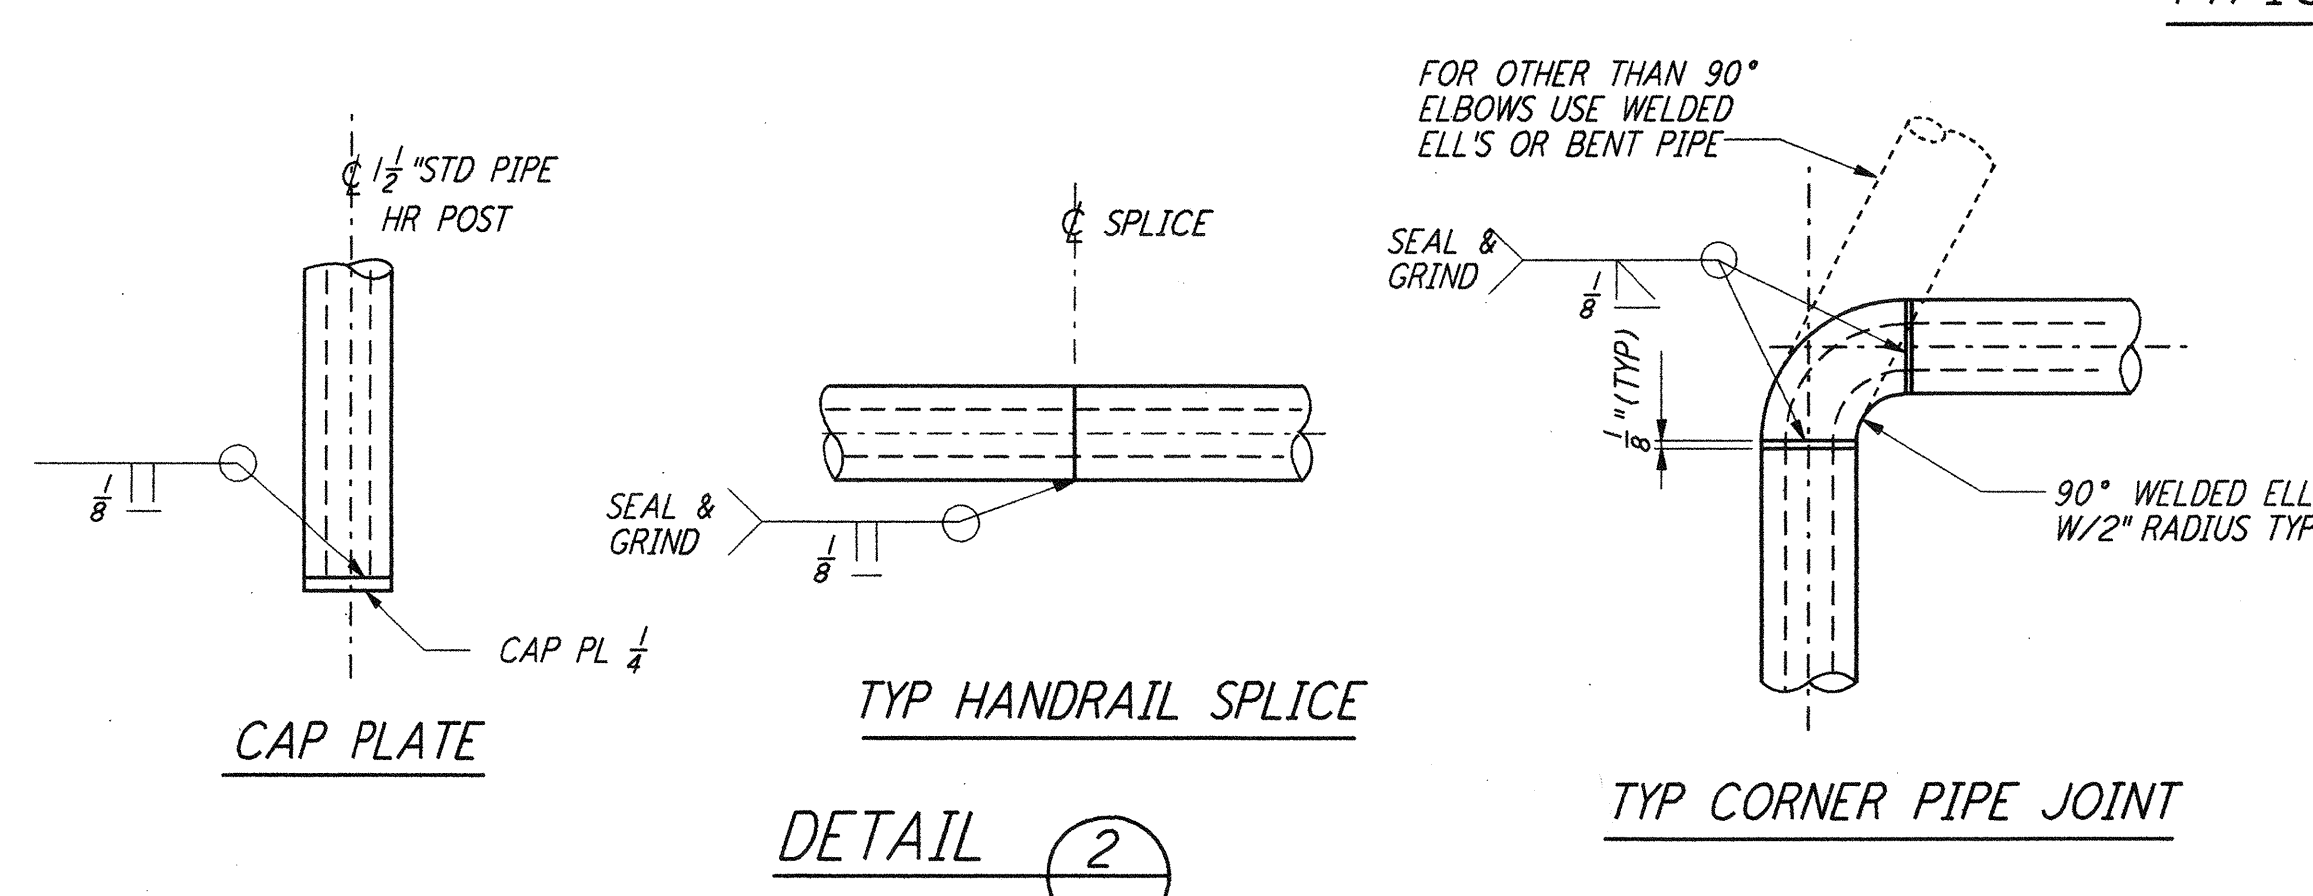


This document and the design it covers are the property of PARSONS. They are loaned only with the borrower's expressed written agreement that they will not be reproduced, copied, loaned, exhibited, or used in any other way, except by written consent from PARSONS to the borrower.

- NOTES:**
- FOR GENERAL NOTES, ABBREVIATIONS AND LEGEND SEE DRAWING WA-S-001.
 - SEE DESIGN DRAWINGS FOR STRUCTURAL MEMBER SIZE AND DIMENSIONS.
 - ALL EXPOSED SHARP EDGES AND CORNERS SHALL BE GROUND SMOOTH.
 - GALVANIZED MEMBER TO BE FIELD WELDED SHALL BE LEFT UNGALVANIZED A DISTANCE OF ONE INCH FROM AREA OF WELDING. THESE AREAS SHALL BE PAINTED WITH GALVANIZE COATING AFTER WELDING.
 - SHOP-WELDED HANDRAIL SECTIONS SHALL NOT EXCEED 20'-0" IN LENGTH.
 - ALL MISCELLANEOUS STEEL SHOWN ON THIS DRAWING SHALL BE GALVANIZED UNLESS OTHERWISE NOTED ON DESIGN DRAWINGS.
 - PROVIDE CLOSURE PL BETWEEN STAIR TREADS.

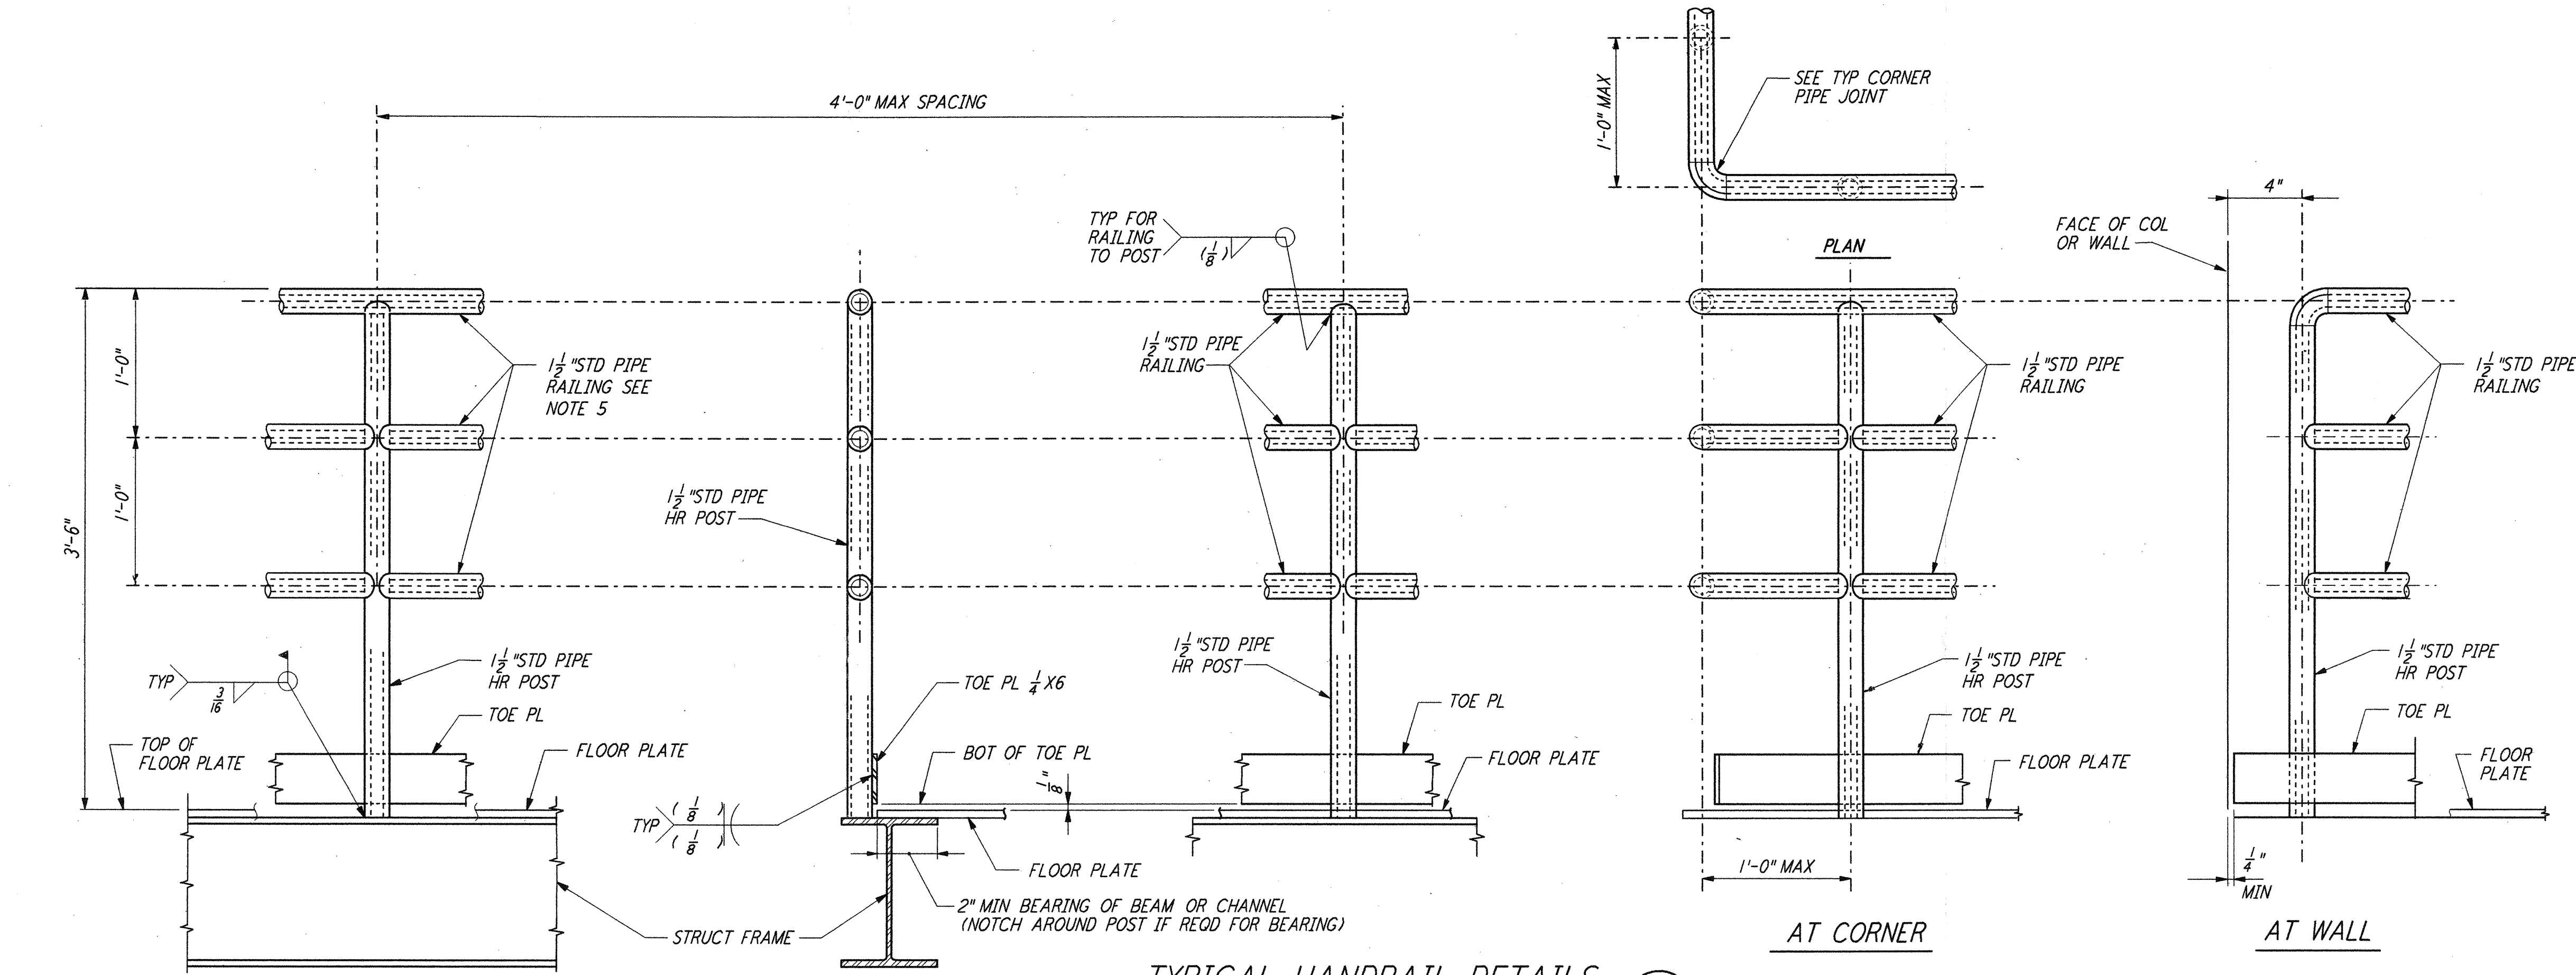

REFERENCES		REVISIONS		ISSUED FOR CONSTRUCTION	
DRAWING NO.	DESCRIPTION	NO.	DATE	BY	DESCRIPTION
		1	6-15-98	CKT	ISSUED FOR AS-BUILT

AS-BUILT DRAWINGS	
NO.	DESCRIPTION
1	ISSUED FOR AS-BUILT

ISSUED FOR CONSTRUCTION	
DRAWN	MCS 6-24-96
CHECKED	DDM 7-2-96
ENGINEER	BP 6-28-96
PROJ	DDM 7-9-96

PARSONS

100 WEST WALNUT STREET
 PASADENA, CALIFORNIA

LIGO

CALIFORNIA INSTITUTE OF TECHNOLOGY
 MASSACHUSETTS INSTITUTE OF TECHNOLOGY

LIGO-D960294-01-0

LASER INTERFEROMETER
 GRAVITATIONAL-WAVE OBSERVATORY
 SITE NO. 1 - HANFORD, WASHINGTON

TITLE	STRUCTURAL STANDARD STAIR & HANDRAIL DETAILS	SCALE	NONE	CONTRACT NUMBER	PP150969	PROJECT NUMBER	8094
SHEET NUMBER	WA-S-009	REVISIONS					

1547414.1998 C:\PLT\JOB\ES\3\98B2J0CF E2085 K:\V3582\1\009\p1