
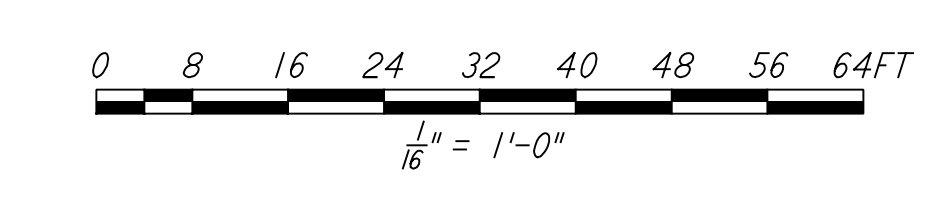


- NOTES:**
1. FOR GENERAL NOTES, ABBREVIATIONS AND SYMBOLS, SEE DRAWING WA-S-001.
 2. FOR SLAB ON GRADE DETAILS SEE DRAWING WA-S-002.
 3. FOR BASE ANGLE AT EDGE OF SLAB OR TOP OF 6" CONCRETE WALL, SEE FRAMING ELEVATIONS AND SECTION WA-S-003

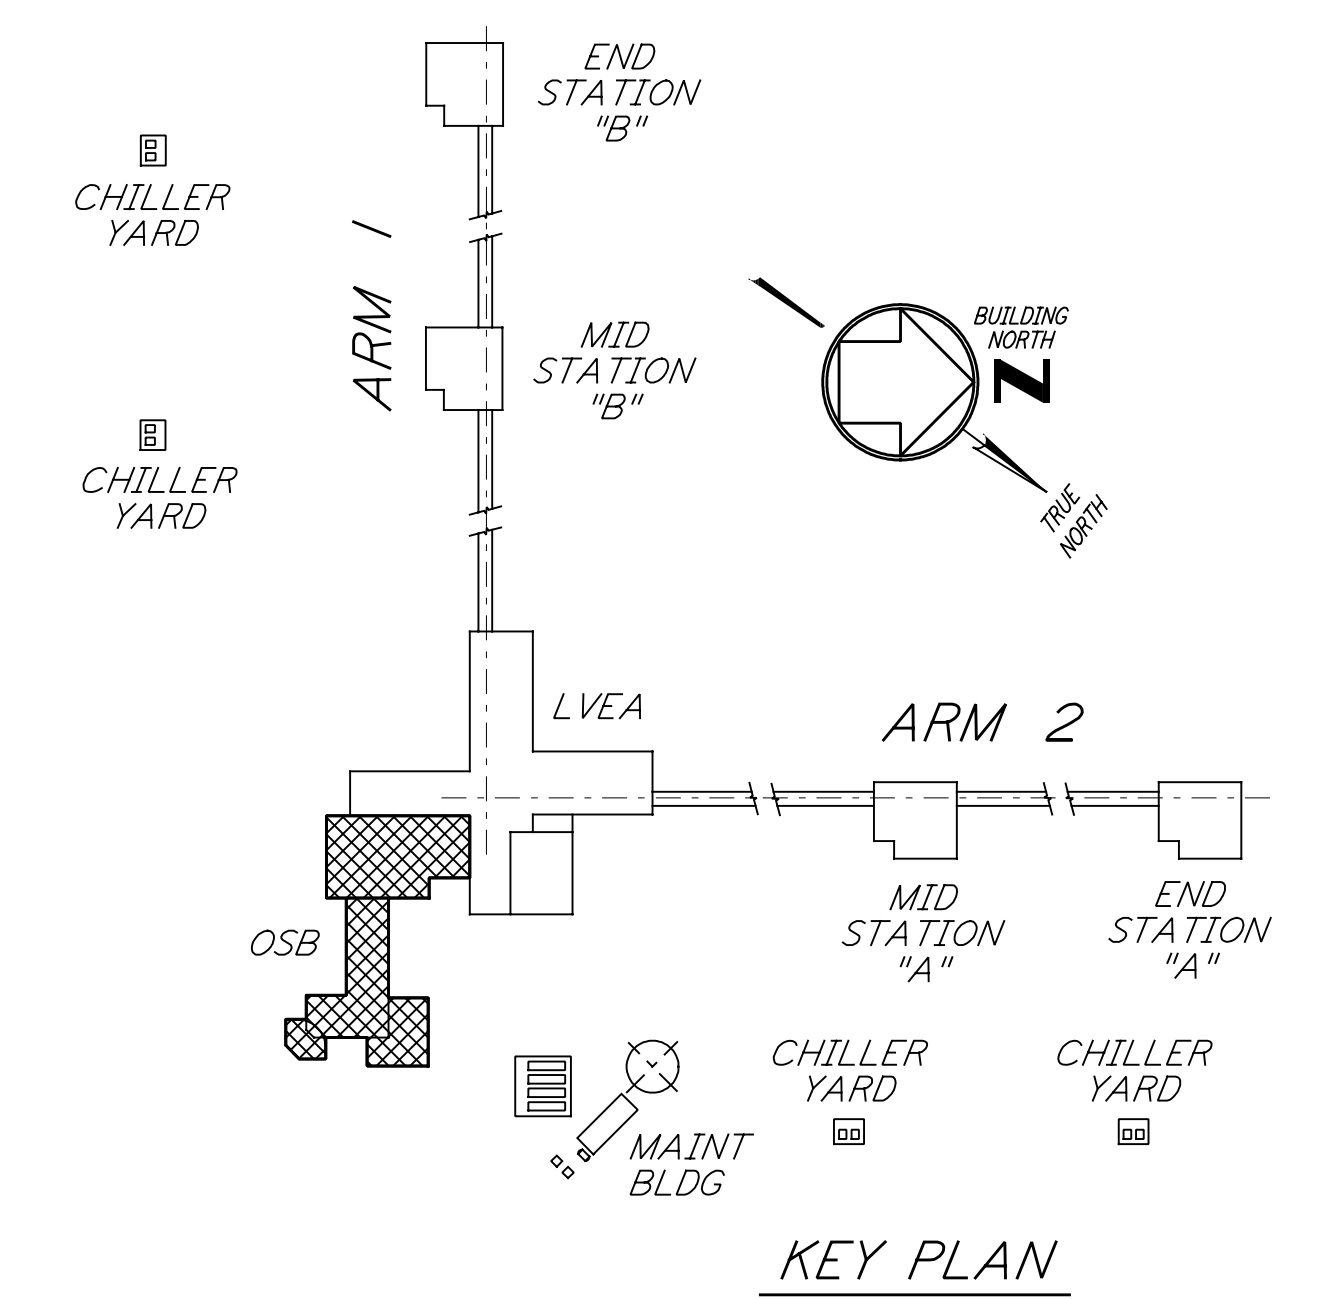

FOR FLOOR SLOPE SEE ARCHITECTURAL DRAWINGS

DATUM POINT EL 100'-0" = EL 531.11'

FOUNDATION PLAN
 1/8" = 1'-0"

This document and the design it covers are the property of PARSONS. They are loaned only with the borrower's expressed written agreement that they will not be reproduced, copied, loaned, exhibited, or used in any other way, except by written consent from PARSONS to the borrower.

This document and the design it covers are the property of PARSONS. They are loaned only with the borrower's expressed written agreement that they will not be reproduced, copied, loaned, exhibited, or used in any other way, except by written consent from PARSONS to the borrower.

NO.	DATE	BY	CHKD	ENGR	PROJ	DESCRIPTION
1	6-15-98	CKT				ISSUED FOR AS-BUILT

ISSUED FOR CONSTRUCTION		
DRAWN	MCS	6-24-96
CHECKED	DDM	7-2-96
ENGINEER	BP	6-26-96
PROJ	MDW	7-9-96
AS-BUILT DRAWINGS		

100 WEST WALNUT STREET
 PASADENA, CALIFORNIA

CALIFORNIA INSTITUTE OF TECHNOLOGY
 MASSACHUSETTS INSTITUTE OF TECHNOLOGY

LIGO-D960296-01-0

LASER INTERFEROMETER
 GRAVITATIONAL-WAVE OBSERVATORY
 SITE NO. 1 - HANFORD, WASHINGTON

TITLE	SCALE	PROJECT NUMBER
STRUCTURAL CORNER STATION OSB FOUNDATION PLAN	AS NOTED	PP150969 8094
SHEET NUMBER	REVISIONS	
WA-S-102		