



PARTIAL FRAMING ELEVATION AT COLUMN LINE 14.3  
 1/8" = 1'-0"

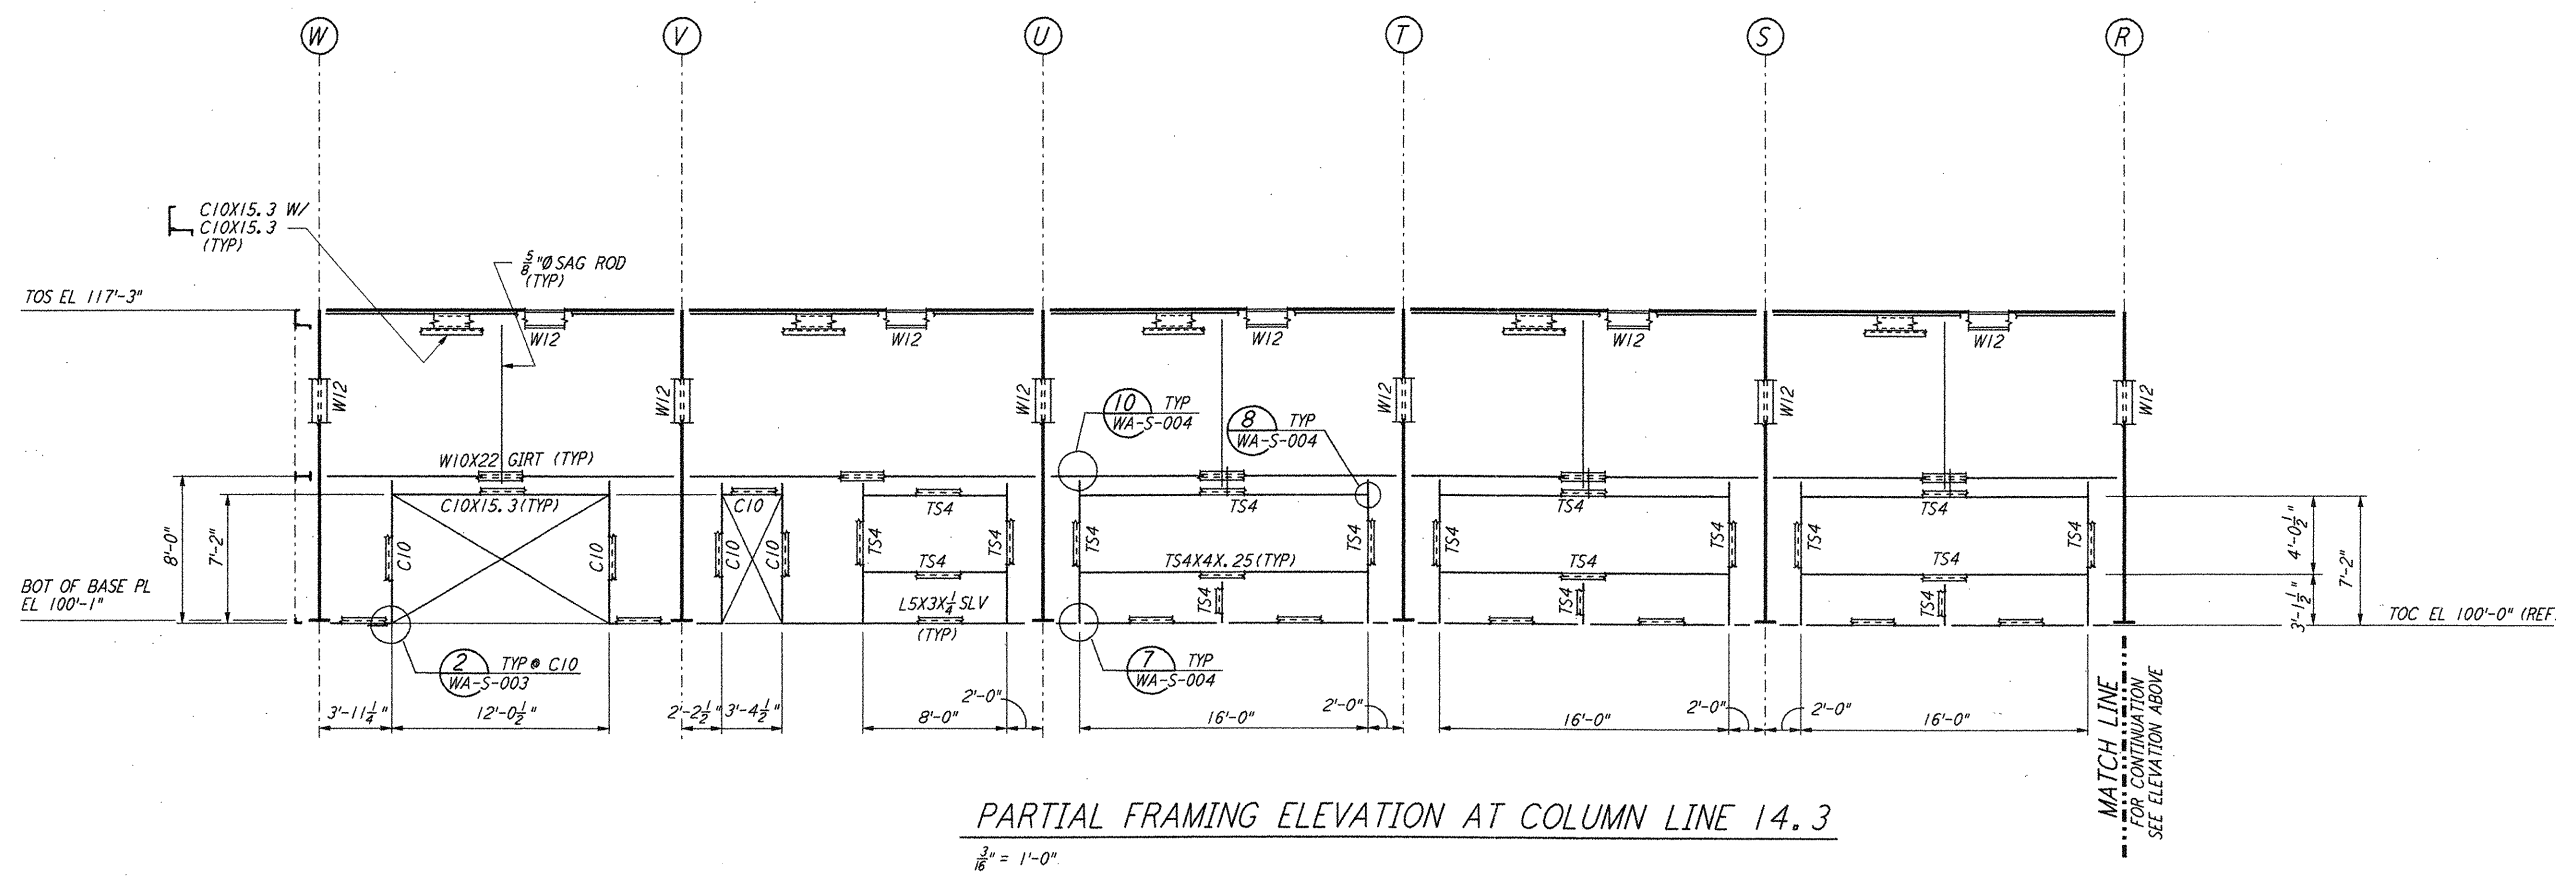

PARTIAL FRAMING ELEVATION AT COLUMN LINE 14.3  
 1/8" = 1'-0"

- NOTES:**
1. FOR GENERAL NOTES, ABBREVIATIONS AND SYMBOLS SEE DRAWING WA-S-001.
  2. FOR CHANNEL, GIRT AND EAVE STRUT CONNECTION DETAILS SEE DRAWING WA-S-005.
  3. FOR W BEAM TO COLUMN WEB/FLANGE CONNECTIONS, SEE DETAILS 6, 7, 8, 99, 100.
  4. FOR BASE ANGLE (LSX3) CONNECTIONS, SEE SECTION A.
  5. FOR VERT BRCC CONNECTIONS SEE 2, 3, 4, 99, 100.

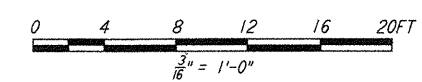

This document and the design it covers are the property of PARSONS. They are loaned only with the borrower's expressed written agreement that they will not be reproduced, copied, loaned, exhibited, or used in any other way, except by written consent from PARSONS to the borrower.

This document and the design it covers are the property of PARSONS. They are loaned only with the borrower's expressed written agreement that they will not be reproduced, copied, loaned, exhibited, or used in any other way, except by written consent from PARSONS to the borrower.

NO.	DATE	BY	CHKD	ENGR	PROJ	DESCRIPTION
1	6-15-98	CKT	BP	PK		ISSUED FOR AS-BUILT

ISSUED FOR CONSTRUCTION	
DRAWN	MCS 6-24-98
CHECKED	DDM 7-2-98
ENGINEER	BP 6-28-98
PROJ	MDW 7-9-98

**AS-BUILT DRAWINGS**

100 WEST WALNUT STREET  
 PASADENA, CALIFORNIA

CALIFORNIA INSTITUTE OF TECHNOLOGY  
 MASSACHUSETTS INSTITUTE OF TECHNOLOGY

**LIGO-D960302-01-0**

LASER INTERFEROMETER  
 GRAVITATIONAL-WAVE OBSERVATORY  
 SITE NO. 1 - HANFORD, WASHINGTON

TITLE	SCALE	CONTRACT NUMBER	PROJECT NUMBER
STRUCTURAL CORNER STATION OSB FRAMING ELEVATIONS SHEET 5	AS NOTED	PP150969	8094
SHEET NUMBER		REVISIONS	
WA-S-122			