




This document and the design it covers are the property of PARSONS. They are loaned only with the borrower's expressed written agreement that they will not be reproduced, copied, loaned, exhibited, or used in any other way, except by written consent from PARSONS to the borrower.

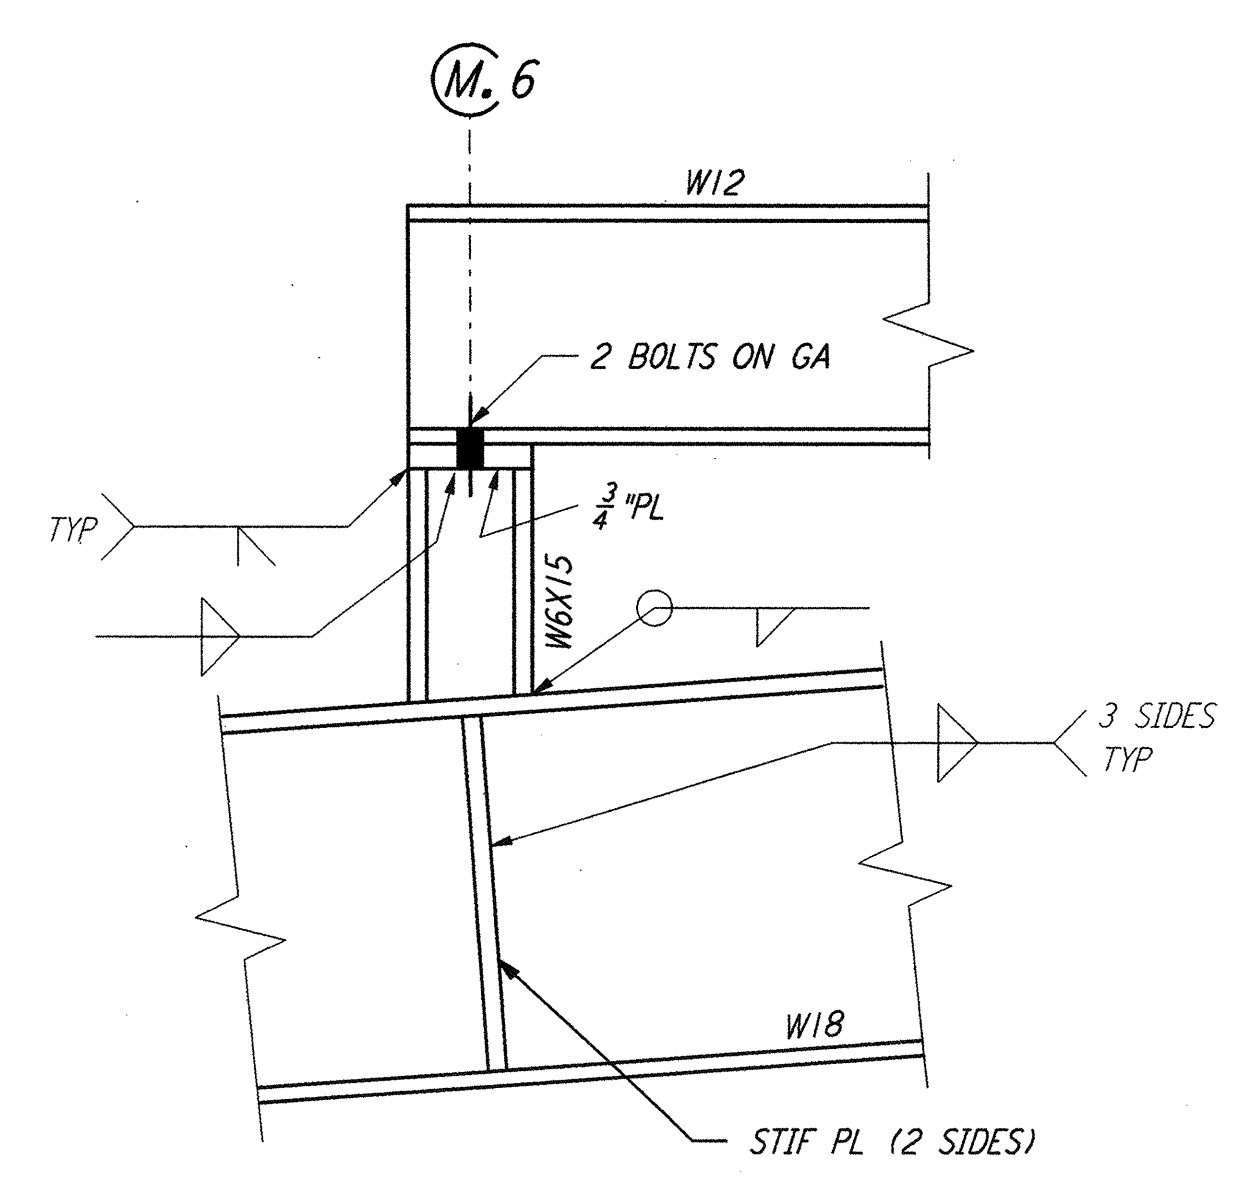


DETAIL 1 REF
 NTS WA-S-407 WA-S-121

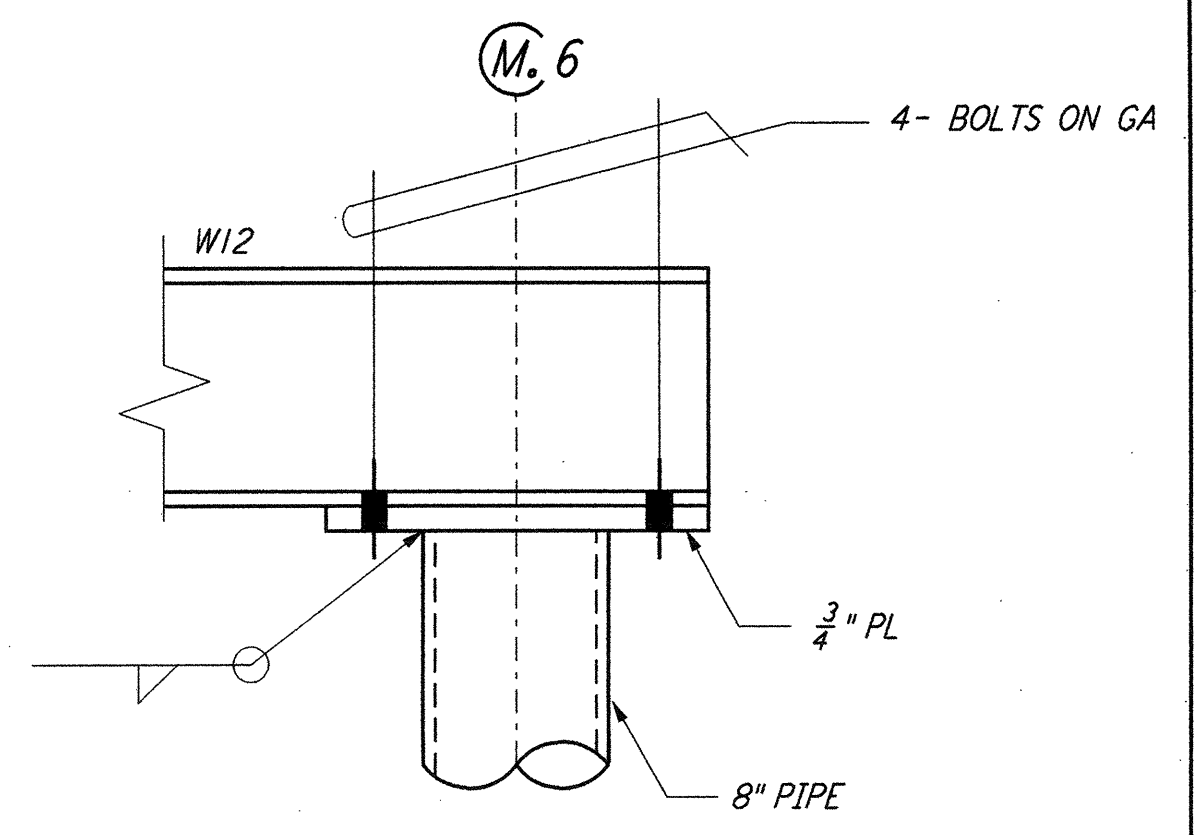


DETAIL 2 REF
 NTS WA-S-407 WA-S-121

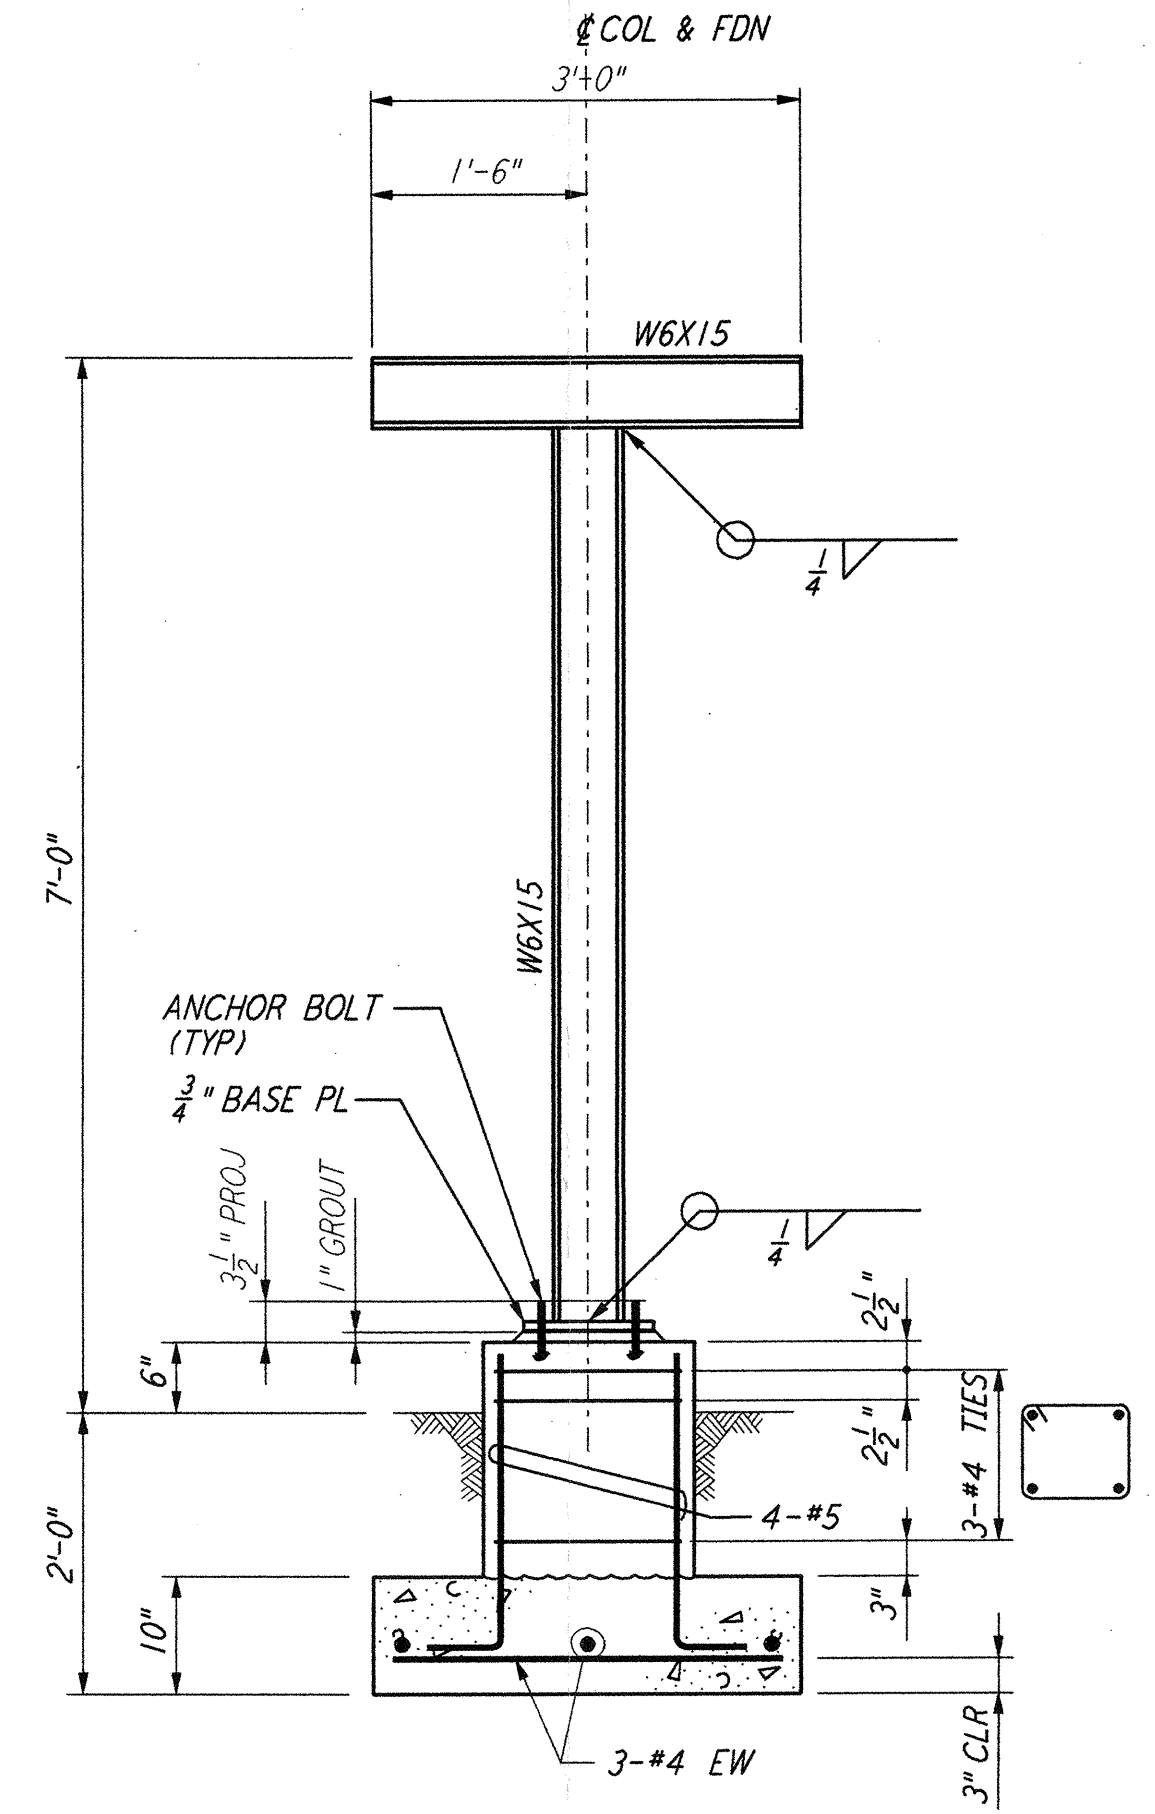


ELEVATION

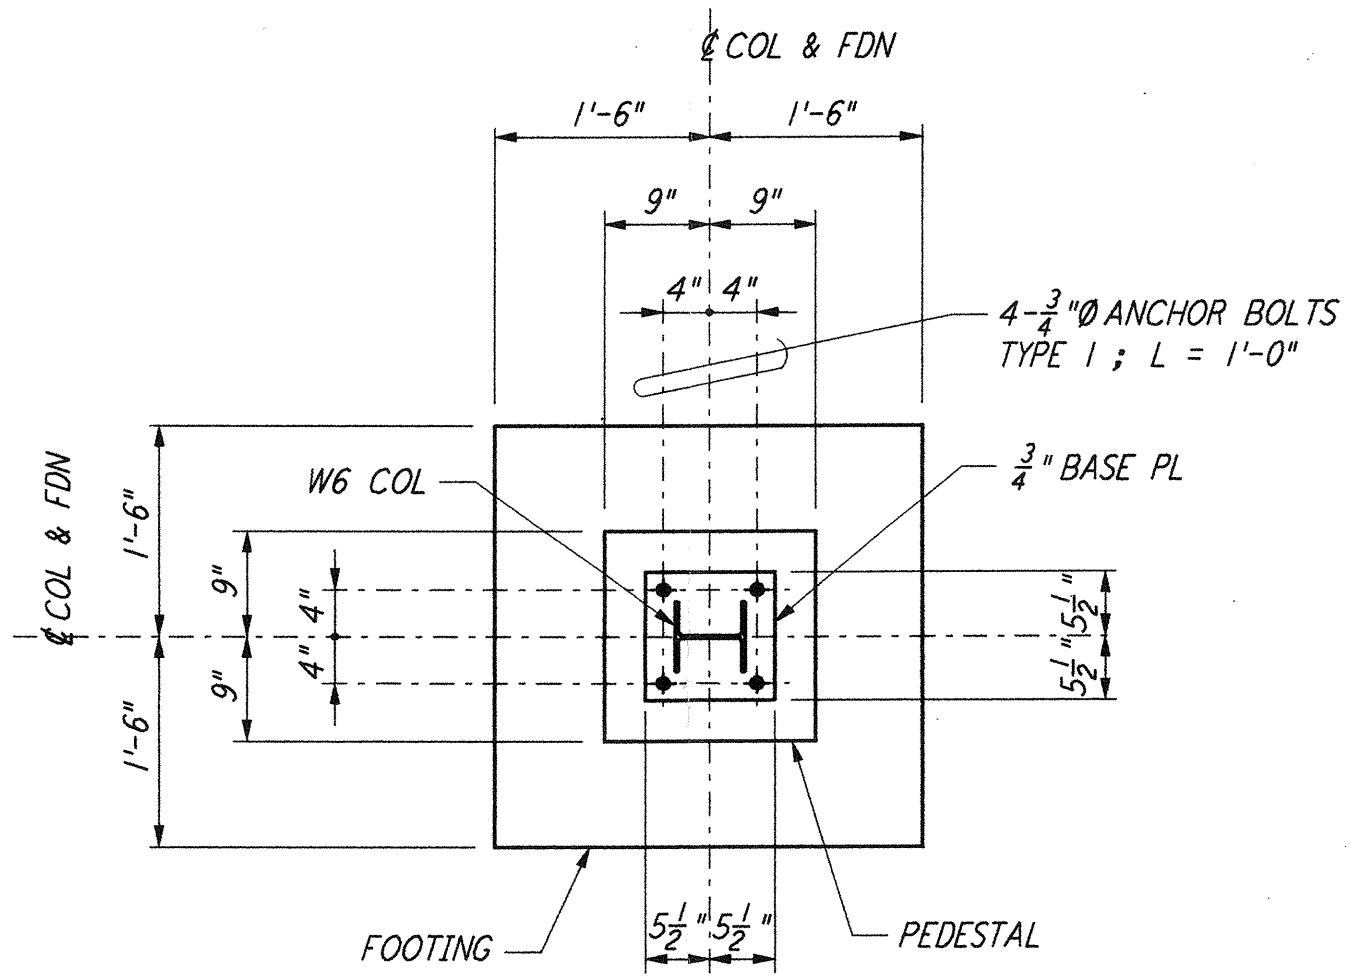


DETAIL 3 REF
 3/4" = 1'-0" WA-S-407 WA-H-116 WA-H-213 WA-H-214

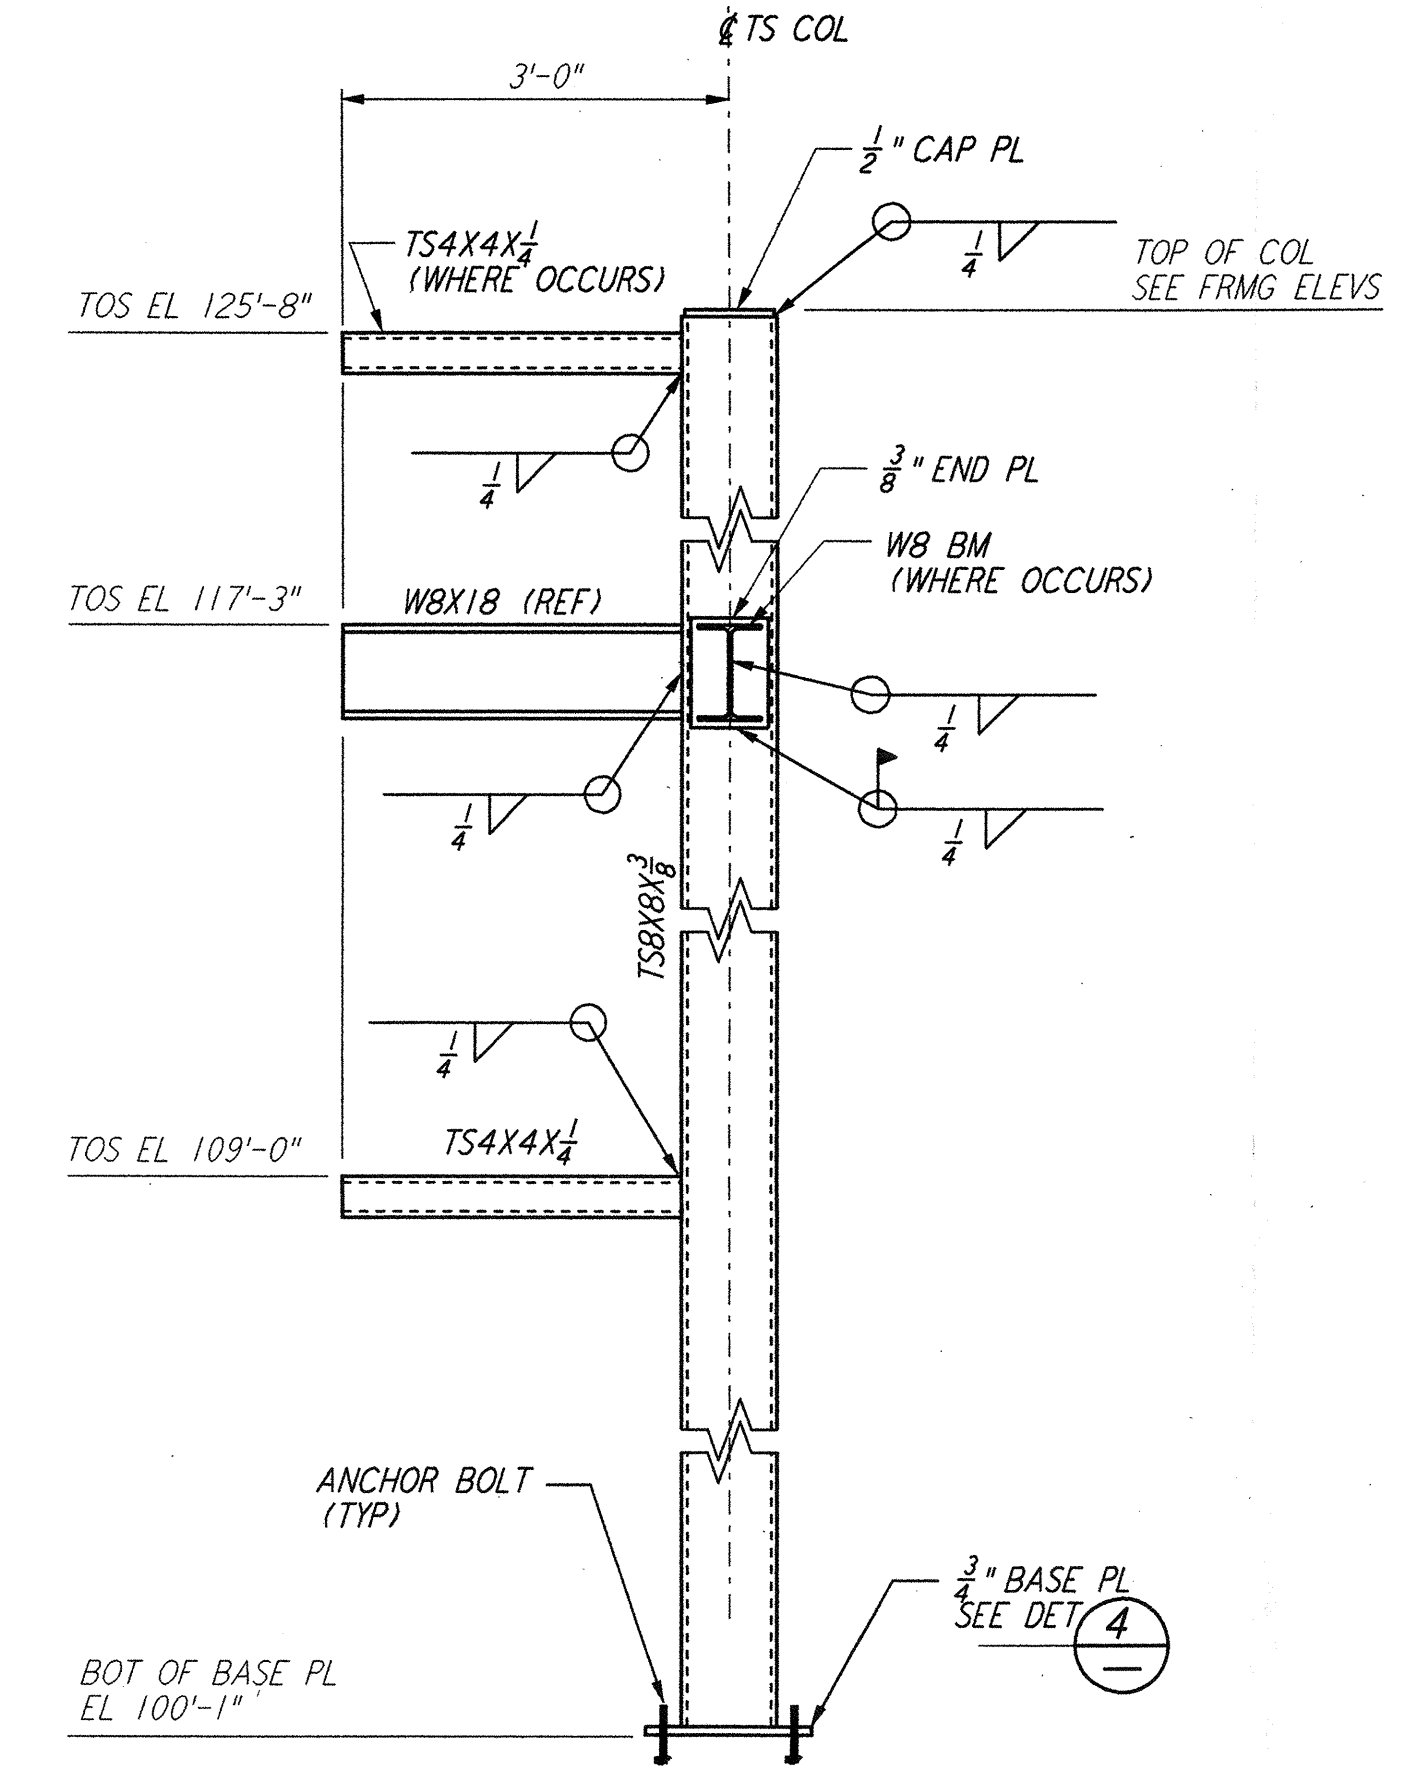


SECTION C REF
 NTS WA-S-407 WA-S-117 WA-S-124

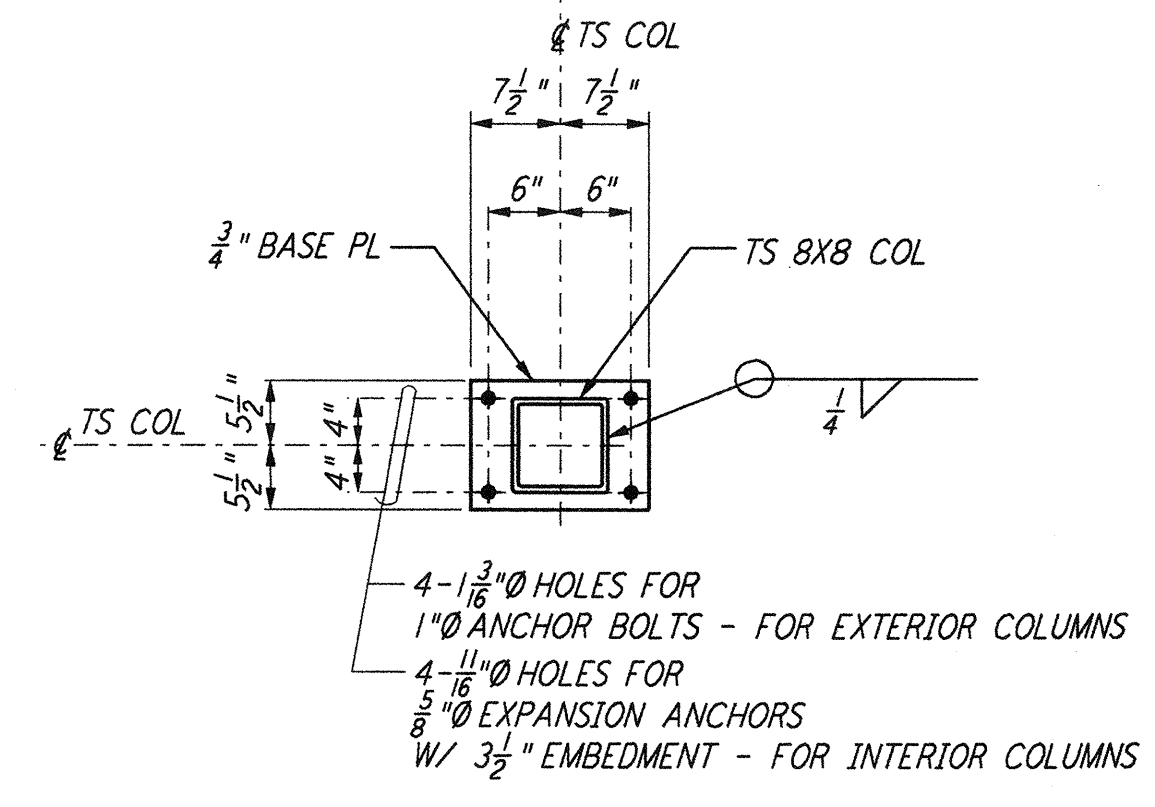


DETAIL 4

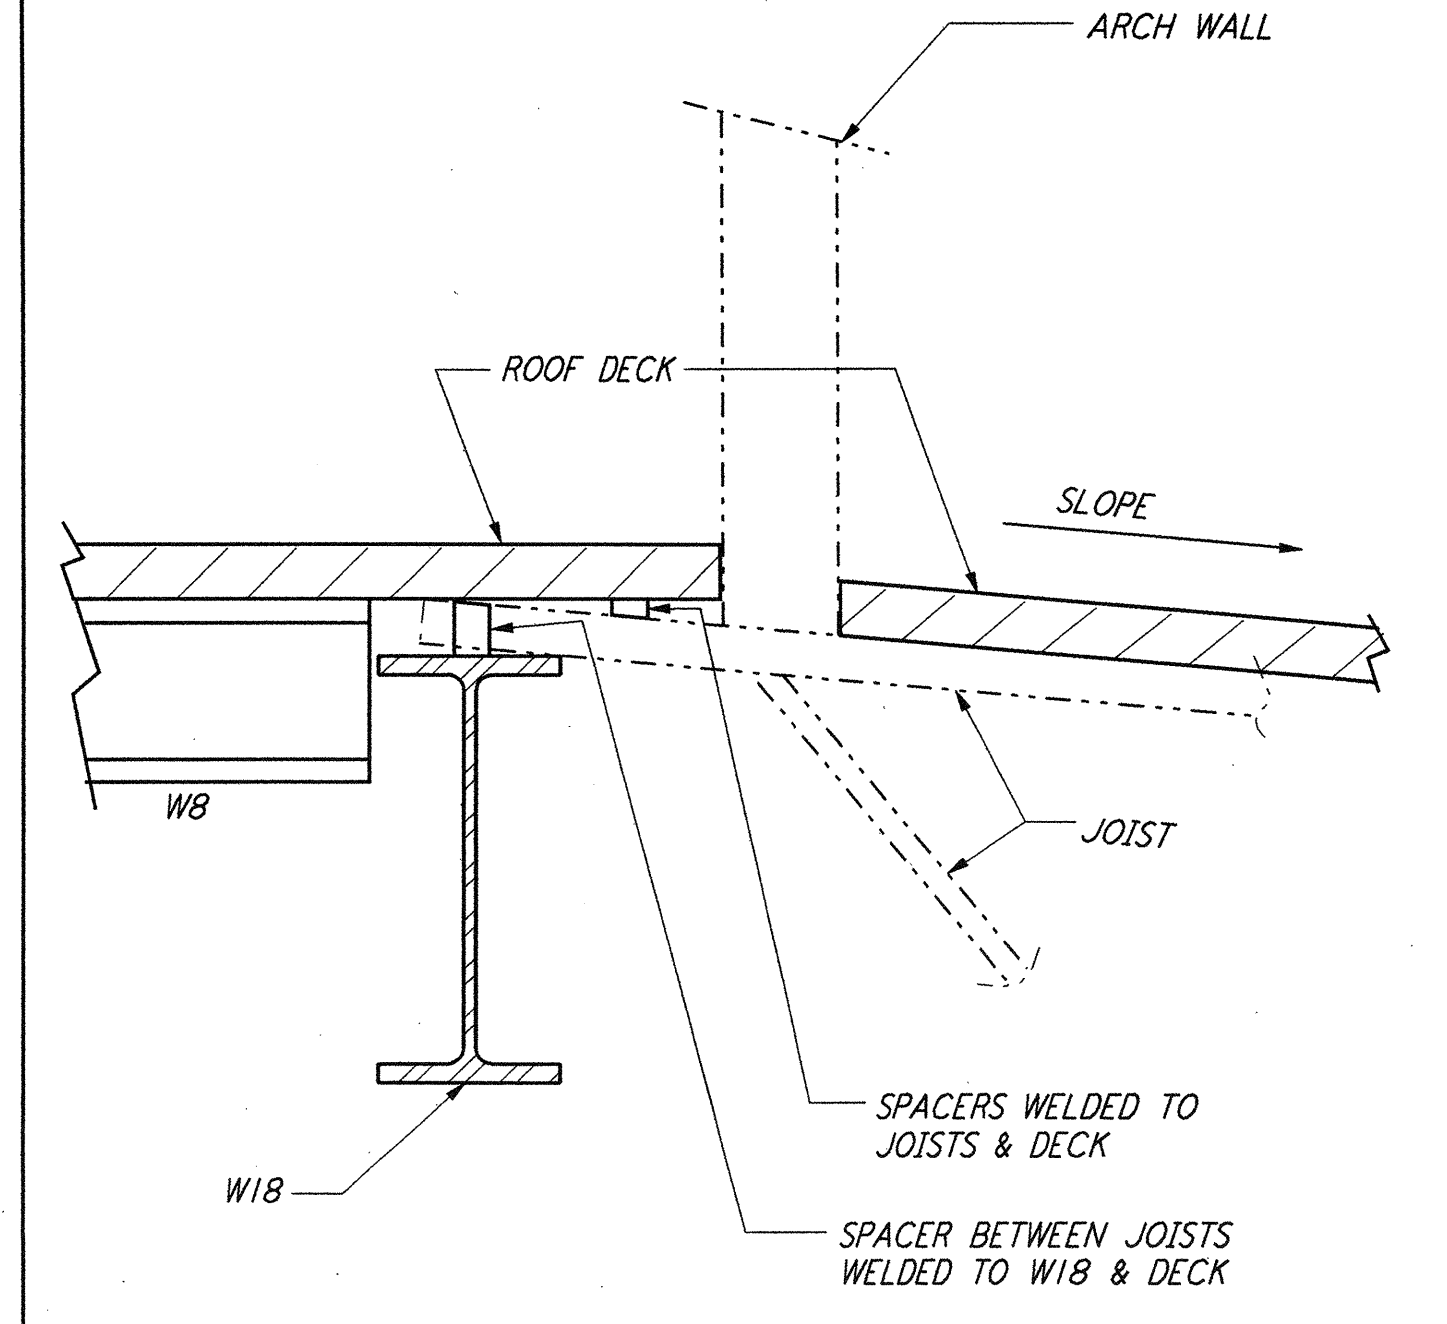


SECTION D REF
 NTS WA-S-407 WA-S-117

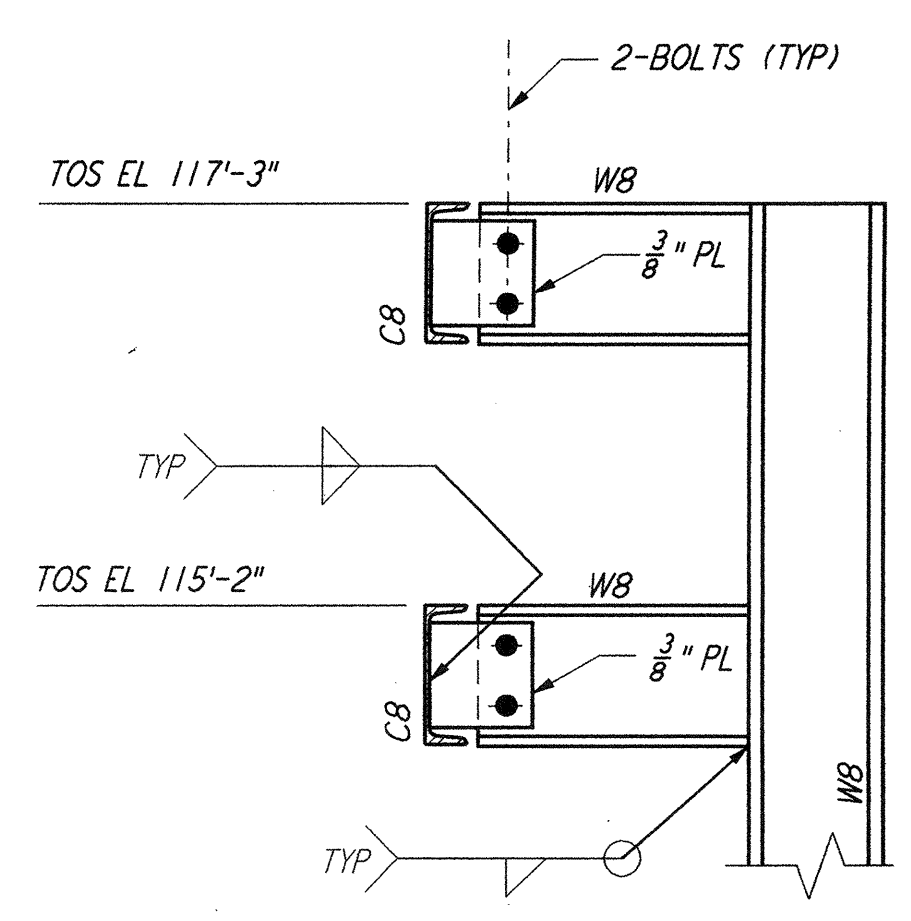


SECTION A REF
 NTS WA-S-407 WA-S-117

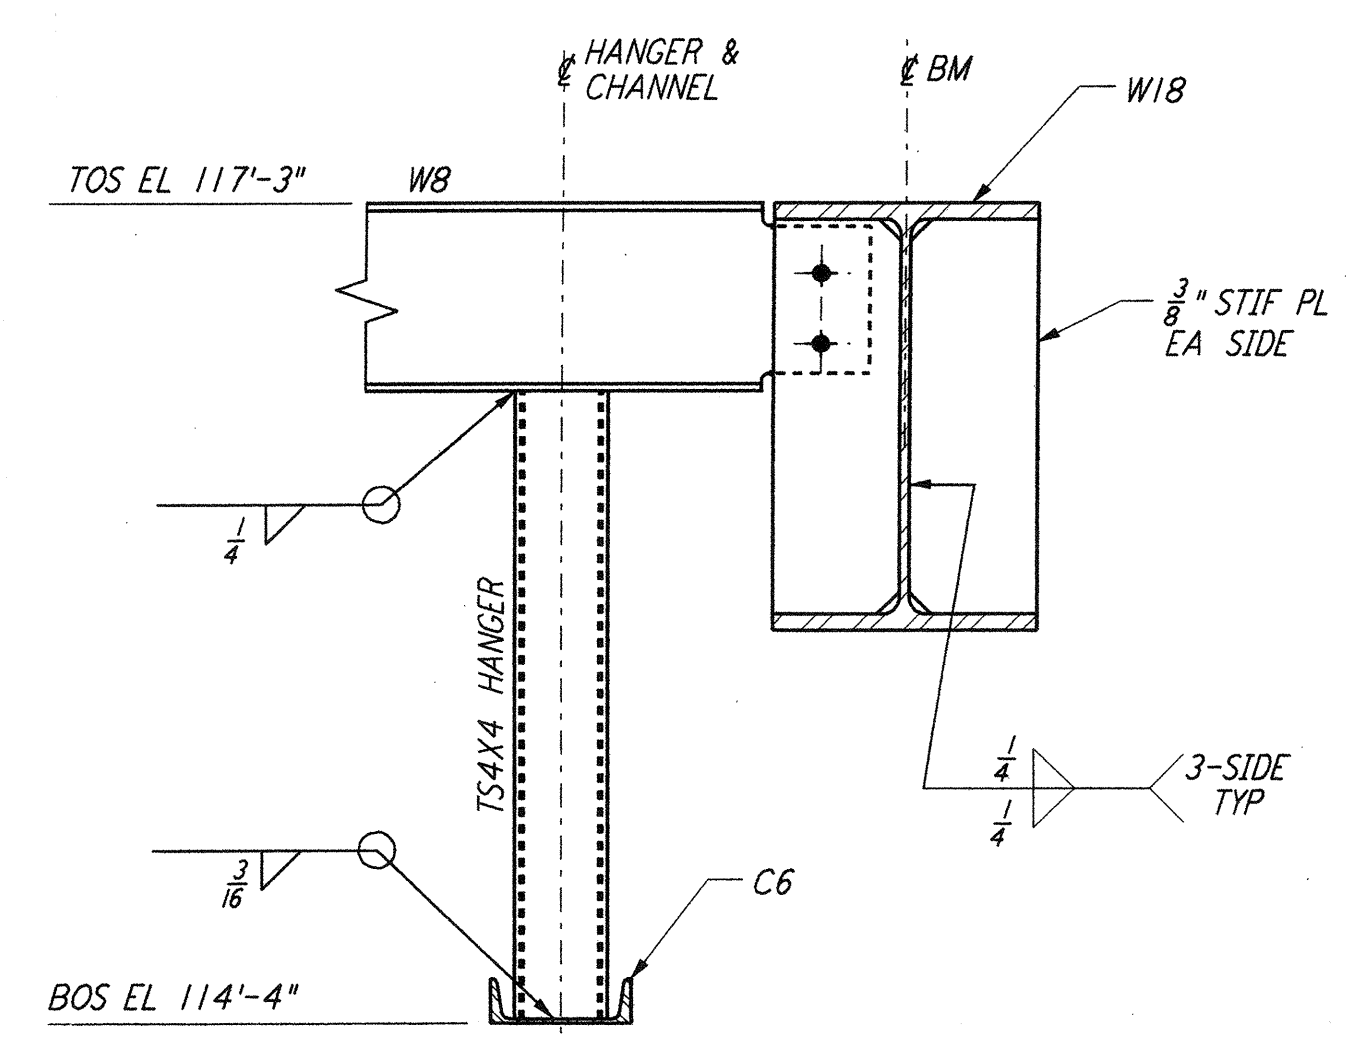

SECTION B REF
 NTS WA-S-407 WA-S-117

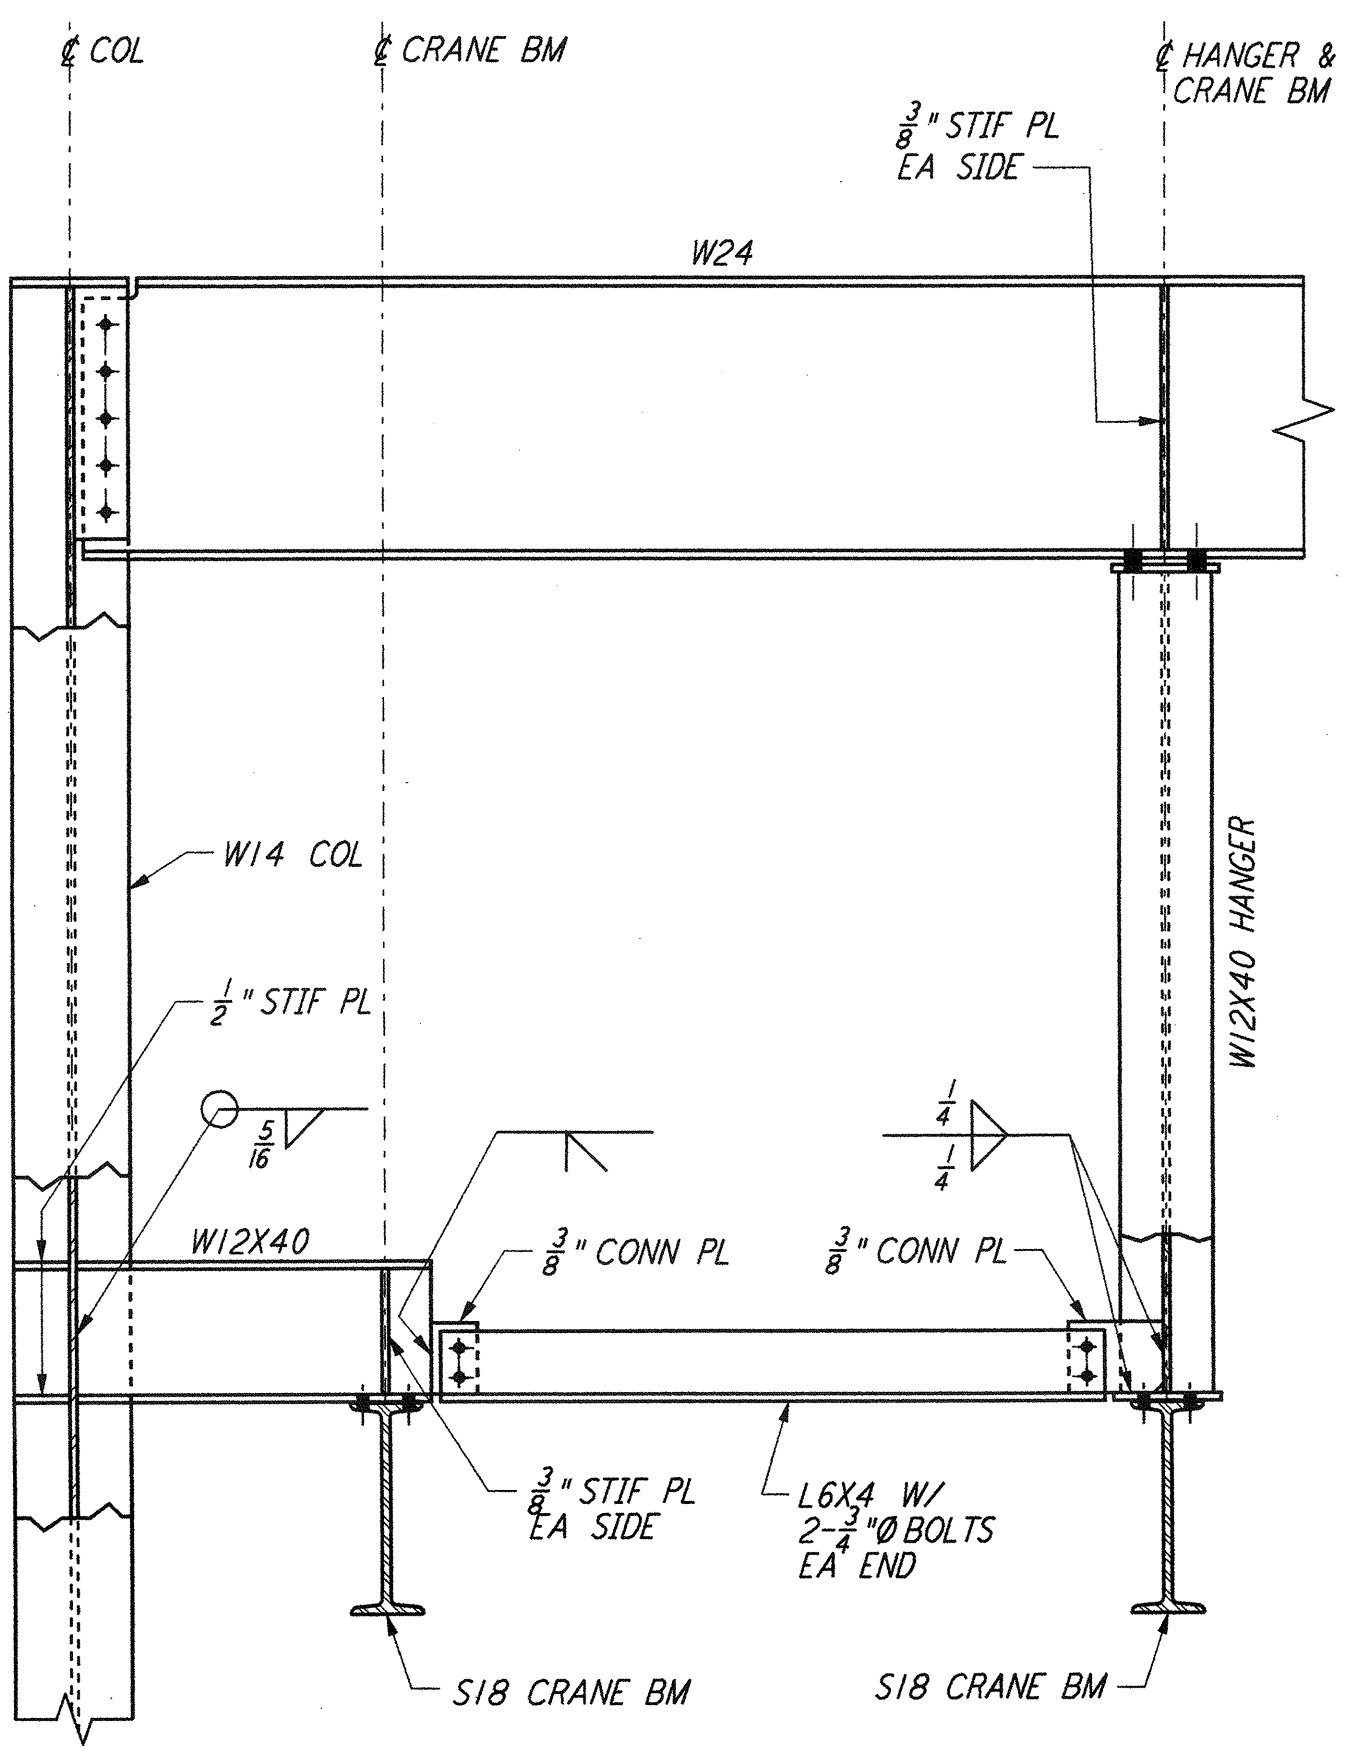

DETAIL 6 REF
 NTS WA-S-407 WA-S-514

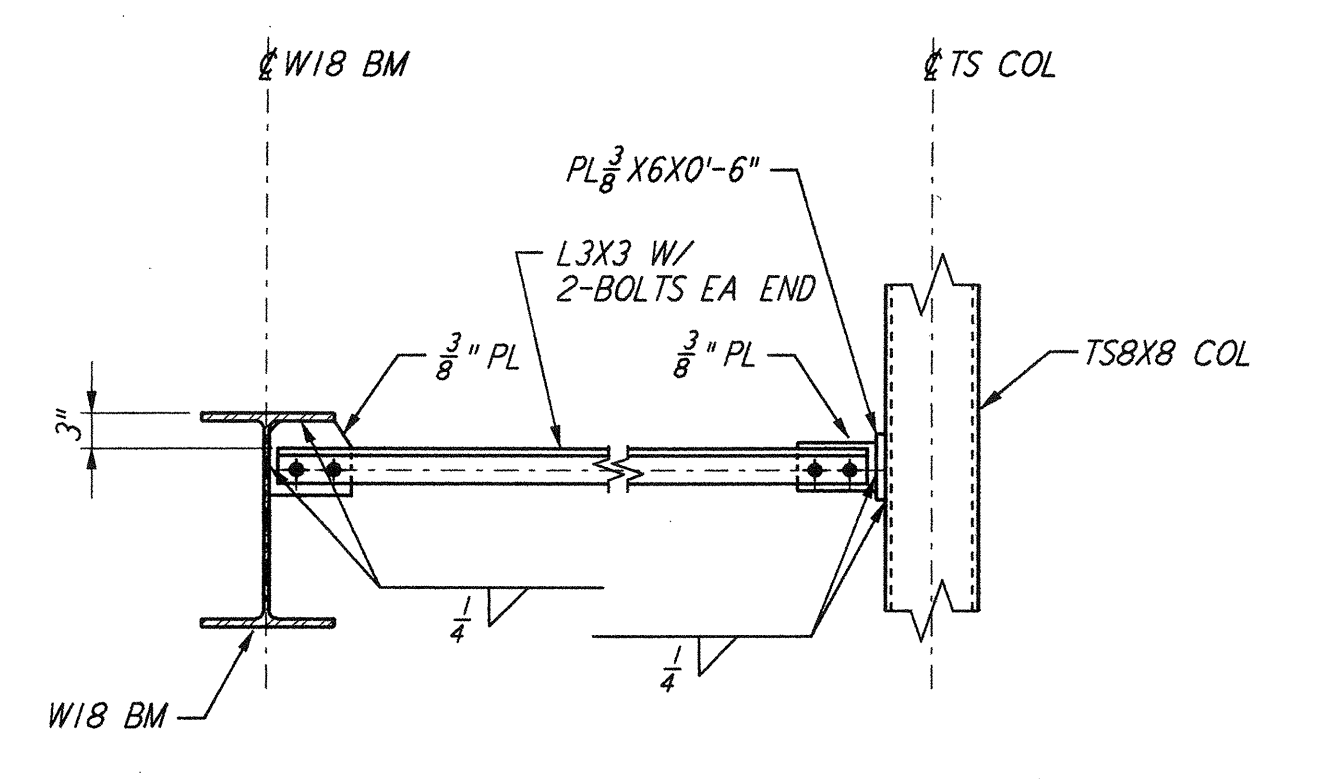

DETAIL 5 REF
 3/4" = 1'-0" WA-S-407 WA-S-117

NO.	DATE	BY	CHKD	ENGR	PROJ	DESCRIPTION
1	6-15-98	CKT				ISSUED FOR AS-BUILT

ISSUED FOR CONSTRUCTION	DATE
DRAWN	MCS 6-24-96
CHECKED	DDM 7-2-96
ENGINEER	BP 6-28-96
PROJ	MDW 7-9-96

AS-BUILT DRAWINGS

PARSONS
 100 WEST WALNUT STREET
 PASADENA, CALIFORNIA

LIGO
 CALIFORNIA INSTITUTE OF TECHNOLOGY
 MASSACHUSETTS INSTITUTE OF TECHNOLOGY

LIGO-D960321-01-0
 LASER INTERFEROMETER
 GRAVITATIONAL-WAVE OBSERVATORY
 SITE NO. 1 - HANFORD, WASHINGTON

TITLE	SCALE	CONTRACT NUMBER	PROJECT NUMBER
STRUCTURAL STEEL SECTIONS & DETAILS	AS NOTED	PP150969	8094
SHEET NUMBER	REVISIONS		
WA-S-407			

Non Vol 06 1630321-01-03-1998 C:\PLOT\01\33-1998\20CF 52085 K:\V3852\4407.dwg