




This document and the design it covers are the property of PARSONS. They are loaned only with the borrower's expressed written agreement that they will not be reproduced, copied, loaned, exhibited, or used in any other way, except by written consent from PARSONS to the borrower.

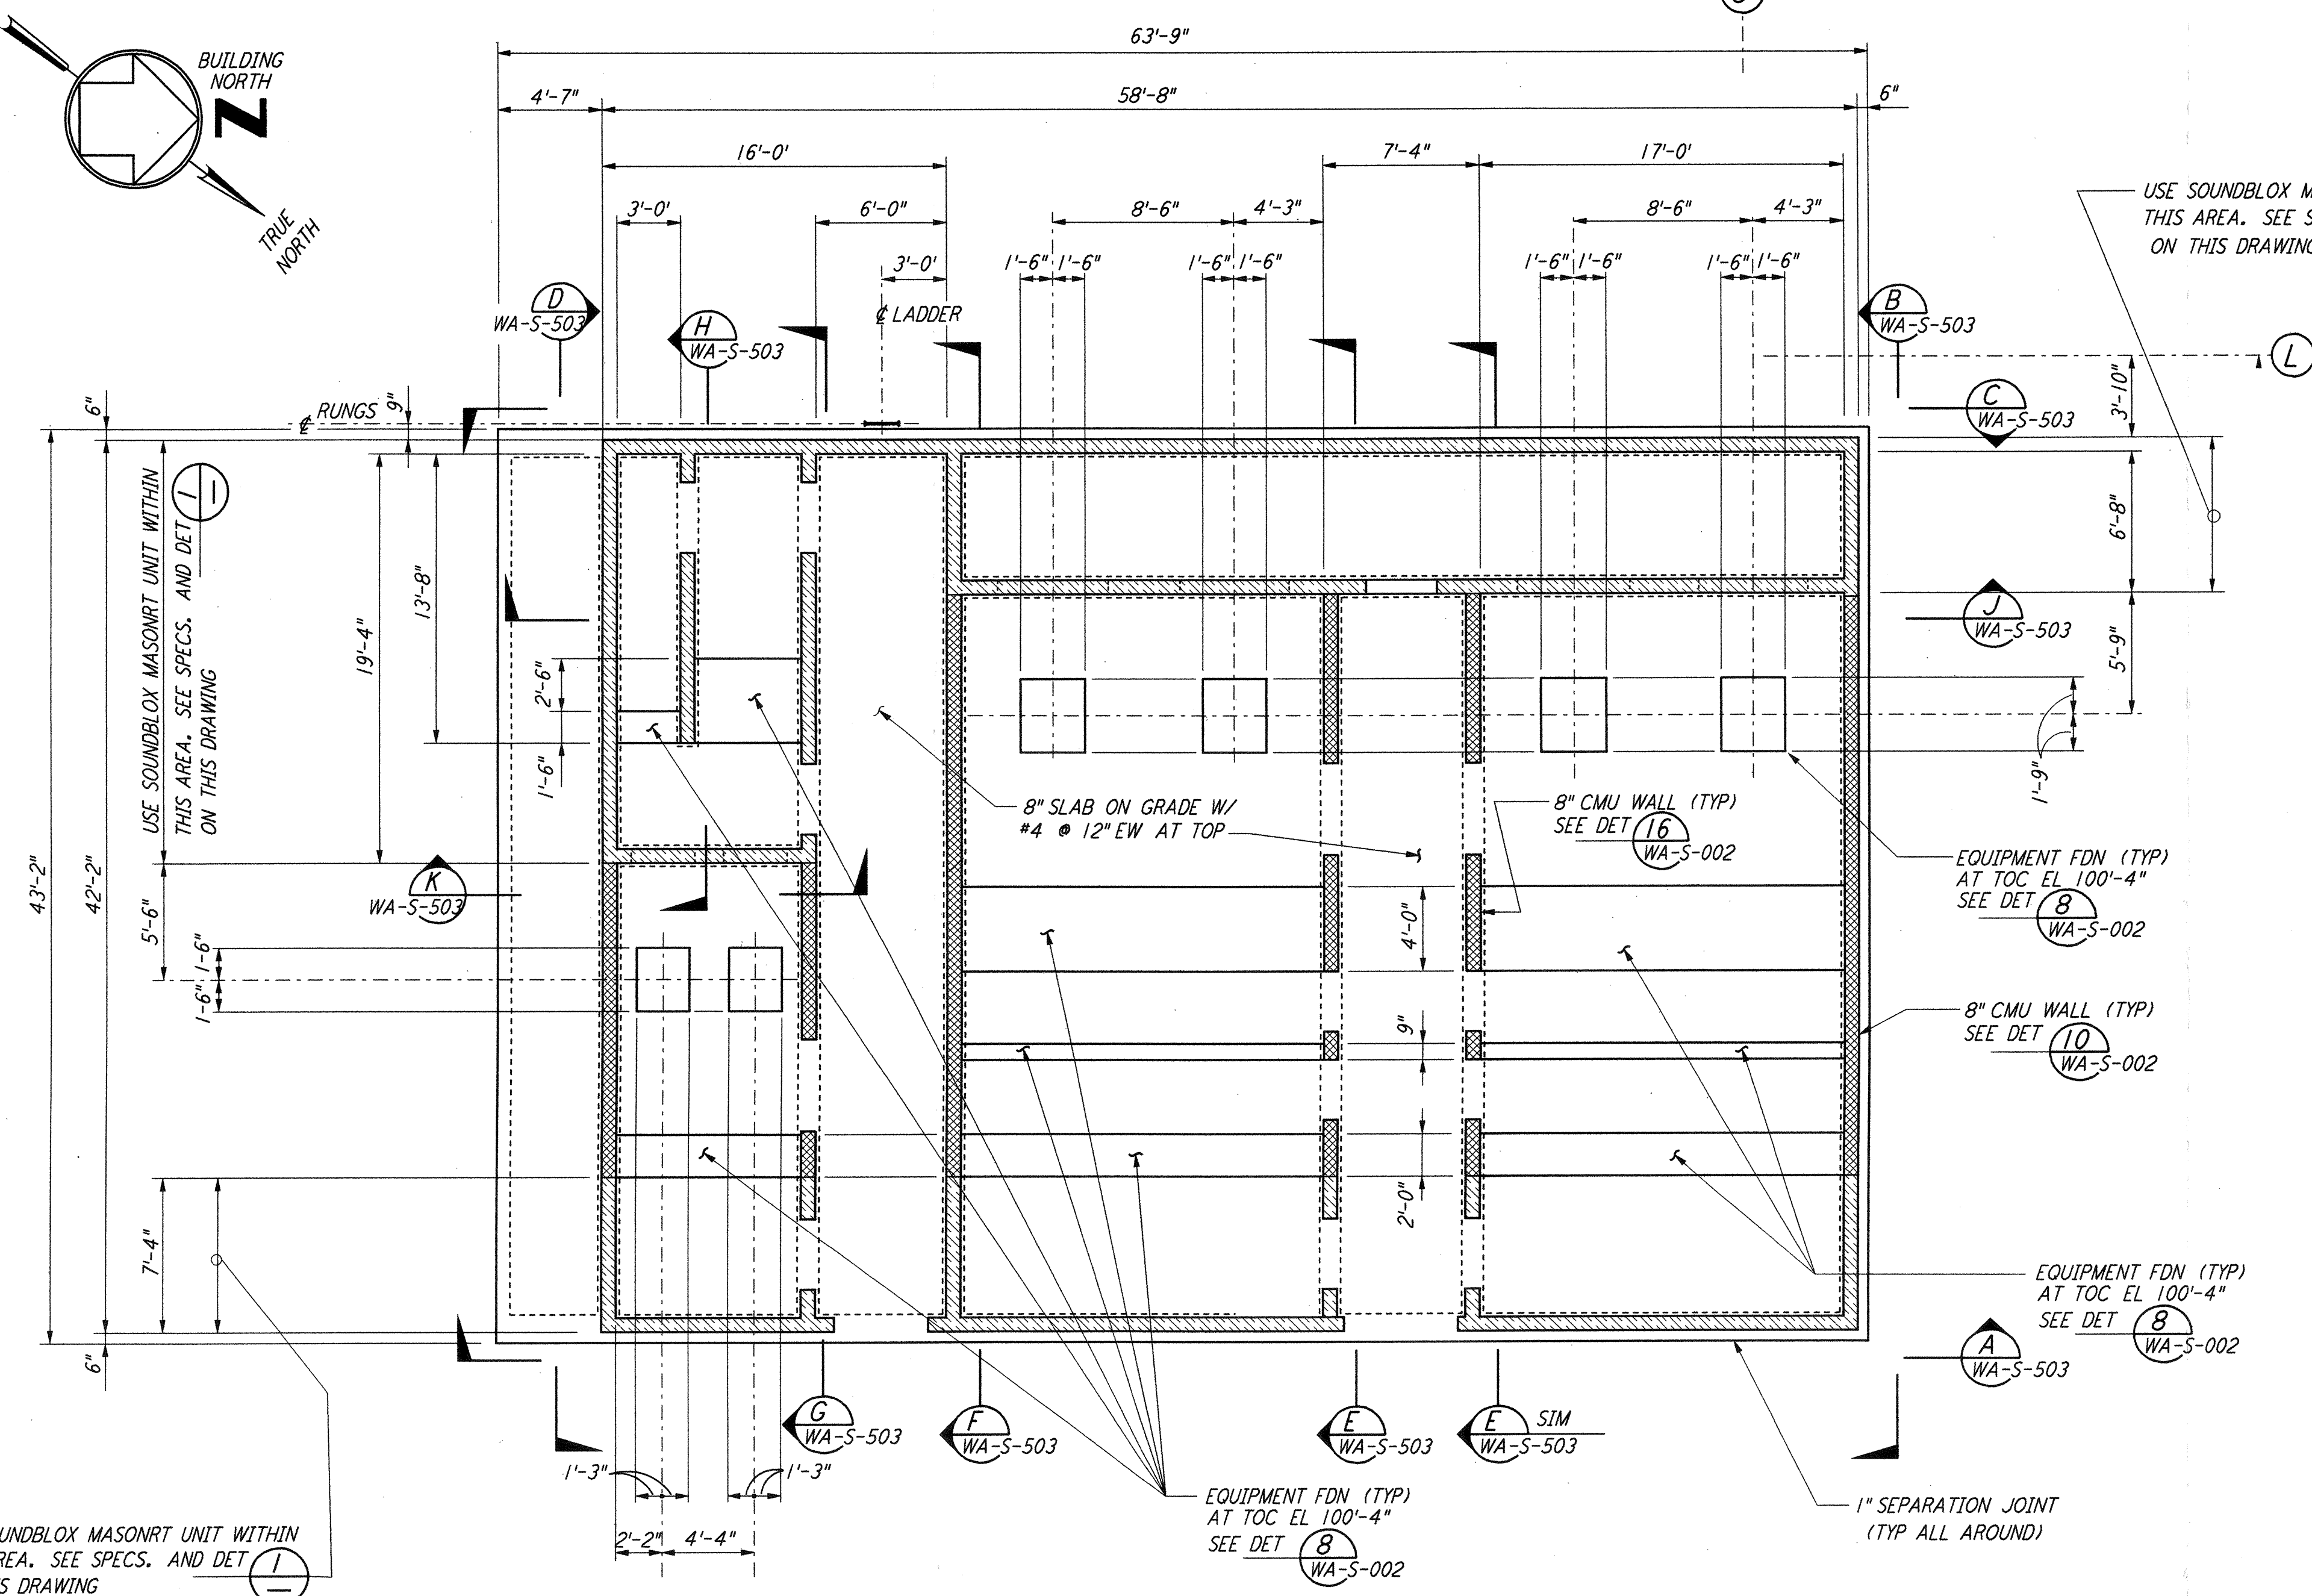


**AIR HANDLING UNIT STRUCTURE  
 FOUNDATION PLAN**  
 $\frac{3}{8}'' = 1'-0''$

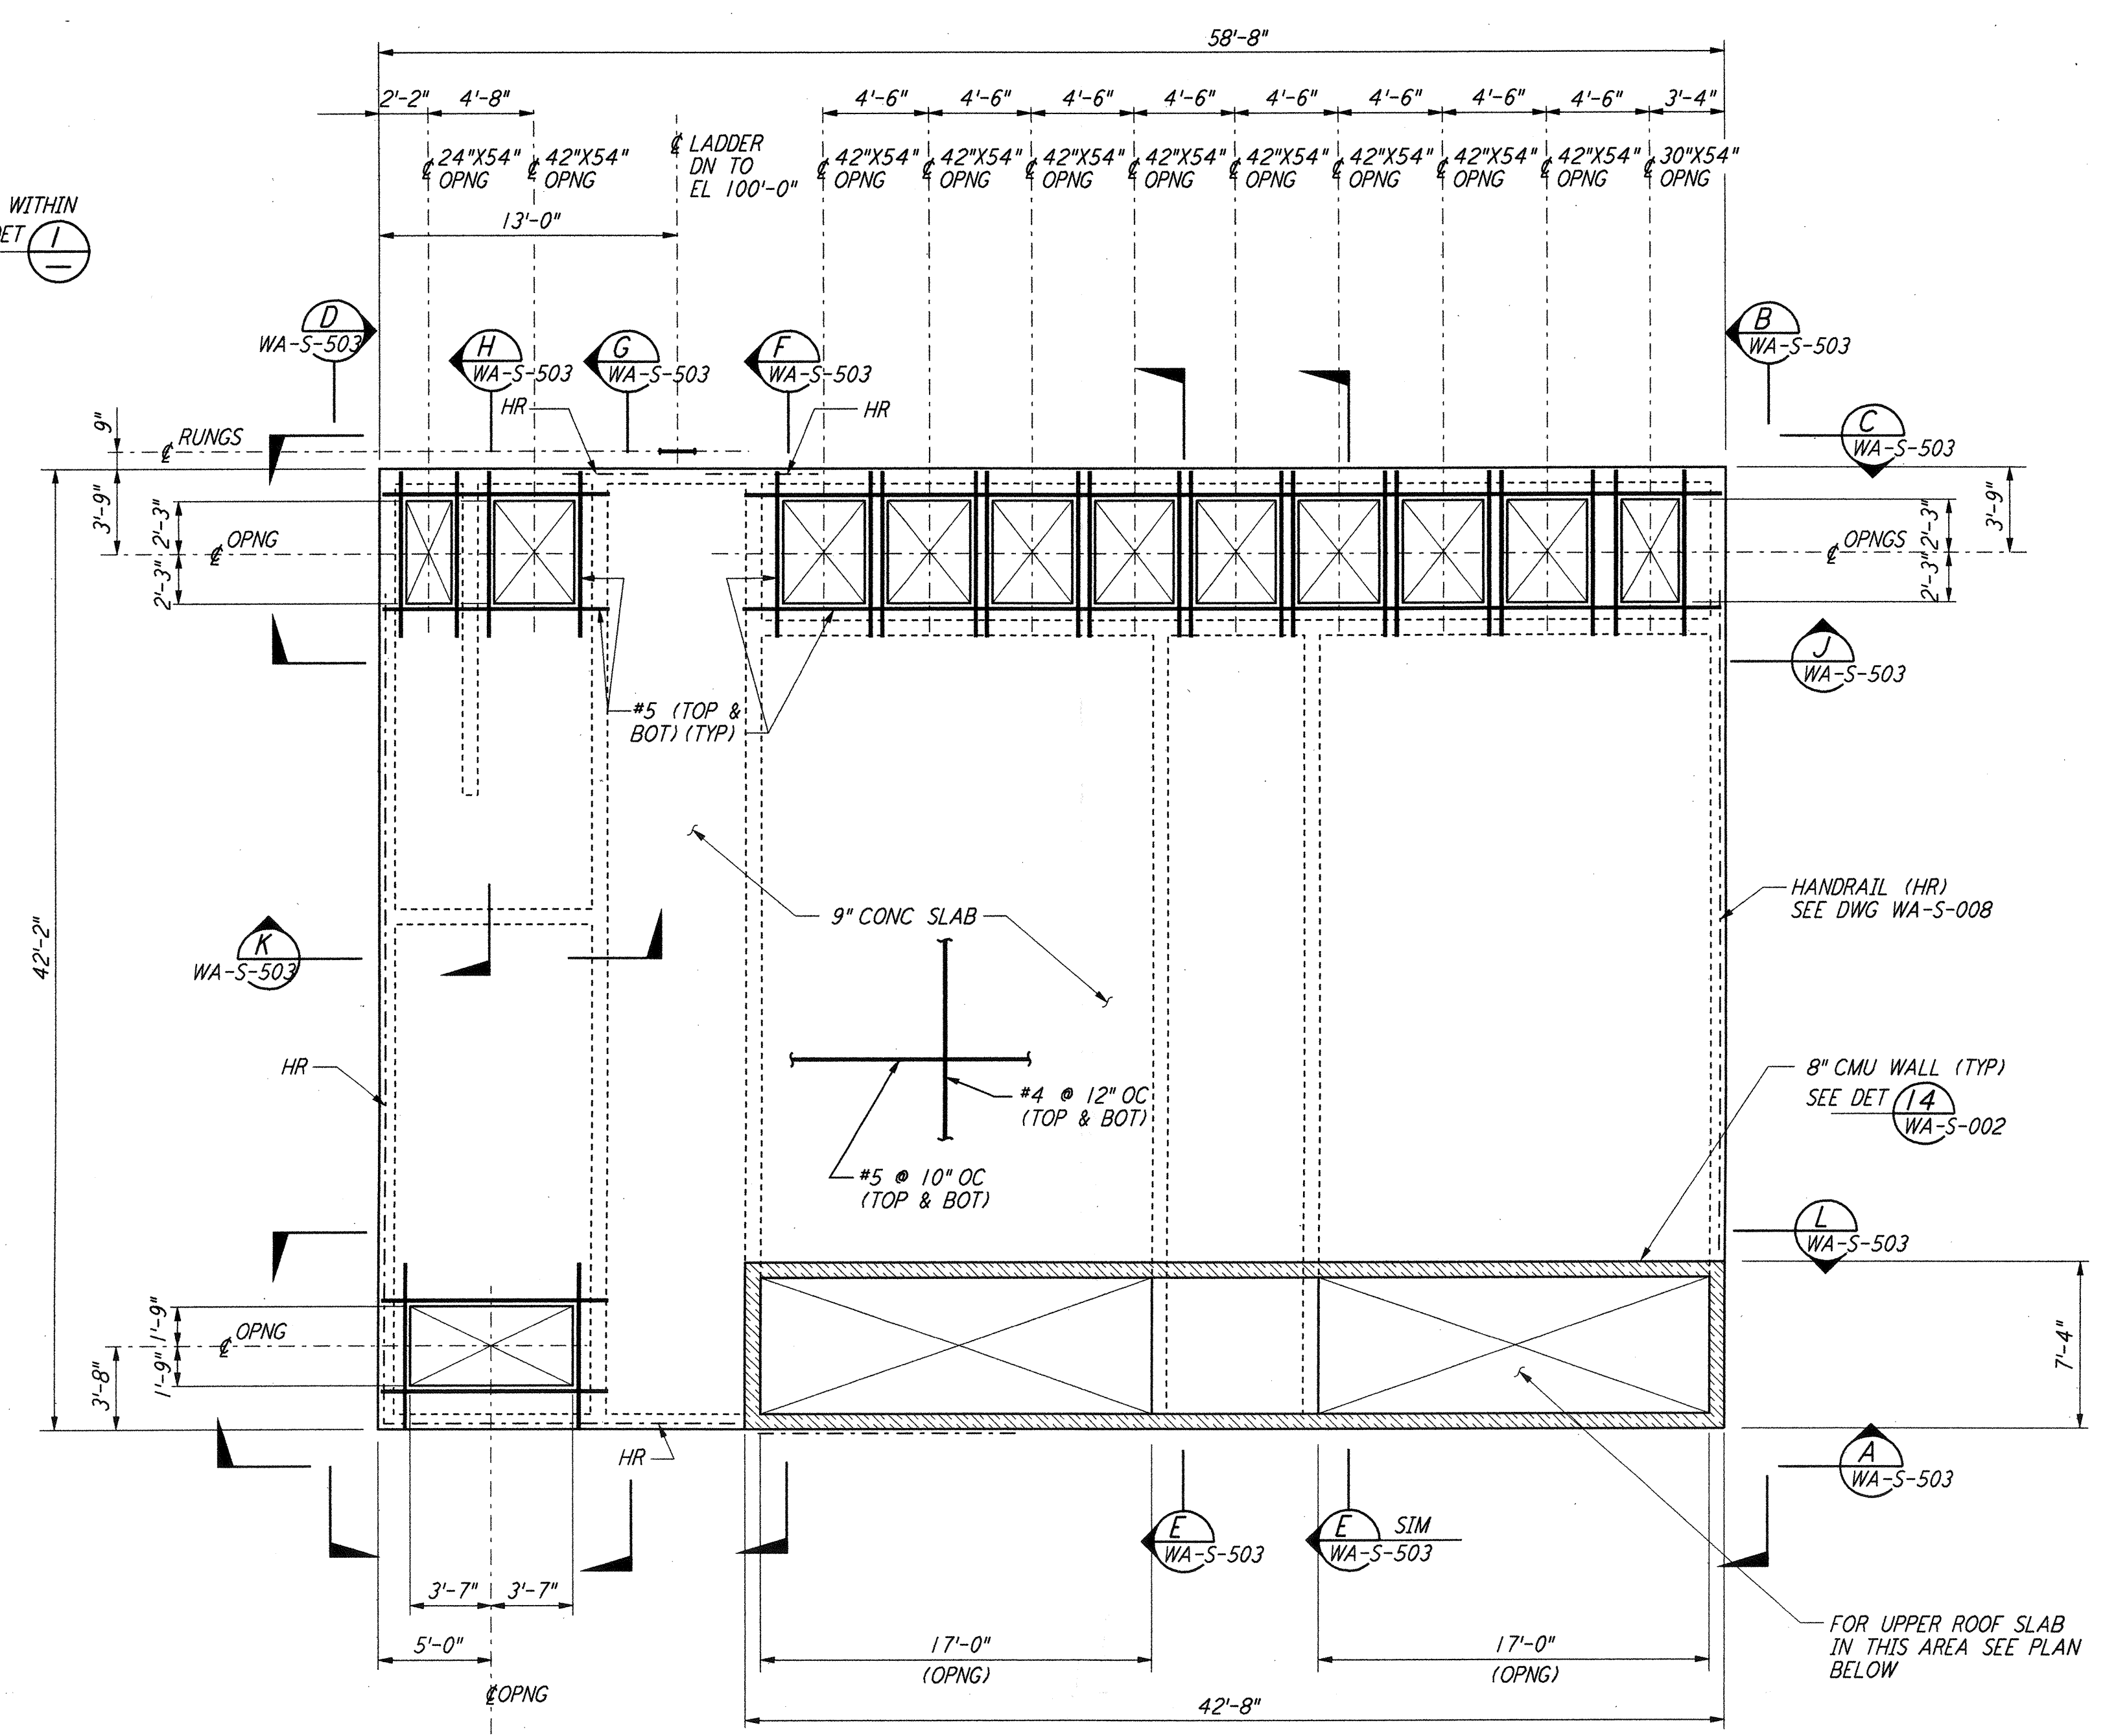

**AIR HANDLING UNIT STRUCTURE  
 LOWER CONCRETE ROOF SLAB PLAN**  
 TOC EL 110'-7"  
 $\frac{3}{8}'' = 1'-0''$

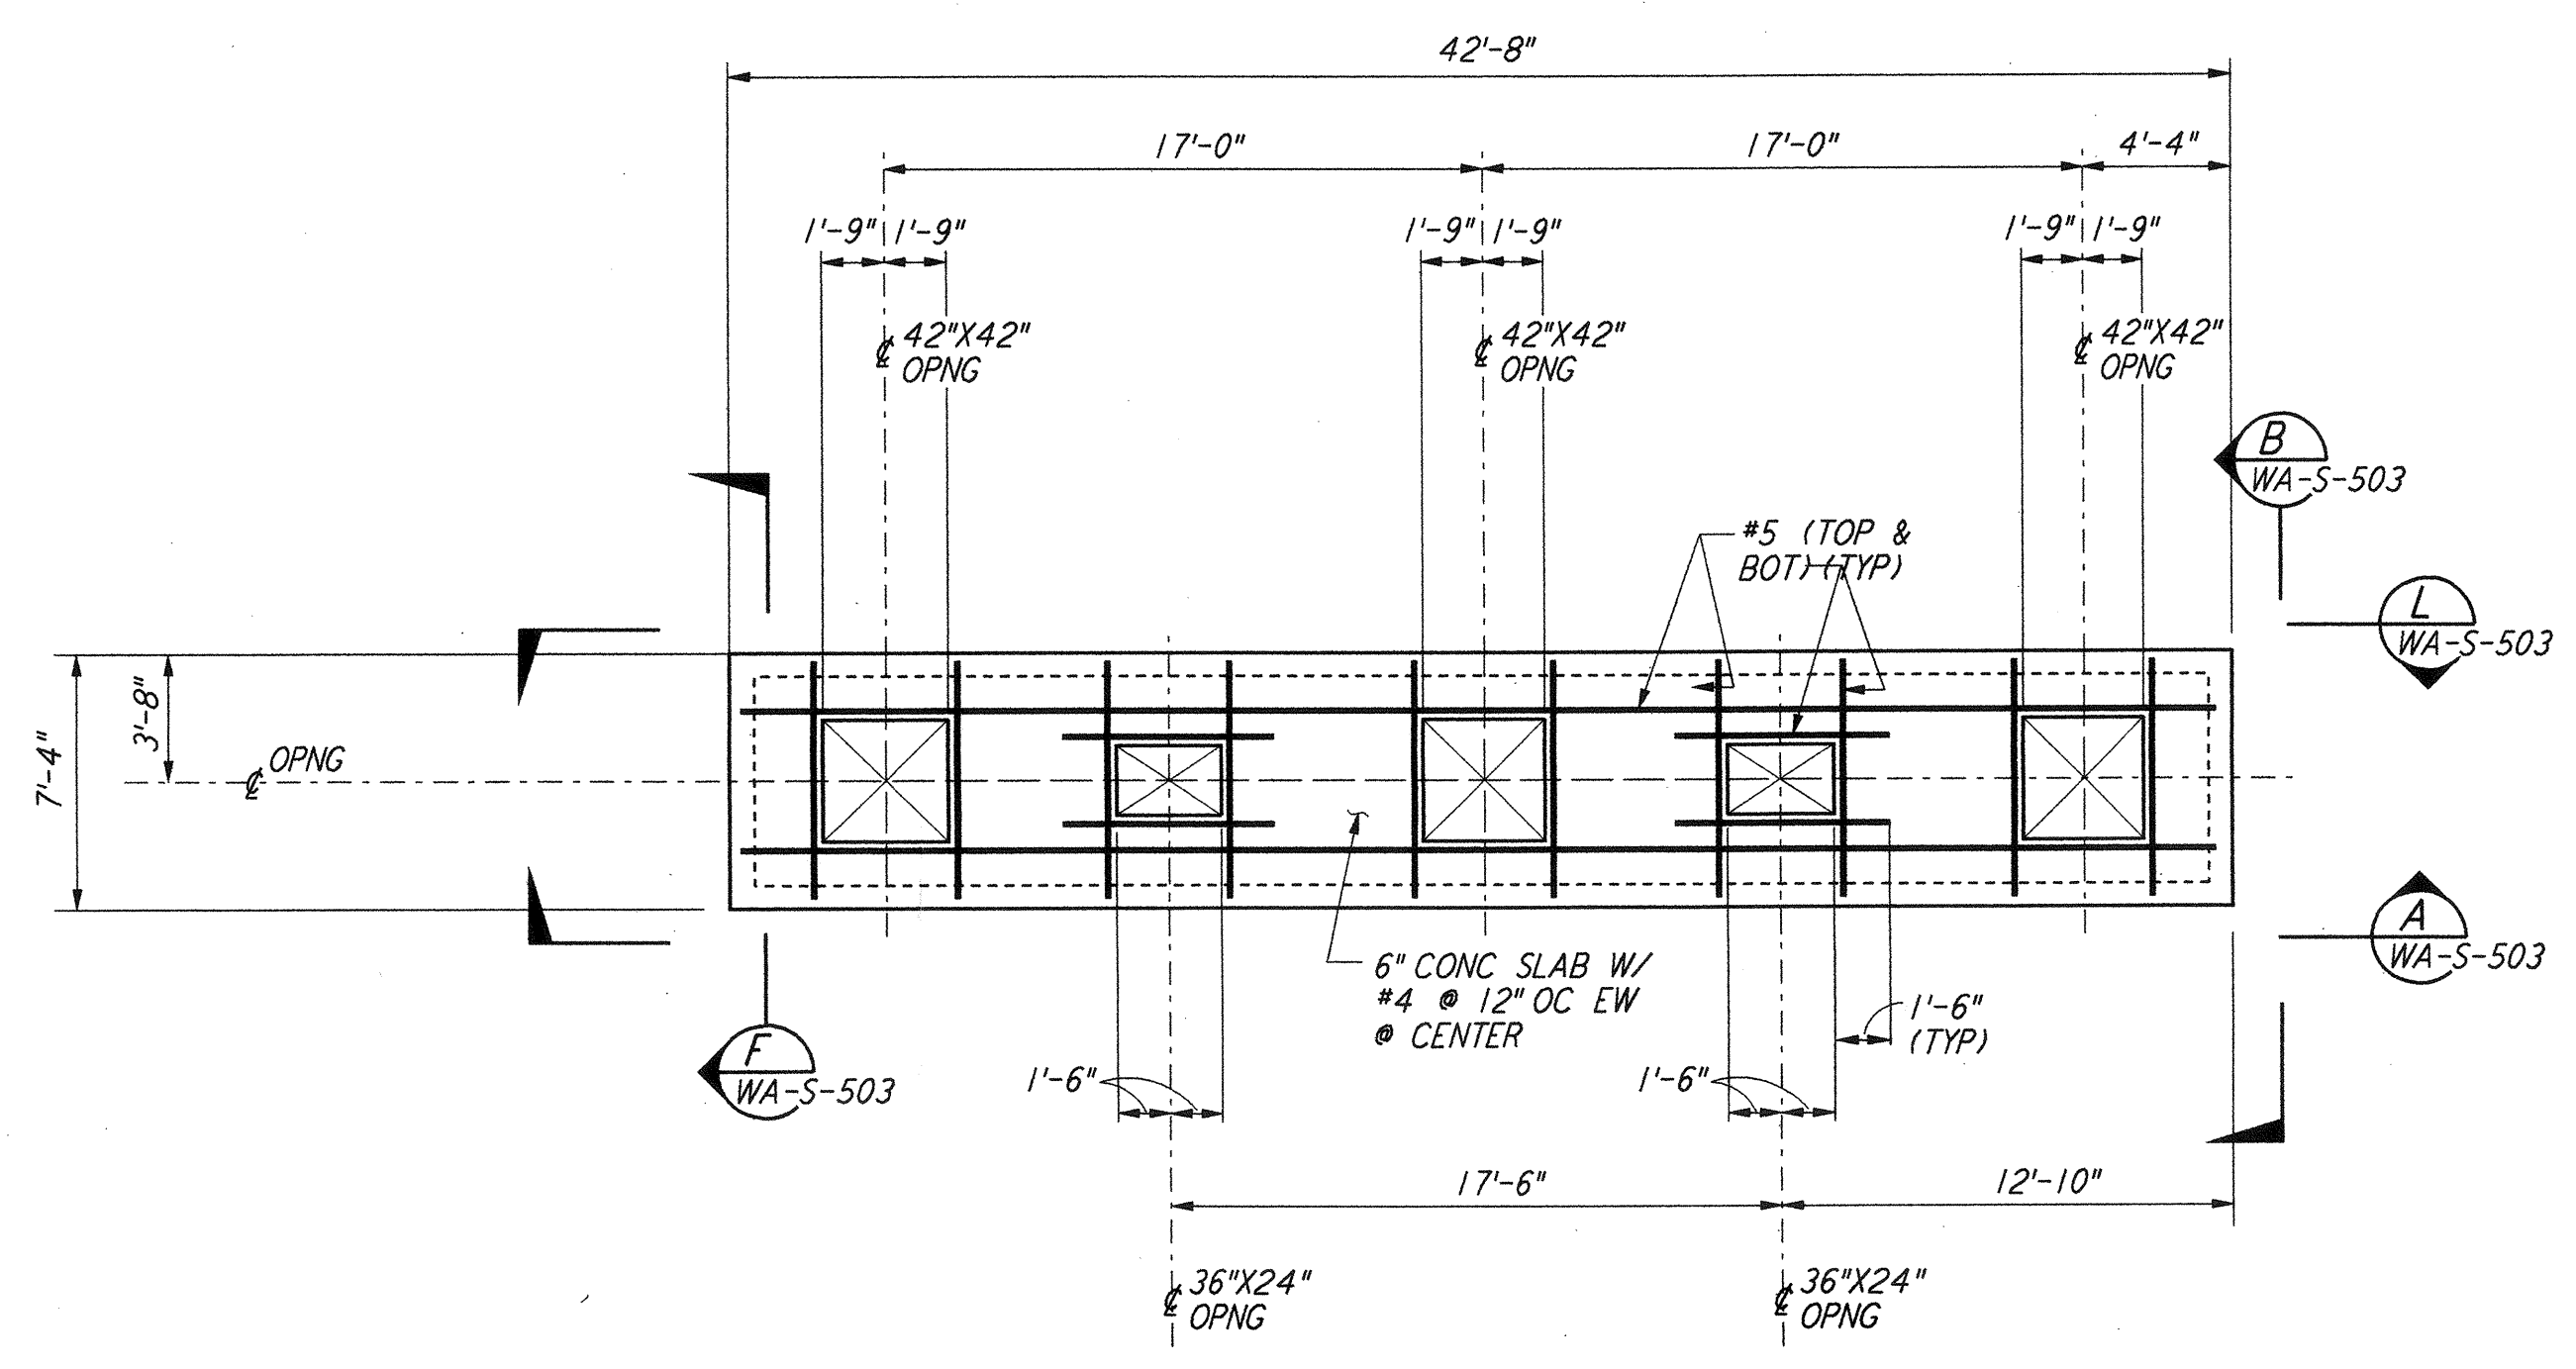


**AIR HANDLING UNIT STRUCTURE  
 UPPER CONCRETE ROOF SLAB PLAN**  
 TOC EL 115'-2"  
 $\frac{3}{8}'' = 1'-0''$

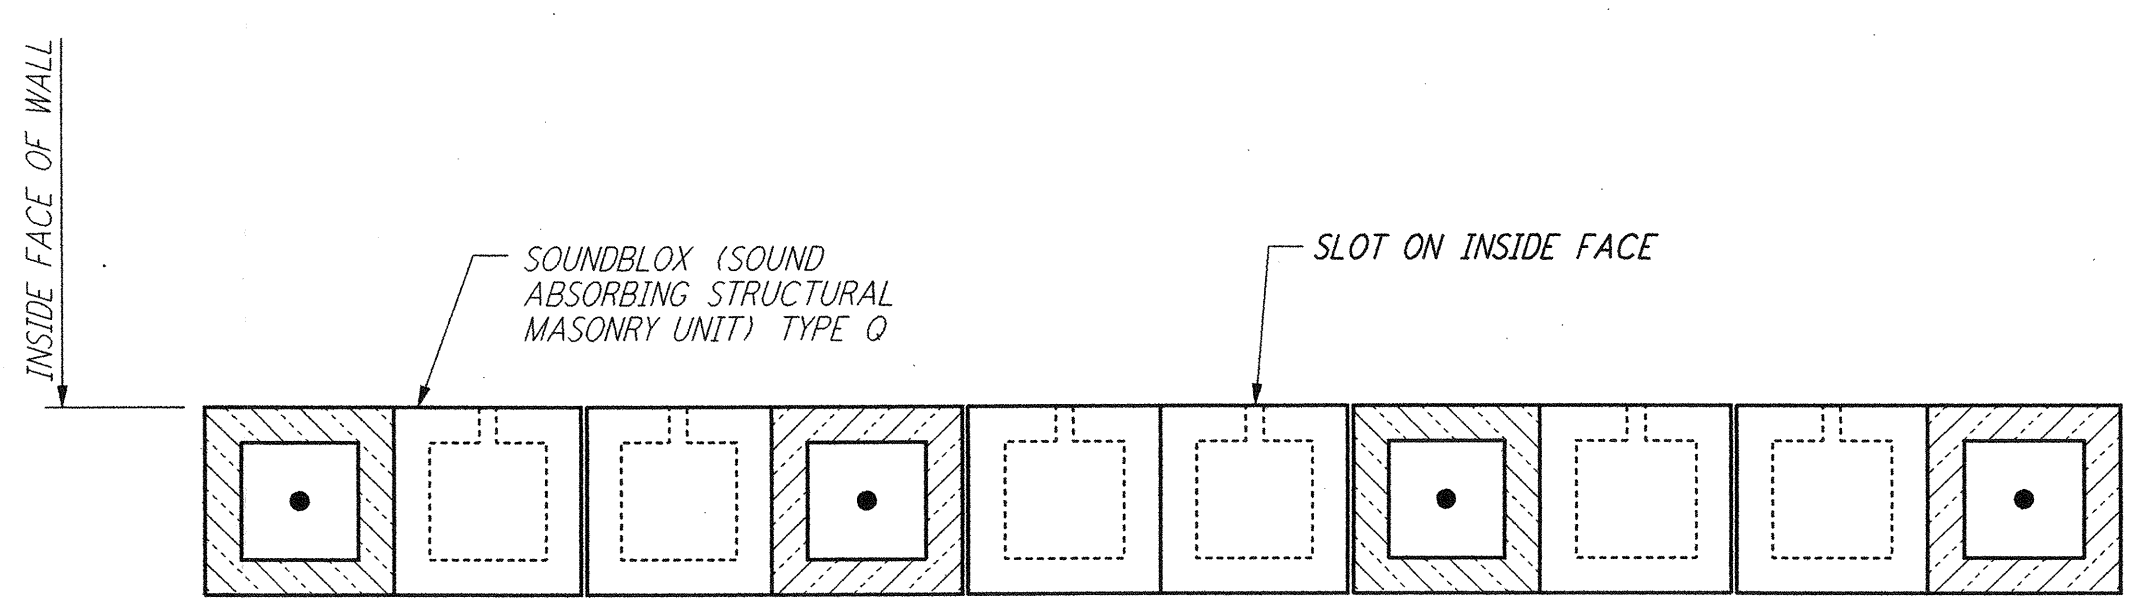

**TYPICAL SECTION OF SOUNDBLOX MASONRY WALL  
 DETAIL (I)**  
 $\frac{1}{2}'' = 1'-0''$

- NOTES:**
- FOR GENERAL NOTES, ABBREVIATIONS & SYMBOLS SEE DRAWING WA-S-001.
  - CONTRACTOR SHALL ADJUST LOCATION AND SIZE OF EQUIPMENT PADS TO SUIT VENDOR EQUIPMENTS.

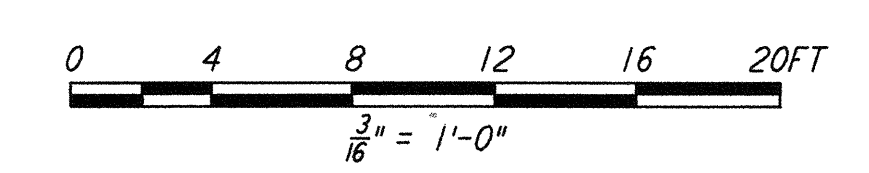

NO.	DATE	BY	CHKD	ENGR	PROJ	DESCRIPTION
1	6-15-98	CKT	BP	BP		ISSUED FOR AS-BUILT

ISSUED FOR CONSTRUCTION		
DRAWN	MCS	6-24-96
CHECKED	DDM	7-2-96
ENGINEER	BP	6-28-96
PROJ	MDW	7-9-96

**AS-BUILT DRAWINGS**

**PARSONS**  
 100 WEST WALNUT STREET  
 PASADENA, CALIFORNIA

**LIGO**  
 CALIFORNIA INSTITUTE OF TECHNOLOGY  
 MASSACHUSETTS INSTITUTE OF TECHNOLOGY

**LASER INTERFEROMETER  
 GRAVITATIONAL-WAVE OBSERVATORY  
 SITE NO. 1 - HANFORD, WASHINGTON**

**STRUCTURAL CORNER STATION AIR HANDLING UNIT ENCLOSURE PLAN**

SCALE: AS NOTED  
 CONTRACT NUMBER: PP150969  
 PROJECT NUMBER: 8094  
 SHEET NUMBER: **WA-S-502**