




**AIR HANDLING UNIT STRUCTURE
FOUNDATION PLAN**
1/8" = 1'-0"

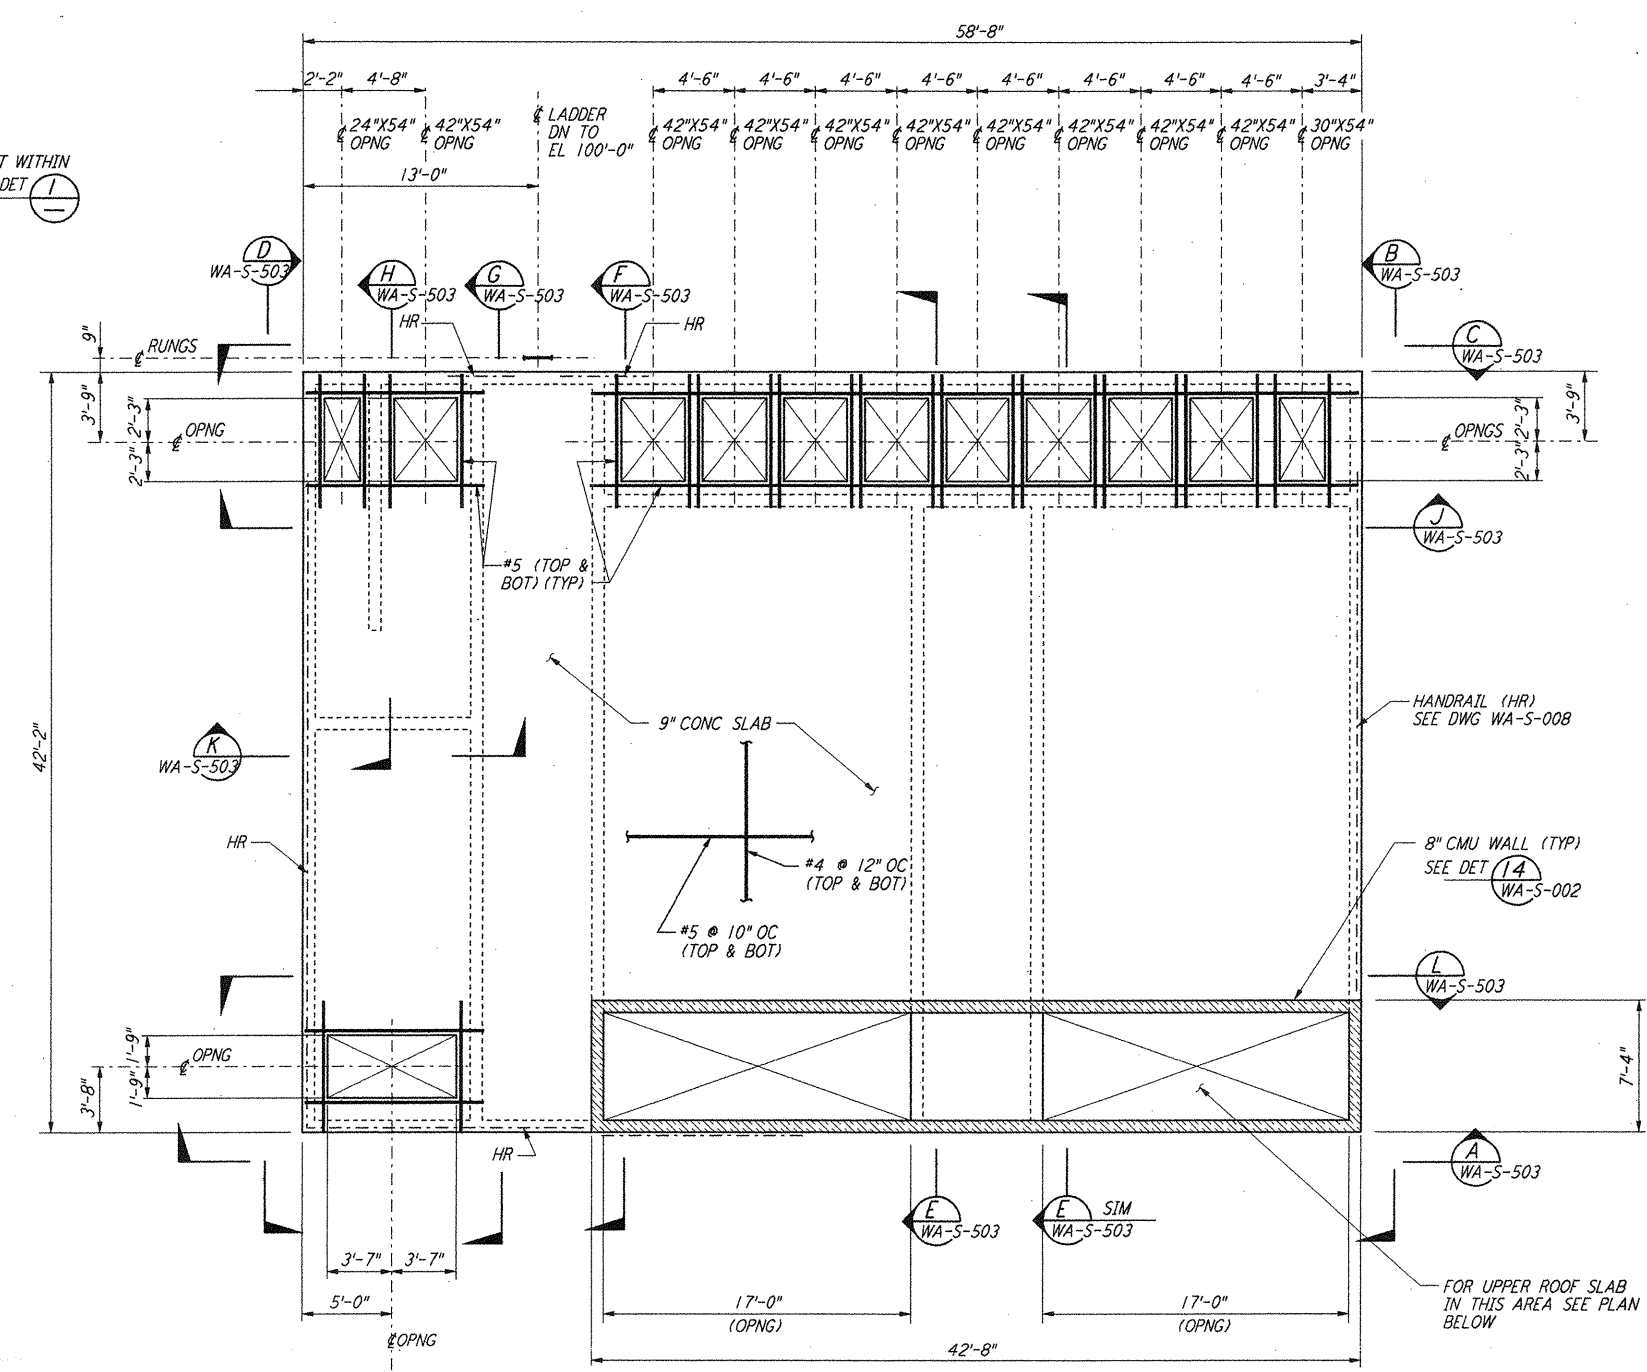

**AIR HANDLING UNIT STRUCTURE
LOWER CONCRETE ROOF SLAB PLAN**
1/8" = 1'-0"
TOC EL 110'-7"

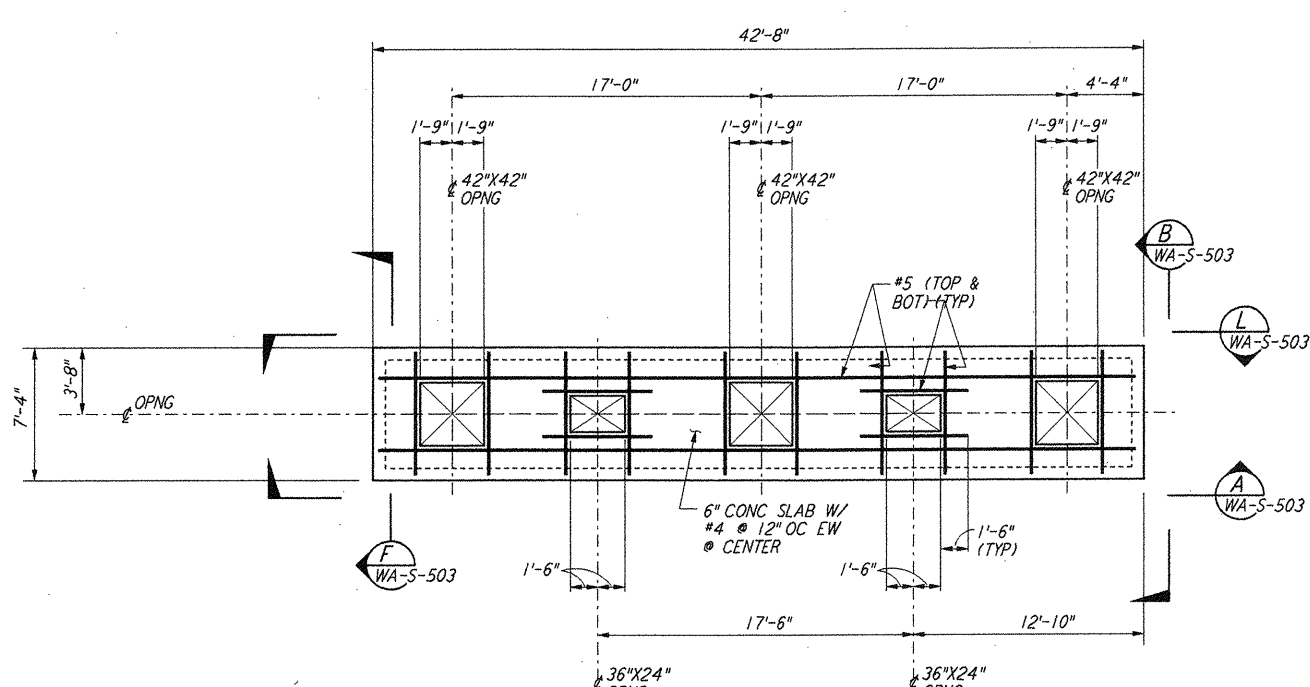


**AIR HANDLING UNIT STRUCTURE
UPPER CONCRETE ROOF SLAB PLAN**
1/8" = 1'-0"
TOC EL 115'-2"

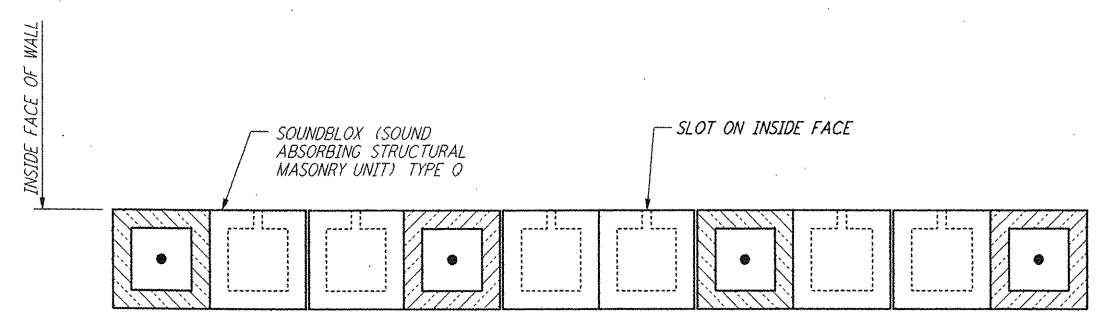

**TYPICAL SECTION OF SOUNDBLOX MASONRY WALL
DETAIL 1**
1/2" = 1'-0"

- NOTES:**
- FOR GENERAL NOTES, ABBREVIATIONS & SYMBOLS SEE DRAWING WA-S-001.
 - CONTRACTOR SHALL ADJUST LOCATION AND SIZE OF EQUIPMENT PADS TO SUIT VENDOR EQUIPMENTS.

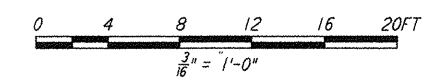

LIGO-D960323-01-O

NO.	DATE	BY	CHKD	ENGR	PROJ	DESCRIPTION
1	6-15-98	CKT	HP	HP	DP	ISSUED FOR AS-BUILT

ISSUED FOR CONSTRUCTION			
DRAWN	MCS	6-24-96	
CHECKED	DDM	7-2-96	
ENGINEER	BP	6-28-96	
PROJ	MDW	7-9-96	

AS-BUILT DRAWINGS

PARSONS
100 WEST WALNUT STREET
PASADENA, CALIFORNIA

LIGO
CALIFORNIA INSTITUTE OF TECHNOLOGY
MASSACHUSETTS INSTITUTE OF TECHNOLOGY

LASER INTERFEROMETER
GRAVITATIONAL-WAVE OBSERVATORY
SITE NO. 1 - HANFORD, WASHINGTON

TITLE: **STRUCTURAL CORNER STATION AIR HANDLING UNIT ENCLOSURE PLAN**

SCALE: AS NOTED
CONTRACT NUMBER: PPI150969
PROJECT NUMBER: 8094
SHEET NUMBER: **WA-S-502**

not be reproduced, copied, loaned, exhibited, or used in any other way, except by written consent from PARSONS to the borrower.

This document and the design it covers are the property of PARSONS. They are loaned only with the borrower's expressed written agreement that they will