



This document and the design it covers are the property of PARSONS. They are loaned only with the borrower's expressed written agreement that they will not be reproduced, copied, loaned, exhibited, or used in any other way, except by written consent from PARSONS to the borrower.


This document and the design it covers are the property of PARSONS. They are loaned only with the borrower's expressed written agreement that they will not be reproduced, copied, loaned, exhibited, or used in any other way, except by written consent from PARSONS to the borrower.

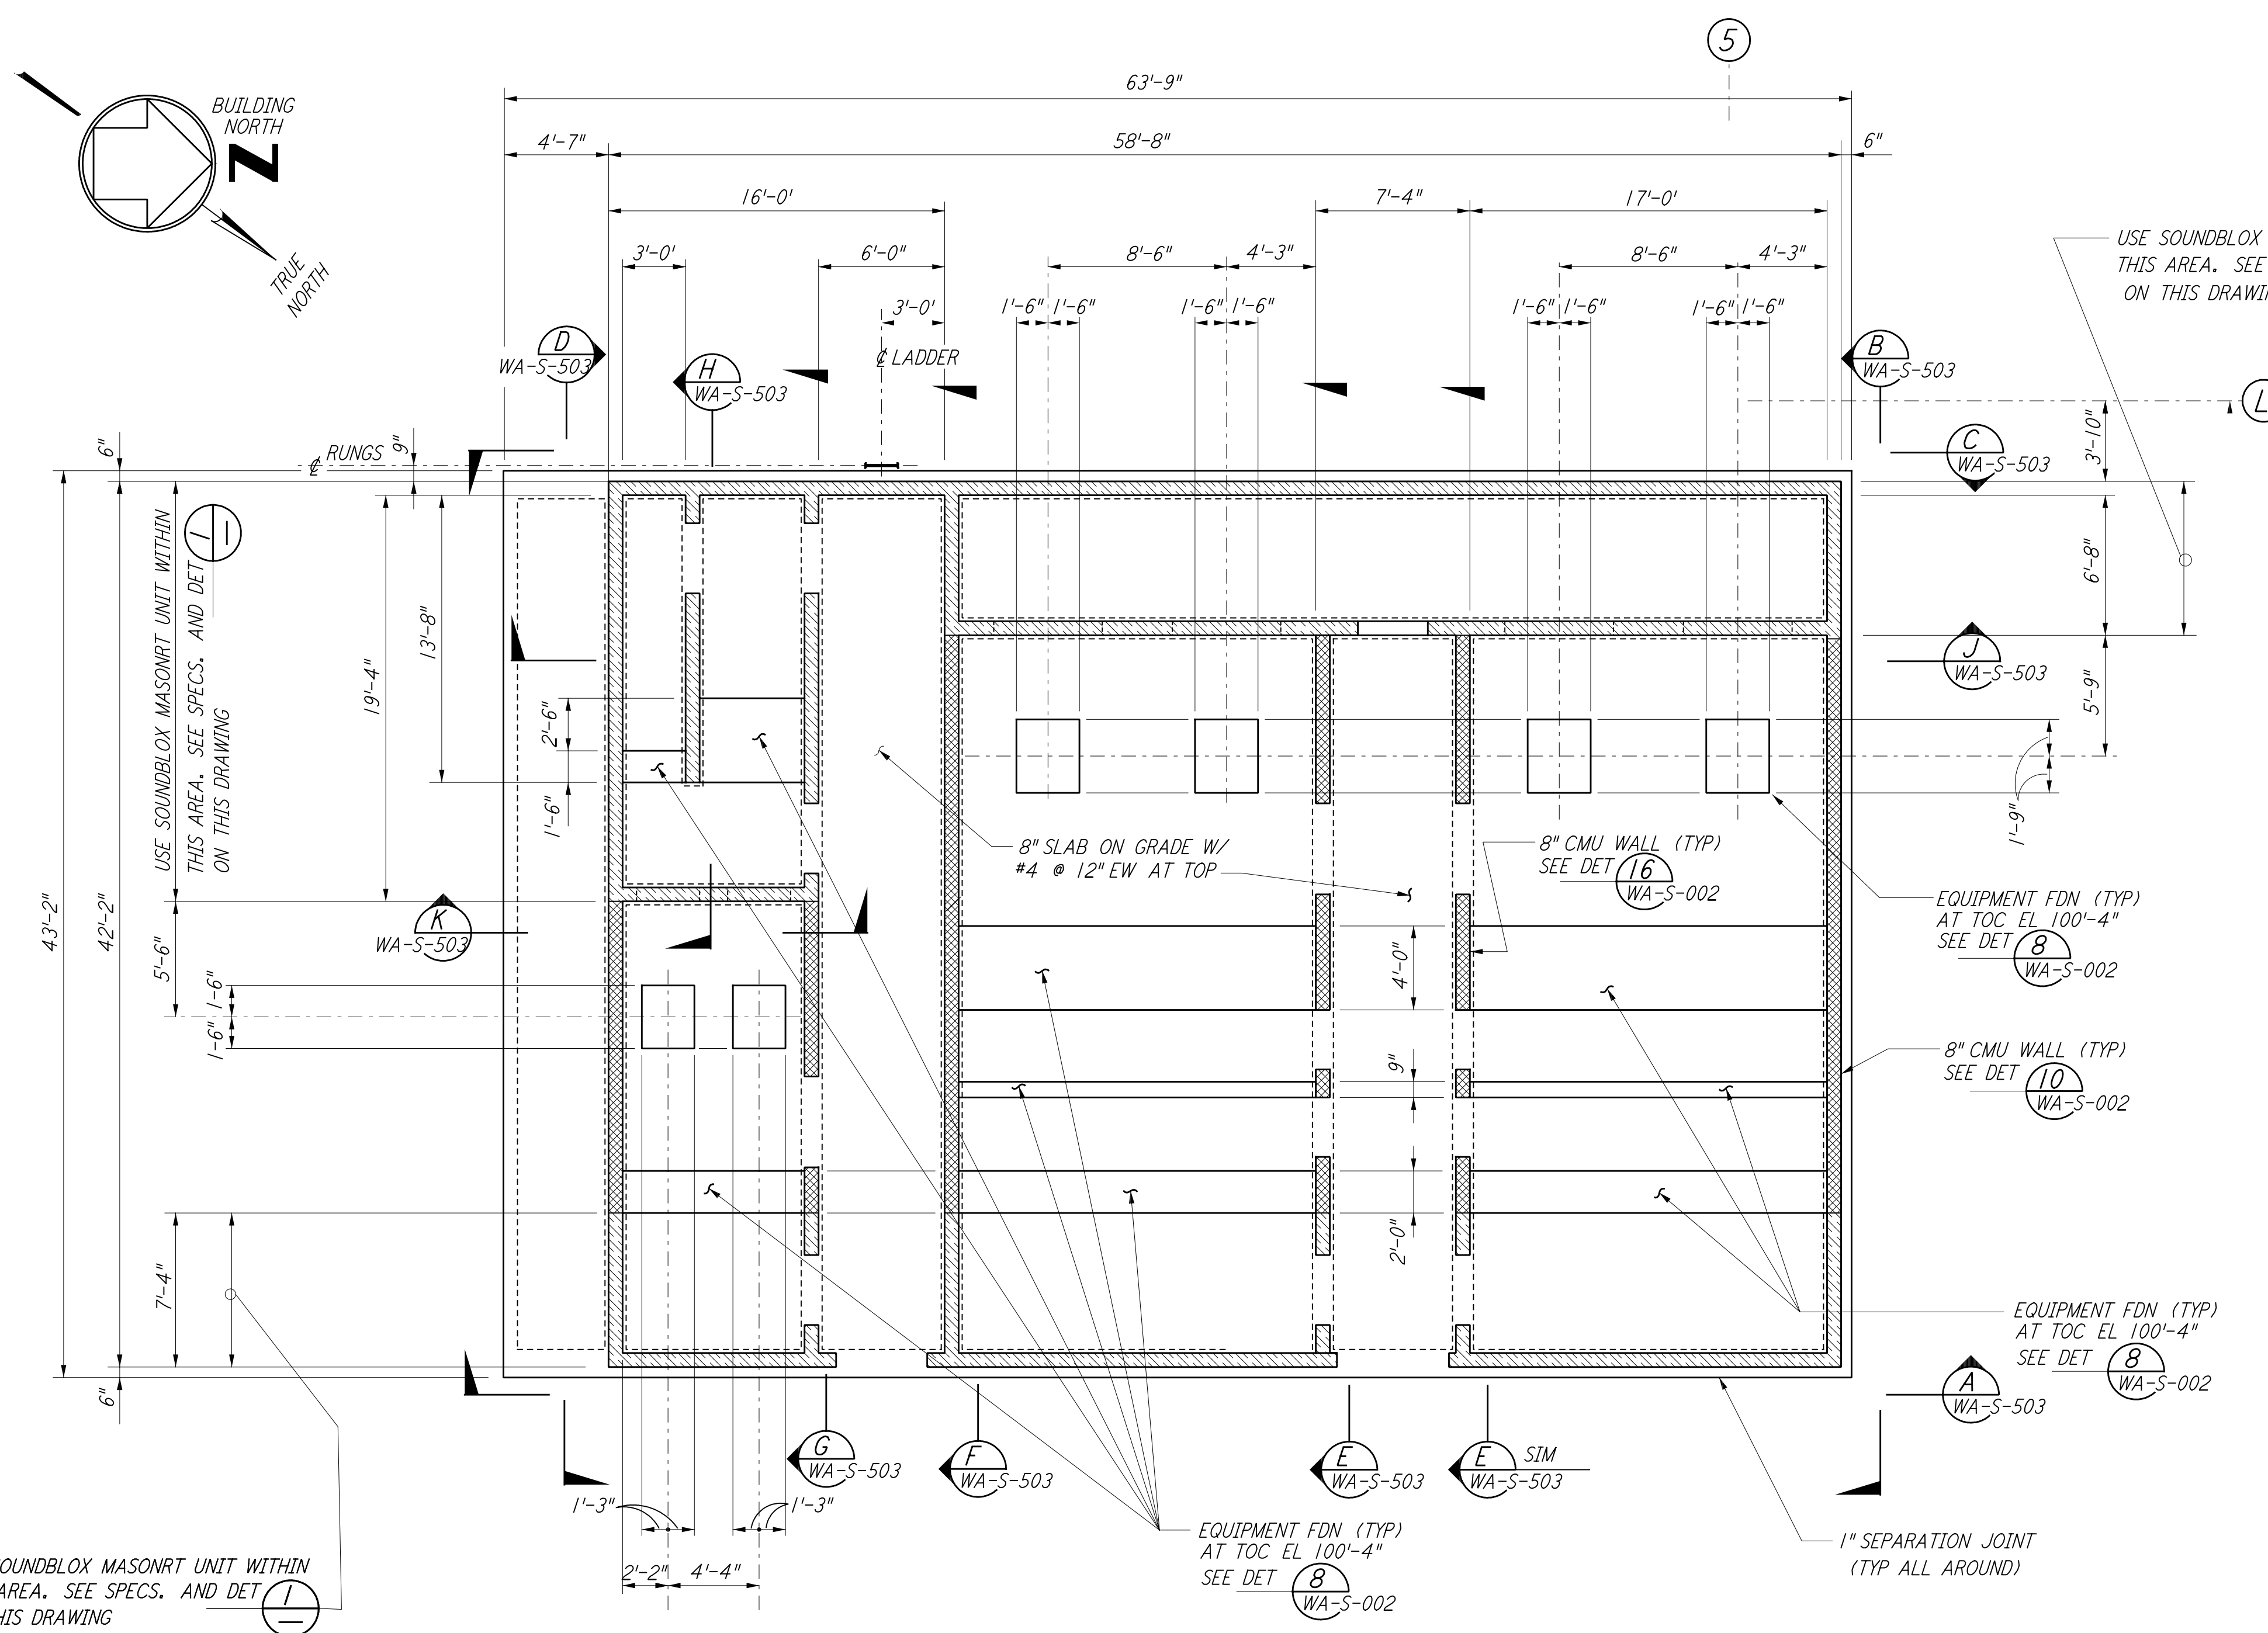


**AIR HANDLING UNIT STRUCTURE
 FOUNDATION PLAN**
 $\frac{3}{16}'' = 1'-0''$

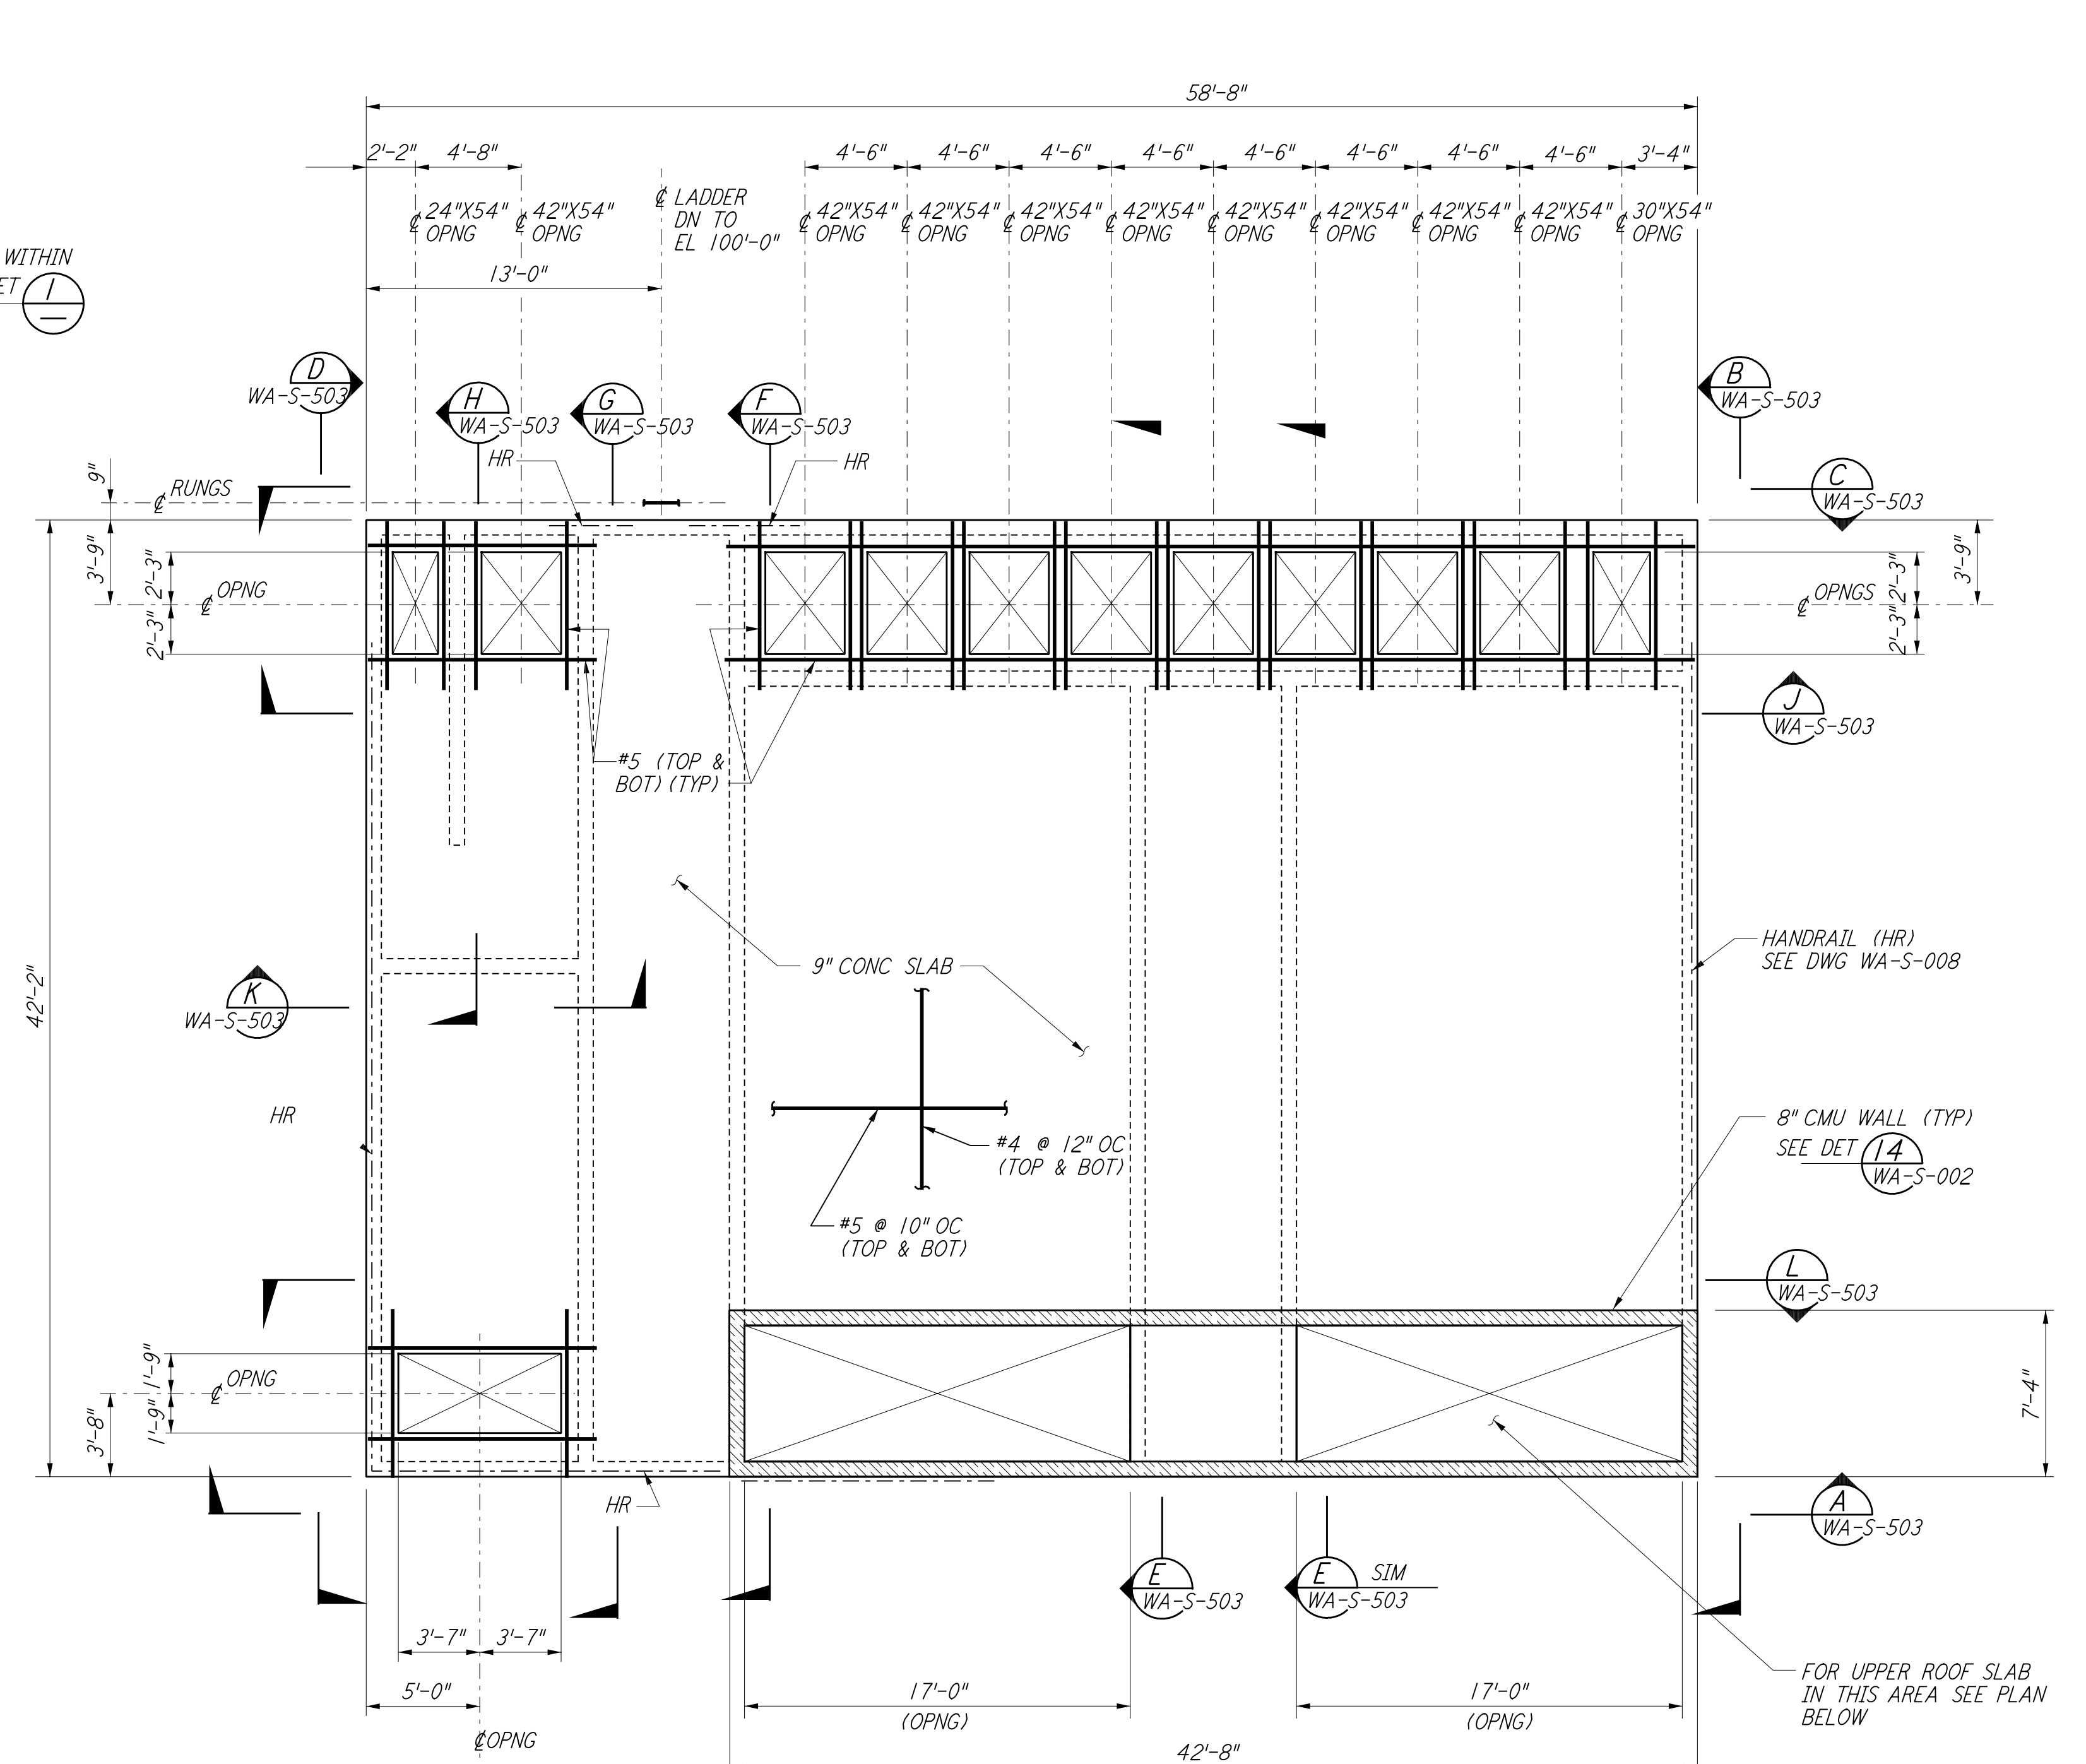

**AIR HANDLING UNIT STRUCTURE
 LOWER CONCRETE ROOF SLAB PLAN**
 $\frac{3}{16}'' = 1'-0''$
 TOC EL 110'-7"

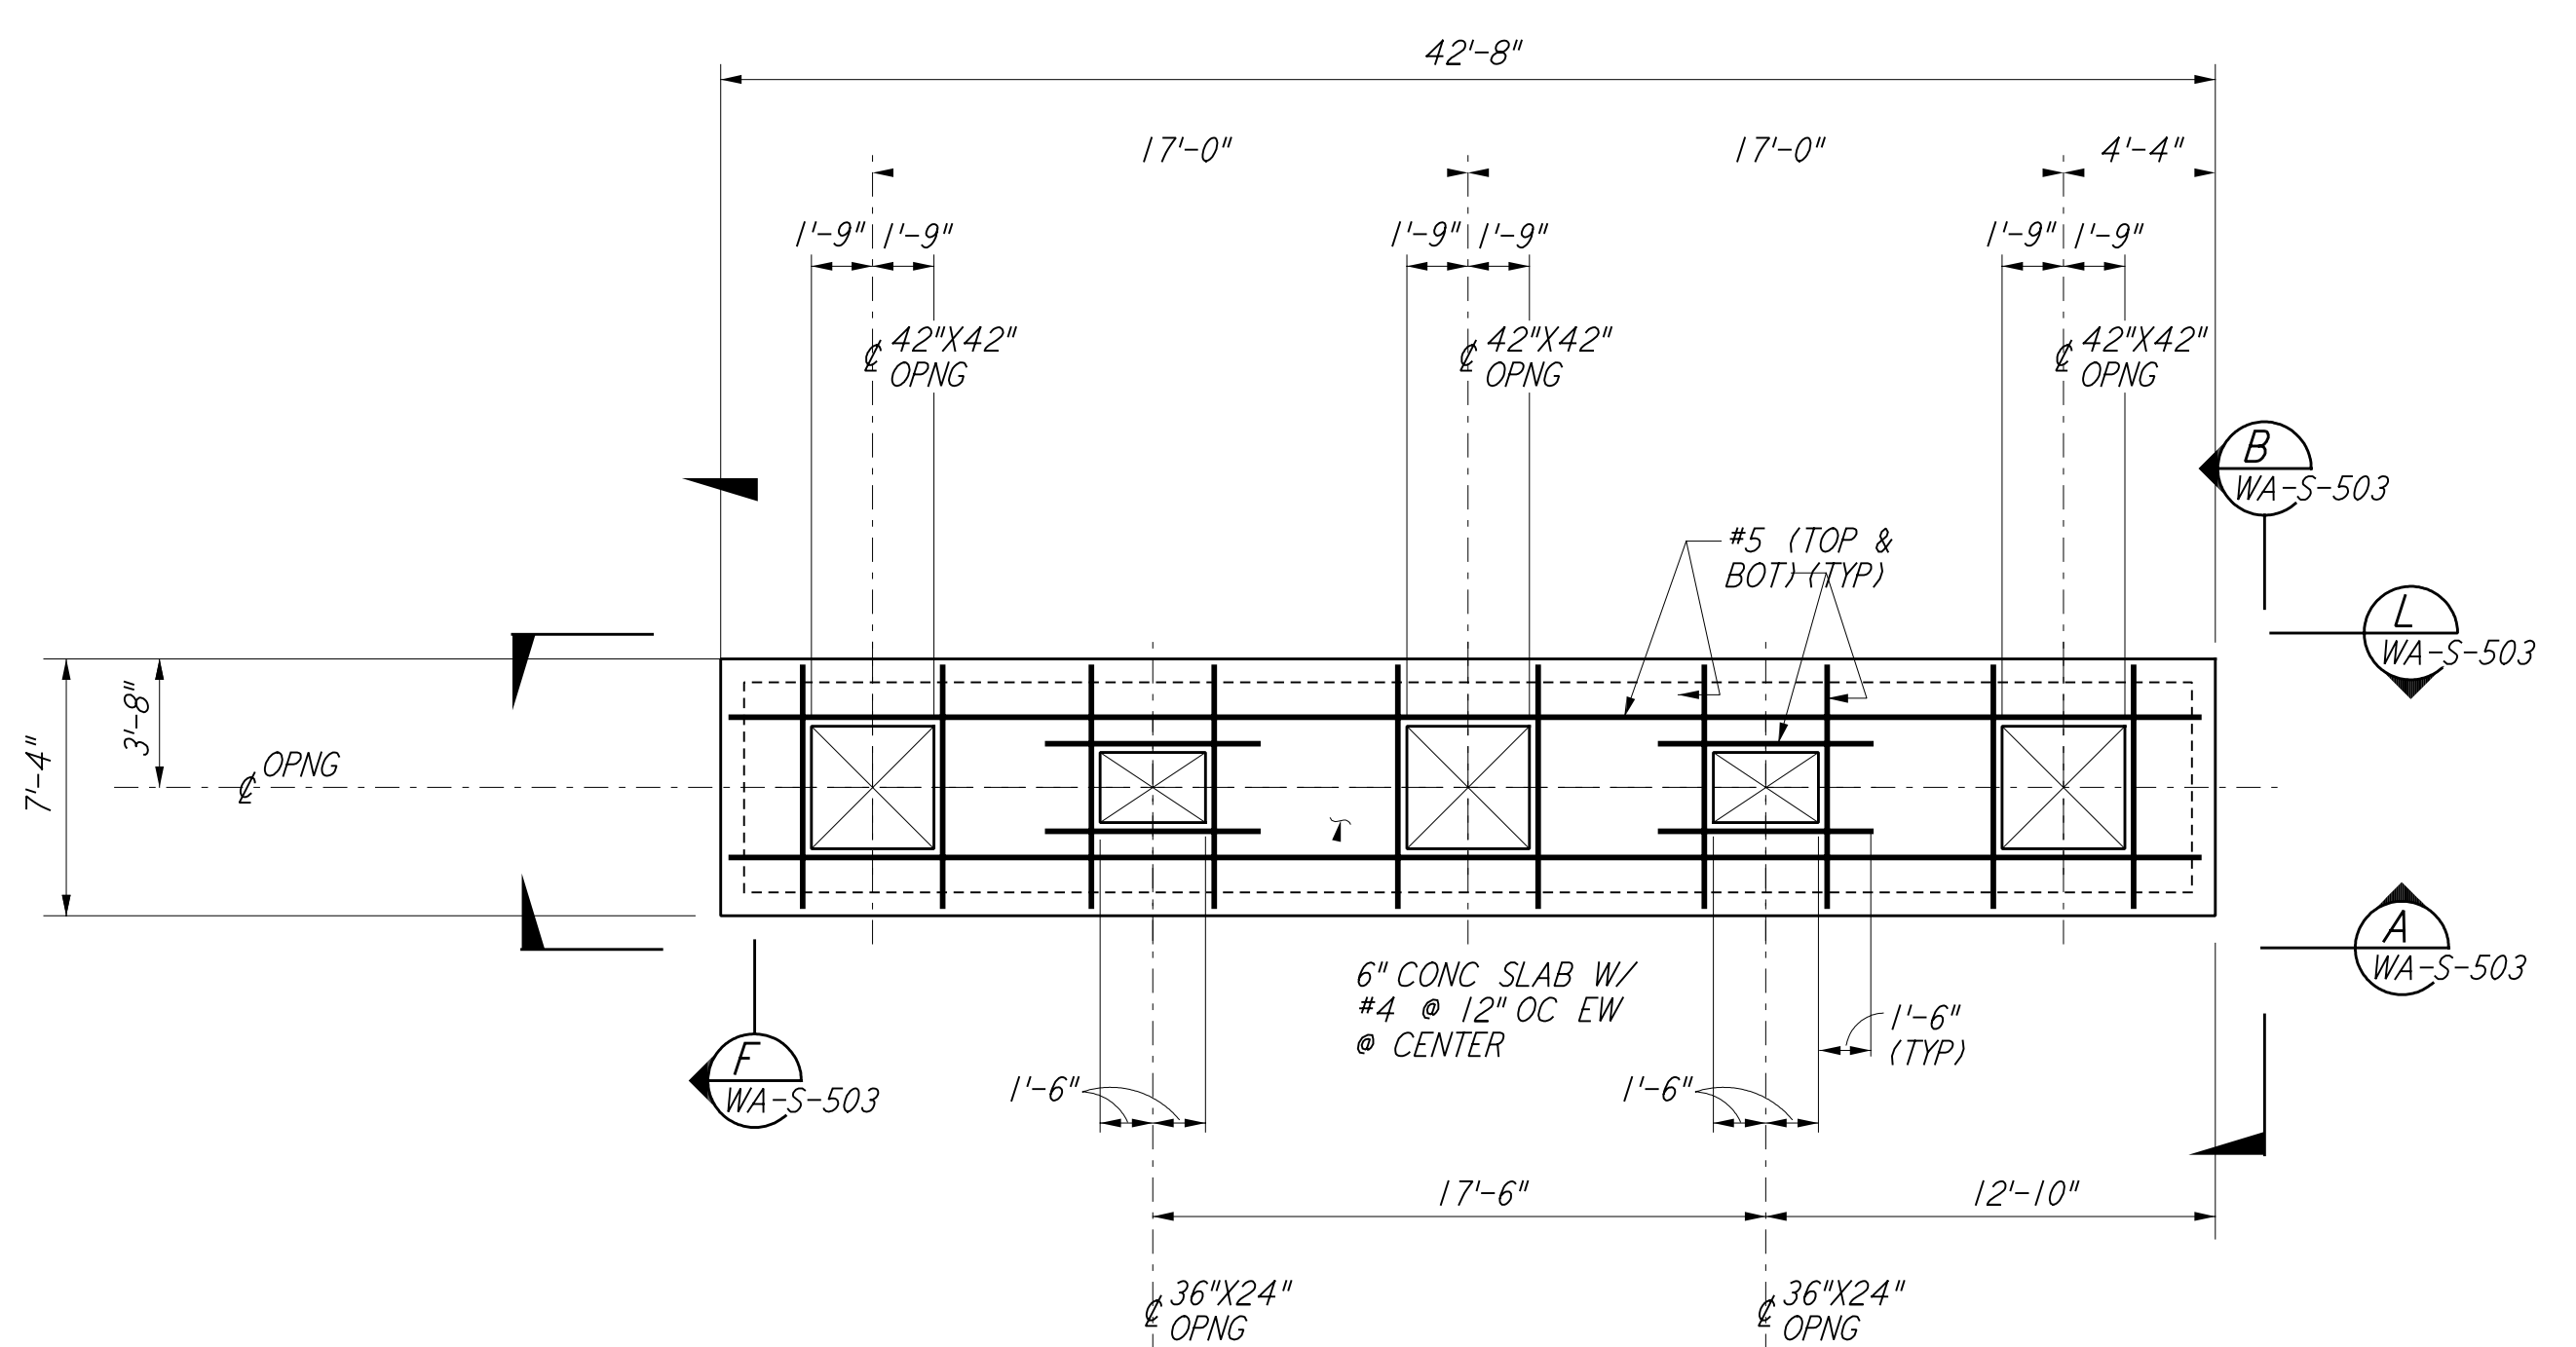


**AIR HANDLING UNIT STRUCTURE
 UPPER CONCRETE ROOF SLAB PLAN**
 $\frac{3}{16}'' = 1'-0''$
 TOC EL 115'-2"

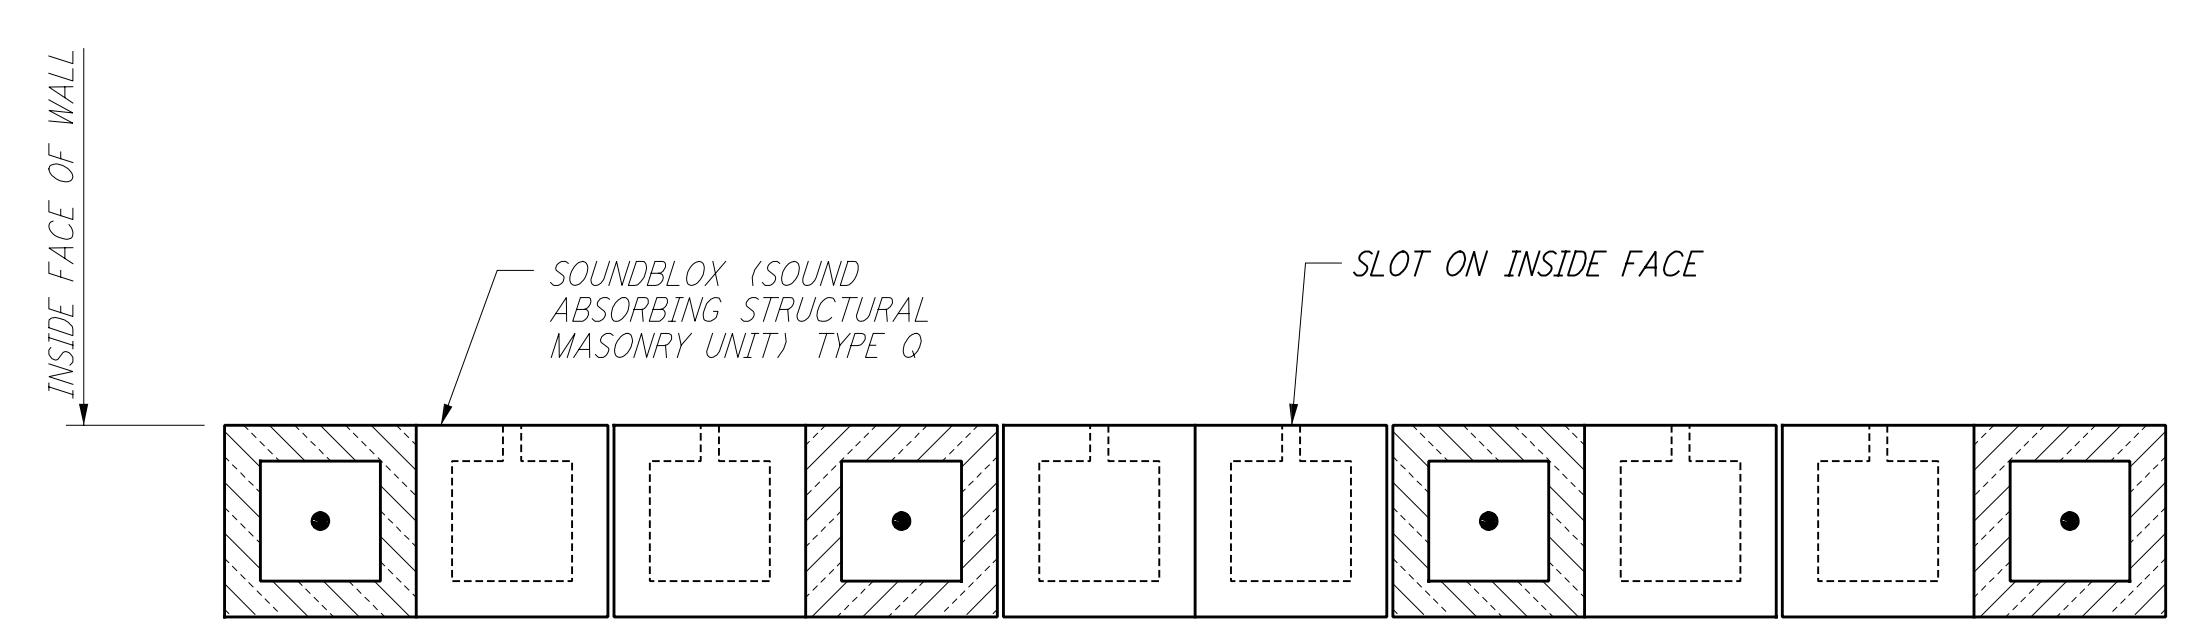

**TYPICAL SECTION OF SOUNDBLOX MASONRY WALL
 DETAIL 1**
 $\frac{1}{2}'' = 1'-0''$

- NOTES:**
- FOR GENERAL NOTES, ABBREVIATIONS & SYMBOLS SEE DRAWING WA-S-001.
 - CONTRACTOR SHALL ADJUST LOCATION AND SIZE OF EQUIPMENT PADS TO SUIT VENDOR EQUIPMENTS.

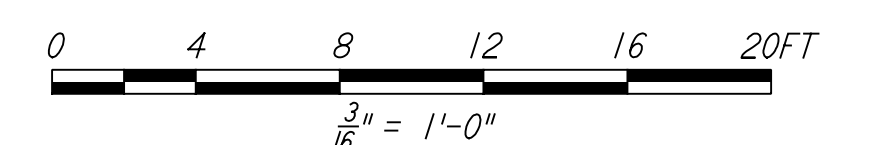

LIGO-D960323-01-0

NO.	DATE	BY	CHKD	ENGR	PROJ	DESCRIPTION
1	6-15-98	CKT				ISSUED FOR AS-BUILT

ISSUED FOR CONSTRUCTION
 DRAWN: MCS 6-24-96
 CHECKED: DDM 7-2-96
 ENGINEER: BP 6-28-96
 PROJ: MDW 7-9-96

AS-BUILT DRAWINGS



LASER INTERFEROMETER GRAVITATIONAL-WAVE OBSERVATORY
 SITE NO. 1 - HANFORD, WASHINGTON

STRUCTURAL CORNER STATION AIR HANDLING UNIT ENCLOSURE PLAN

SCALE: AS NOTED
 SHEET NUMBER: PP150969
 PROJECT NUMBER: 8094

WA-S-502