




This document and the design it covers are the property of PARSONS. They are loaned only with the borrower's expressed written agreement that they will not be reproduced, copied, loaned, exhibited, or used in any other way, except by written consent from PARSONS to the borrower.

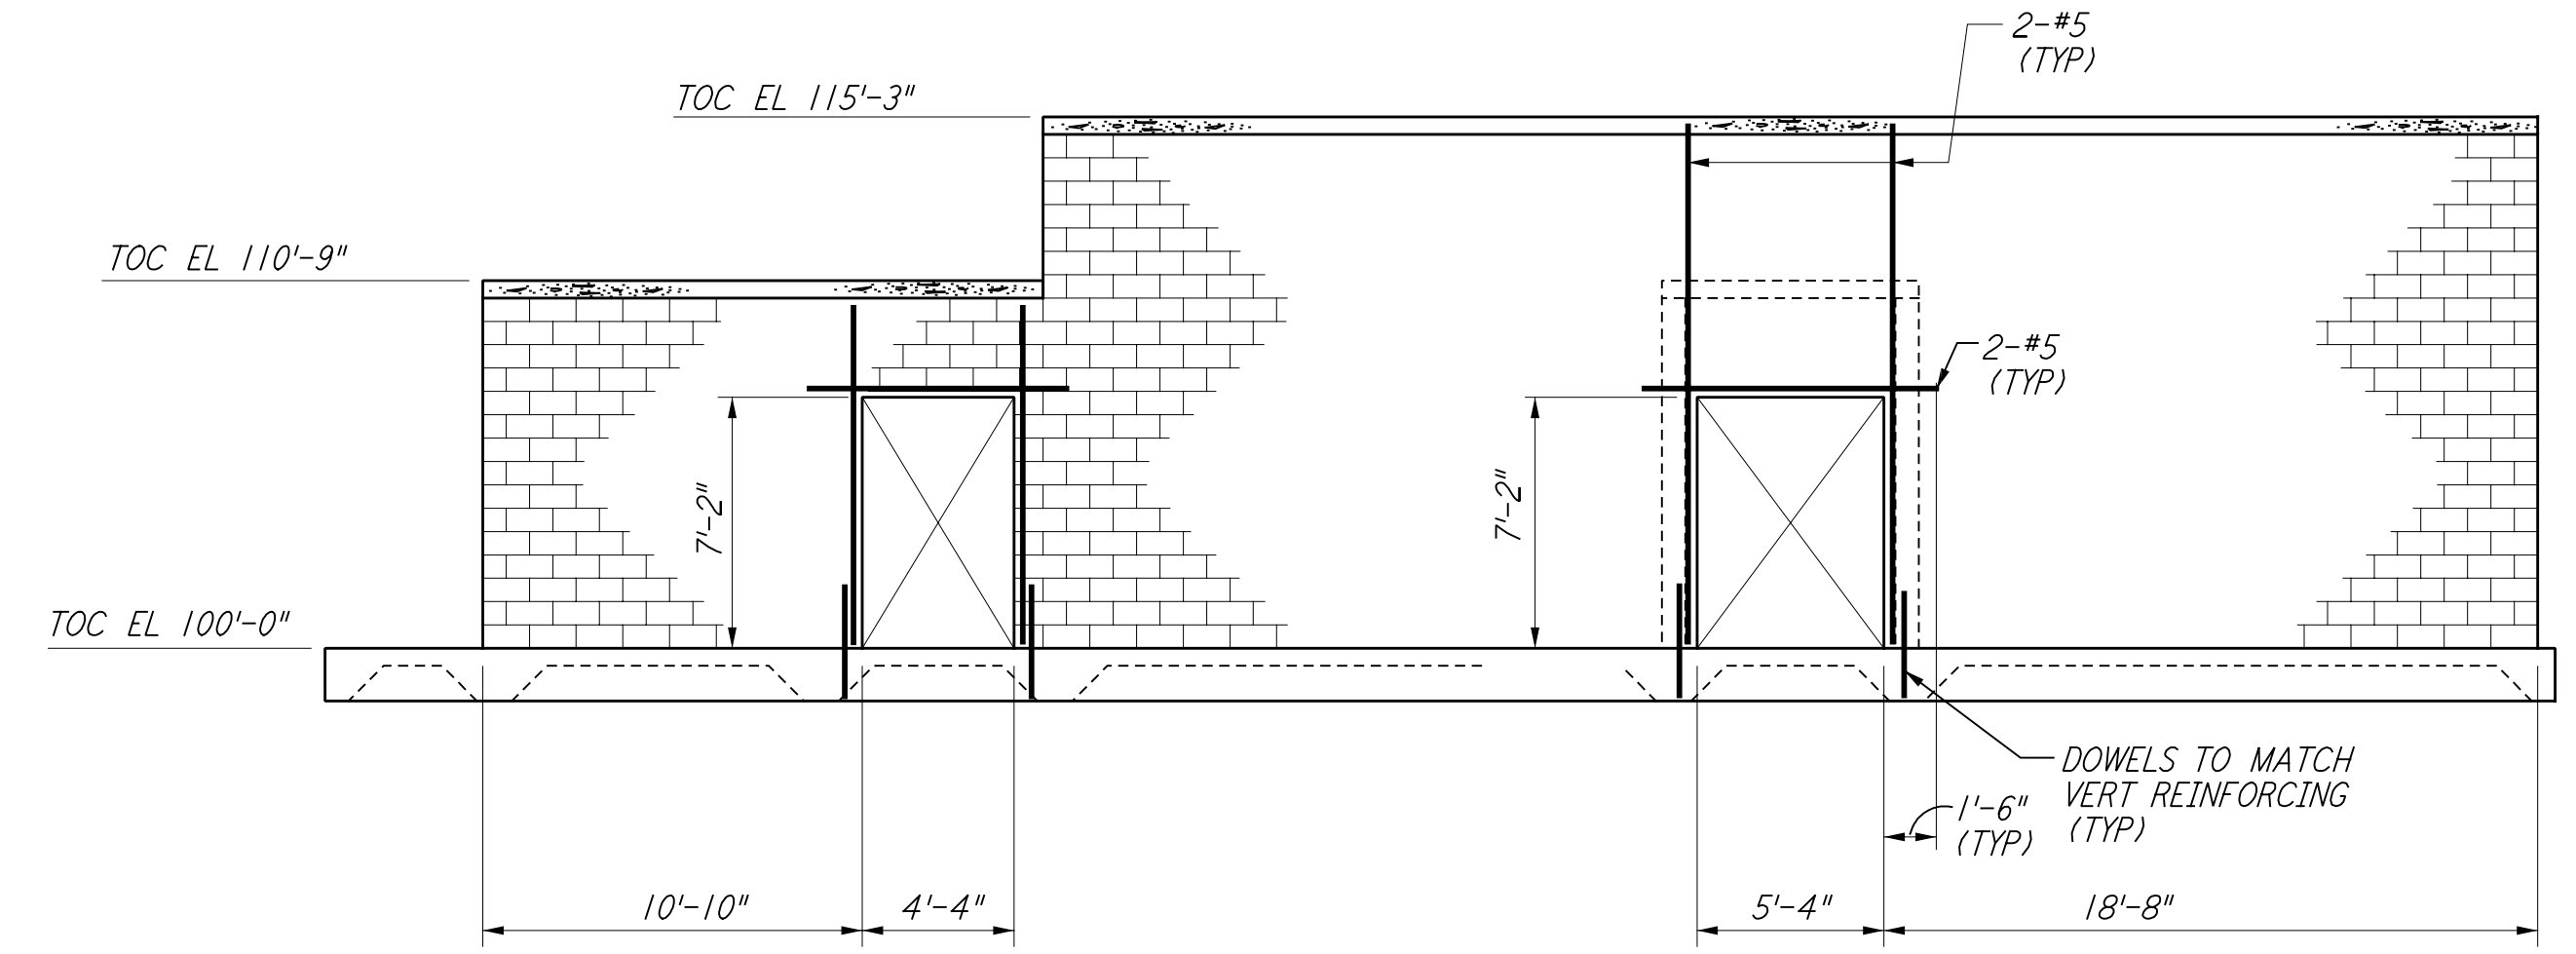


ELEVATION A REF
 $\frac{3}{16}'' = 1'-0''$
 WA-S-503 WA-S-502

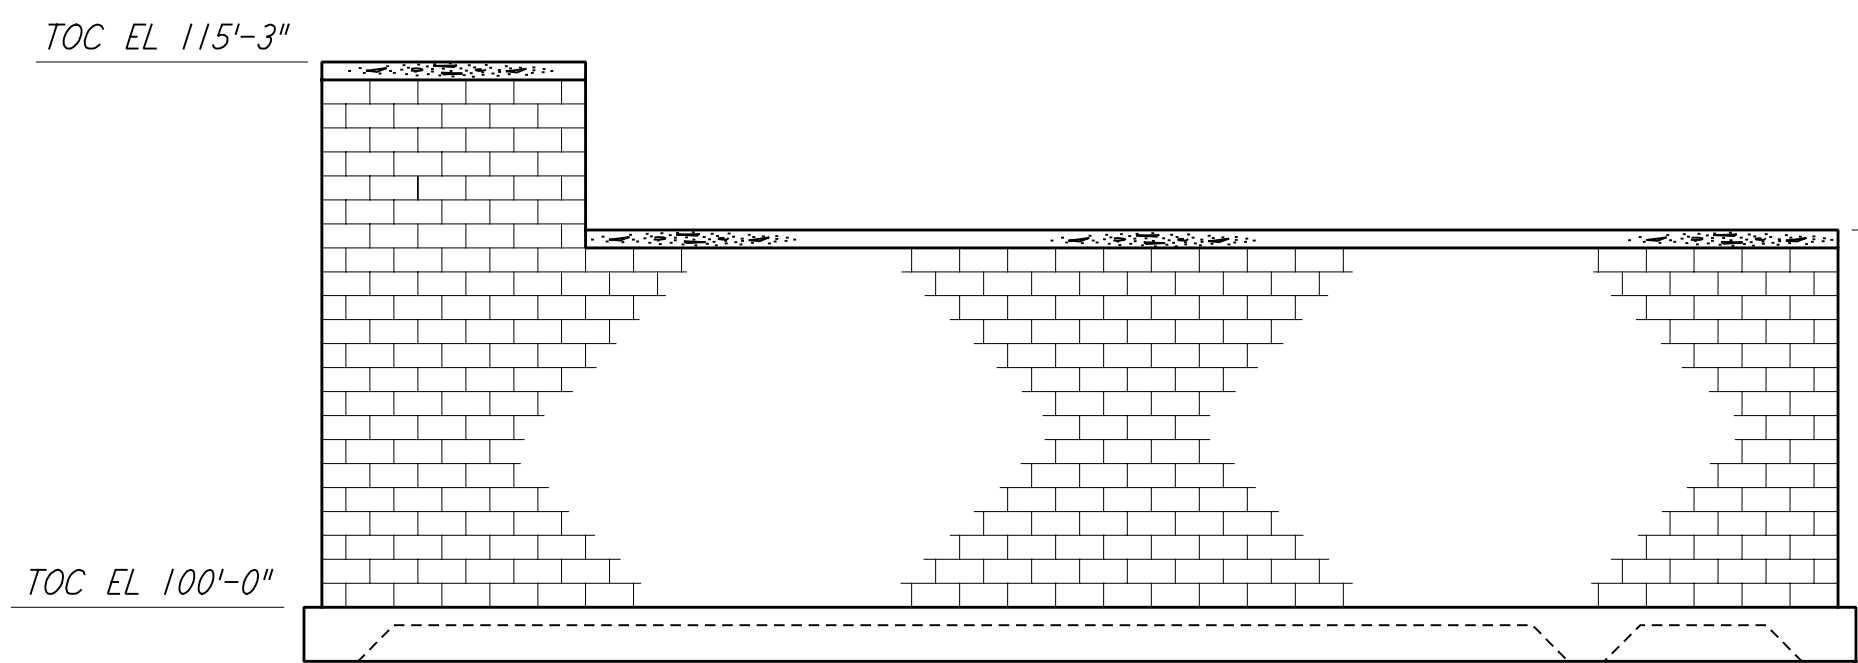


ELEVATION B REF
 $\frac{3}{16}'' = 1'-0''$
 WA-S-503 WA-S-502

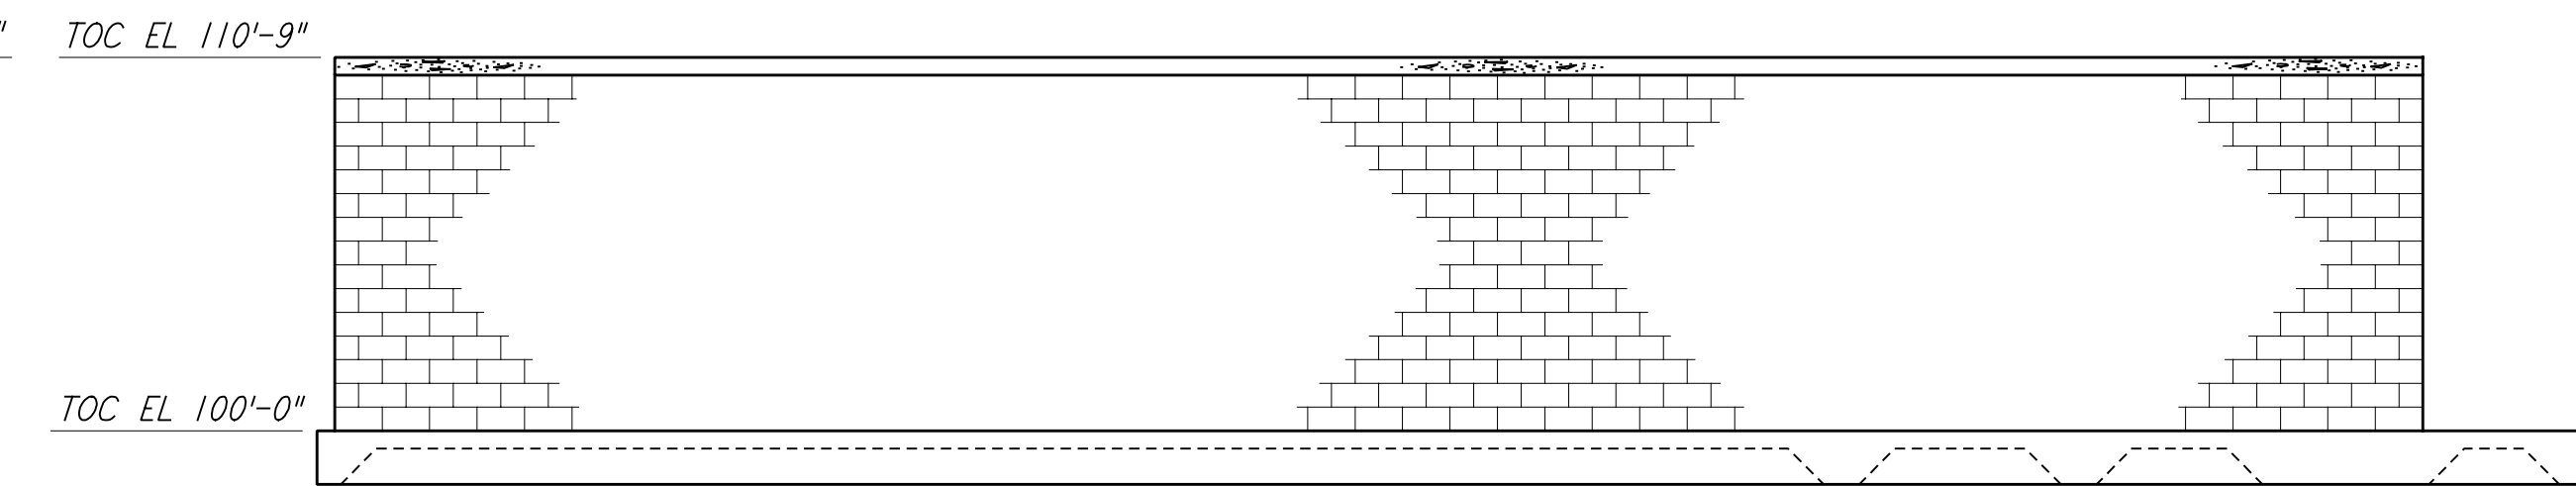


ELEVATION C REF
 $\frac{3}{16}'' = 1'-0''$
 WA-S-503 WA-S-502

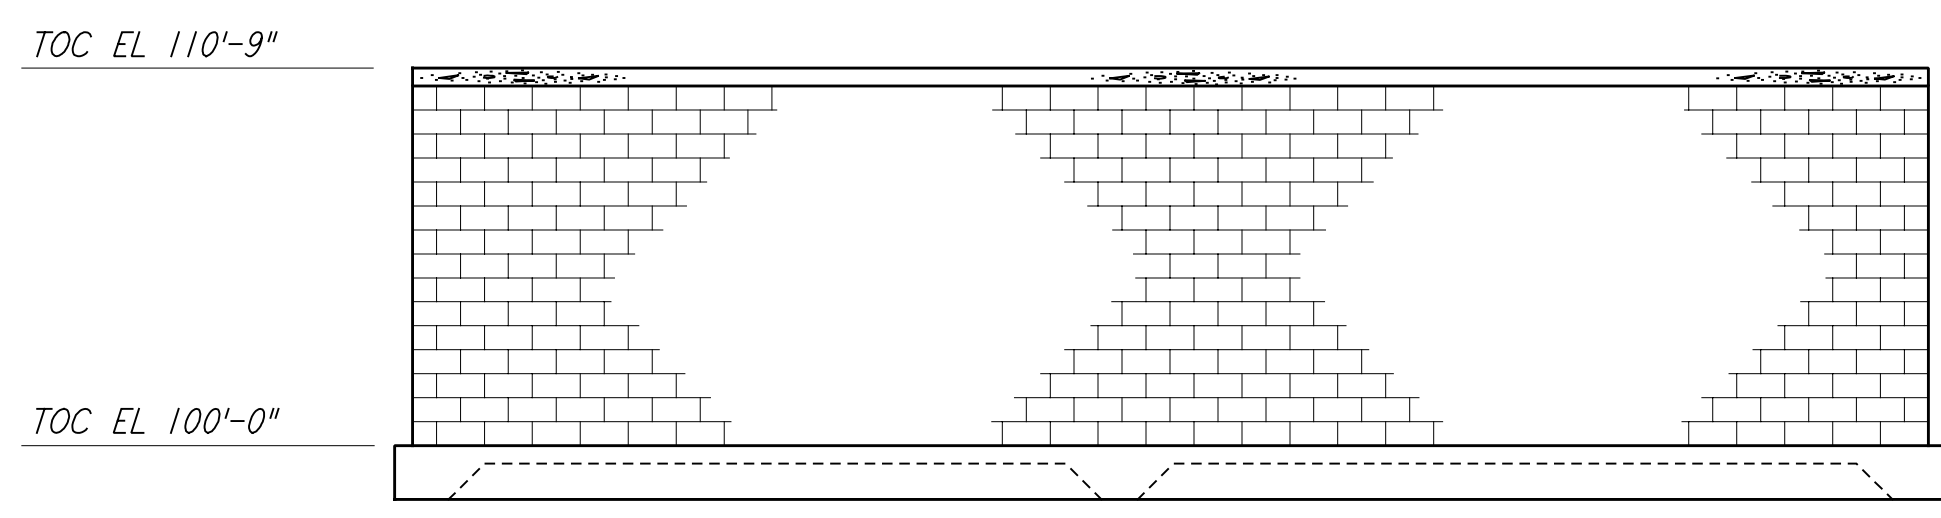


ELEVATION D REF
 $\frac{3}{16}'' = 1'-0''$
 WA-S-503 WA-S-502

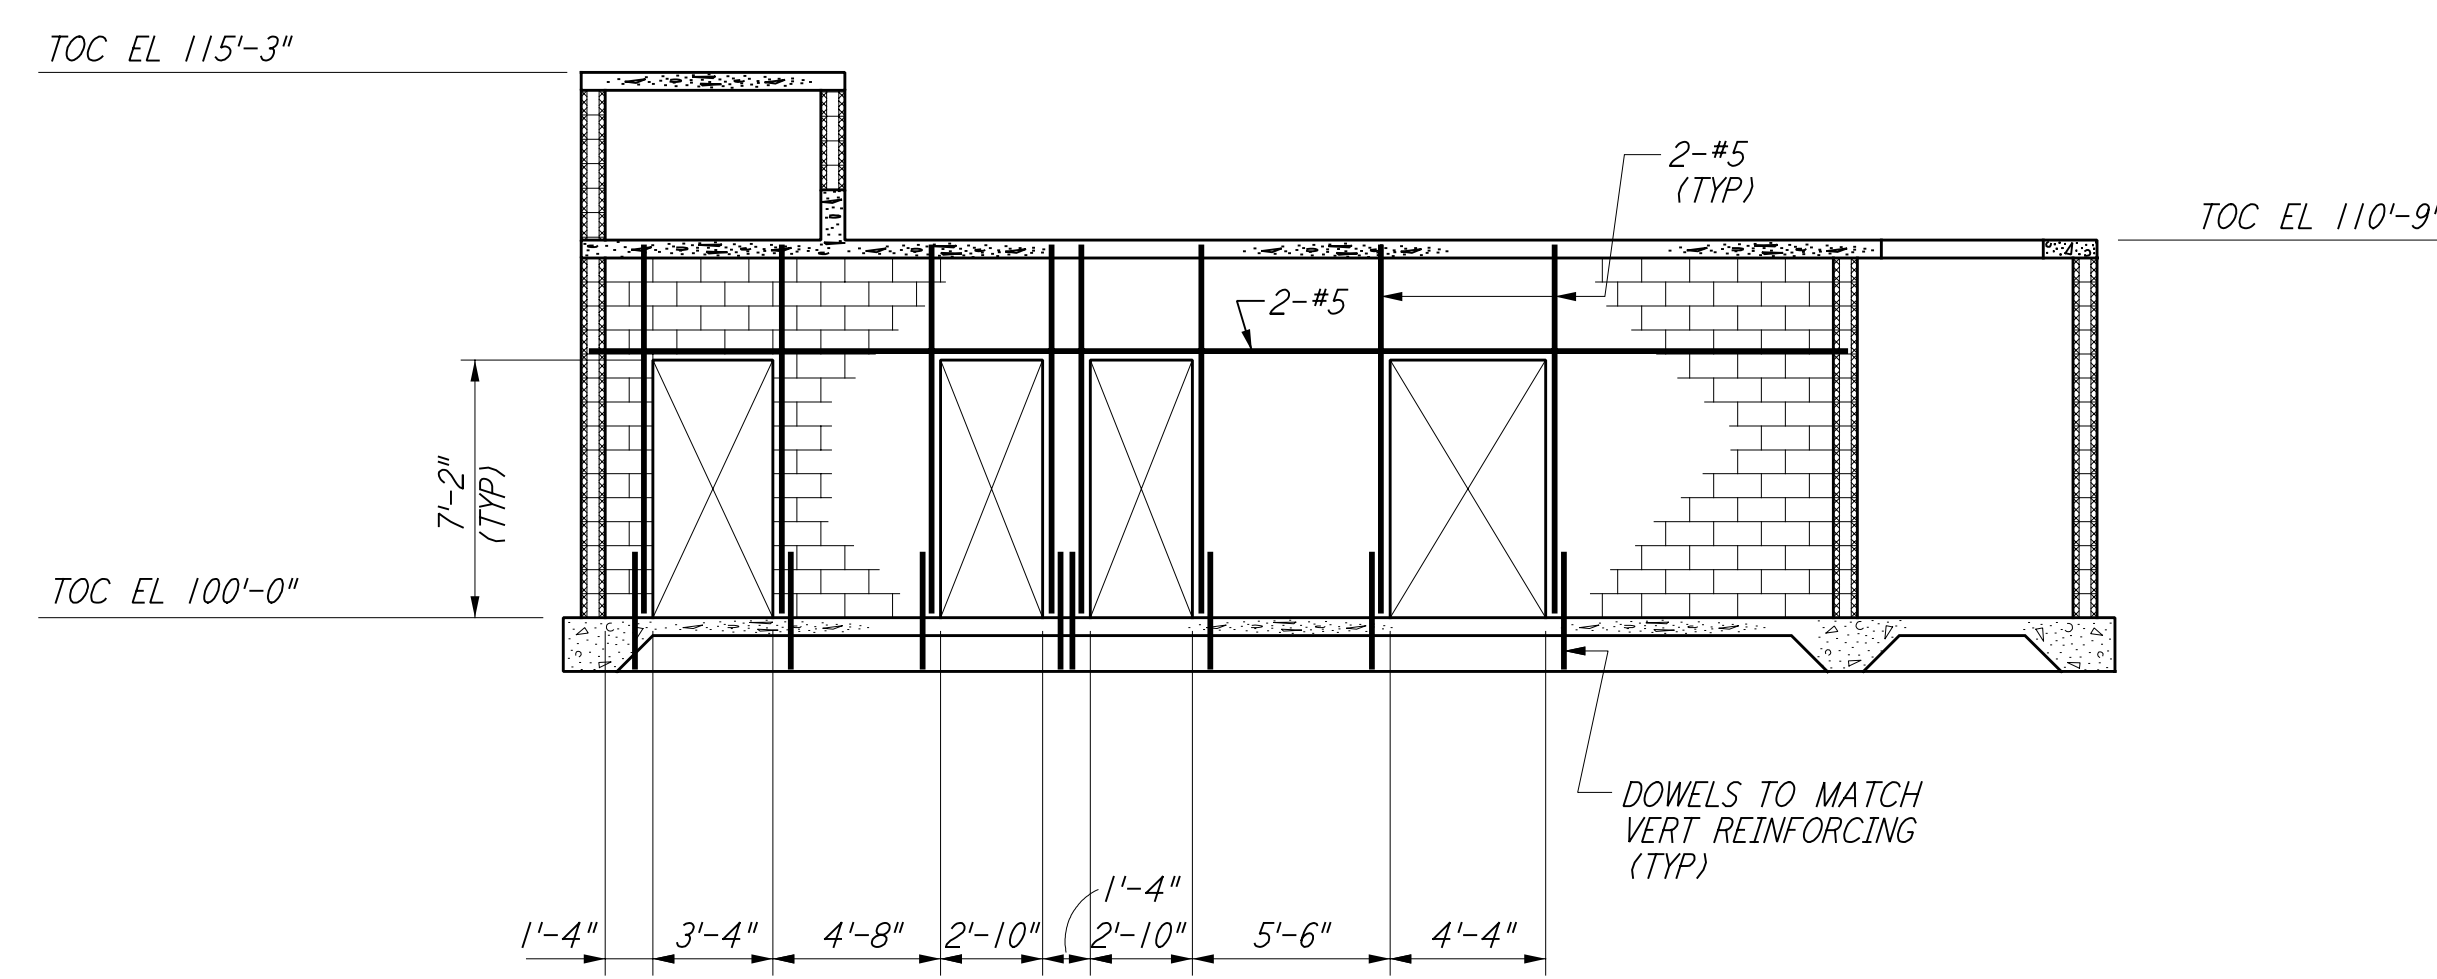


SECTION E REF
 $\frac{3}{16}'' = 1'-0''$
 WA-S-503 WA-S-502

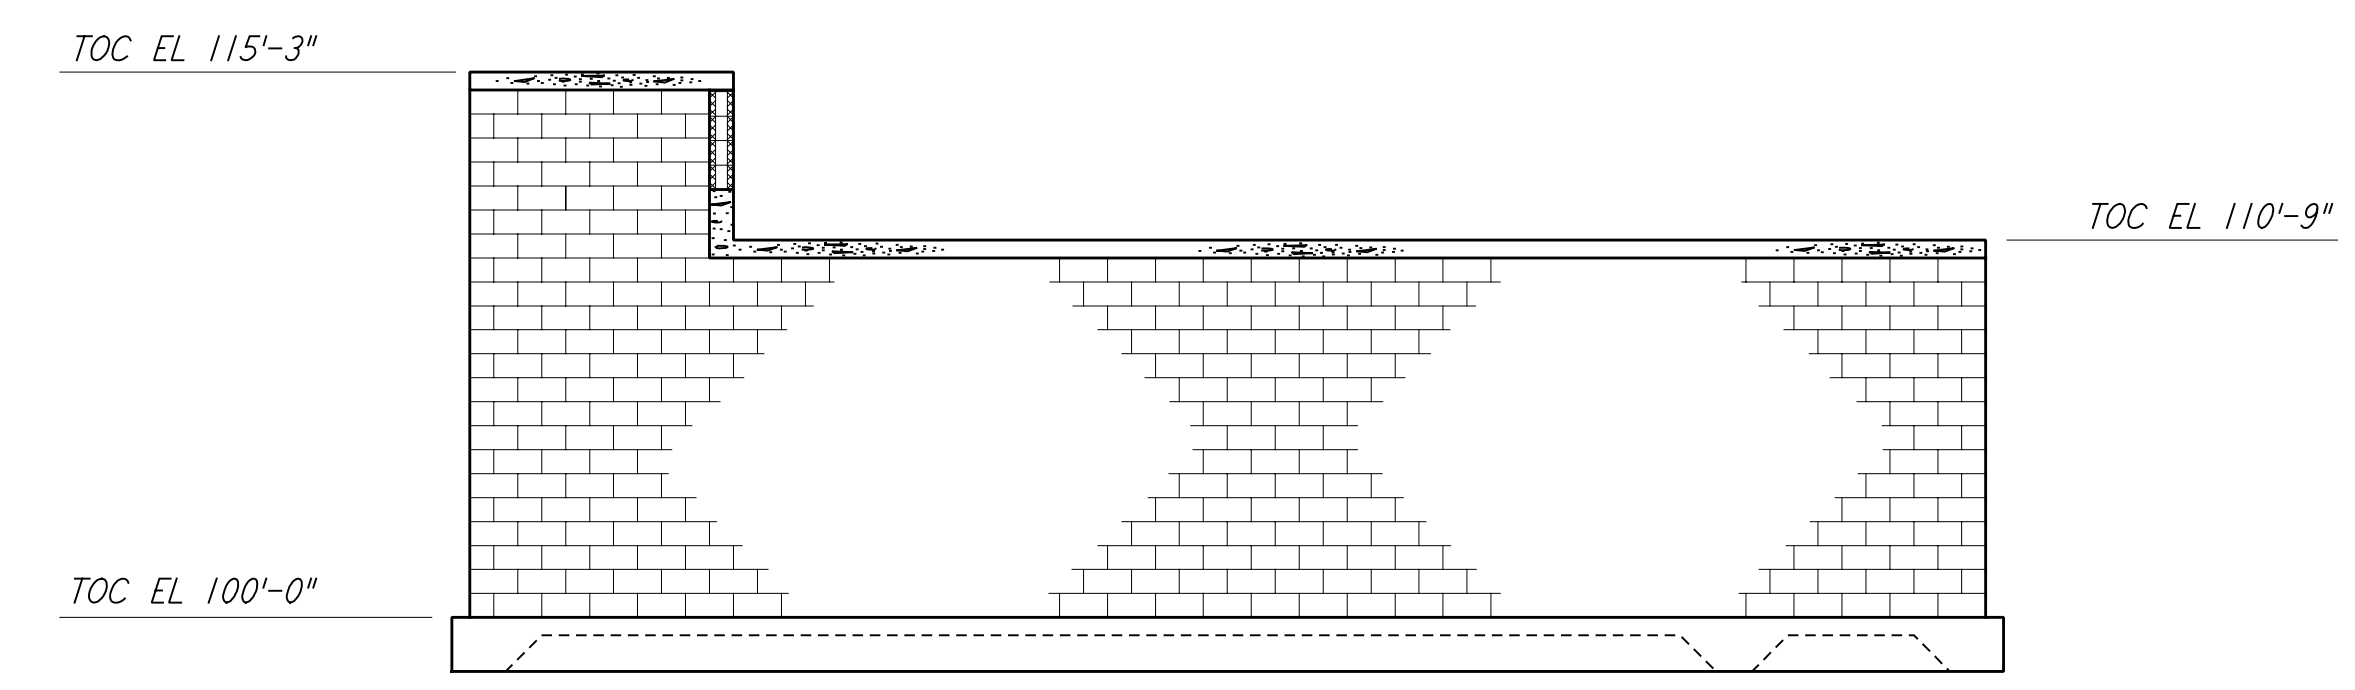


SECTION F REF
 $\frac{3}{16}'' = 1'-0''$
 WA-S-503 WA-S-502

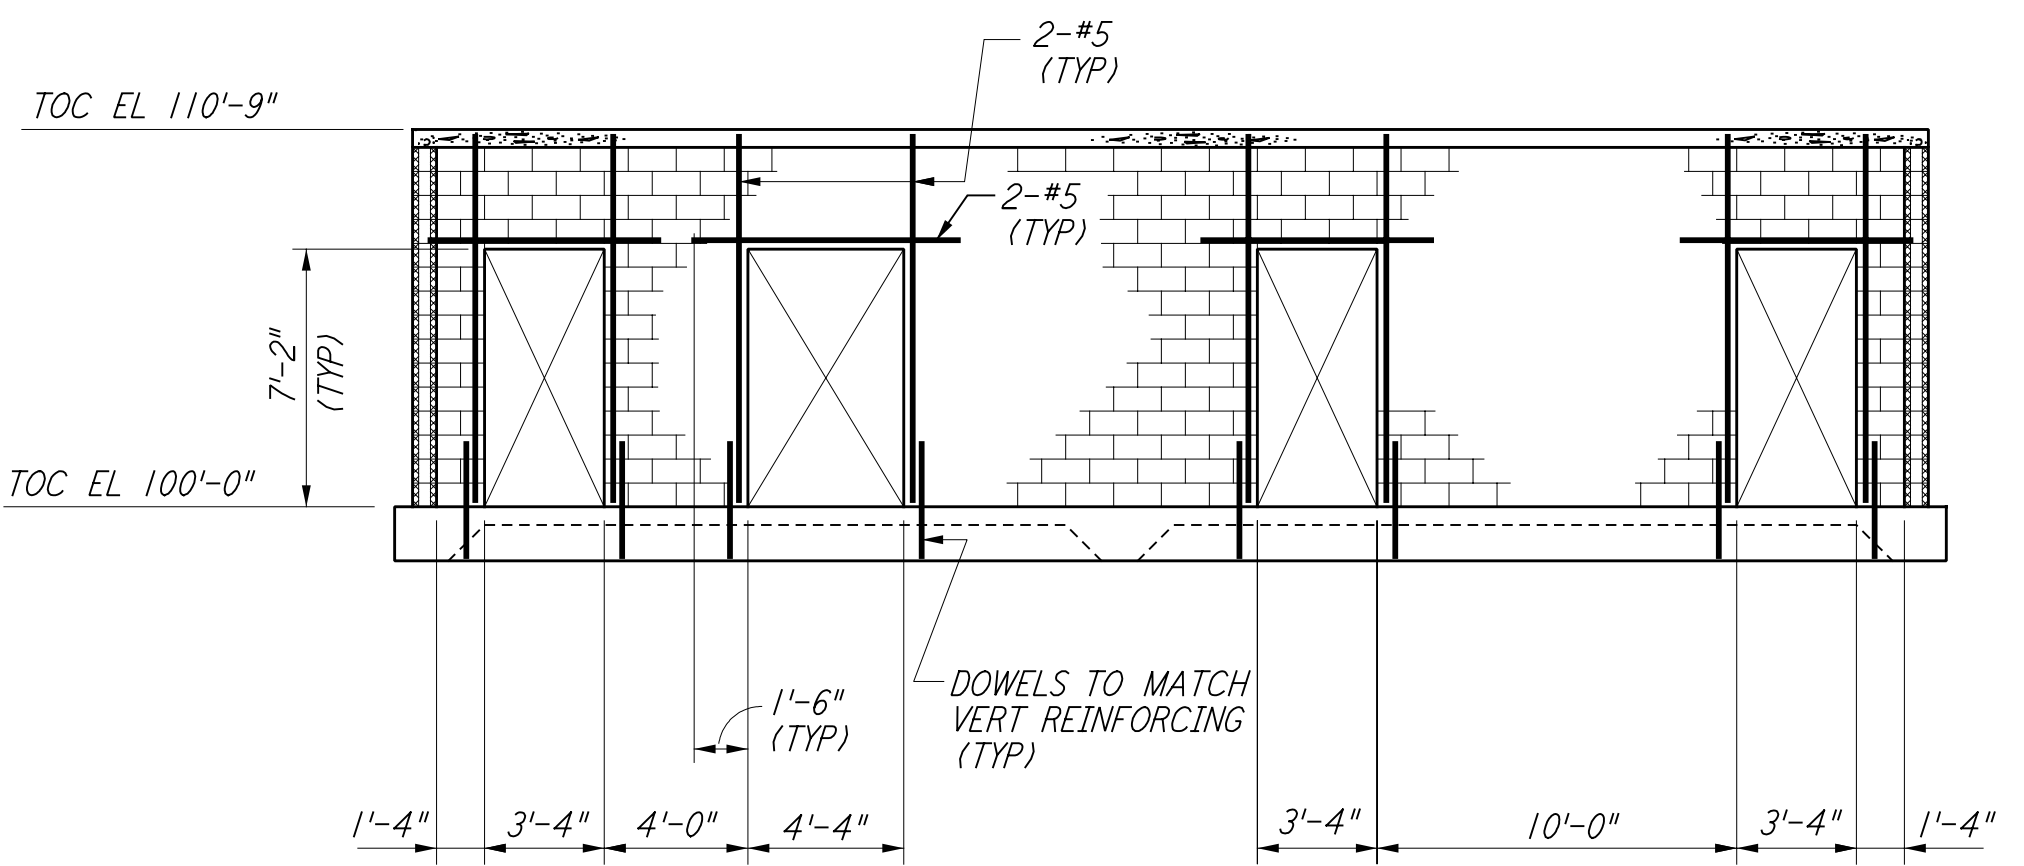


SECTION G REF
 $\frac{3}{16}'' = 1'-0''$
 WA-S-503 WA-S-502

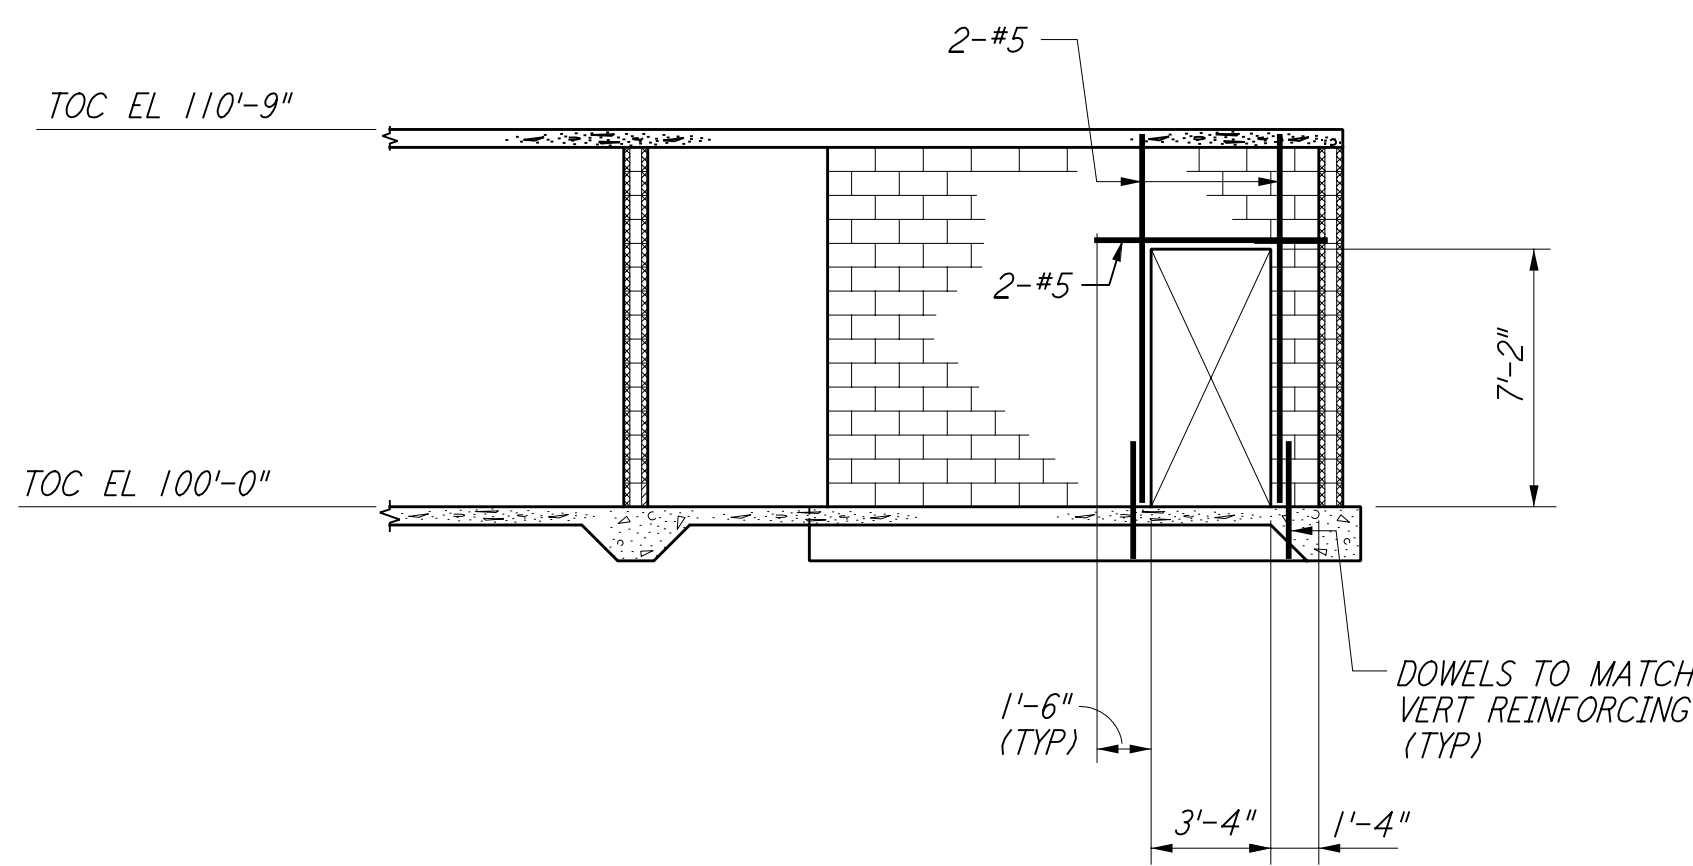


SECTION H REF
 $\frac{3}{16}'' = 1'-0''$
 WA-S-503 WA-S-502

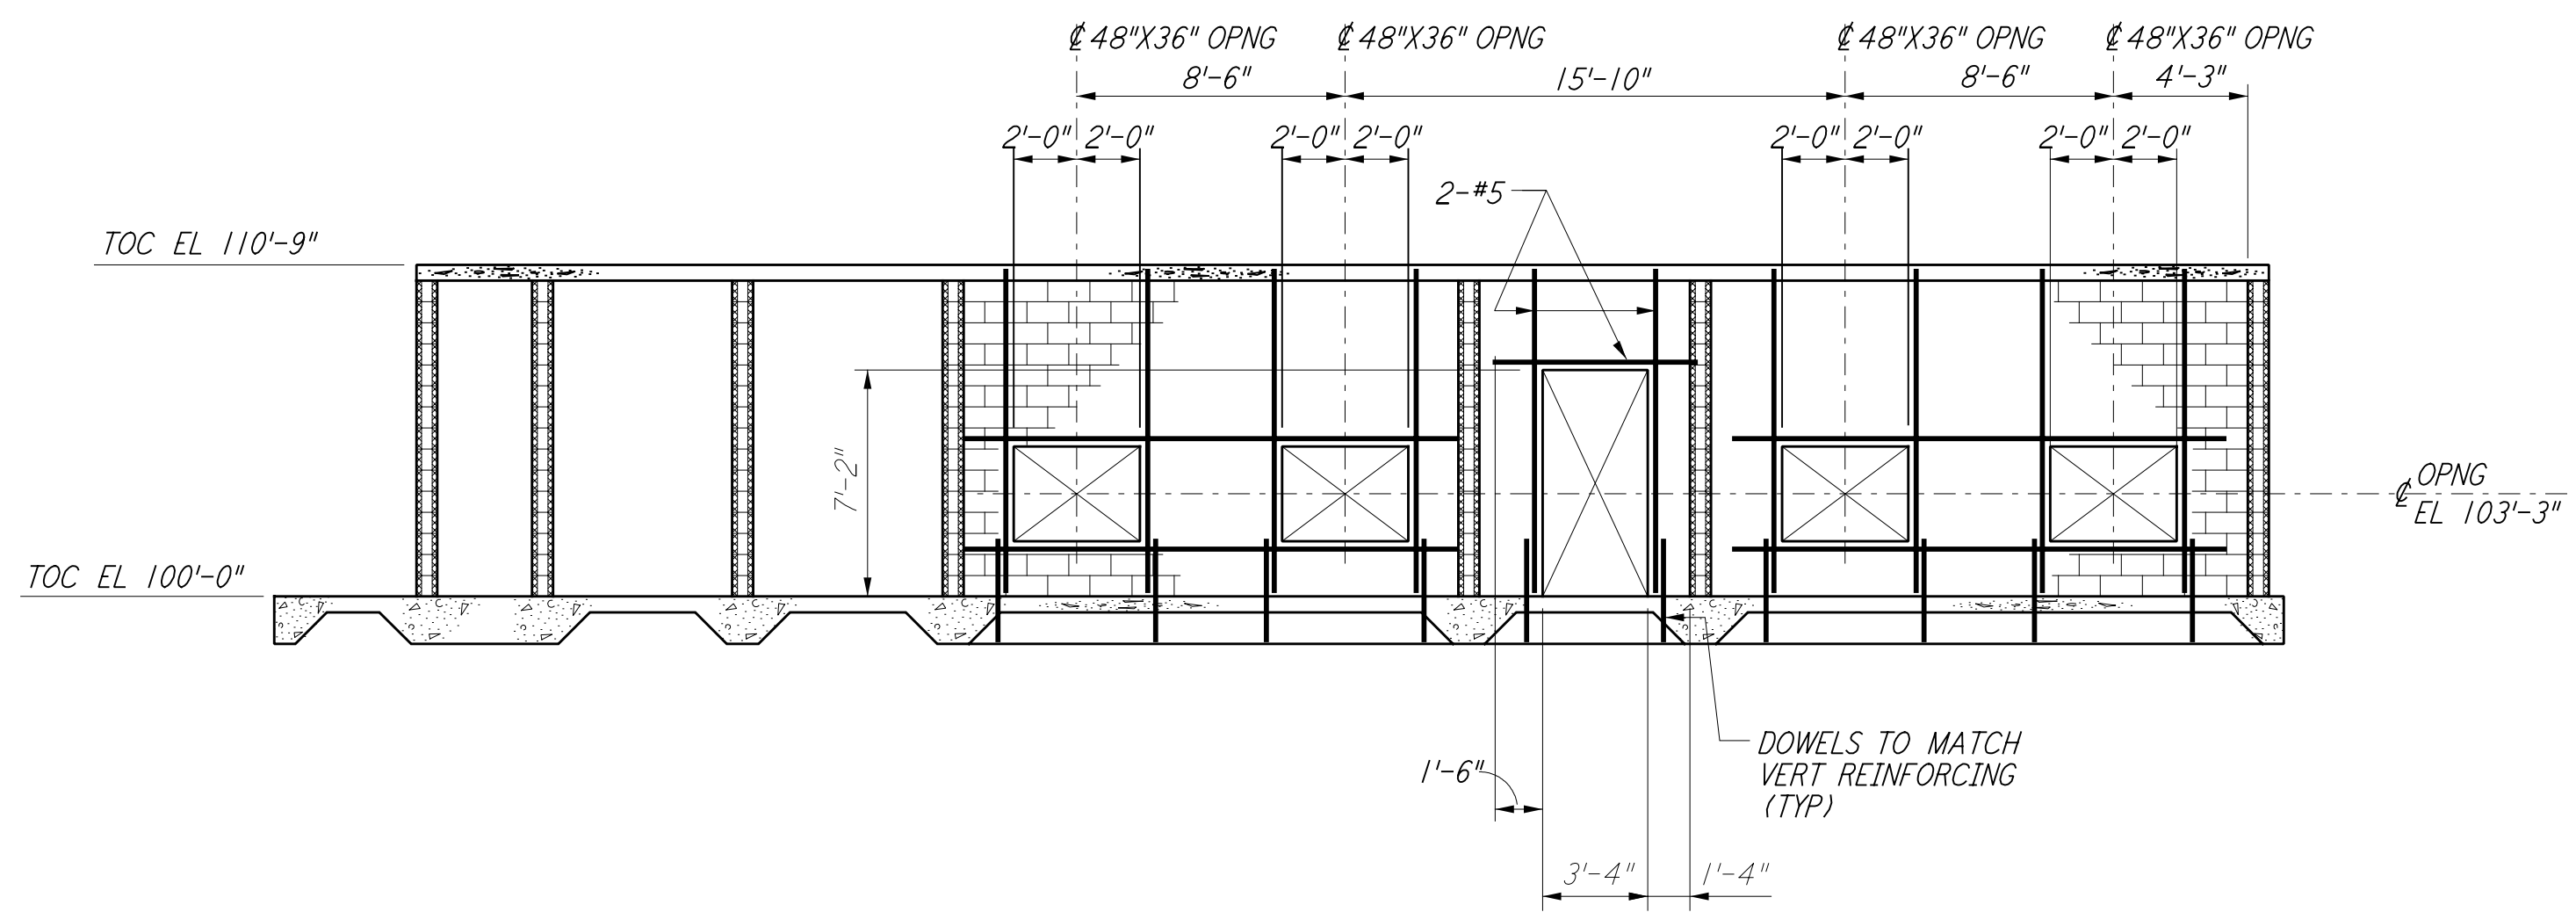

SECTION J REF
 $\frac{3}{16}'' = 1'-0''$
 WA-S-503 WA-S-502

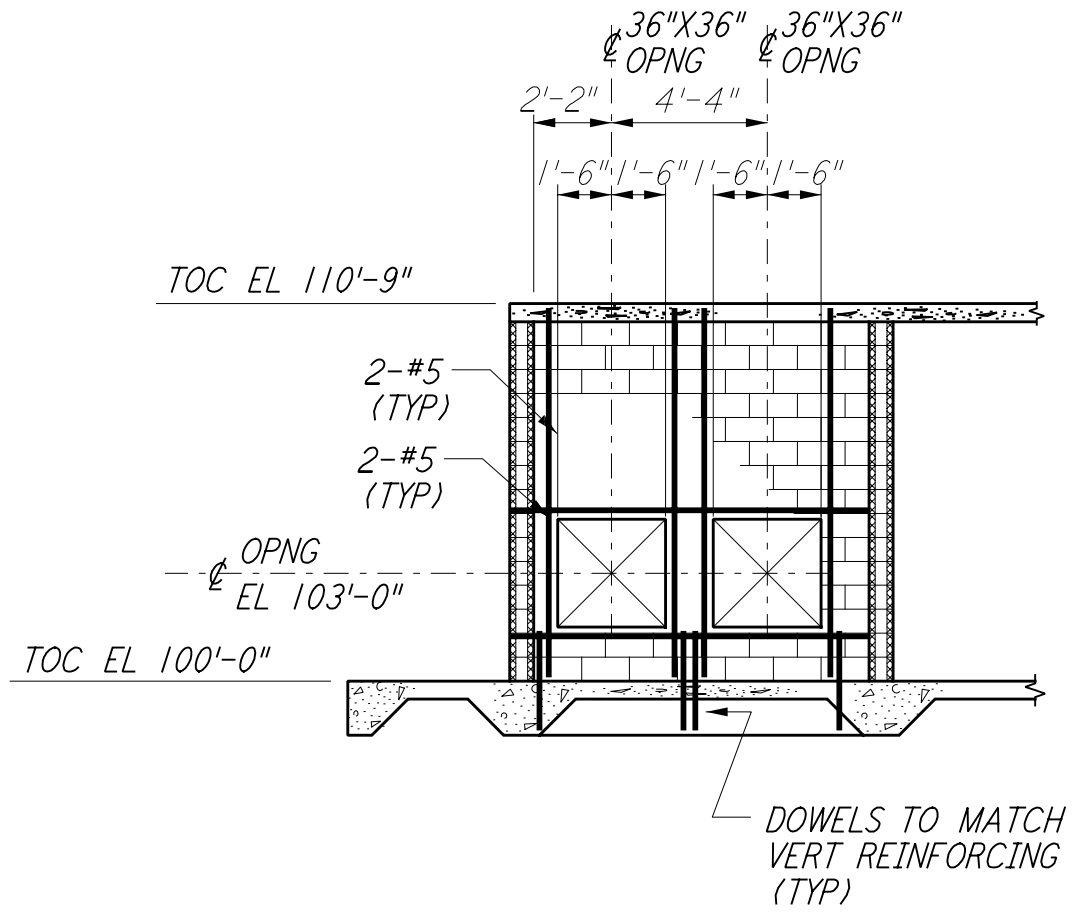


SECTION K REF
 $\frac{3}{16}'' = 1'-0''$
 WA-S-503 WA-S-502

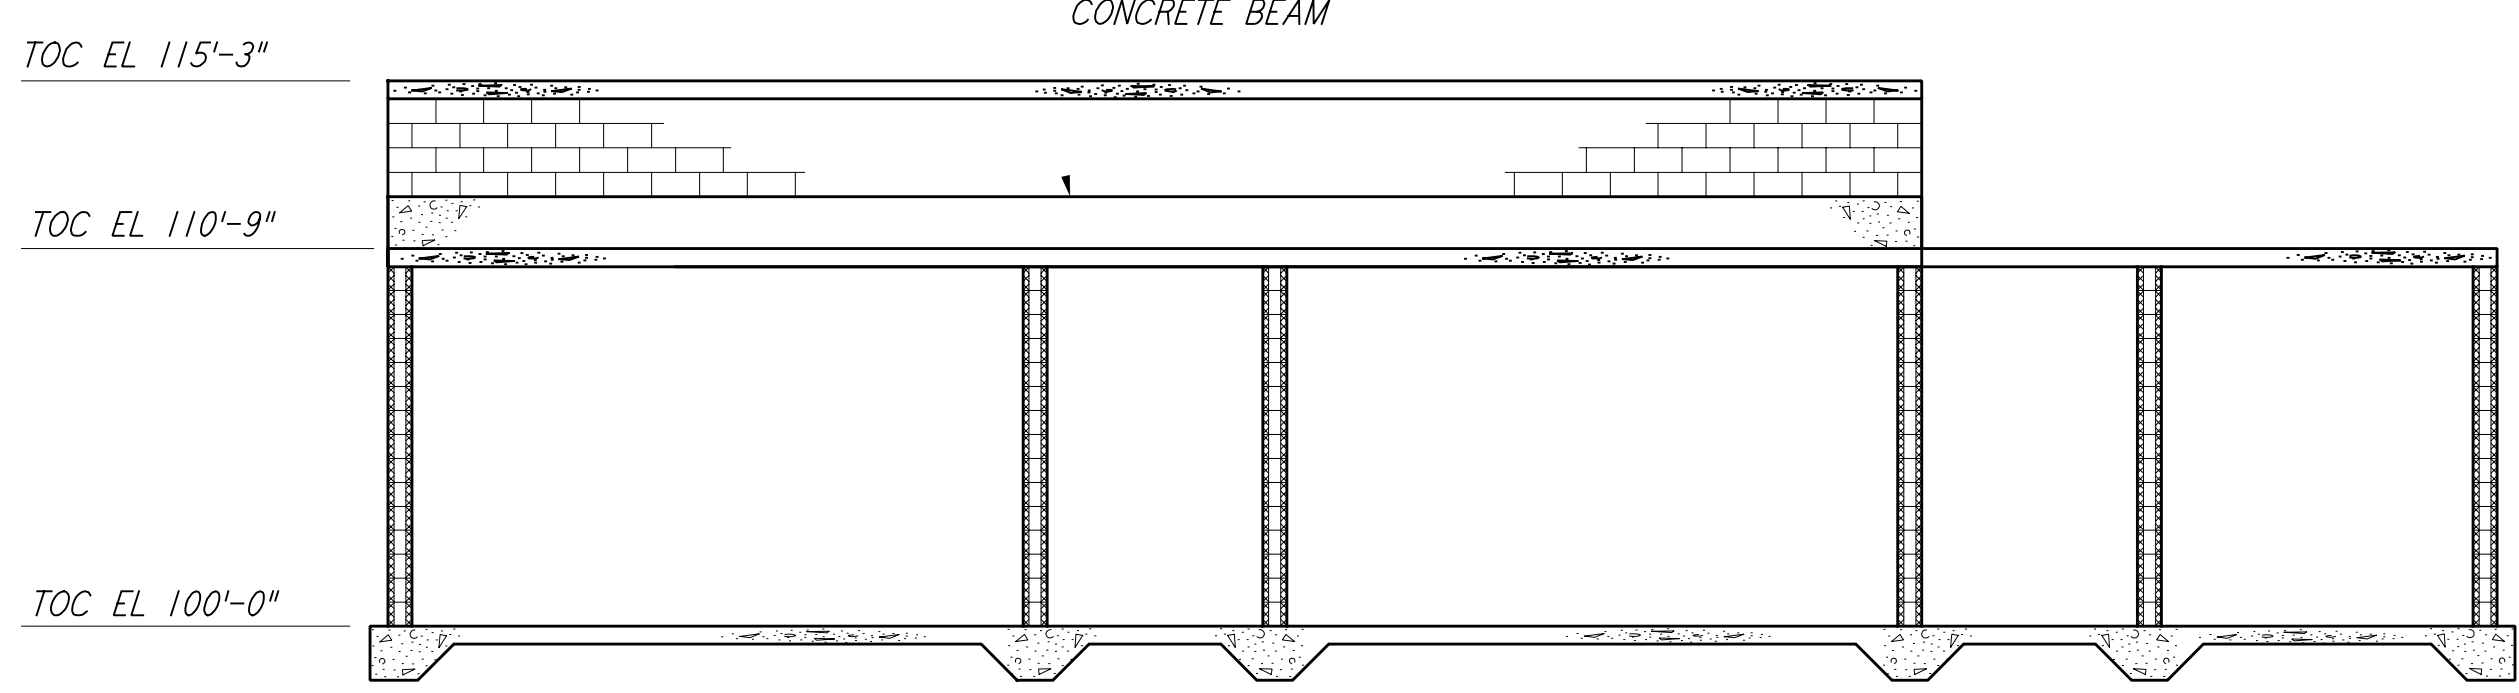

SECTION L REF
 $\frac{3}{16}'' = 1'-0''$
 WA-S-503 WA-S-502

NOTES:
 1. FOR GENERAL NOTES, ABBREVIATIONS & SYMBOLS SEE DRAWING WA-S-001.

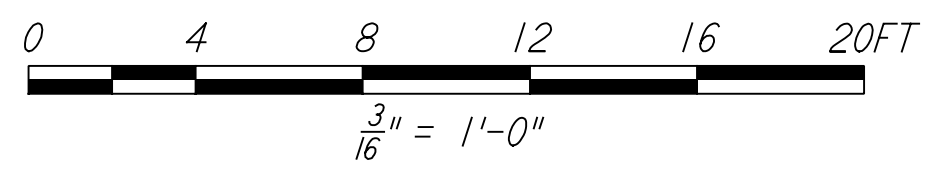

LIGO-D960324-01-O

NO.	DATE	BY	CHKD	ENGR	PROJ	DESCRIPTION
1	6-15-98	CKT				ISSUED FOR AS-BUILT

ISSUED FOR CONSTRUCTION		
DRAWN	MCS	6-24-96
CHECKED	DDM	7-2-96
ENGINEER	BP	6-28-96
PROJ	MDW	7-9-96

AS-BUILT DRAWINGS



LASER INTERFEROMETER GRAVITATIONAL-WAVE OBSERVATORY SITE NO. I - HANFORD, WASHINGTON		
TITLE	AS NOTED	PROJECT NUMBER
STRUCTURAL CORNER STATION AIR HANDLING UNIT ENCLOSURE ELEVS & SECTS	PP150969	8094
SHEET NUMBER		REVISIONS
WA-S-503		