

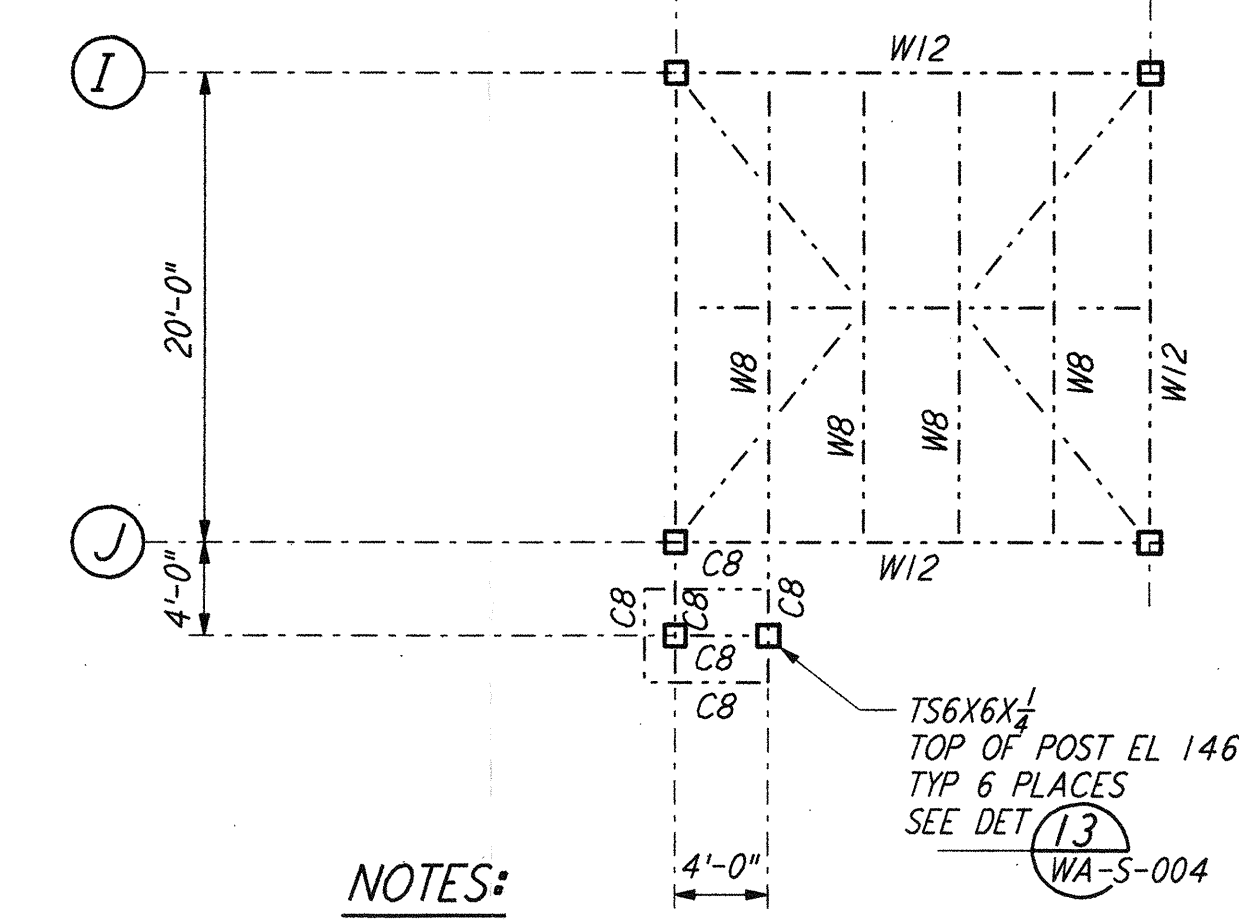
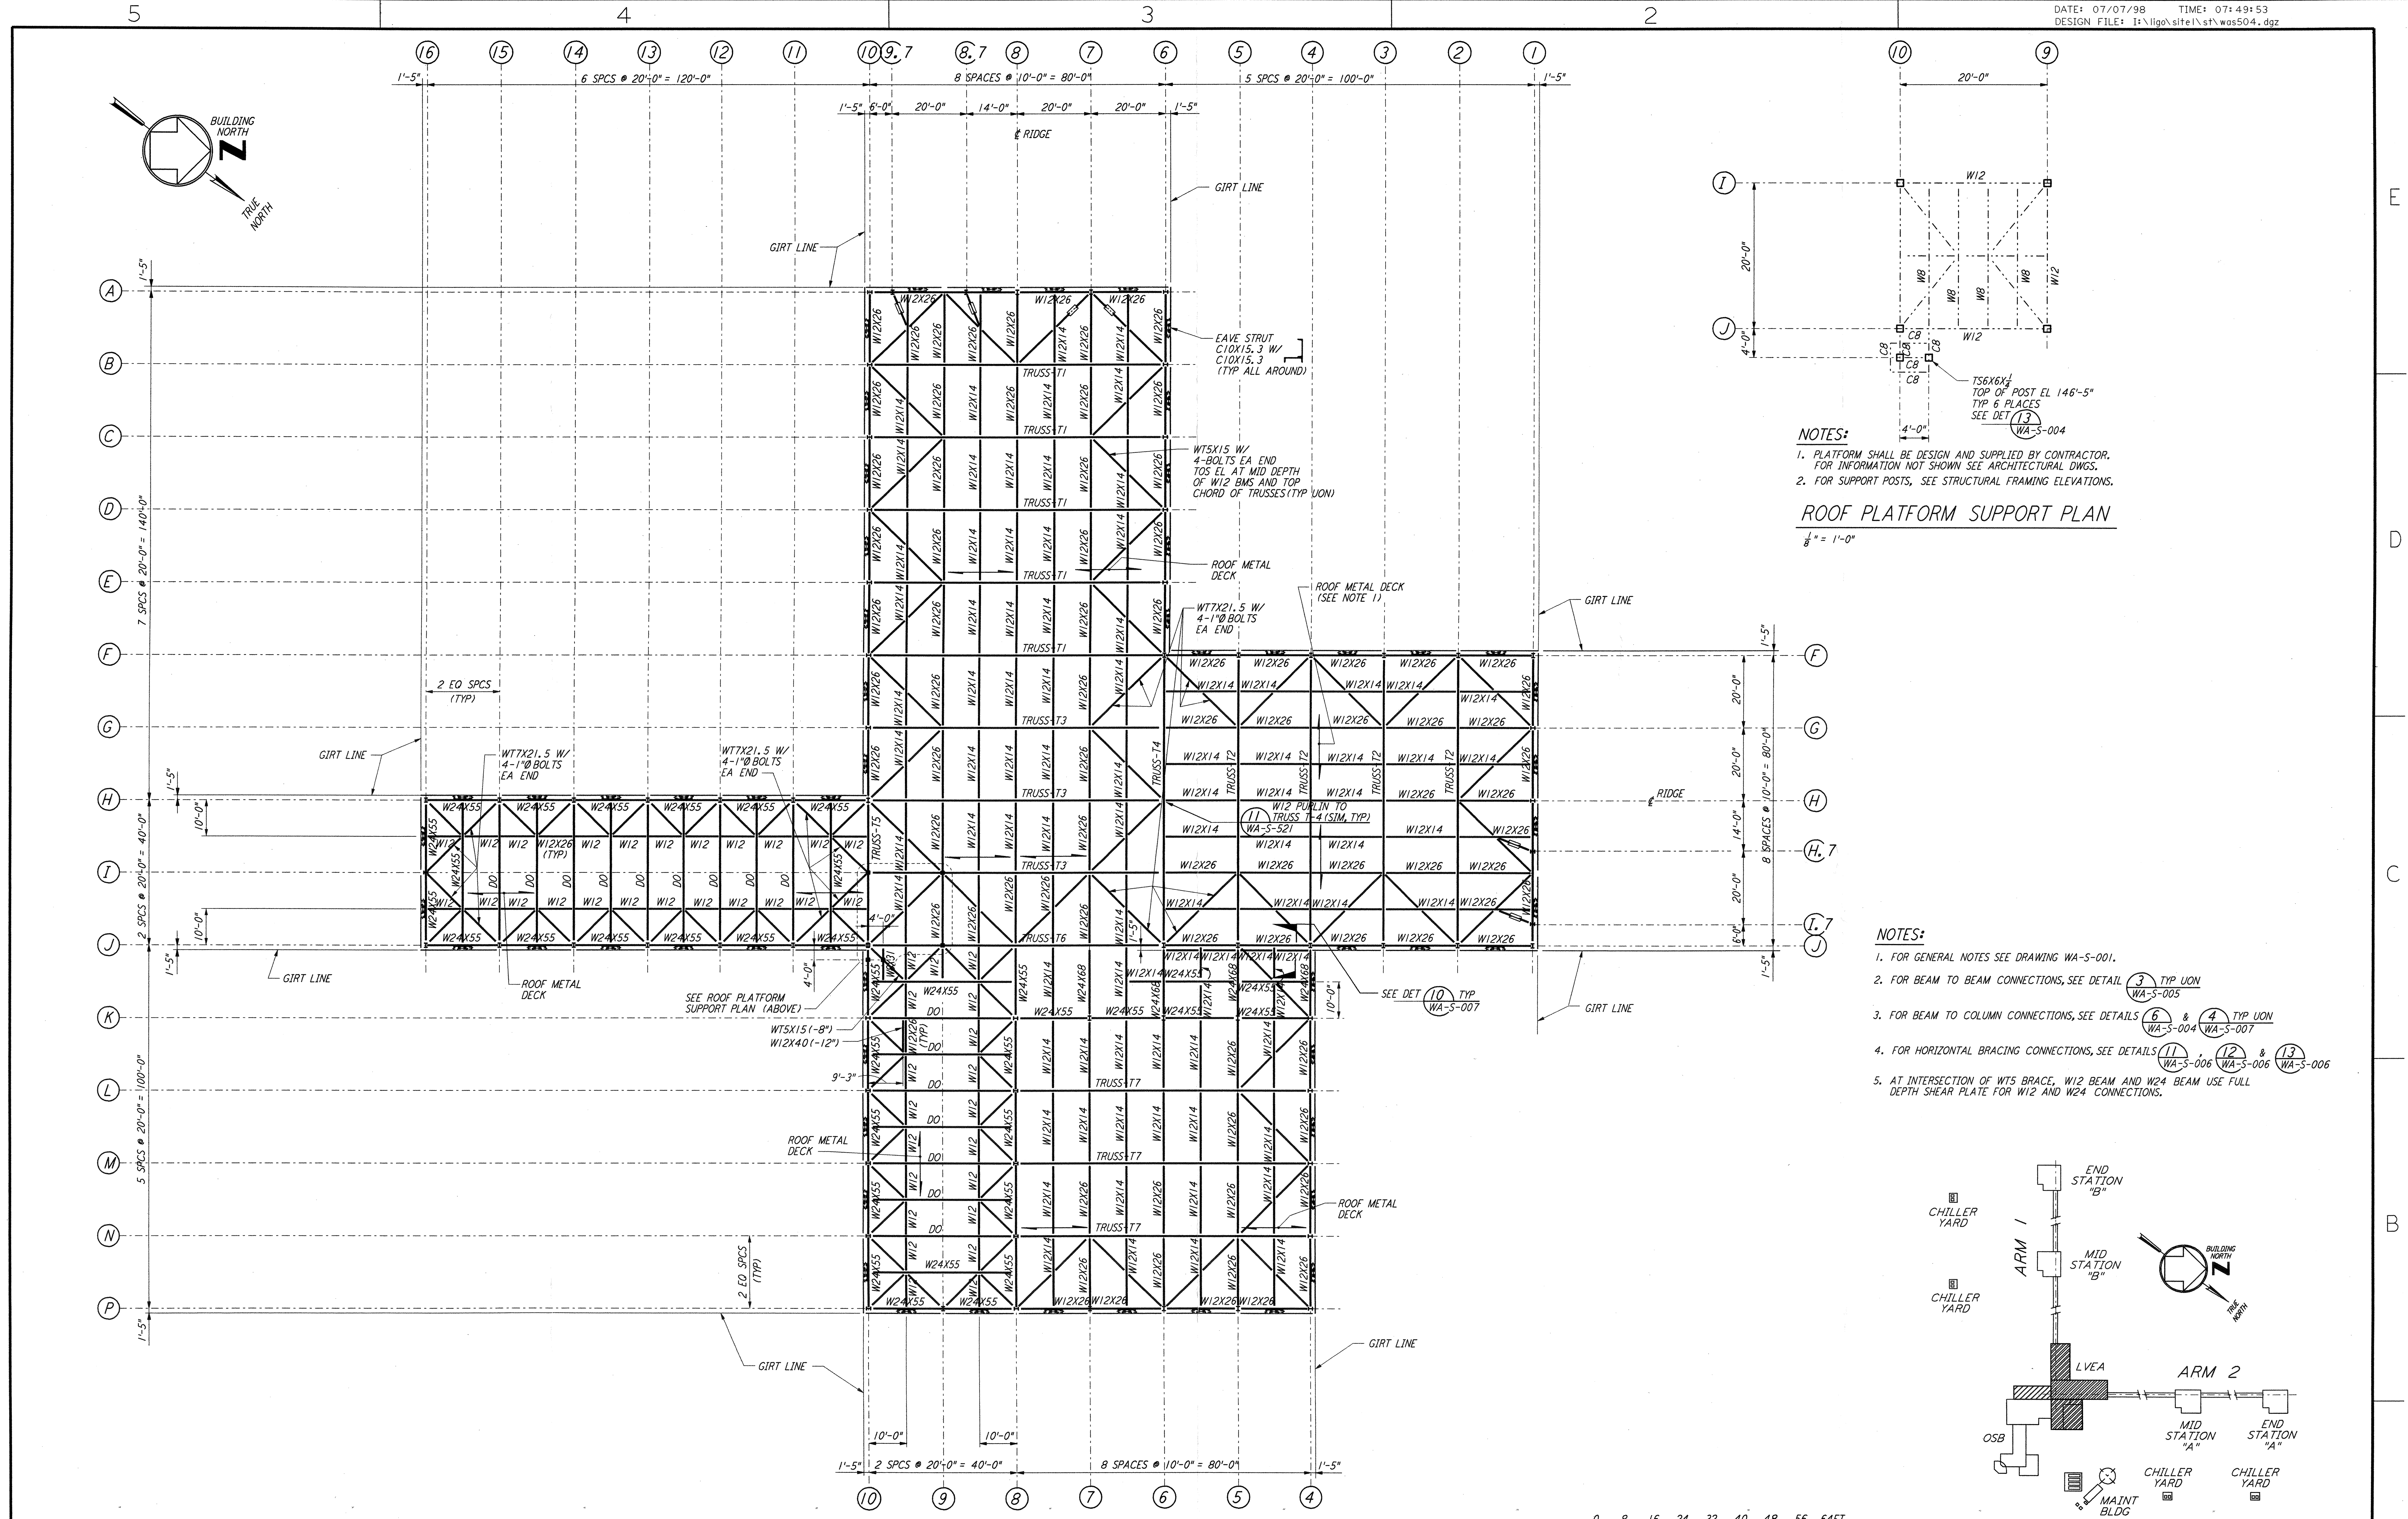


This document and the design it covers are the property of PARSONS. They are loaned only with the borrower's expressed written agreement that they will not be reproduced, copied, loaned, exhibited, or used in any other way, except by written consent from PARSONS to the borrower.

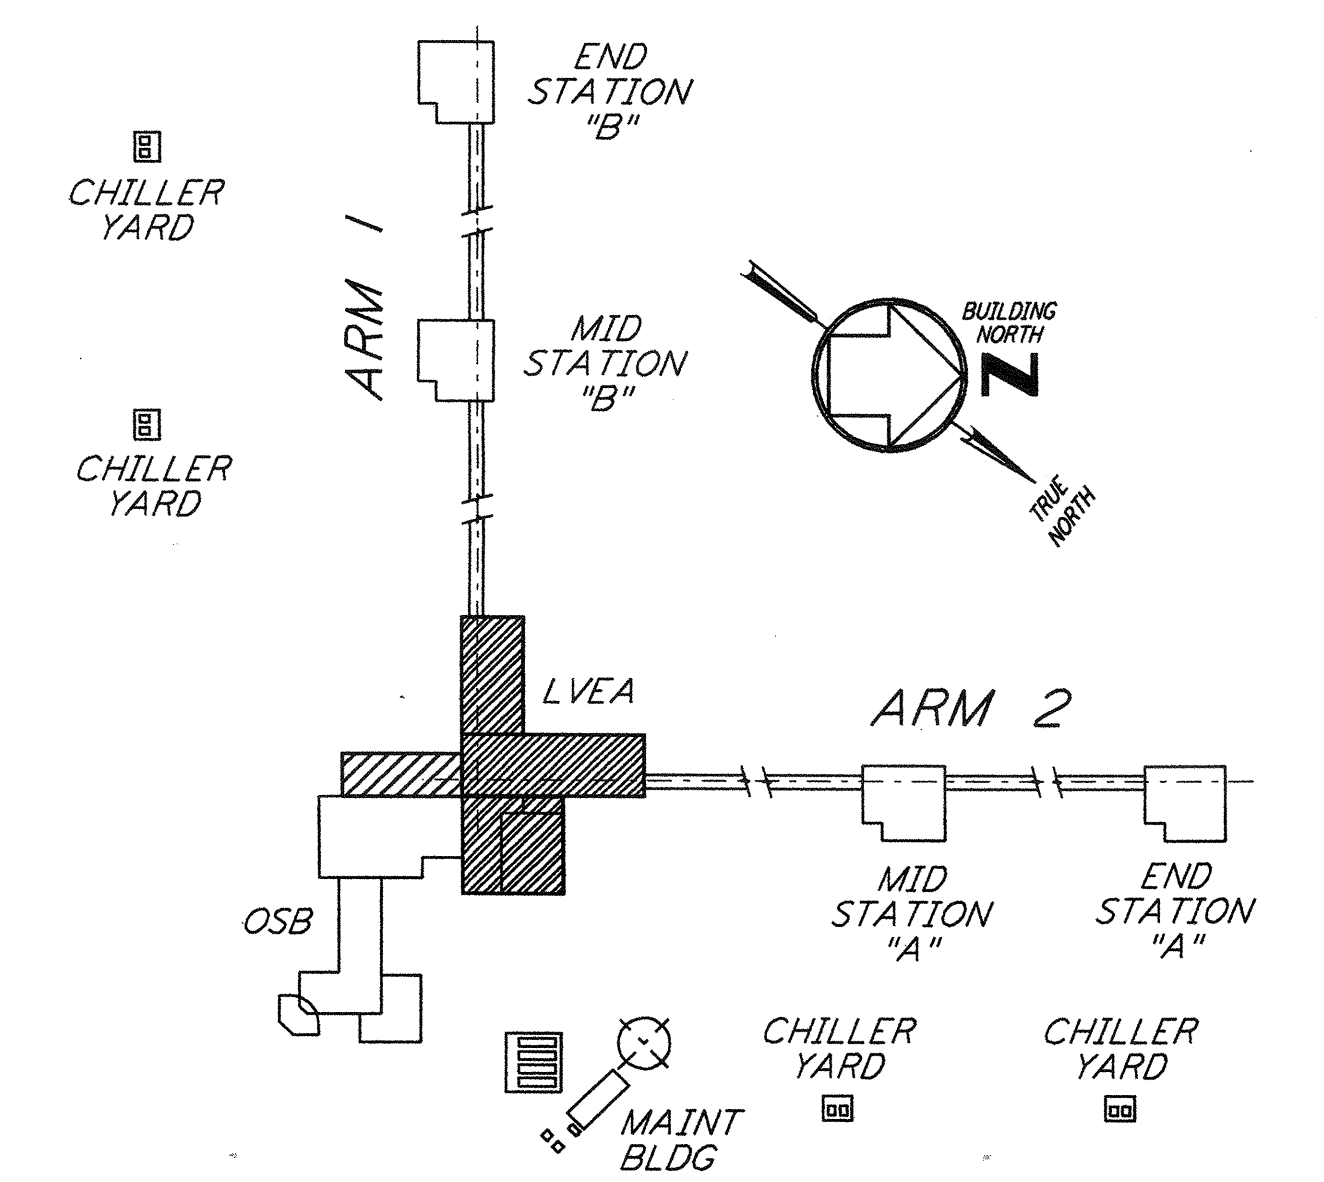

**NOTES:**  
 1. PLATFORM SHALL BE DESIGN AND SUPPLIED BY CONTRACTOR. FOR INFORMATION NOT SHOWN SEE ARCHITECTURAL DWGS.  
 2. FOR SUPPORT POSTS, SEE STRUCTURAL FRAMING ELEVATIONS.  
**ROOF PLATFORM SUPPORT PLAN**  
 1/8" = 1'-0"

**NOTES:**  
 1. FOR GENERAL NOTES SEE DRAWING WA-S-001.  
 2. FOR BEAM TO BEAM CONNECTIONS, SEE DETAIL (3) TYP UON WA-S-005  
 3. FOR BEAM TO COLUMN CONNECTIONS, SEE DETAILS (6) & (4) TYP UON WA-S-004 & WA-S-007  
 4. FOR HORIZONTAL BRACING CONNECTIONS, SEE DETAILS (11), (12) & (13) WA-S-006 & WA-S-006  
 5. AT INTERSECTION OF W15 BRACE, W12 BEAM AND W24 BEAM USE FULL DEPTH SHEAR PLATE FOR W12 AND W24 CONNECTIONS.

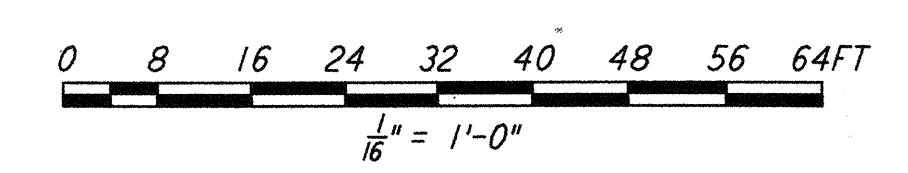

**KEY PLAN**  
**LIGO-D960325-01-0**

NO.	DATE	BY	CHKD	ENGR	PROJ	DESCRIPTION
1	6-15-98	CKT	DPF	PKB	PK	ISSUED FOR AS-BUILT

ISSUED FOR CONSTRUCTION	MCS	6-24-96
DRAWN	DDM	7-2-96
CHECKED	BP	6-28-96
ENGINEER	MDW	7-2-96
PROJ		

**AS-BUILT DRAWINGS**



100 WEST WALNUT STREET  
 PASADENA, CALIFORNIA



CALIFORNIA INSTITUTE OF TECHNOLOGY  
 MASSACHUSETTS INSTITUTE OF TECHNOLOGY

LASER INTERFEROMETER  
 GRAVITATIONAL-WAVE OBSERVATORY  
 SITE NO. 1 - HANFORD, WASHINGTON

TITLE	SCALE	CONTRACT NUMBER	PROJECT NUMBER
STRUCTURAL CORNER STATION LVEA ROOF FRAMING PLAN	AS NOTED	PPI50969	8094
SHEET NUMBER	REVISIONS		
WA-S-504			