
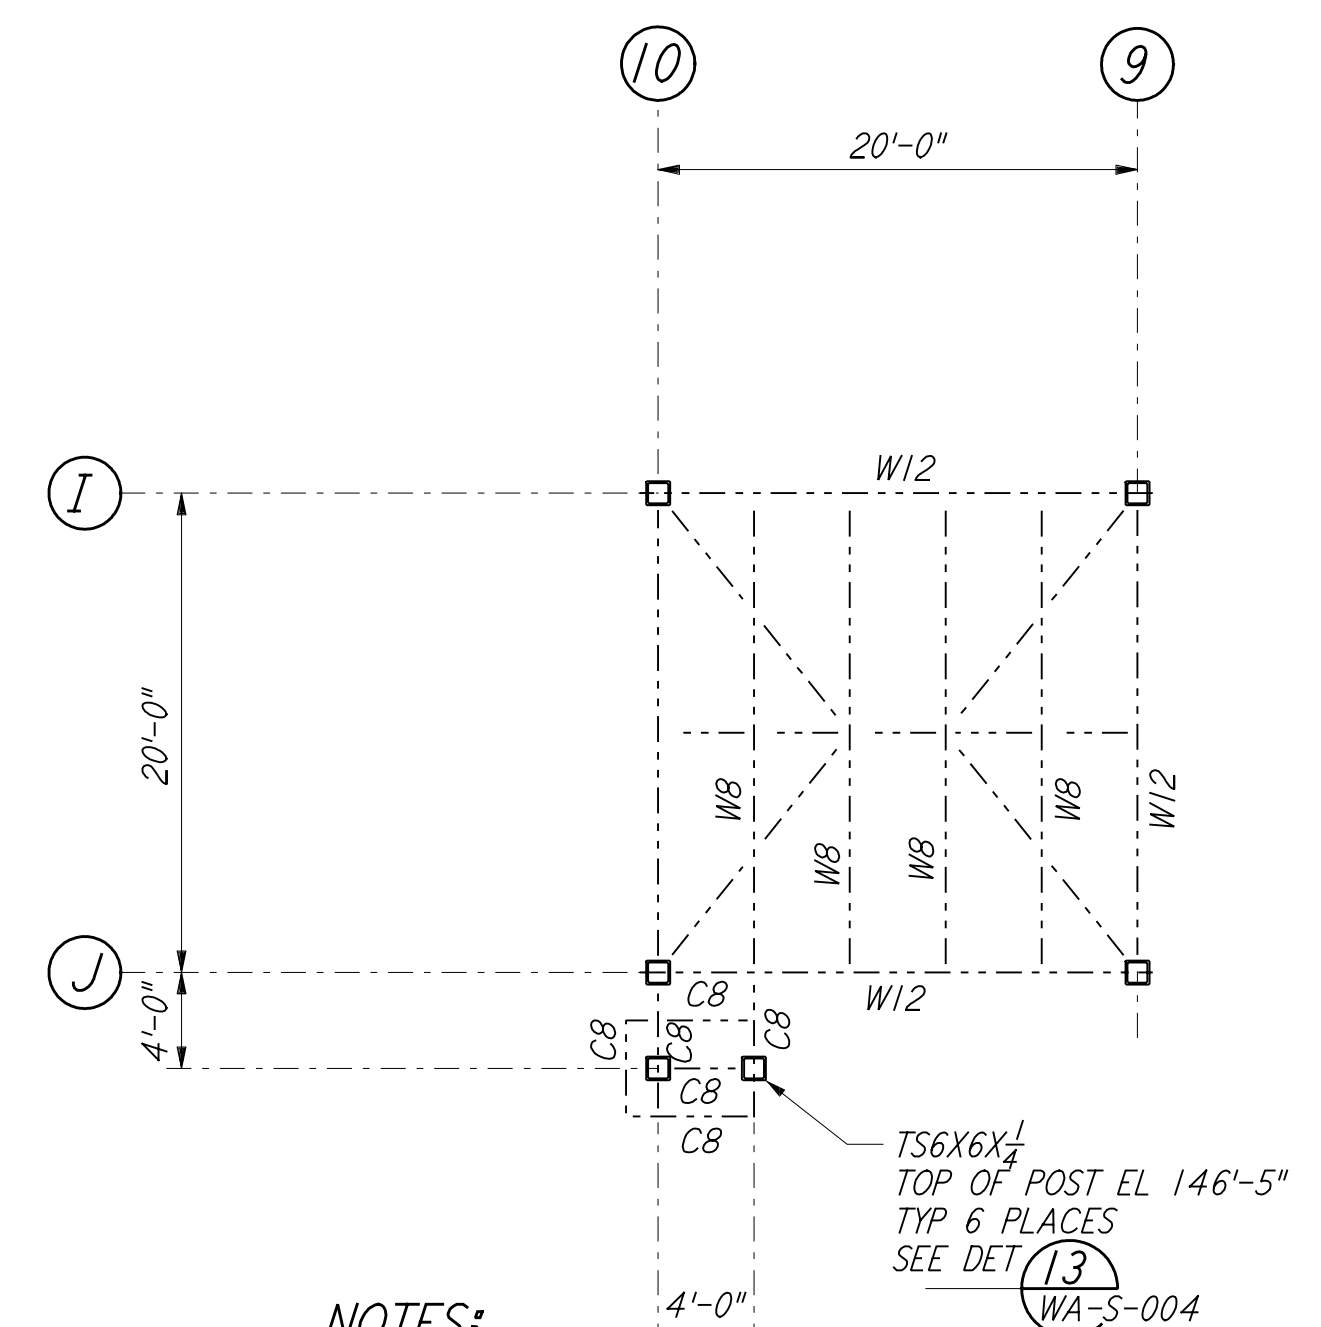


This document and the design it covers are the property of PARSONS. They are loaned only with the borrower's expressed written agreement that they will not be reproduced, copied, loaned, exhibited, or used in any other way, except by written consent from PARSONS to the borrower.

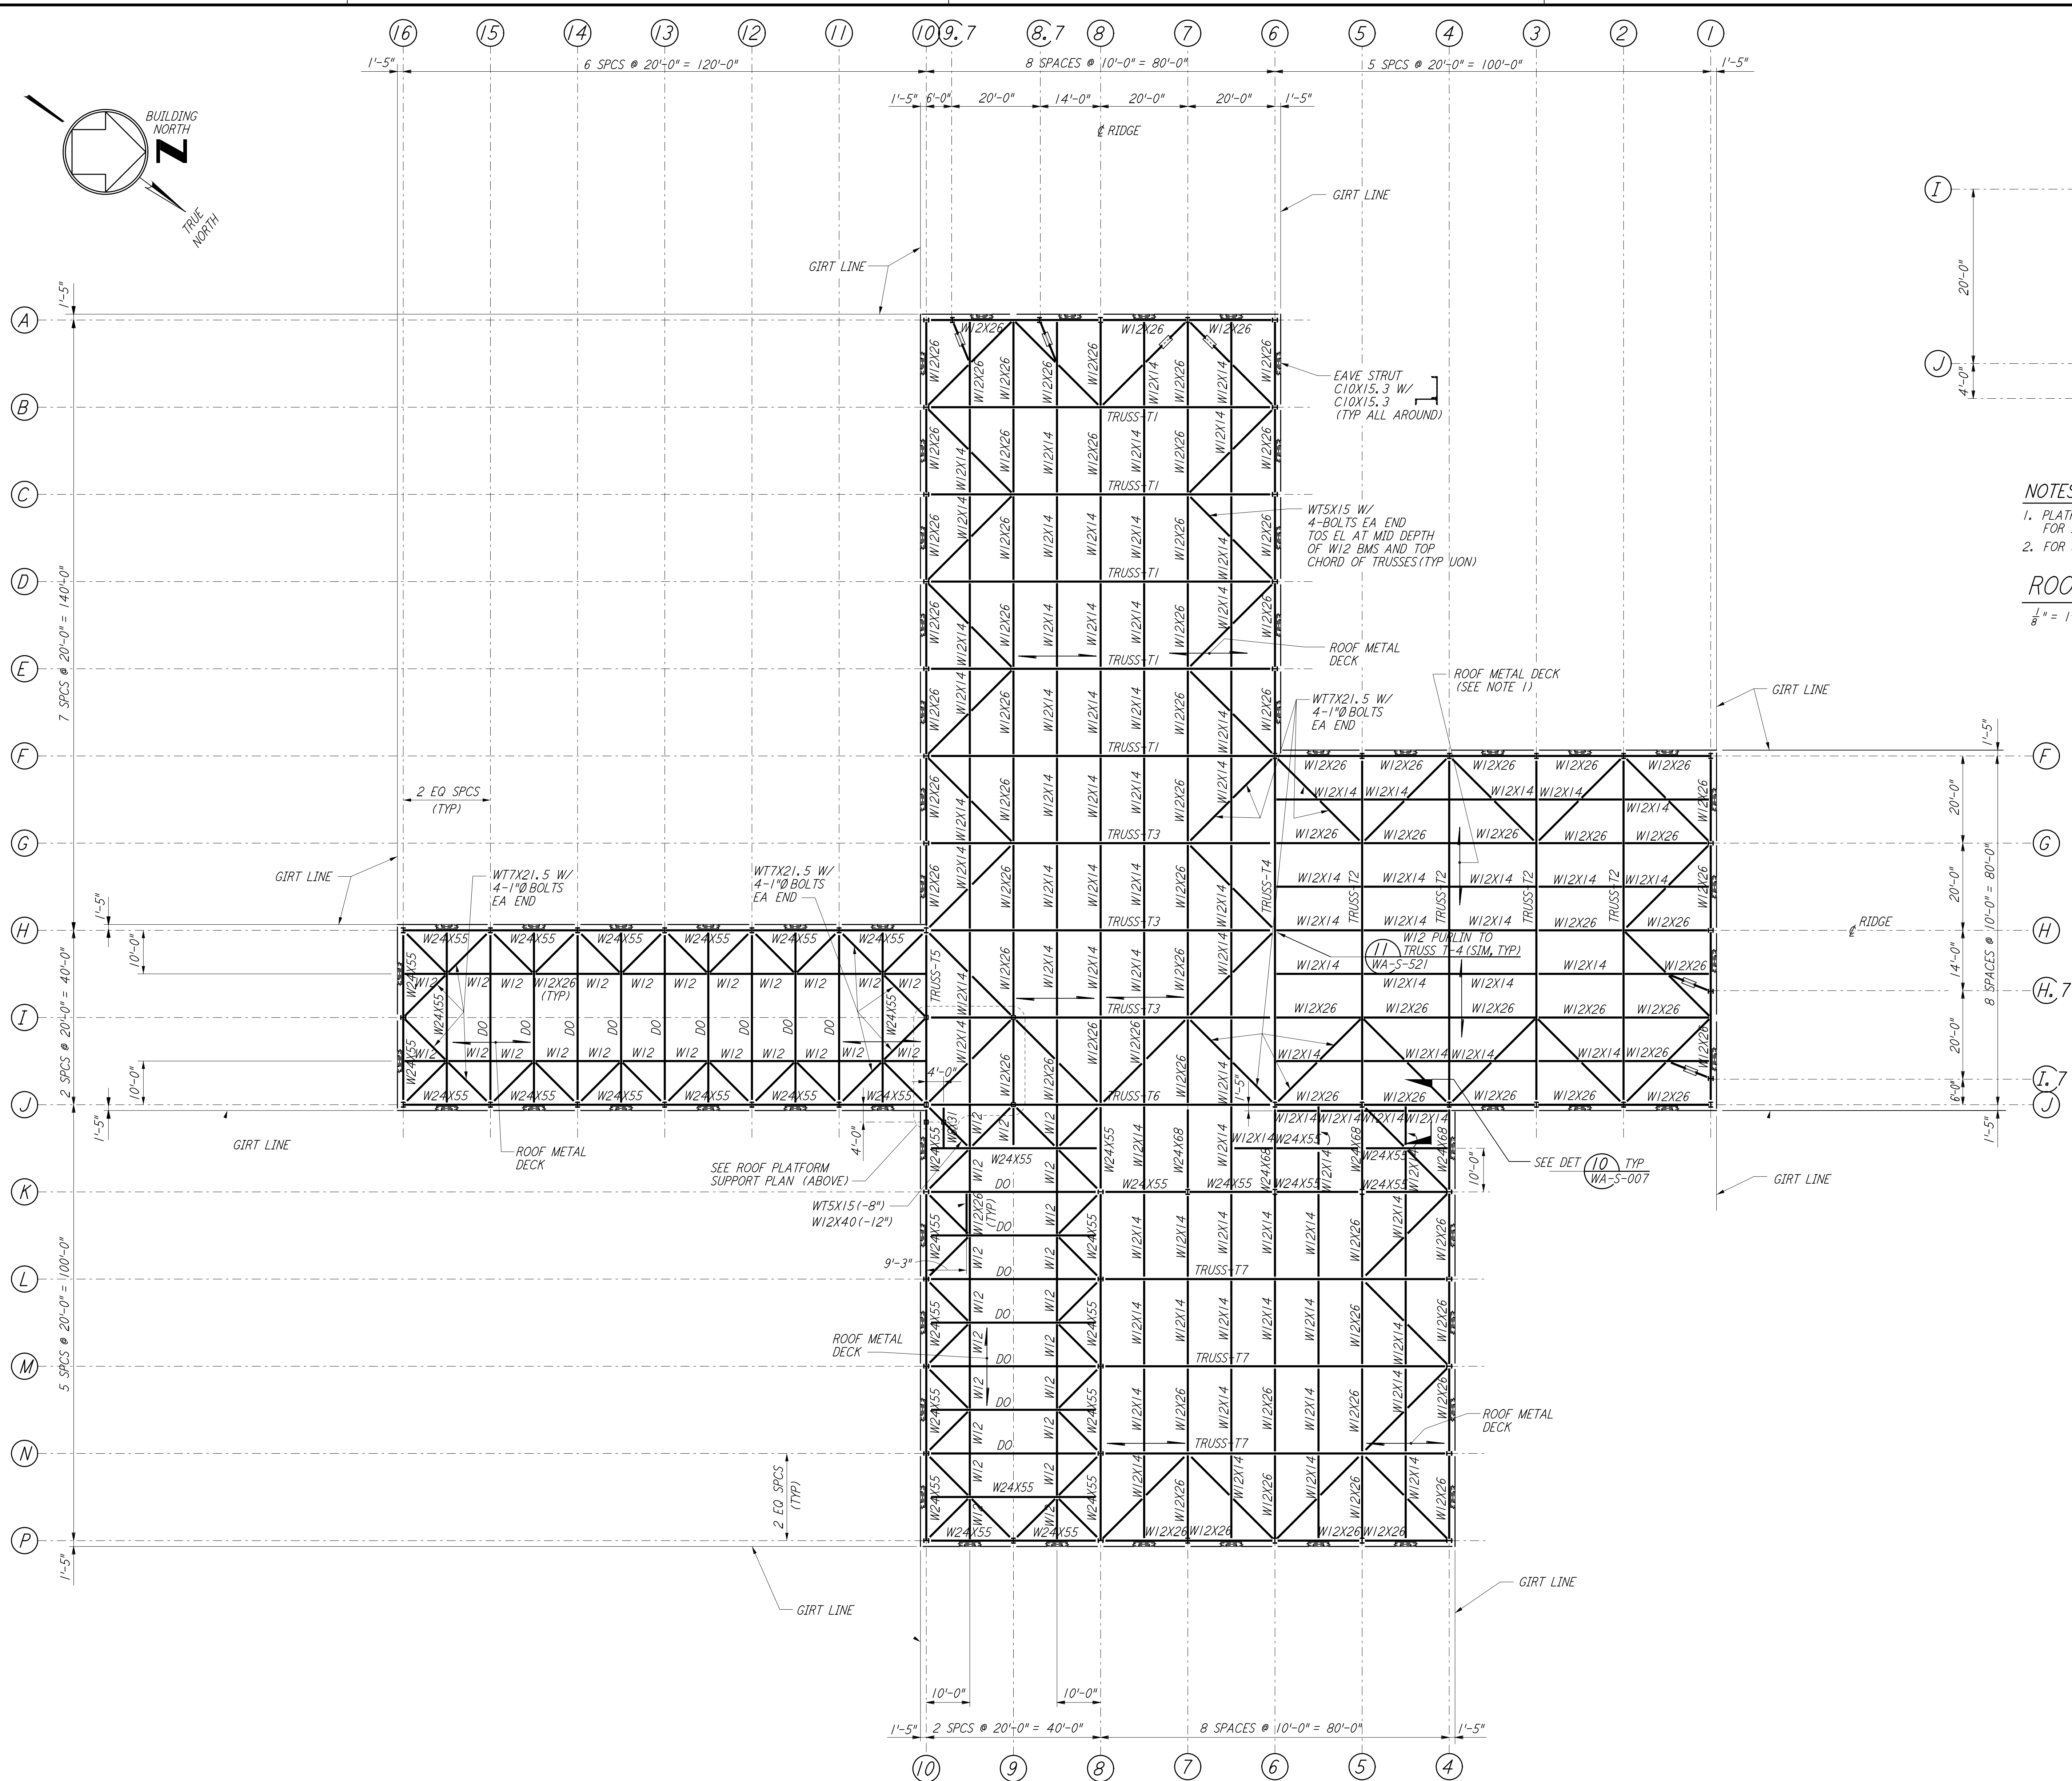


**NOTES:**

1. PLATFORM SHALL BE DESIGN AND SUPPLIED BY CONTRACTOR. FOR INFORMATION NOT SHOWN SEE ARCHITECTURAL DWGS.
2. FOR SUPPORT POSTS, SEE STRUCTURAL FRAMING ELEVATIONS.


**ROOF PLATFORM SUPPORT PLAN**  
 $\frac{1}{8}'' = 1'-0''$

**NOTES:**

1. FOR GENERAL NOTES SEE DRAWING WA-S-001.
2. FOR BEAM TO BEAM CONNECTIONS, SEE DETAIL (3) TYP UON WA-S-005
3. FOR BEAM TO COLUMN CONNECTIONS, SEE DETAILS (6) & (4) TYP UON WA-S-004 & WA-S-007
4. FOR HORIZONTAL BRACING CONNECTIONS, SEE DETAILS (11) & (12) & (13) WA-S-006 WA-S-006 & WA-S-006
5. AT INTERSECTION OF WTS BRACE, W12 BEAM AND W24 BEAM USE FULL DEPTH SHEAR PLATE FOR W12 AND W24 CONNECTIONS.

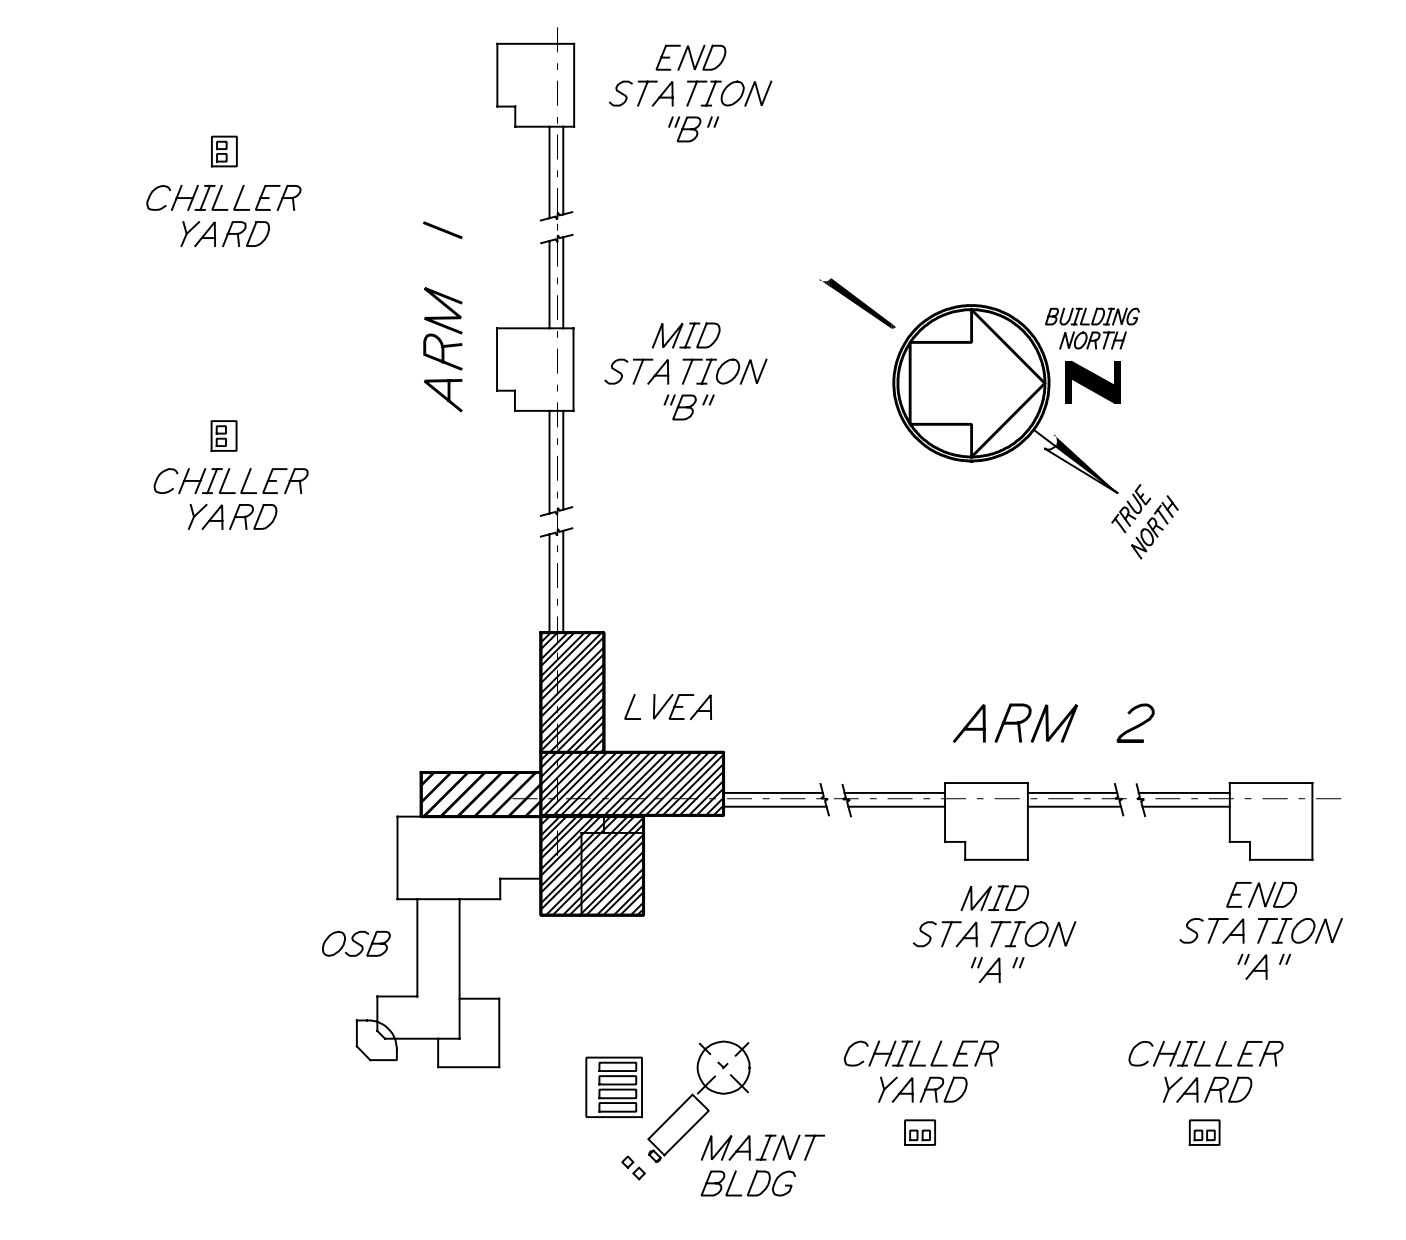

**LIGO-D960325-01-O KEY PLAN**

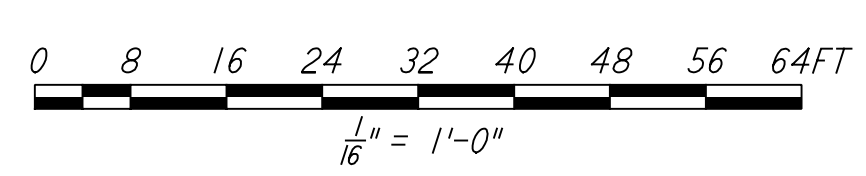

ISSUED FOR CONSTRUCTION					DRAWN MCS 6-24-96							
CHECKED DDM 7-2-96					ENGINEER BP 6-28-96							
PROJ MDW 7-2-96					AS-BUILT DRAWINGS							
ISSUED FOR AS-BUILT					DRAWING NO. DESCRIPTION							
NO.	DATE	BY	CHKD	ENGR	PROJ	NO.	DATE	BY	CHKD	ENGR	PROJ	DESCRIPTION
1	6-15-98	CKT										



LASER INTERFEROMETER GRAVITATIONAL-WAVE OBSERVATORY SITE NO. 1 - HANFORD, WASHINGTON			TITLE		
STRUCTURAL CORNER STATION LVEA ROOF FRAMING PLAN			SCALE	AS NOTED	PP150969
			SHEET NUMBER	8094	PROJECT NUMBER
			<b>WA-S-504</b>		

The user is responsible for the accuracy of the information provided in this drawing.