



PARTIAL ELEVATION AT COLUMN LINE J
 $\frac{3}{16}'' = 1'-0''$

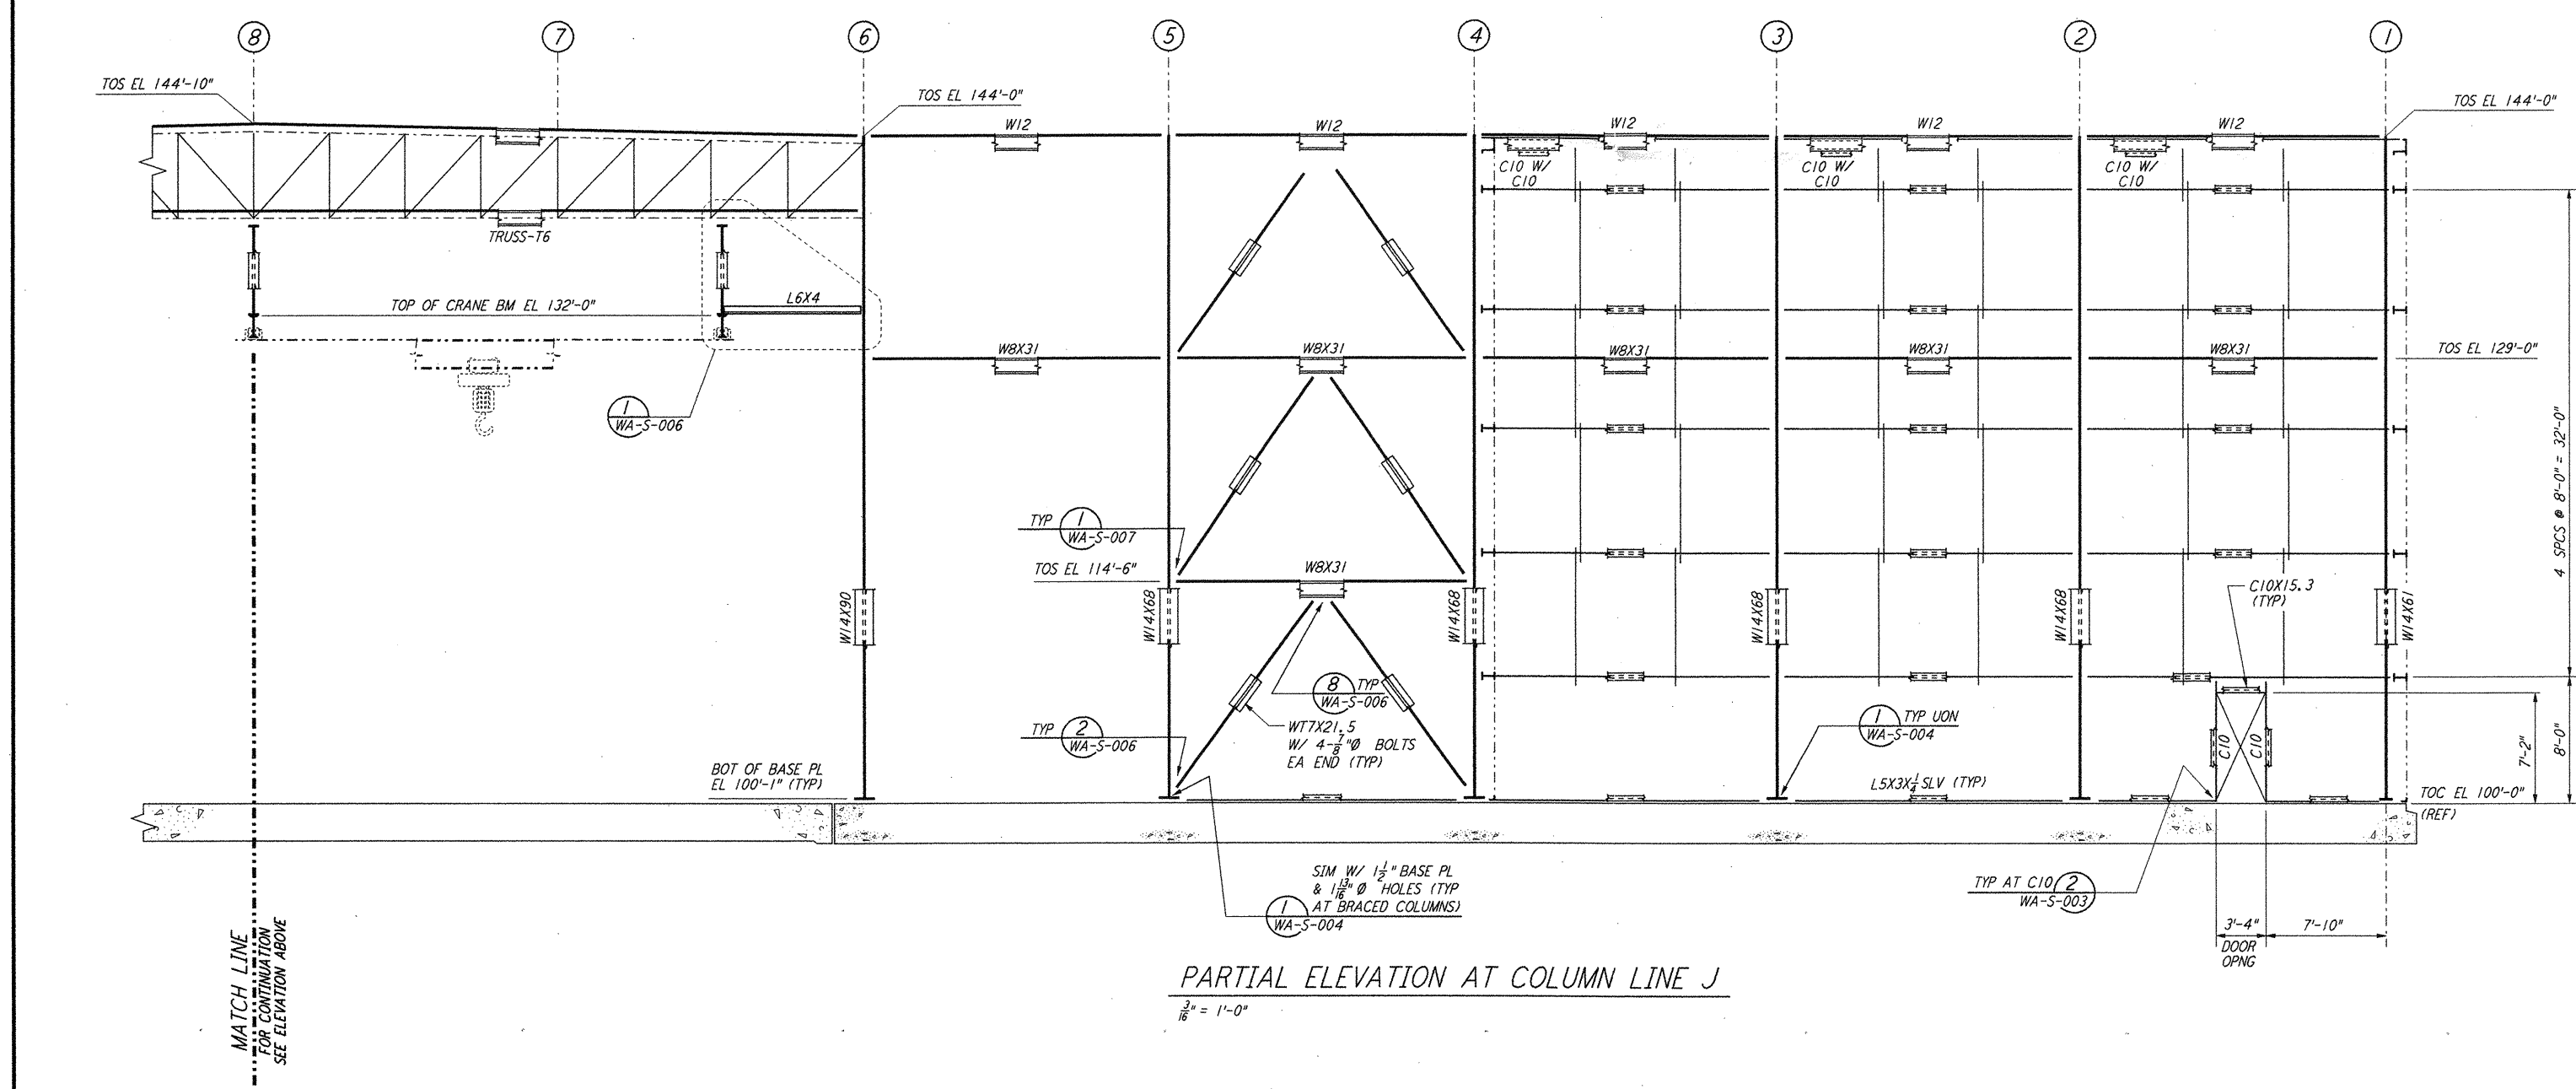

PARTIAL ELEVATION AT COLUMN LINE J
 $\frac{3}{16}'' = 1'-0''$

MATCH LINE
 FOR CONTINUATION
 SEE ELEVATION BELOW

NOTE:
 1. FOR NOTES SEE DRAWING WA-S-507.

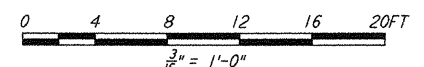

LIGO-D960335-01-0

NO.	DATE	BY	CHKD	ENGR	PROJ	DESCRIPTION
1	6-15-98	CKT	BP	MDW	PA	ISSUED FOR AS-BUILT

ISSUED FOR CONSTRUCTION		
DRAWN	MCS	6-24-98
CHECKED	DDM	7-2-98
ENGINEER	BP	6-28-98
PROJ	MDW	7-9-98

AS-BUILT DRAWINGS

PARSONS
 100 WEST WALNUT STREET
 PASADENA, CALIFORNIA

LIGO
 CALIFORNIA INSTITUTE OF TECHNOLOGY
 MASSACHUSETTS INSTITUTE OF TECHNOLOGY

LASER INTERFEROMETER
 GRAVITATIONAL-WAVE OBSERVATORY
 SITE NO. 1 - HANFORD, WASHINGTON

TITLE: STRUCTURAL CORNER STATION LVEA FRAMING ELEVATIONS SHEET 8

SCALE: AS NOTED CONTRACT NUMBER: PPI150969 PROJECT NUMBER: 8094

SHEET NUMBER: **WA-S-514**

not be reproduced, copied, loaned, exhibited, or used in any other way, except by written consent from PARSONS to the borrower.

This document and the design it covers are the property of PARSONS. They are loaned only with the borrower's expressed written agreement that they will

Mon Jul 06 16:52:38 1998 C:\PLOT\QUE\S3-Y9862.DCF 52885 K:\V9862\4514.prf LIGOWAF.BDR