
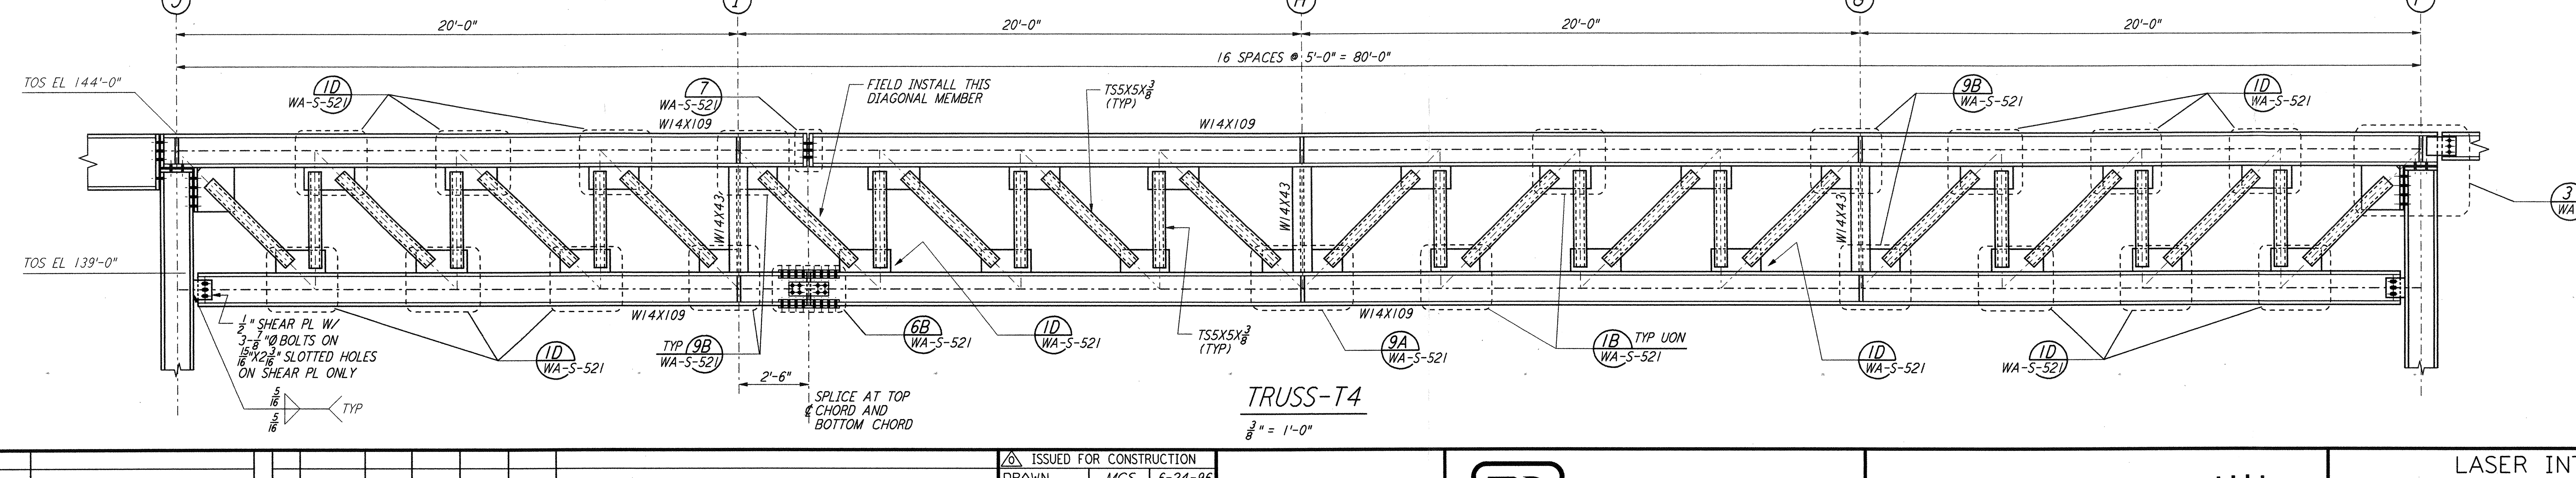
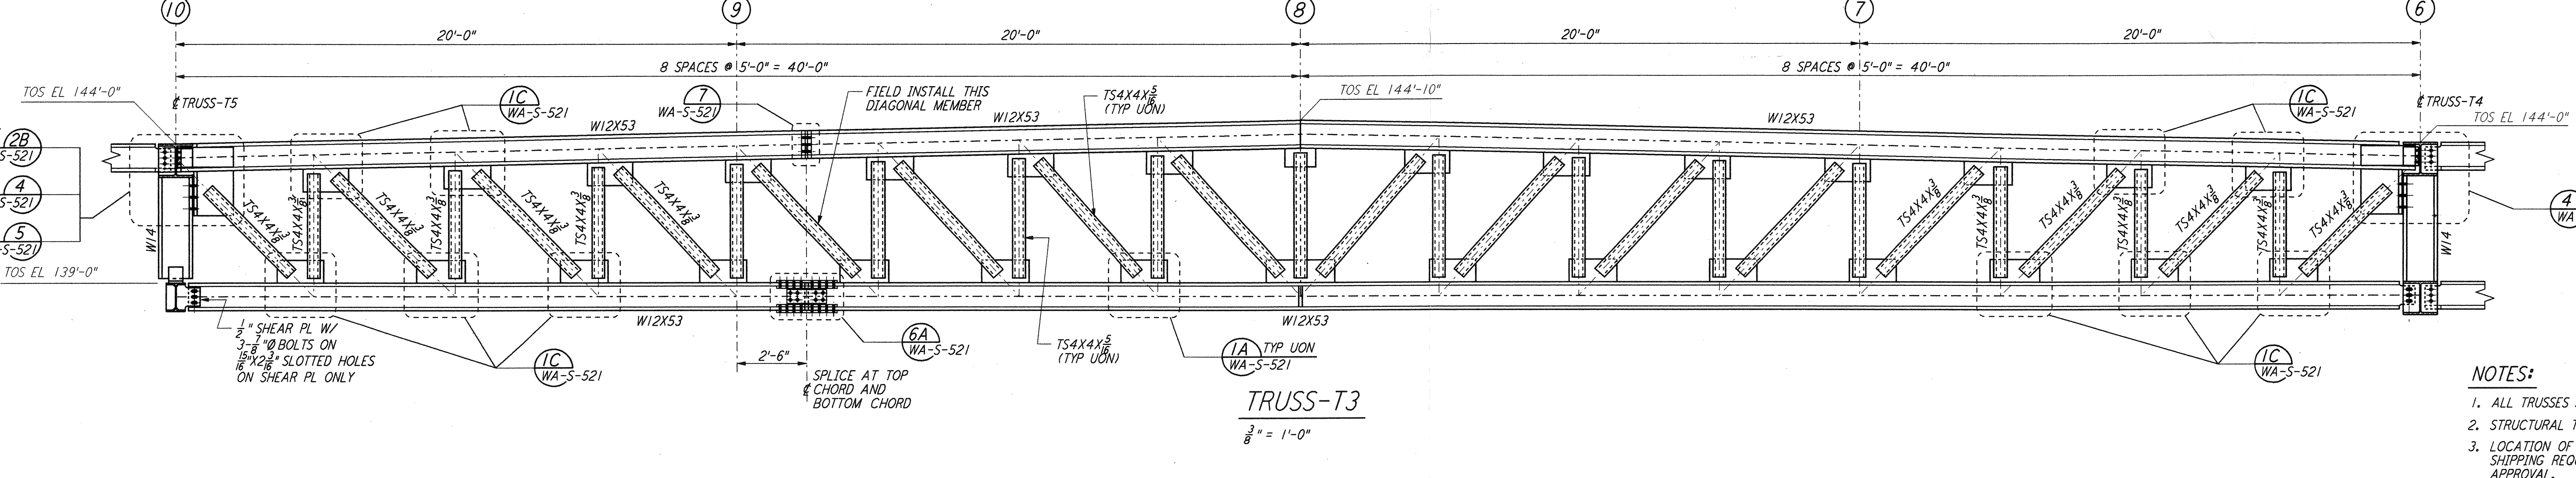
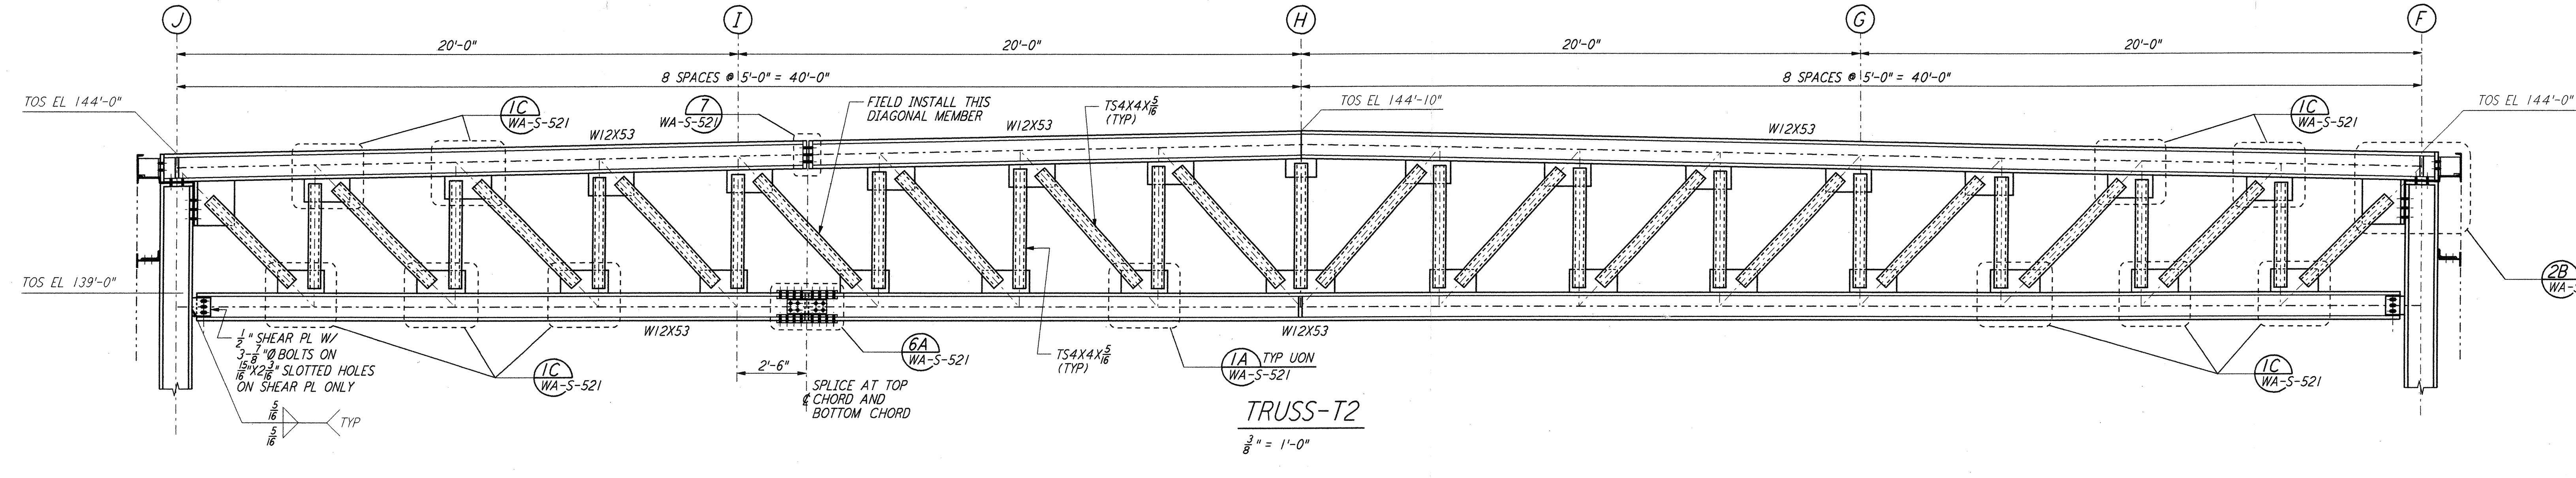


This document and the design it covers are the property of PARSONS. They are loaned only with the borrower's expressed written agreement that they will not be reproduced, copied, loaned, exhibited, or used in any other way, except by written consent from PARSONS to the borrower.

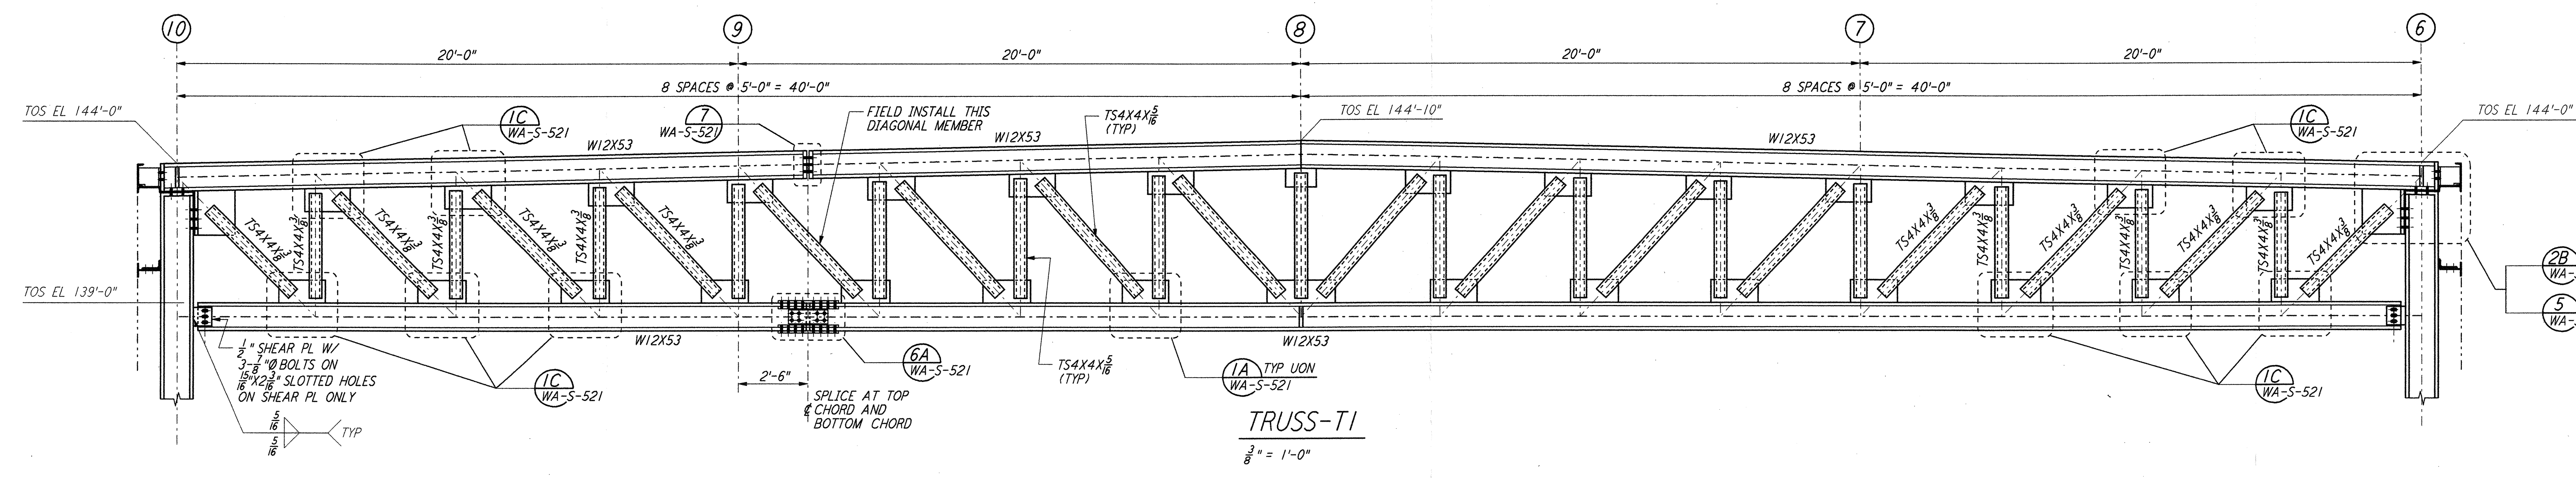


(2B) TYP UON WA-S-521  
 AT LINE F THIS END ONLY  
 (5) WA-S-521

(2B) TYP WA-S-521

(4) WA-S-521

- NOTES:**
- ALL TRUSSES SHALL BE SHOP ASSEMBLED.
  - STRUCTURAL TUBES SHALL BE ASTM A500, GRADE B.
  - LOCATION OF SPLICE MAY BE ADJUSTED TO MEET SHIPPING REQUIREMENTS WITH STRUCTURAL ENGINEER'S APPROVAL.

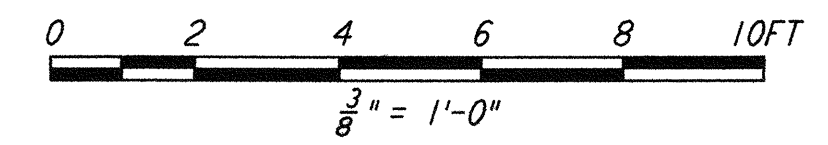

**LIGO-D960338-01-0**

NO.	DATE	BY	CHKD	ENGR	PROJ	DESCRIPTION
1	6-15-98	CKT	MDW	MDW	MDW	ISSUED FOR AS-BUILT

NO.	DATE	BY	CHKD	ENGR	PROJ	DESCRIPTION
1	6-15-98	CKT	MDW	MDW	MDW	ISSUED FOR AS-BUILT

ISSUED FOR CONSTRUCTION  
 DRAWN MCS 6-24-96  
 CHECKED DDM 7-2-96  
 ENGINEER BP 6-28-96  
 PROJ MDW 7-9-96

**AS-BUILT DRAWINGS**

100 WEST WALNUT STREET  
 PASADENA, CALIFORNIA



LASER INTERFEROMETER GRAVITATIONAL-WAVE OBSERVATORY SITE NO. 1 - HANFORD, WASHINGTON		PROJECT NUMBER 8094	
STRUCTURAL CORNER STATION LVEA TRUSS ELEVATIONS SHEET 1		SCALE AS NOTED	REVISIONS PP150969
		<b>WA-S-517</b>	