




WALL MOUNTED FIRE DAMPER 1 REF
 NTS WA-H-411

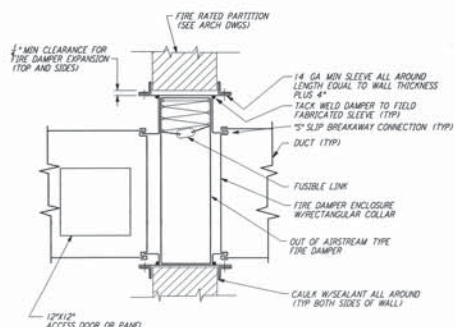


RECTANGULAR DUCT FIRE DAMPER 2 REF
 NTS WA-H-411

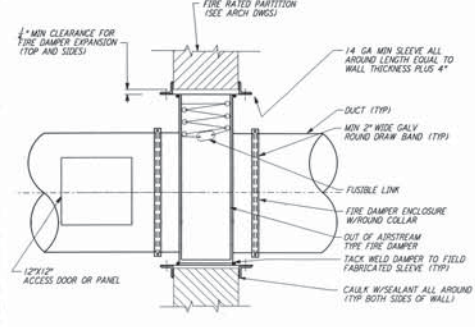


ROUND DUCT FIRE DAMPER MOUNTING DETAIL 3 REF
 NTS WA-H-411

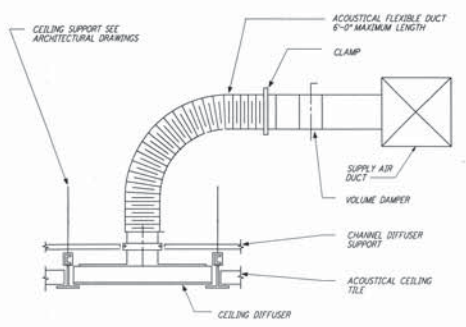


FLEXIBLE DUCT CONNECTION 4 REF
 NTS WA-H-411

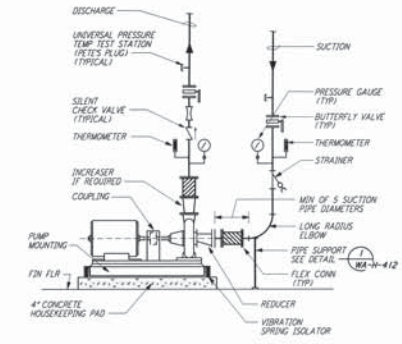


PUMP CONNECTION DETAIL 5 REF
 NTS WA-H-411

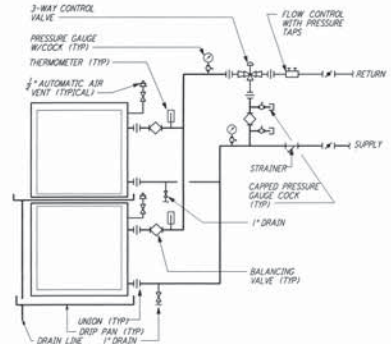


MULTIPLE COIL PIPING DETAIL 6 REF
 NTS WA-H-411

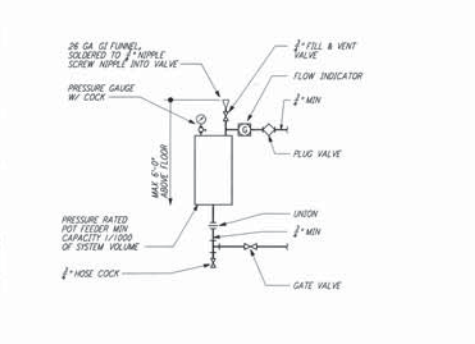


CHEMICAL FEEDER DETAIL 7 REF
 NTS WA-H-411

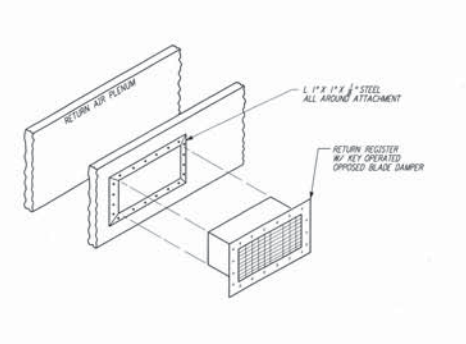


REGISTER MOUNTING DETAIL 8 REF
 NTS WA-H-411

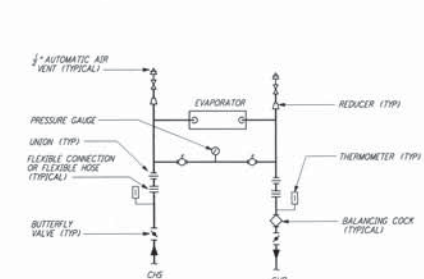

WATER CHILLER CONNECTION 9 REF
 NTS WA-H-411

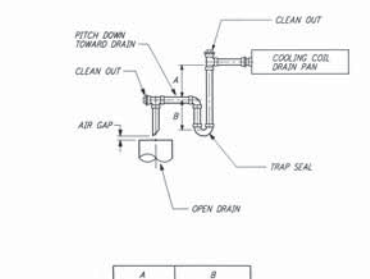

CONDENSATE DRAIN DETAIL 10 REF
 NTS WA-H-411

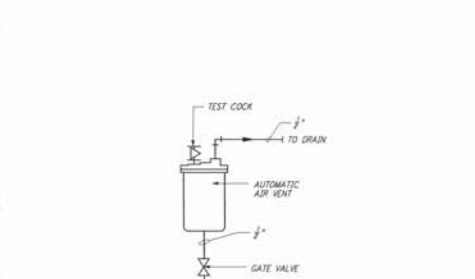

AUTOMATIC AIR VENT 11 REF
 NTS WA-H-411

NOTES:
 1. FOR LEGEND, ABBREVIATIONS AND GENERAL NOTES SEE SHEETS WA-H-001 AND WA-H-002.

This document and the design it covers are the property of PARSONS. It is to be used only for the project and site identified herein. It is not to be reproduced, copied, loaned, exhibited, or used in any way without the prior written consent from PARSONS to the borrower.

NO.	DATE	BY	CHKD	ENGR	PROJ	DESCRIPTION
1	5-15-98	CP	AA	AA	PP	ISSUED FOR AS-BUILT

NO.	DATE	BY	CHKD	ENGR	PROJ	DESCRIPTION
1	6-24-98	CLP	AA	AA	PP	ISSUED FOR CONSTRUCTION
2	7/17/98	ME	AA	AA	PP	CHECKED
3	7/27/98	AA	AA	AA	PP	ENGINEER
4	7/27/98	AA	AA	AA	PP	PROJECT

AS-BUILT DRAWINGS

PARSONS
 100 WEST WALNUT STREET
 PASADENA, CALIFORNIA

LIGO
 CALIFORNIA INSTITUTE OF TECHNOLOGY
 MASSACHUSETTS INSTITUTE OF TECHNOLOGY

LIGO-D960370-01-0

LASER INTERFEROMETER
 GRAVITATIONAL-WAVE OBSERVATORY
 SITE NO. 1 - HANFORD, WASHINGTON

TITLE	HVAC DETAILS SHEET 1
NO.	PP150969 8094
DATE	WA-H-411