




WALL MOUNTED FIRE DAMPER (1) REF  
 NTS WA-H-411

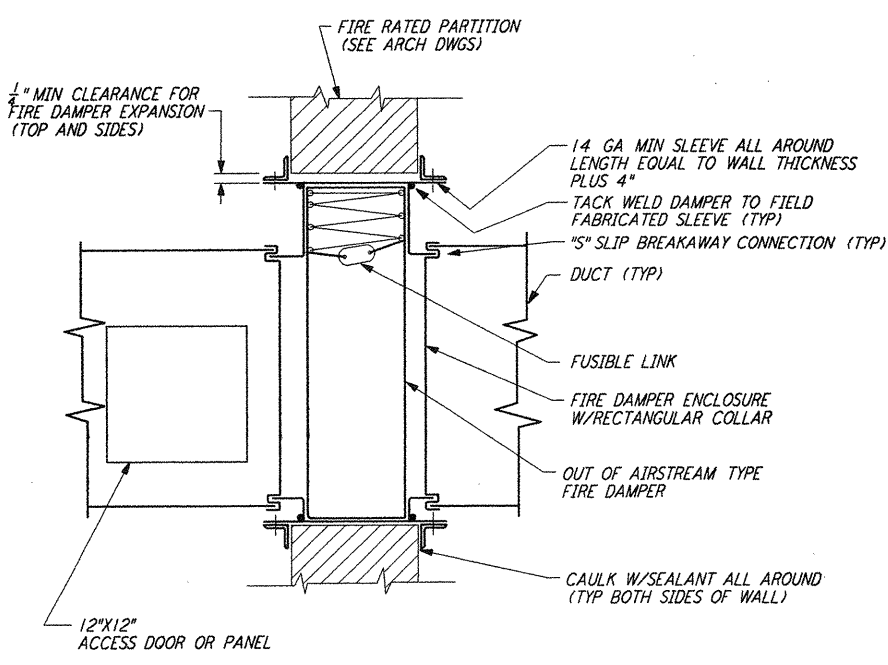


RECTANGULAR DUCT FIRE DAMPER (2) REF  
 NTS WA-H-411

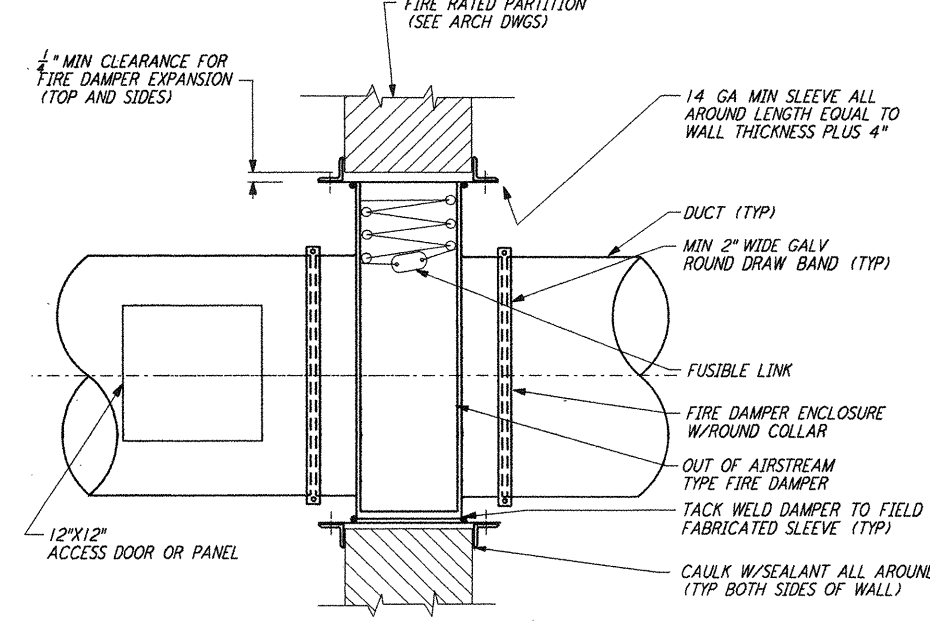


ROUND DUCT FIRE DAMPER MOUNTING DETAIL (3) REF  
 NTS WA-H-411

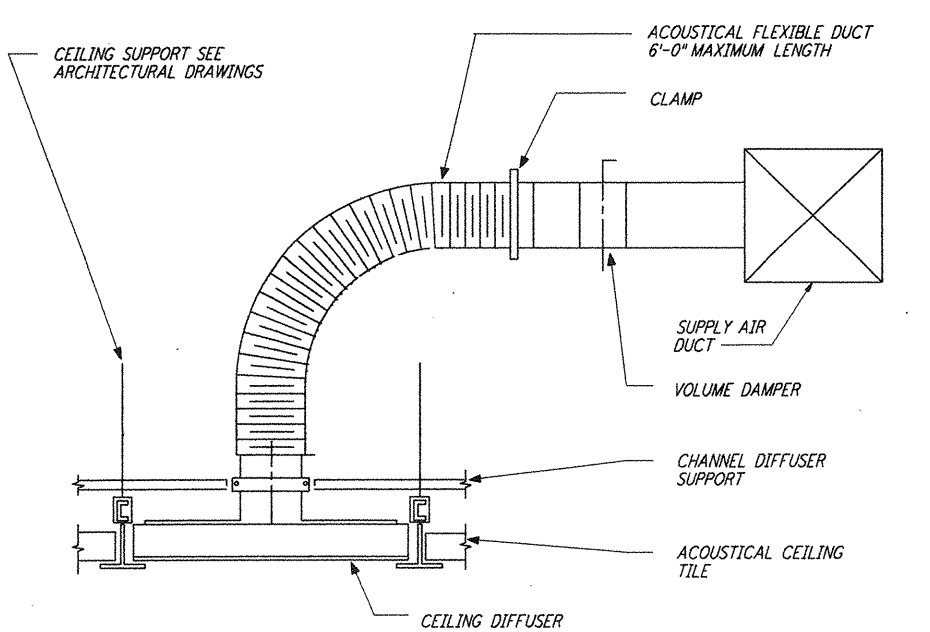


FLEXIBLE DUCT CONNECTION (4) REF  
 NTS WA-H-411

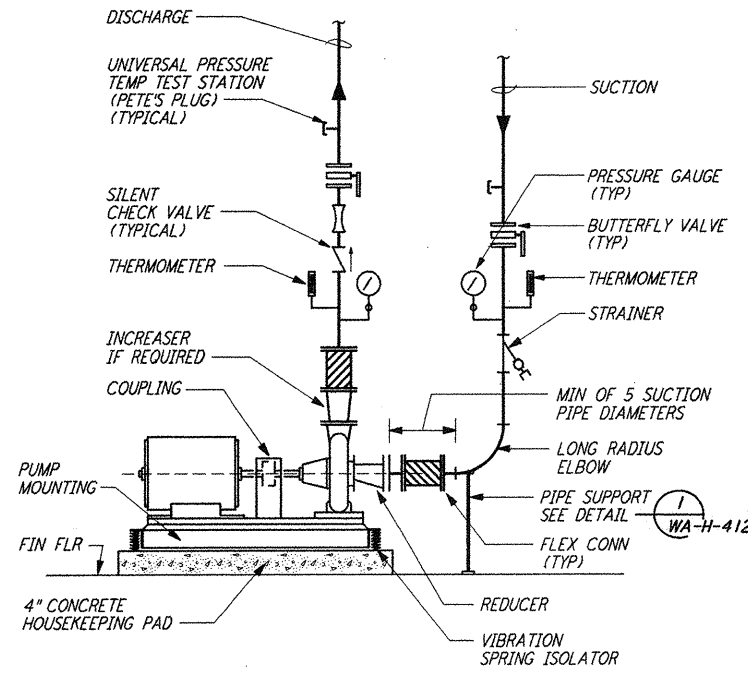


PUMP CONNECTION DETAIL (5) REF  
 NTS WA-H-411

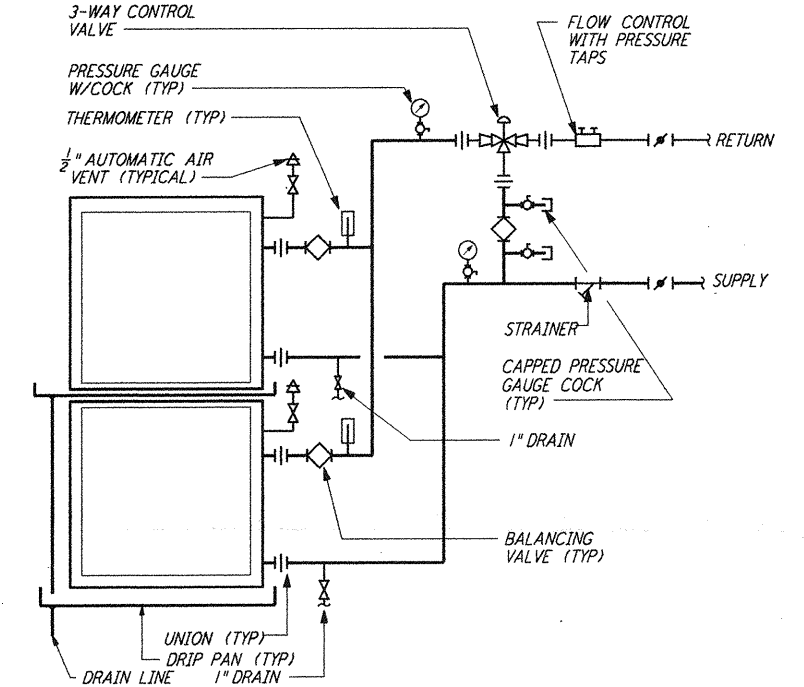


MULTIPLE COIL PIPING DETAIL (6) REF  
 NTS WA-H-411

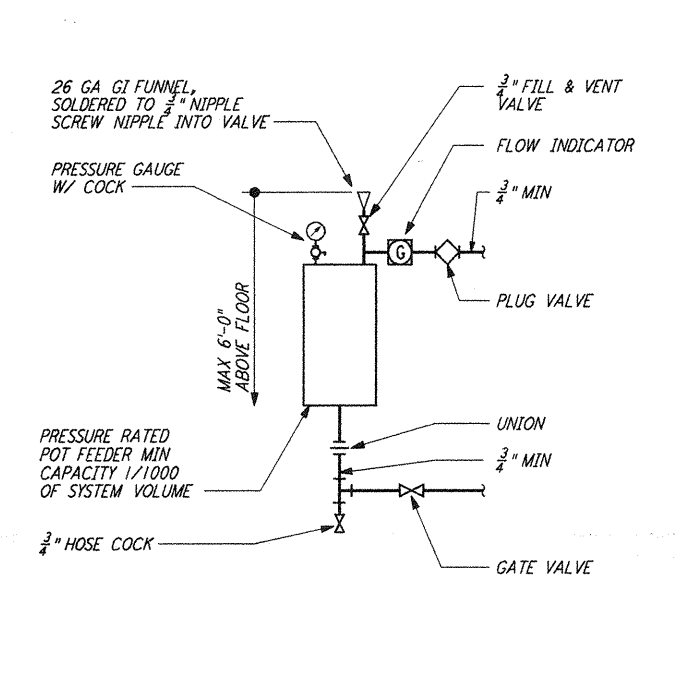


CHEMICAL FEEDER DETAIL (7) REF  
 NTS WA-H-411

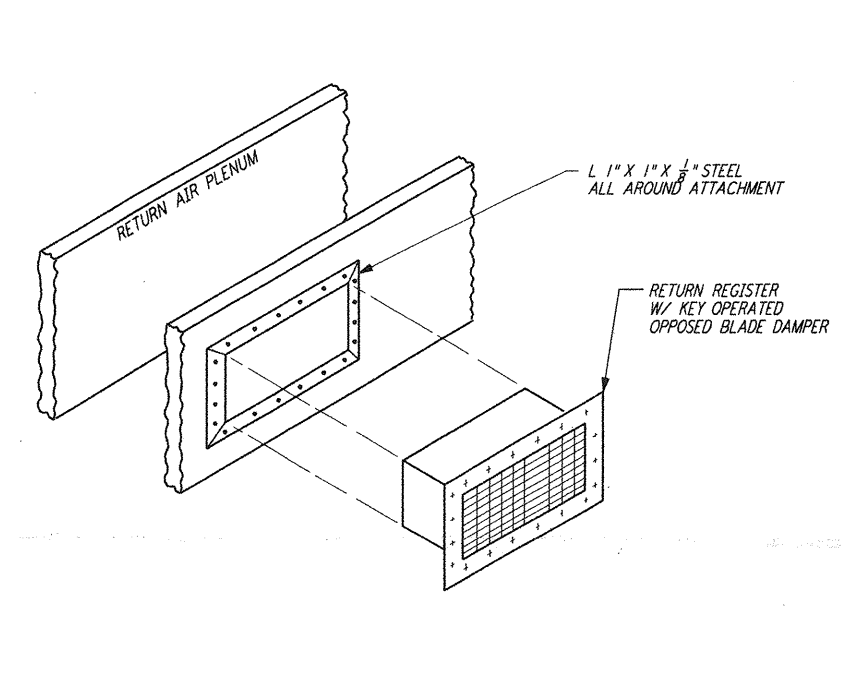


REGISTER MOUNTING DETAIL (8) REF  
 NTS WA-H-411

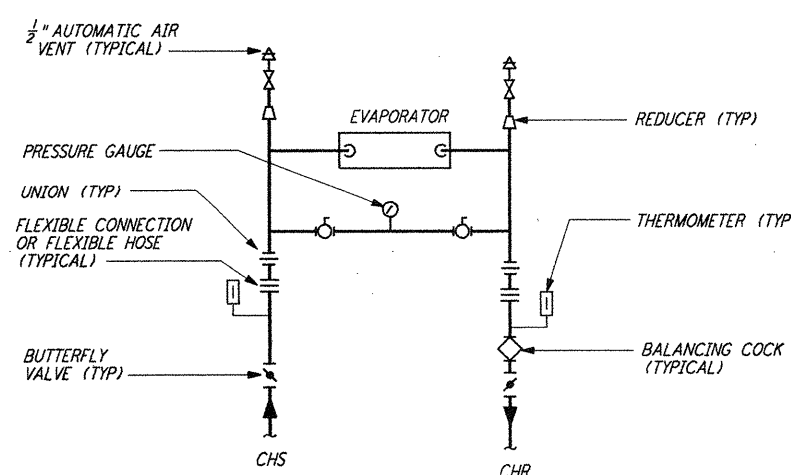

WATER CHILLER CONNECTION (9) REF  
 NTS WA-H-411

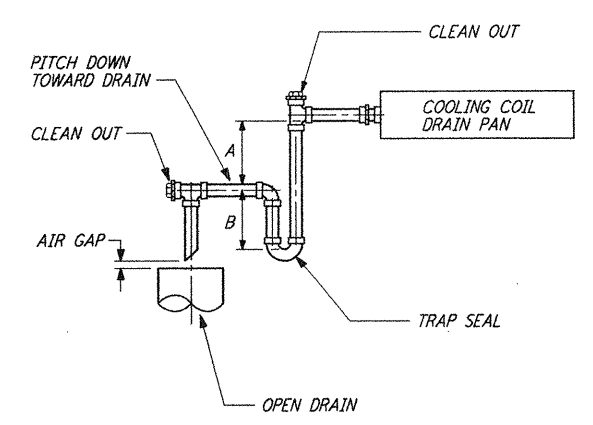

CONDENSATE DRAIN DETAIL (10) REF  
 NTS WA-H-411

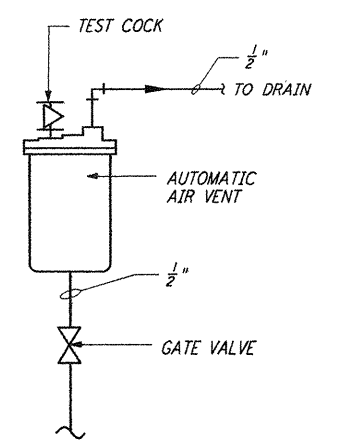

AUTOMATIC AIR VENT (11) REF  
 NTS WA-H-411

NOTES:  
 1. FOR LEGEND, ABBREVIATIONS AND GENERAL NOTES SEE SHEETS WA-H-001 AND WA-H-002.

This document and the design it covers are the property of PARSONS. They are loaned only with the borrower's expressed written agreement that they will not be reproduced, copied, loaned, exhibited, or used in any other way, except by written consent from PARSONS to the borrower.

NO.	DATE	BY	CHKD	ENGR	PROJ	DESCRIPTION
1	5-15-98	CP	AA	AA	PR	ISSUED FOR AS-BUILT

ISSUED FOR CONSTRUCTION			
DRAWN	CLP	6-24-96	
CHECKED	ME	7/3/96	
ENGINEER	AA	7/3/96	
PROJ	MDW	ZBBLG	

**AS-BUILT DRAWINGS**

**PARSONS**  
 100 WEST WALNUT STREET  
 PASADENA, CALIFORNIA

**LIGO**  
 CALIFORNIA INSTITUTE OF TECHNOLOGY  
 MASSACHUSETTS INSTITUTE OF TECHNOLOGY

**LIGO-D960370-01-O**  
 LASER INTERFEROMETER  
 GRAVITATIONAL-WAVE OBSERVATORY  
 SITE NO. 1 - HANFORD, WASHINGTON

TITLE	SCALE	CONTRACT NUMBER	PROJECT NUMBER
HVAC DETAILS SHEET 1	NONE	PP150969	8094
SHEET NUMBER		REVISIONS	
<b>WA-H-411</b>			