




WALL MOUNTED FIRE DAMPER (1) REF
 NTS WA-H-411

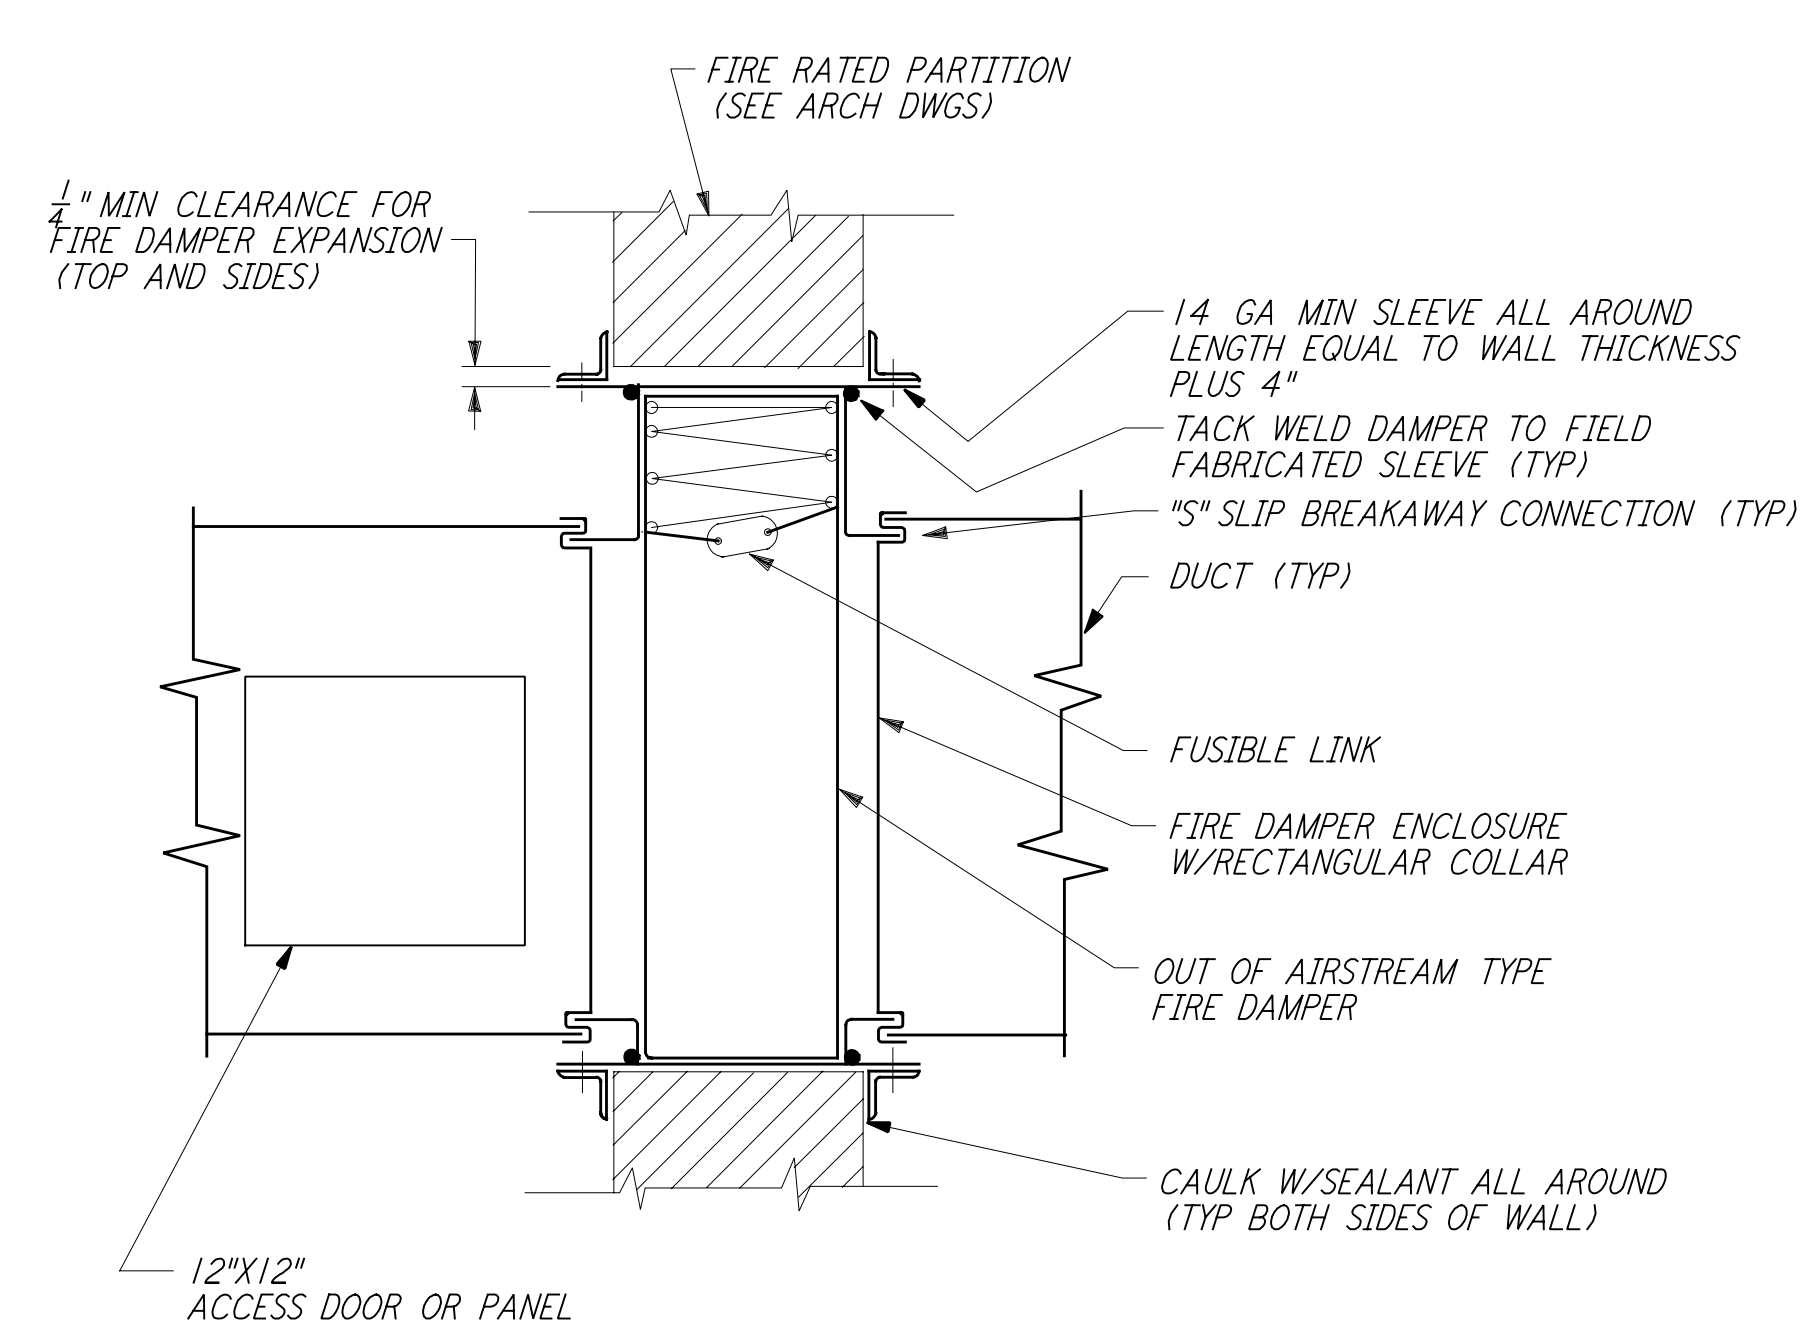


RECTANGULAR DUCT FIRE DAMPER (2) REF
 NTS WA-H-411

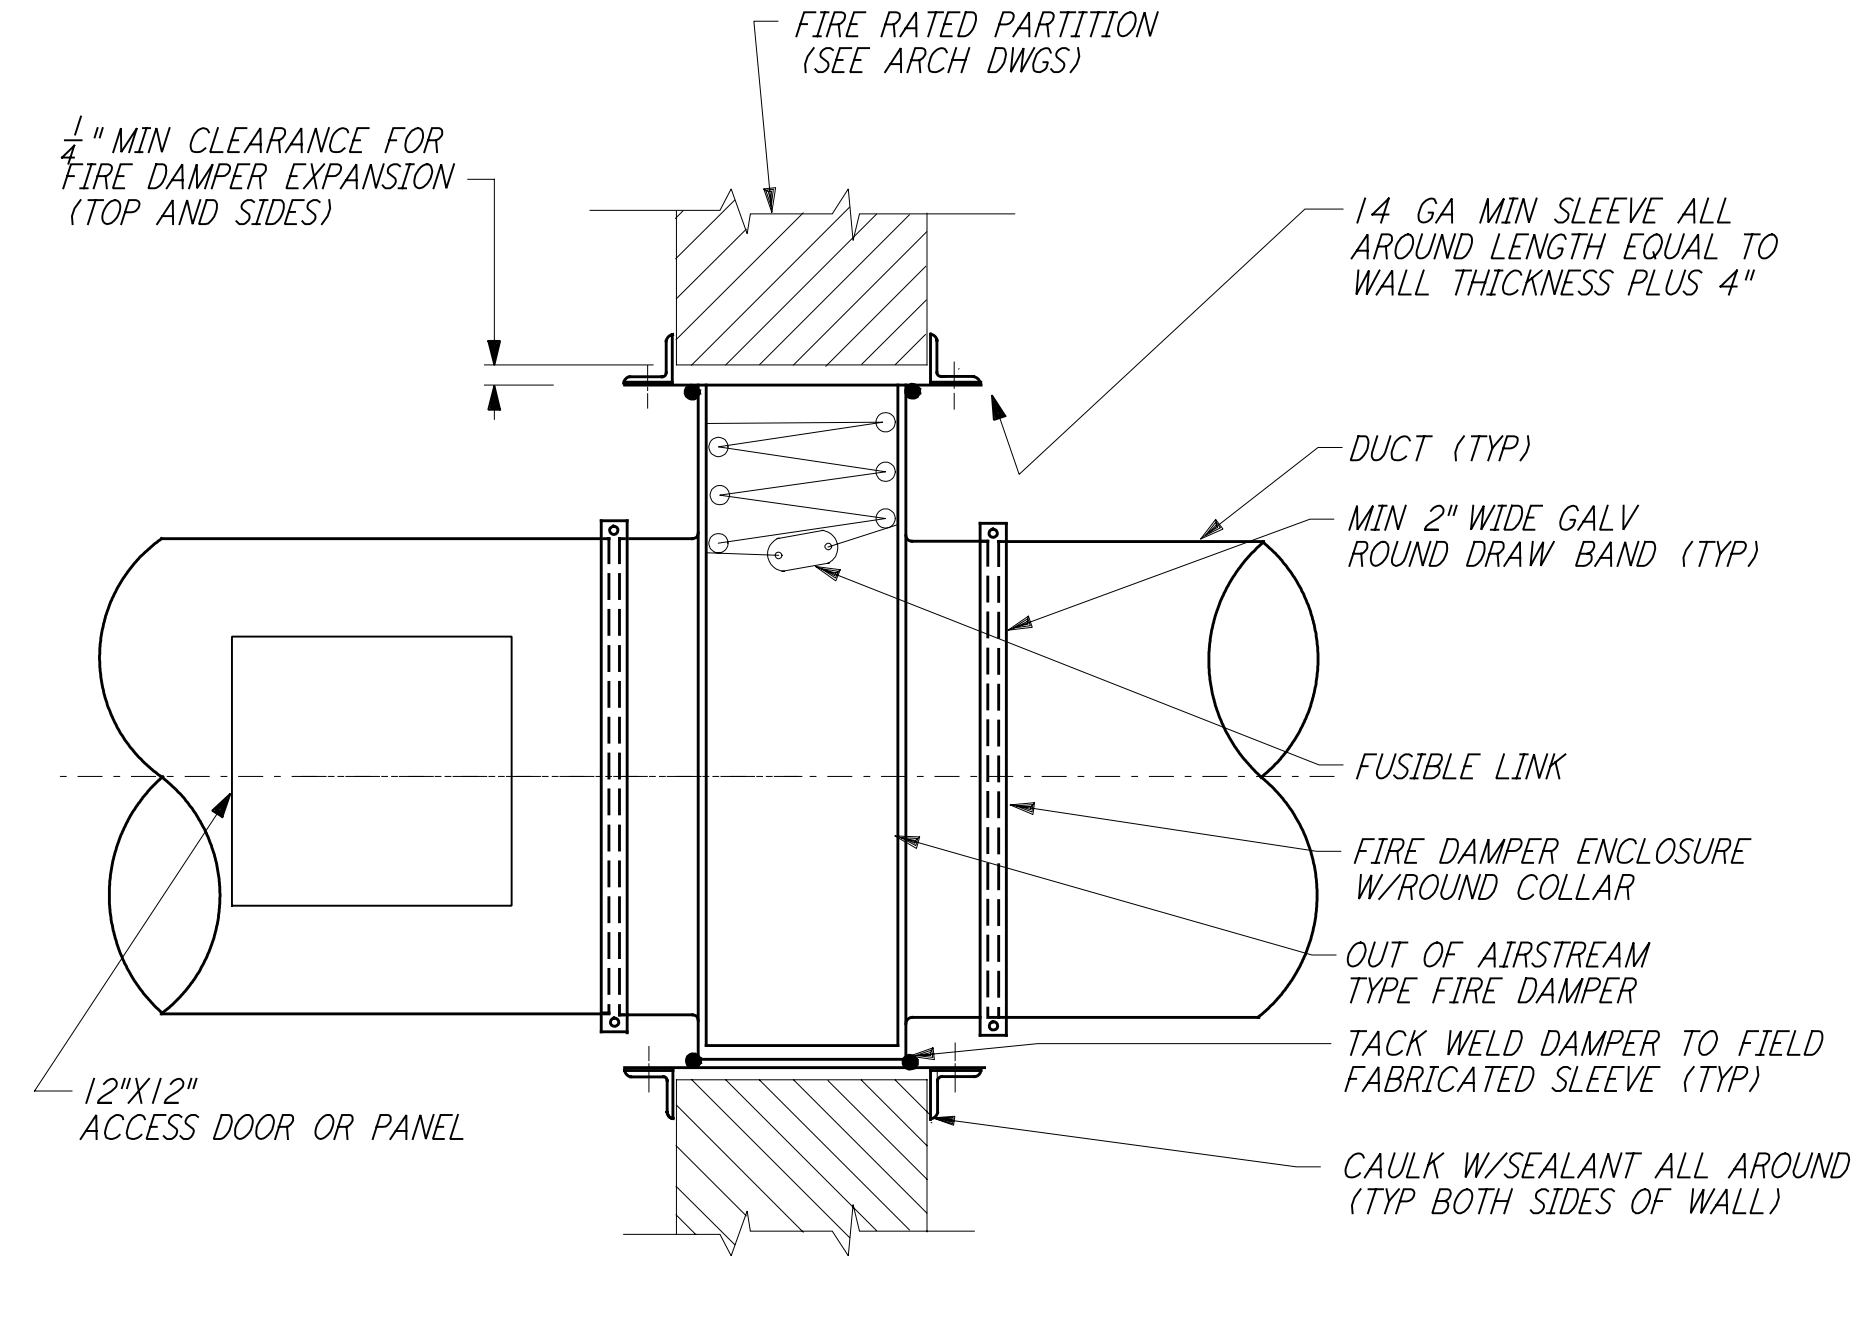


ROUND DUCT FIRE DAMPER MOUNTING DETAIL (3) REF
 NTS WA-H-411

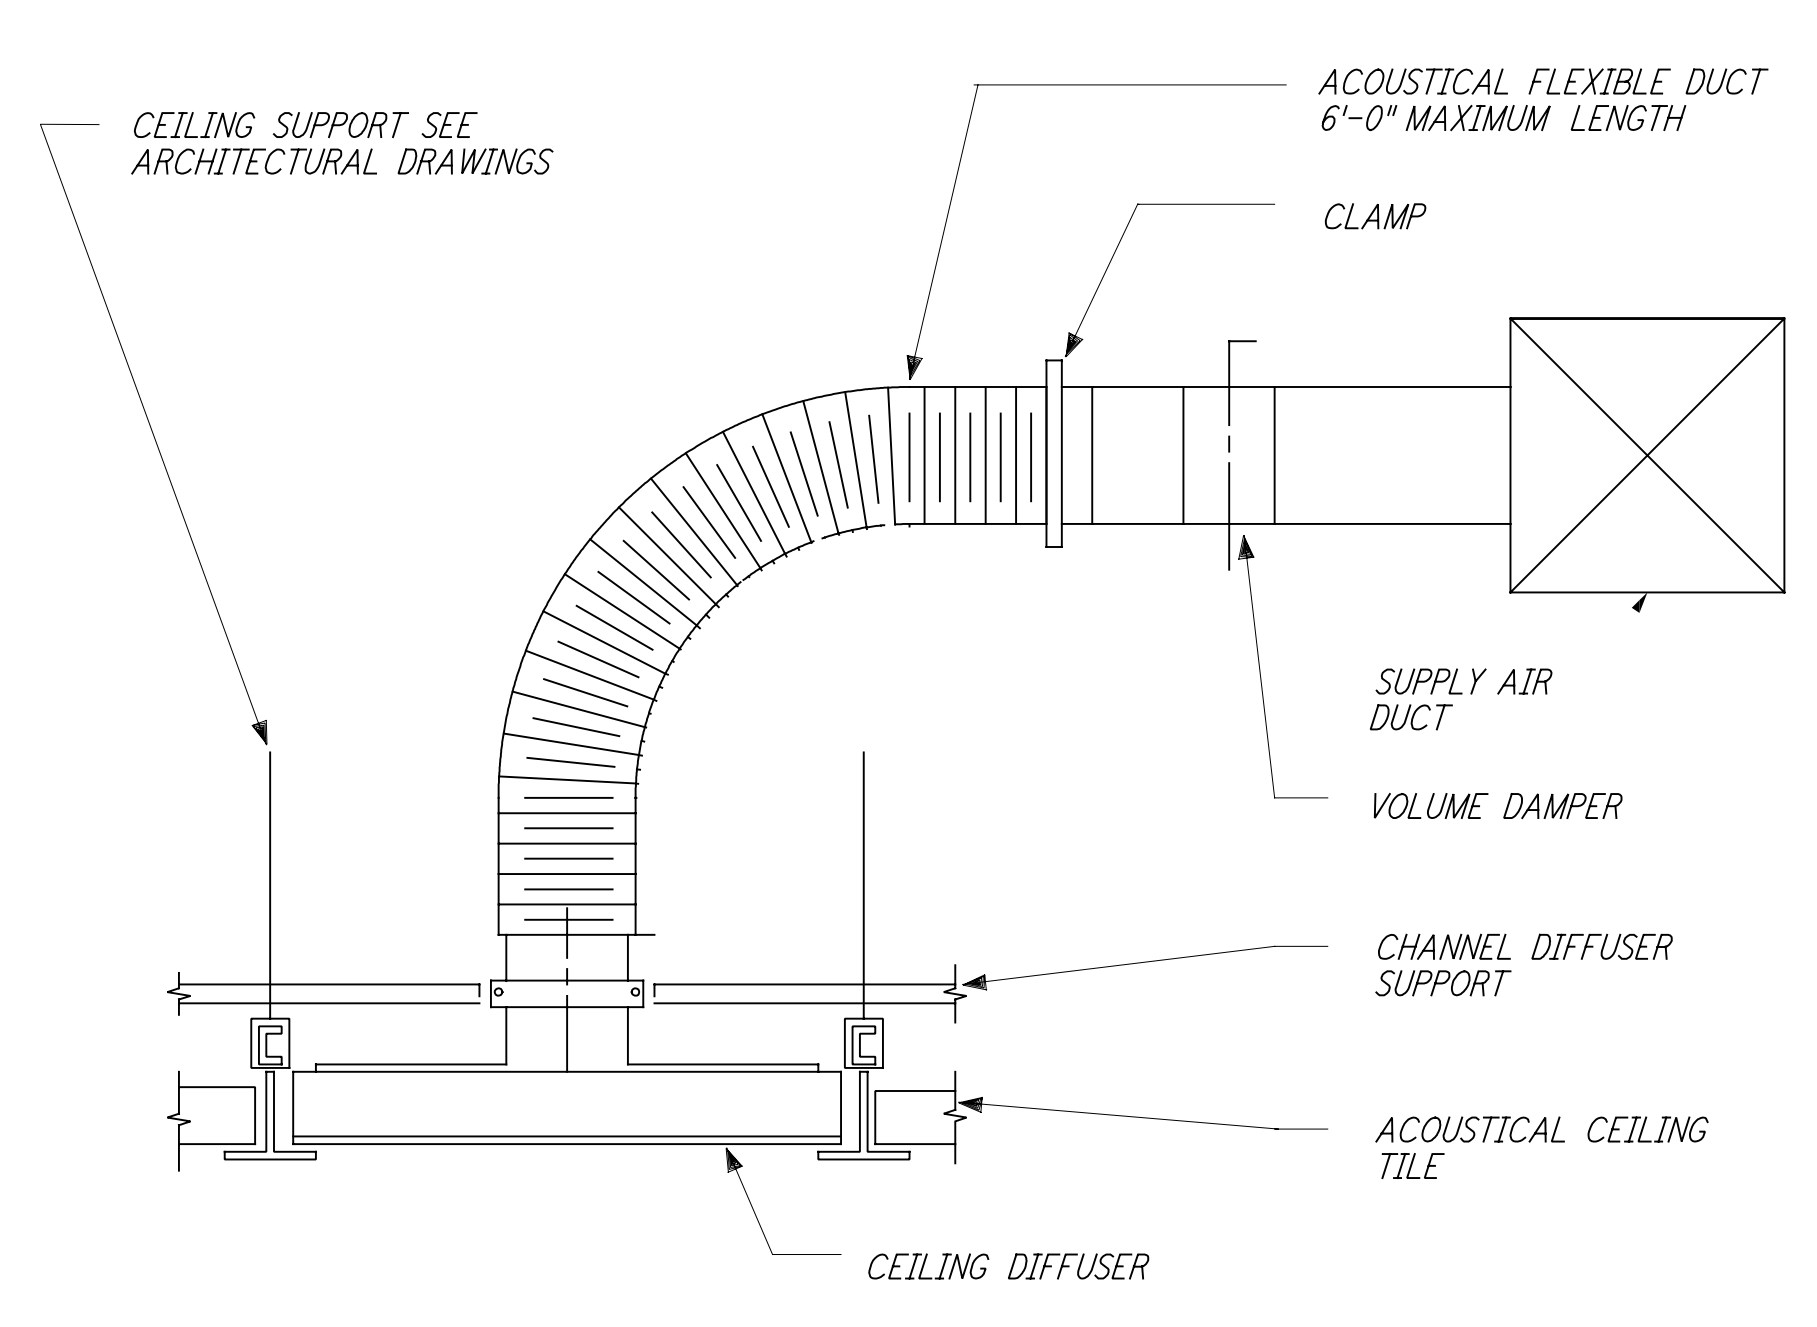


FLEXIBLE DUCT CONNECTION (4) REF
 NTS WA-H-411

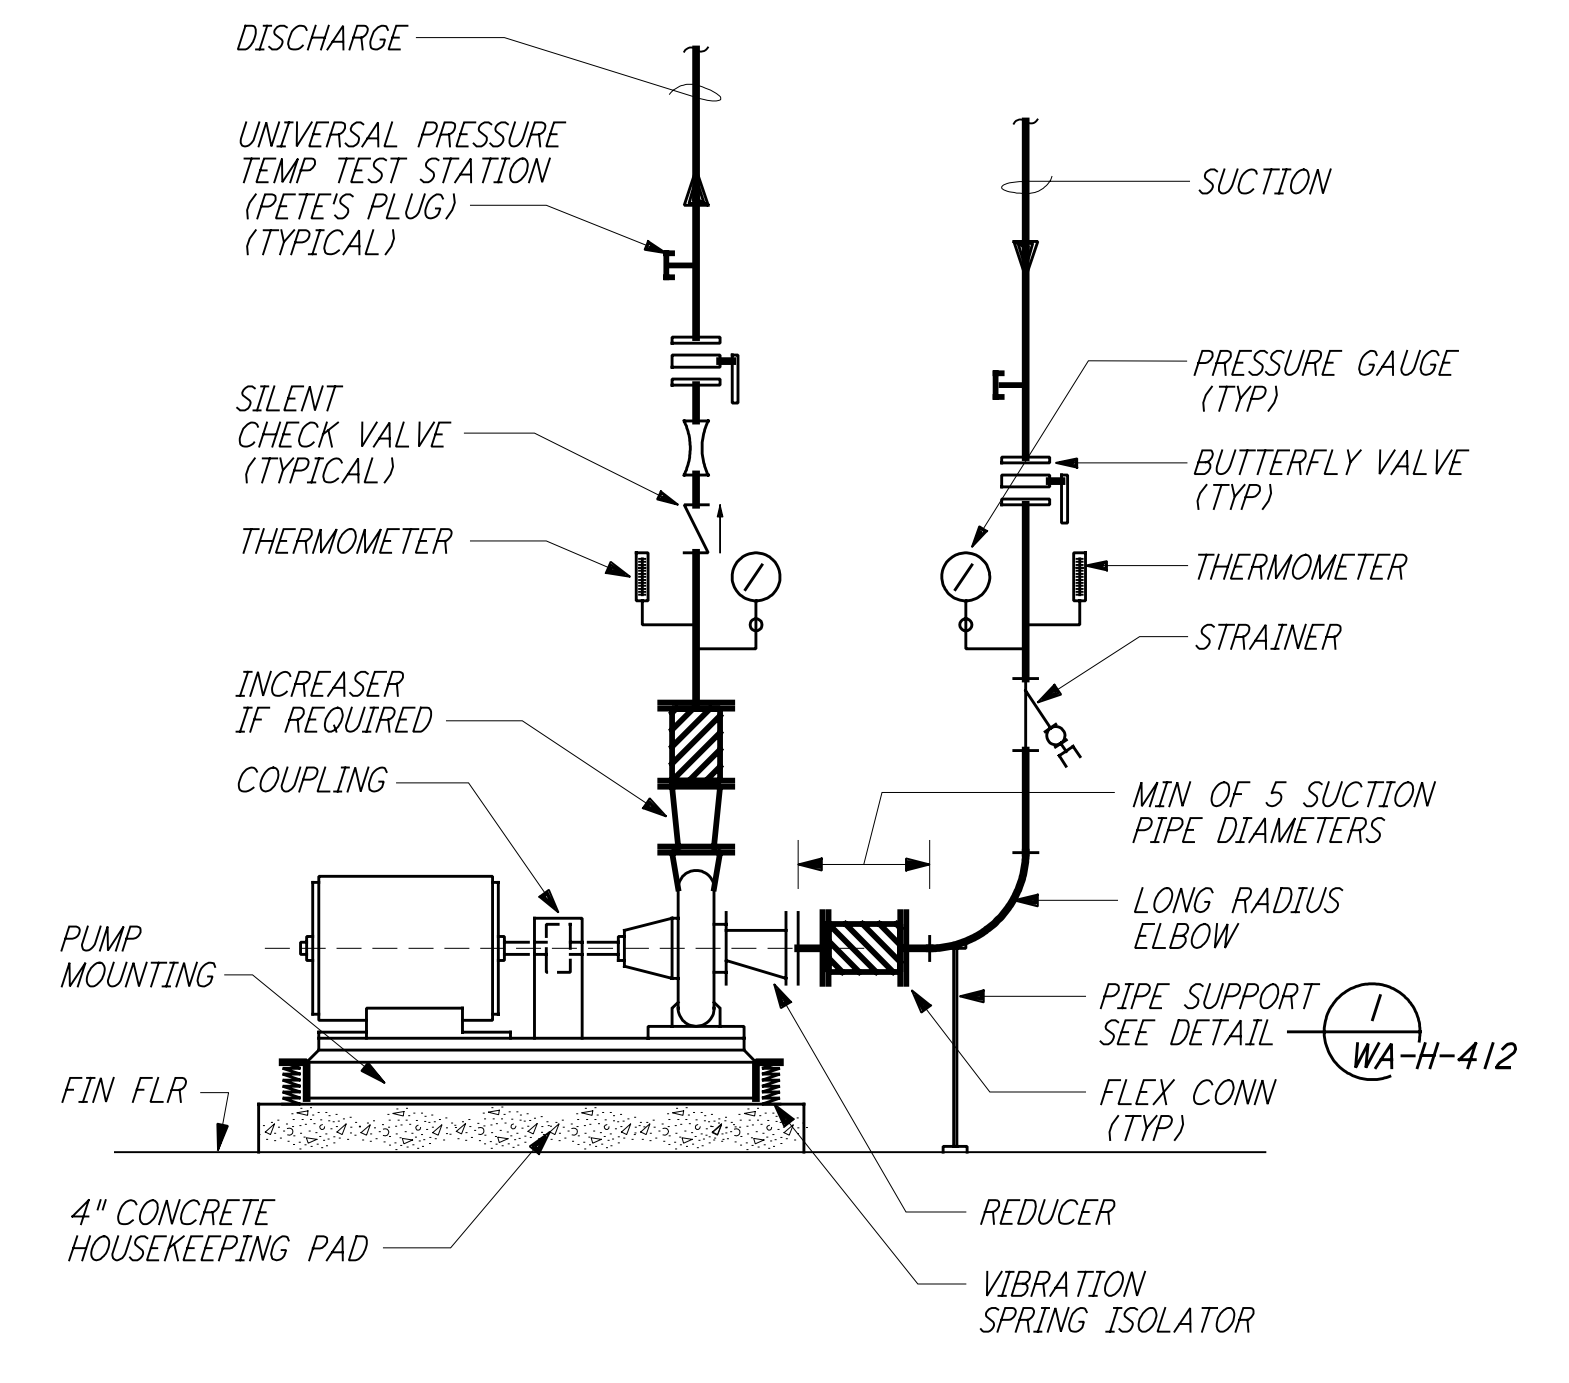


PUMP CONNECTION DETAIL (5) REF
 NTS WA-H-411

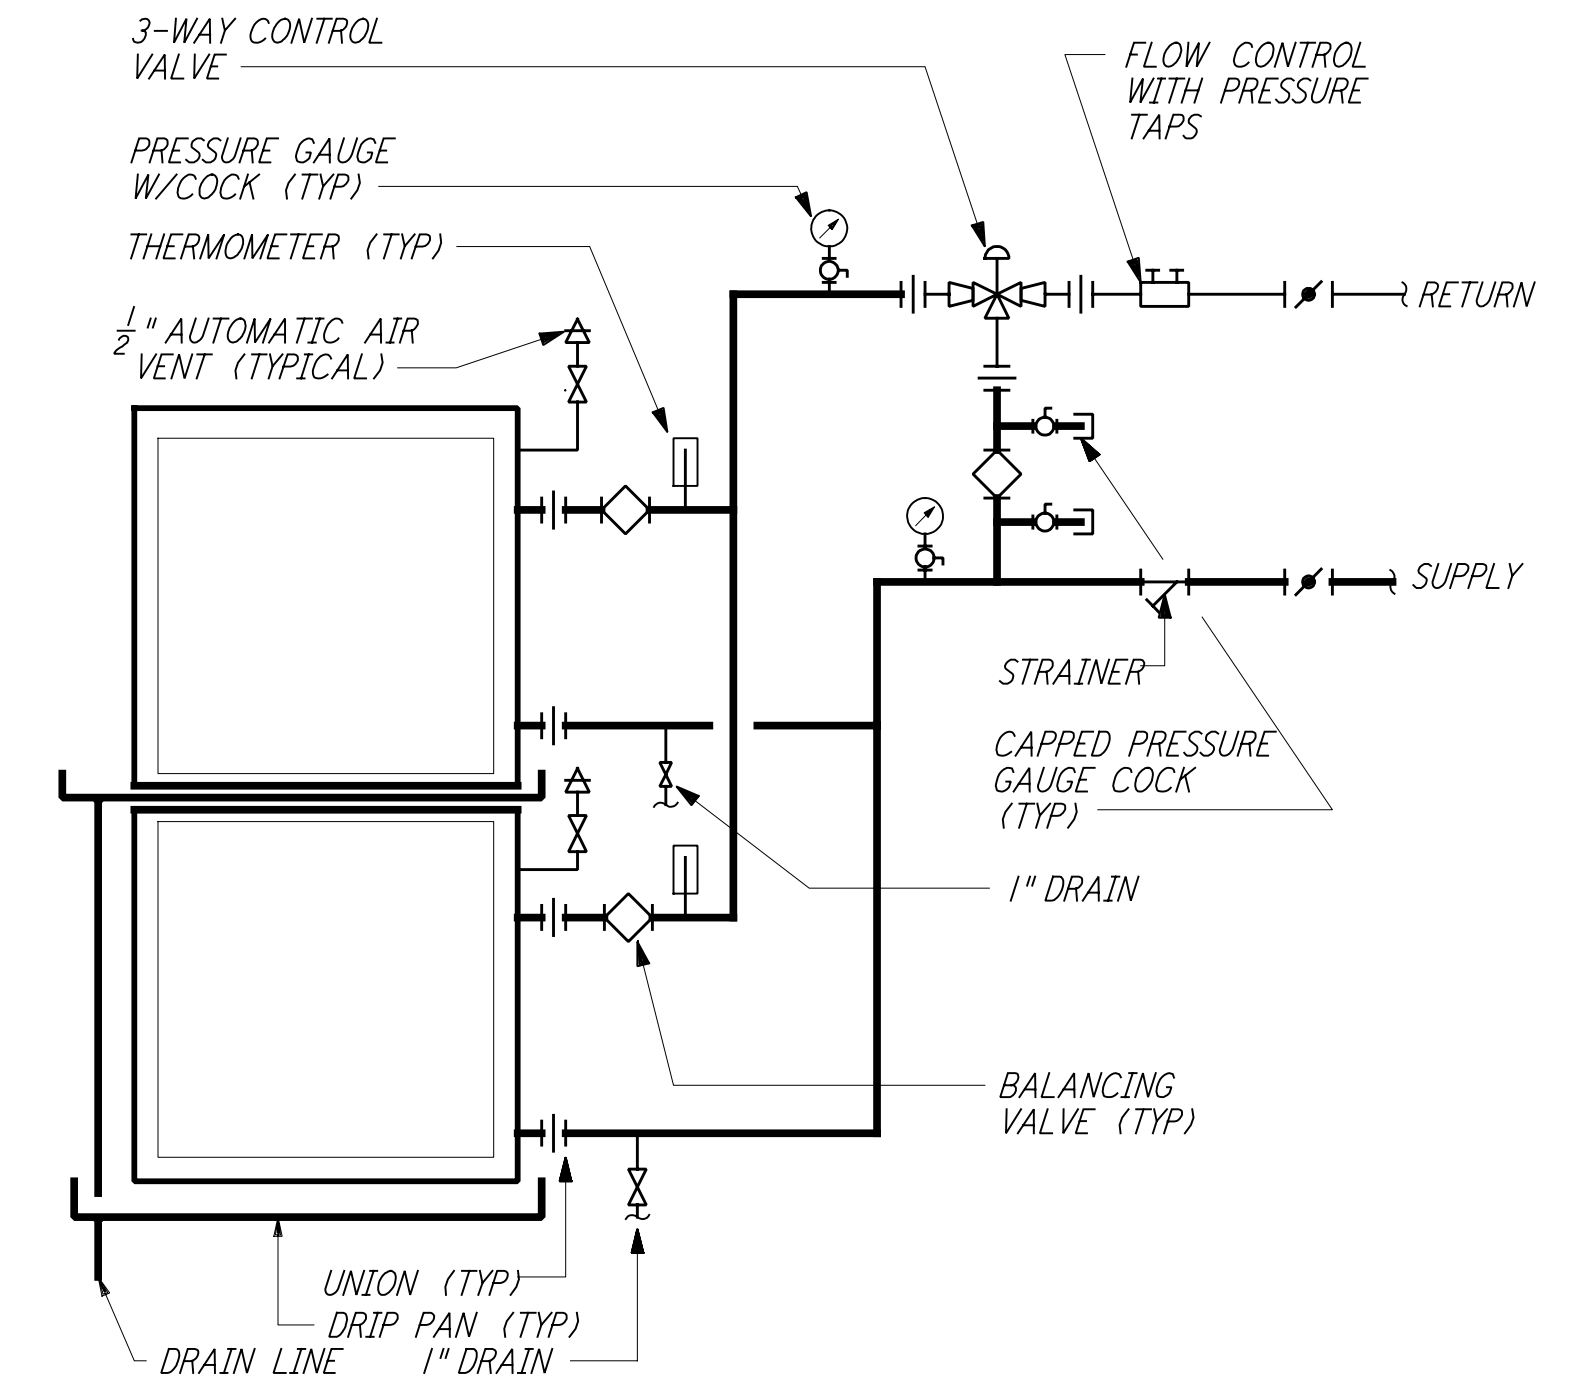


MULTIPLE COIL PIPING DETAIL (6) REF
 NTS WA-H-411

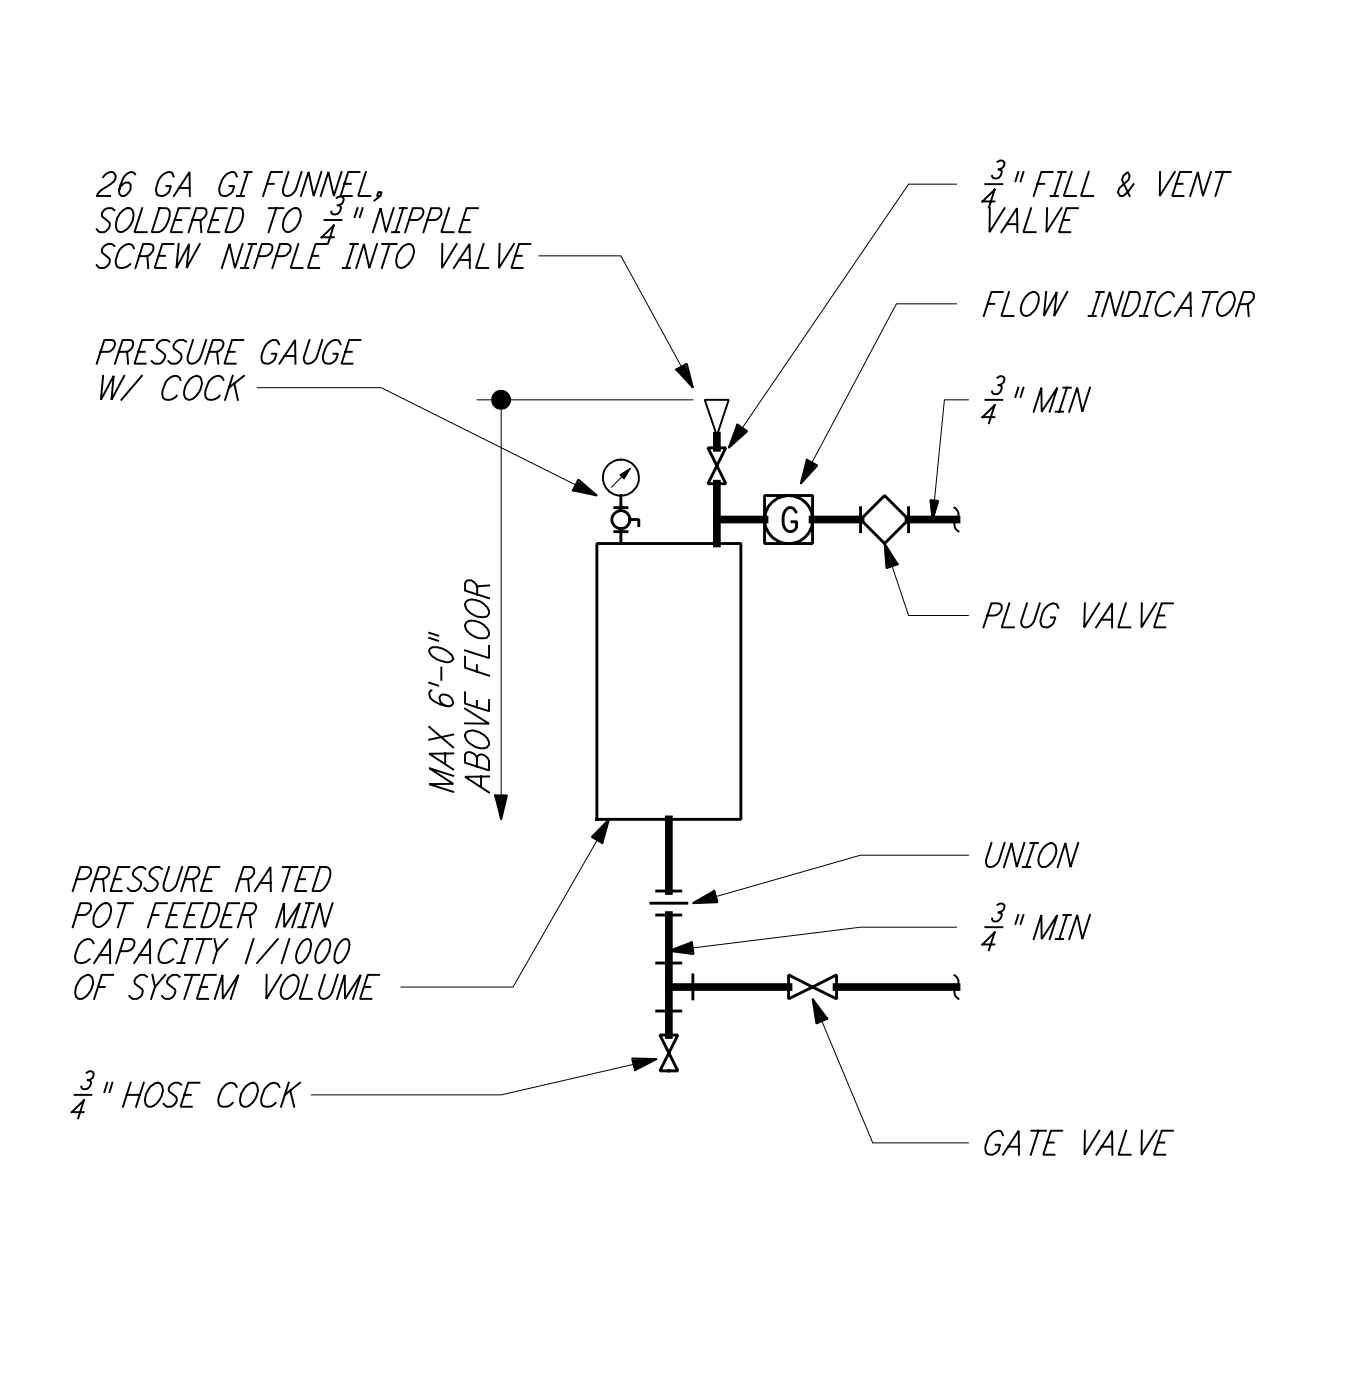


CHEMICAL FEEDER DETAIL (7) REF
 NTS WA-H-411

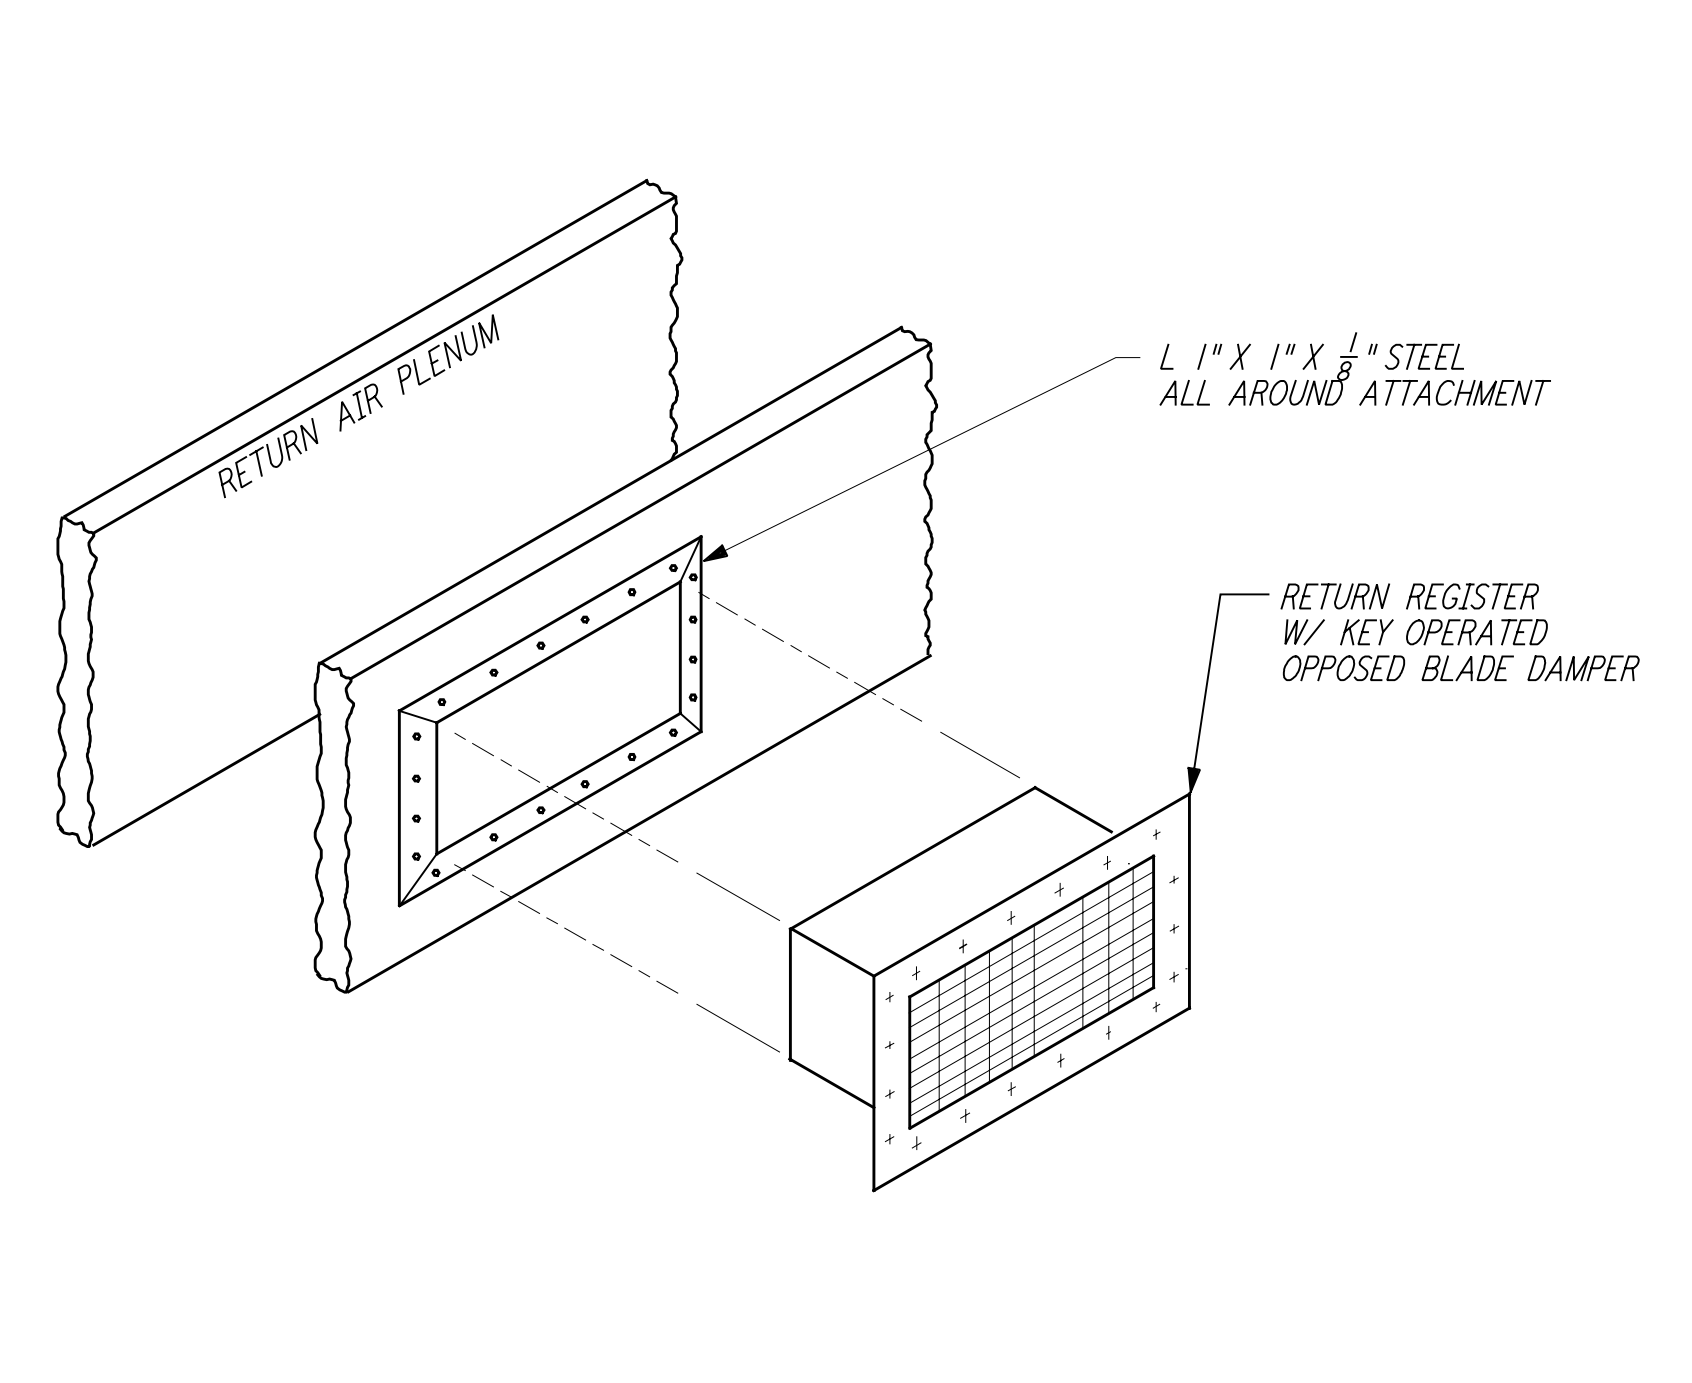


REGISTER MOUNTING DETAIL (8) REF
 NTS WA-H-411

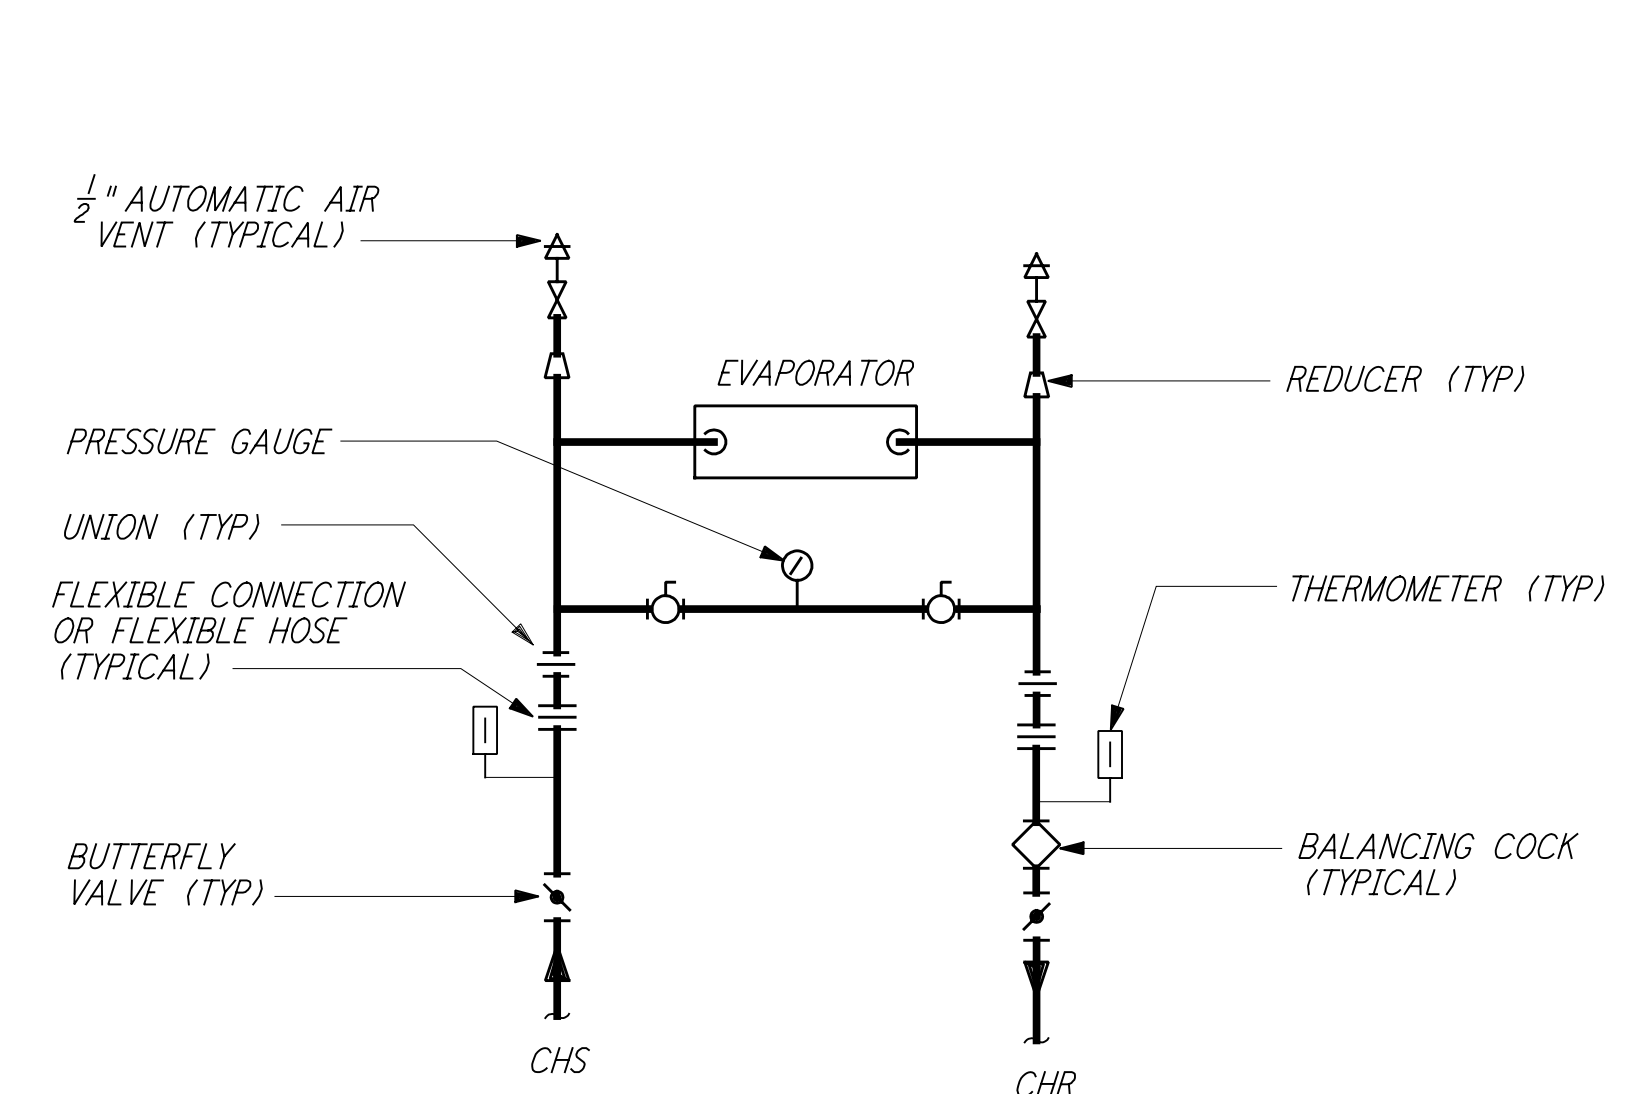

WATER CHILLER CONNECTION (9) REF
 NTS WA-H-411

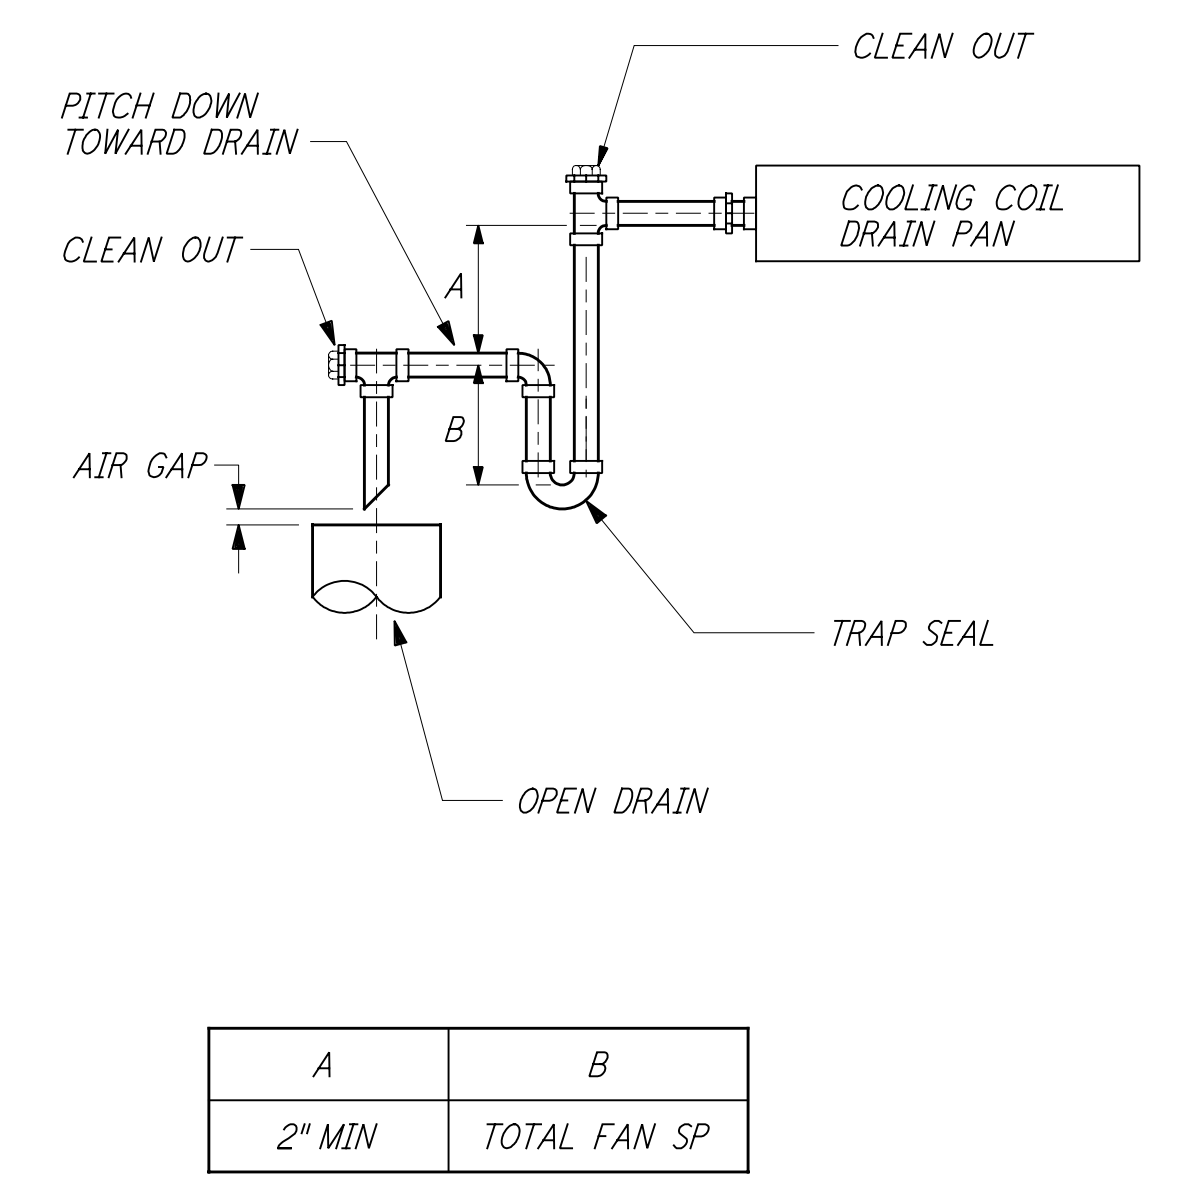

CONDENSATE DRAIN DETAIL (10) REF
 NTS WA-H-411

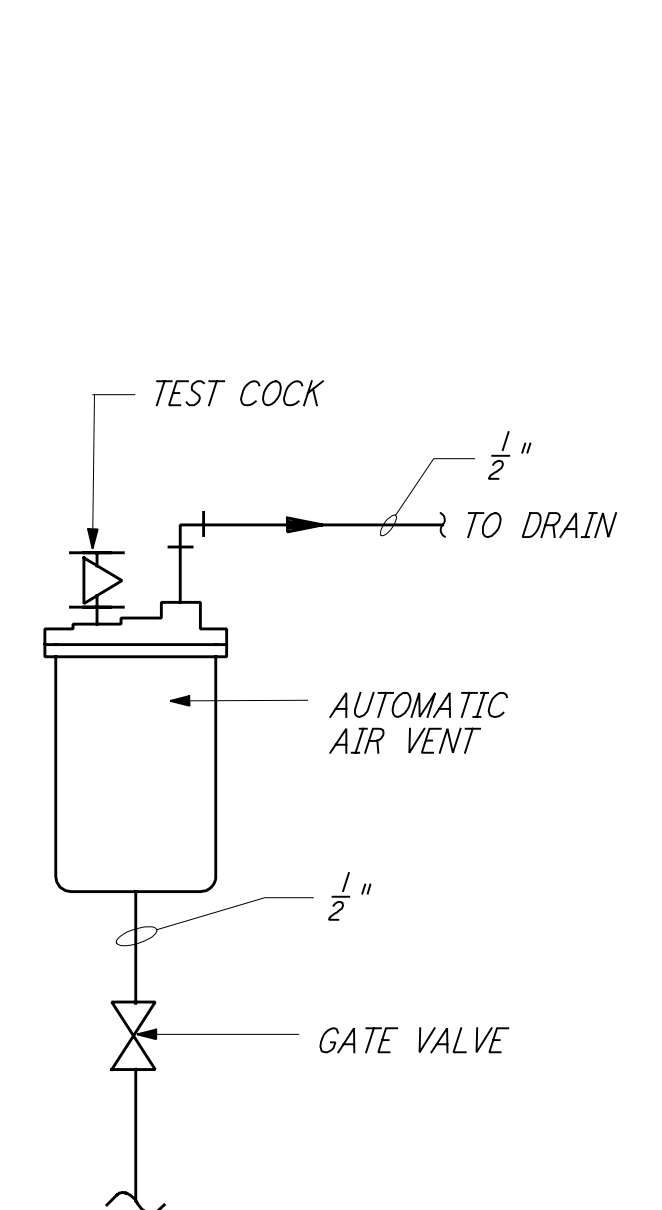

AUTOMATIC AIR VENT (11) REF
 NTS WA-H-411

NOTES:
 1. FOR LEGEND, ABBREVIATIONS AND GENERAL NOTES SEE SHEETS WA-H-001 AND WA-H-002.

LIGO-D960370-01-0

ISSUED FOR CONSTRUCTION	CLP	6-24-96
DRAWN		
CHECKED		
ENGINEER		
PROJ		
AS-BUILT DRAWINGS		
ISSUED FOR AS-BUILT		
DRAWING NO.	DESCRIPTION	NO. DATE BY CHKO ENGR PROJ DESCRIPTION
		1 5-15-98 CP

100 WEST WALNUT STREET
 PASADENA, CALIFORNIA

PARSONS

LIGO
 CALIFORNIA INSTITUTE OF TECHNOLOGY
 MASSACHUSETTS INSTITUTE OF TECHNOLOGY

LASER INTERFEROMETER GRAVITATIONAL-WAVE OBSERVATORY SITE NO. 1 - HANFORD, WASHINGTON		
TITLE	SHEET NUMBER	PROJECT NUMBER
HVAC DETAILS SHEET I	NONE	PP150969 8094
WA-H-411		REVISIONS

This document and the design it covers are the property of PARSONS. They are loaned only with the borrower's expressed written agreement that they will not be reproduced, copied, loaned, exhibited, or used in any other way, except by written consent from PARSONS to the borrower.