




**SCHEMATIC & WIRING DIAGRAM SYMBOLS**

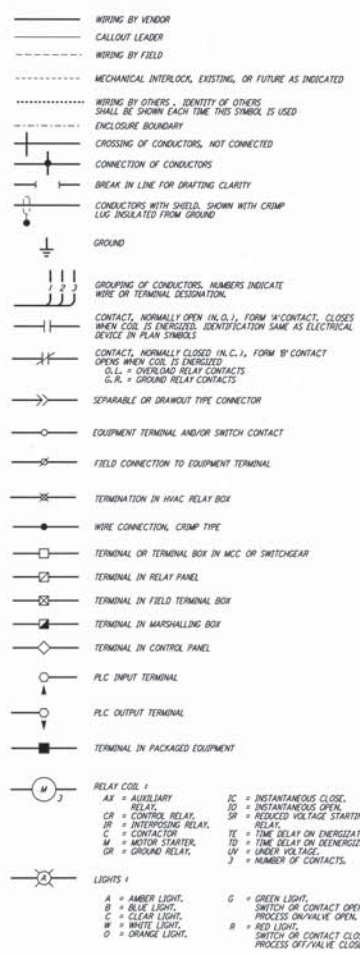

**SCHEMATIC & WIRING DIAGRAM SYMBOLS**

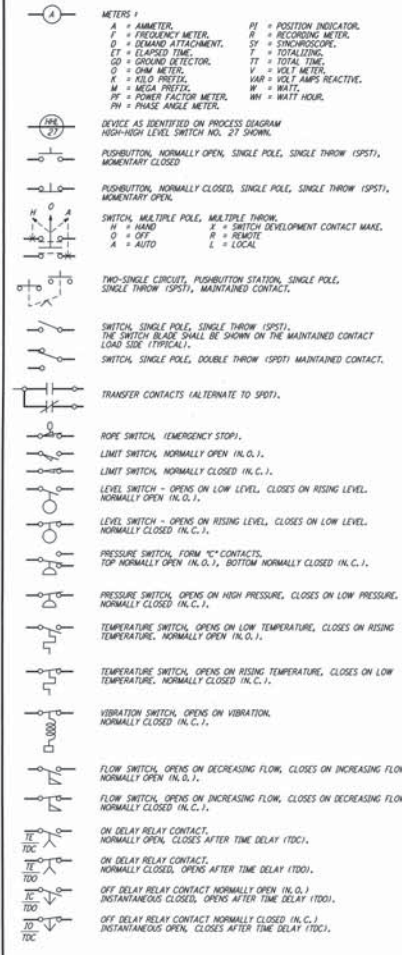

**SCHEMATIC & WIRING DIAGRAM SYMBOLS**

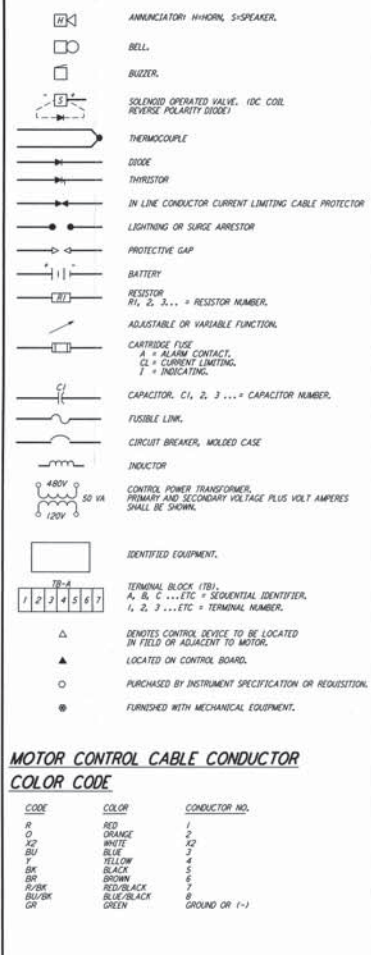

REF ID	DESCRIPTION
WA-E-001	ABBREVIATIONS & ACRONYMS
WA-E-002	STANDARD PLAN SYMBOLS
WA-E-004	ONE/THREE LINE DIAGRAM SYMBOLS

NO.	DATE	BY	CHKD	ENGR	PROJ	ISSUED FOR AS-BUILT
1	8-15-98	J.G.	TC	TC		ISSUED FOR AS-BUILT

AS-BUILT DRAWINGS

ISSUED FOR CONSTRUCTION  
 DRAWN M.M. 8-25-98  
 CHECKED J.T.S. 7-3-98  
 ENGINEER K.P. 7-3-98  
 PROJ. M.G.W. 7-8-98

**PARSONS**  
 100 WEST WALNUT STREET  
 PASADENA, CALIFORNIA

**LIGO**  
 CALIFORNIA INSTITUTE OF TECHNOLOGY  
 MASSACHUSETTS INSTITUTE OF TECHNOLOGY

**LASER INTERFEROMETER  
 GRAVITATIONAL-WAVE OBSERVATORY  
 SITE NO. 1 - HANFORD, WASHINGTON**

TITLE: ELECTRICAL STANDARD SCHEMATIC & WIRING DIAGRAMS SYMBOLS  
 NONE  
 PPI50969 8094  
**WA-E-003**

This document and the design it covers are the property of PARSONS. It is to be used only for the project and for the purposes specified therein. It is not to be reproduced, copied, loaned, exhibited, or used in any way without the written consent of PARSONS.

Thu Jul 09 13:09:02 1998 C:\PLOT\G:\L31\T882200\52805 K:\L31\G85\44803.dwg