
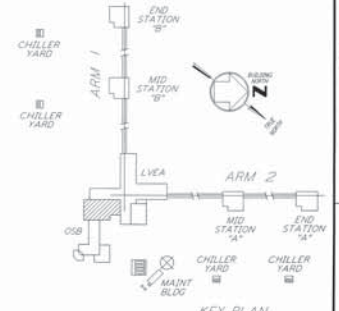


NOTES:

1. FOR NOTES AND REFERENCE DRAWINGS SEE DWG. WA-E-107.
2. ALL CIRCUITS SHOWN ON THIS DRAWING ARE FROM PANEL W-CS-163-LP-01 UNLESS NOTED OTHERWISE.
3. CIRCUIT SHOWN FEEDING THESE LIGHTING FIXTURES IS FROM W-CS-163-RP-01.
4. CIRCUIT SHOWN FEEDING THESE LIGHTING FIXTURES IS FROM W-CS-168-RP-01.
5. FOR ALL PANEL FEEDER CONDUIT AND WIRE SIZES SEE SINGLE LINE DIAGRAM DWG WA-E-500.

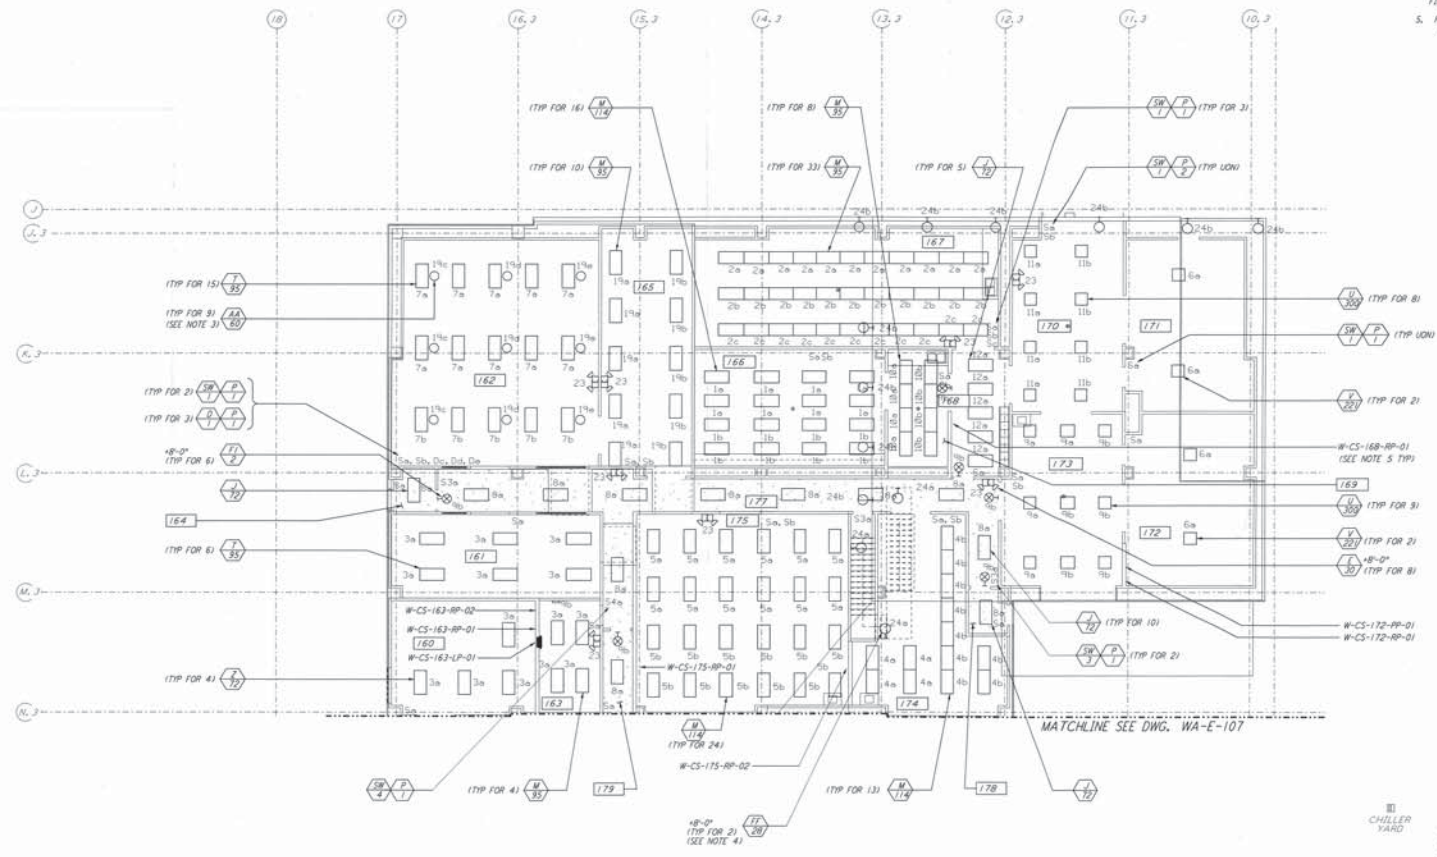

LIGO-D960397-02-0

LASER INTERFEROMETER
 GRAVITATIONAL-WAVE OBSERVATORY
 SITE NO. 1 - HANFORD, WASHINGTON

TITLE: **ELECTRICAL CORNER STATION OSB LAB AREA LIGHTING PLAN**
 AS NOTED PPI50969 8094
WA-E-108

This document and the design it covers are the property of PARSONS. It is to be used only for the project and site for which it was prepared. It is not to be reproduced, copied, loaned, exhibited, or used in any way without the written consent of PARSONS.

| NO. | DATE | BY | CHKD | ENGR | PRJL | DESCRIPTION |
|-----|---------|------|------|------|------|---------------------|
| 2 | 8-15-98 | J.G. | M. | PP | PP | ISSUED FOR AS-BUILT |
| 1 | 3-21-97 | J.G. | K.P. | K.R. | TDM | GENERAL REVISIONS |

| AS-BUILT DRAWINGS | |
|-------------------------|-----------------|
| ISSUED FOR CONSTRUCTION | |
| DRAWN | M. M. 6-25-96 |
| CHECKED | J. K. 7-3-96 |
| ENGINEER | K. R. 7-3-96 |
| PRJL | M. D. W. 7-8-96 |

PARSONS
 100 WEST WALNUT STREET
 PASADENA, CALIFORNIA

LIGO
 CALIFORNIA INSTITUTE OF TECHNOLOGY
 MASSACHUSETTS INSTITUTE OF TECHNOLOGY