


**NOTE:**  
 1. FOR SPECIFICATIONS SEE SPECIFICATION SECTION 16742 TELEPHONE AND DATA CABLE.

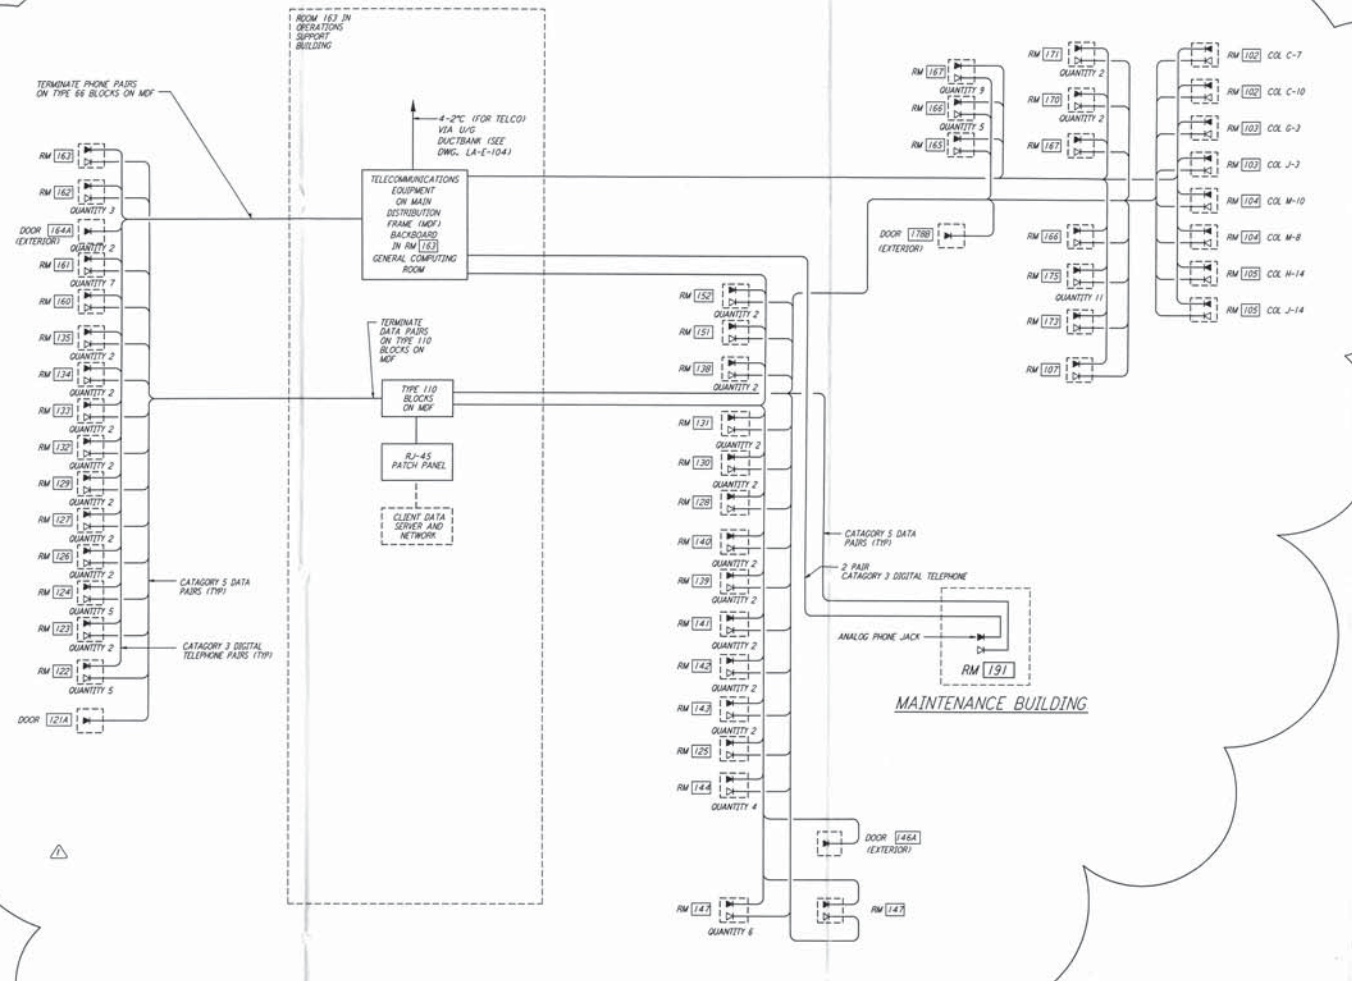

TELEPHONE, FACILITY DATA RISER DIAGRAM

This document and the design it covers are the property of PARSONS. They are loaned only with the borrower's expressed written agreement that they will not be reproduced, copied, loaned, exhibited, or used in any other way, except by written consent from PARSONS to the borrower.

REVISED FOR CONSTRUCTION	DATE	BY	CHKD	ENGR	PROJ	DESCRIPTION
DRAWN	M. M.	6-25-96				
CHECKED	J. K.	7-3-96				
ENGINEER	K. R.	7-3-96				
PROJ.	T. G. M.	7-9-96				



**PARSONS**  
 100 WEST WALNUT STREET  
 PASADENA, CALIFORNIA

**LIGO**  
 CALIFORNIA INSTITUTE OF TECHNOLOGY  
 MASSACHUSETTS INSTITUTE OF TECHNOLOGY

LASER INTERFEROMETER  
 GRAVITATIONAL-WAVE OBSERVATORY  
 SITE NO. 1 - HANFORD, WASHINGTON

ELECTRICAL CORNER STATION COMMUNICATIONS RISER DIAGRAM

WA-E-109

LIGO-D960398-01-0

Plot No. 24, REVISION 1, 5/17/97, KATLUD3\MARKES\MARKES\EB707P

Plot No. 24, REVISION 1, 5/17/97, KATLUD3\MARKES\MARKES\EB707P