

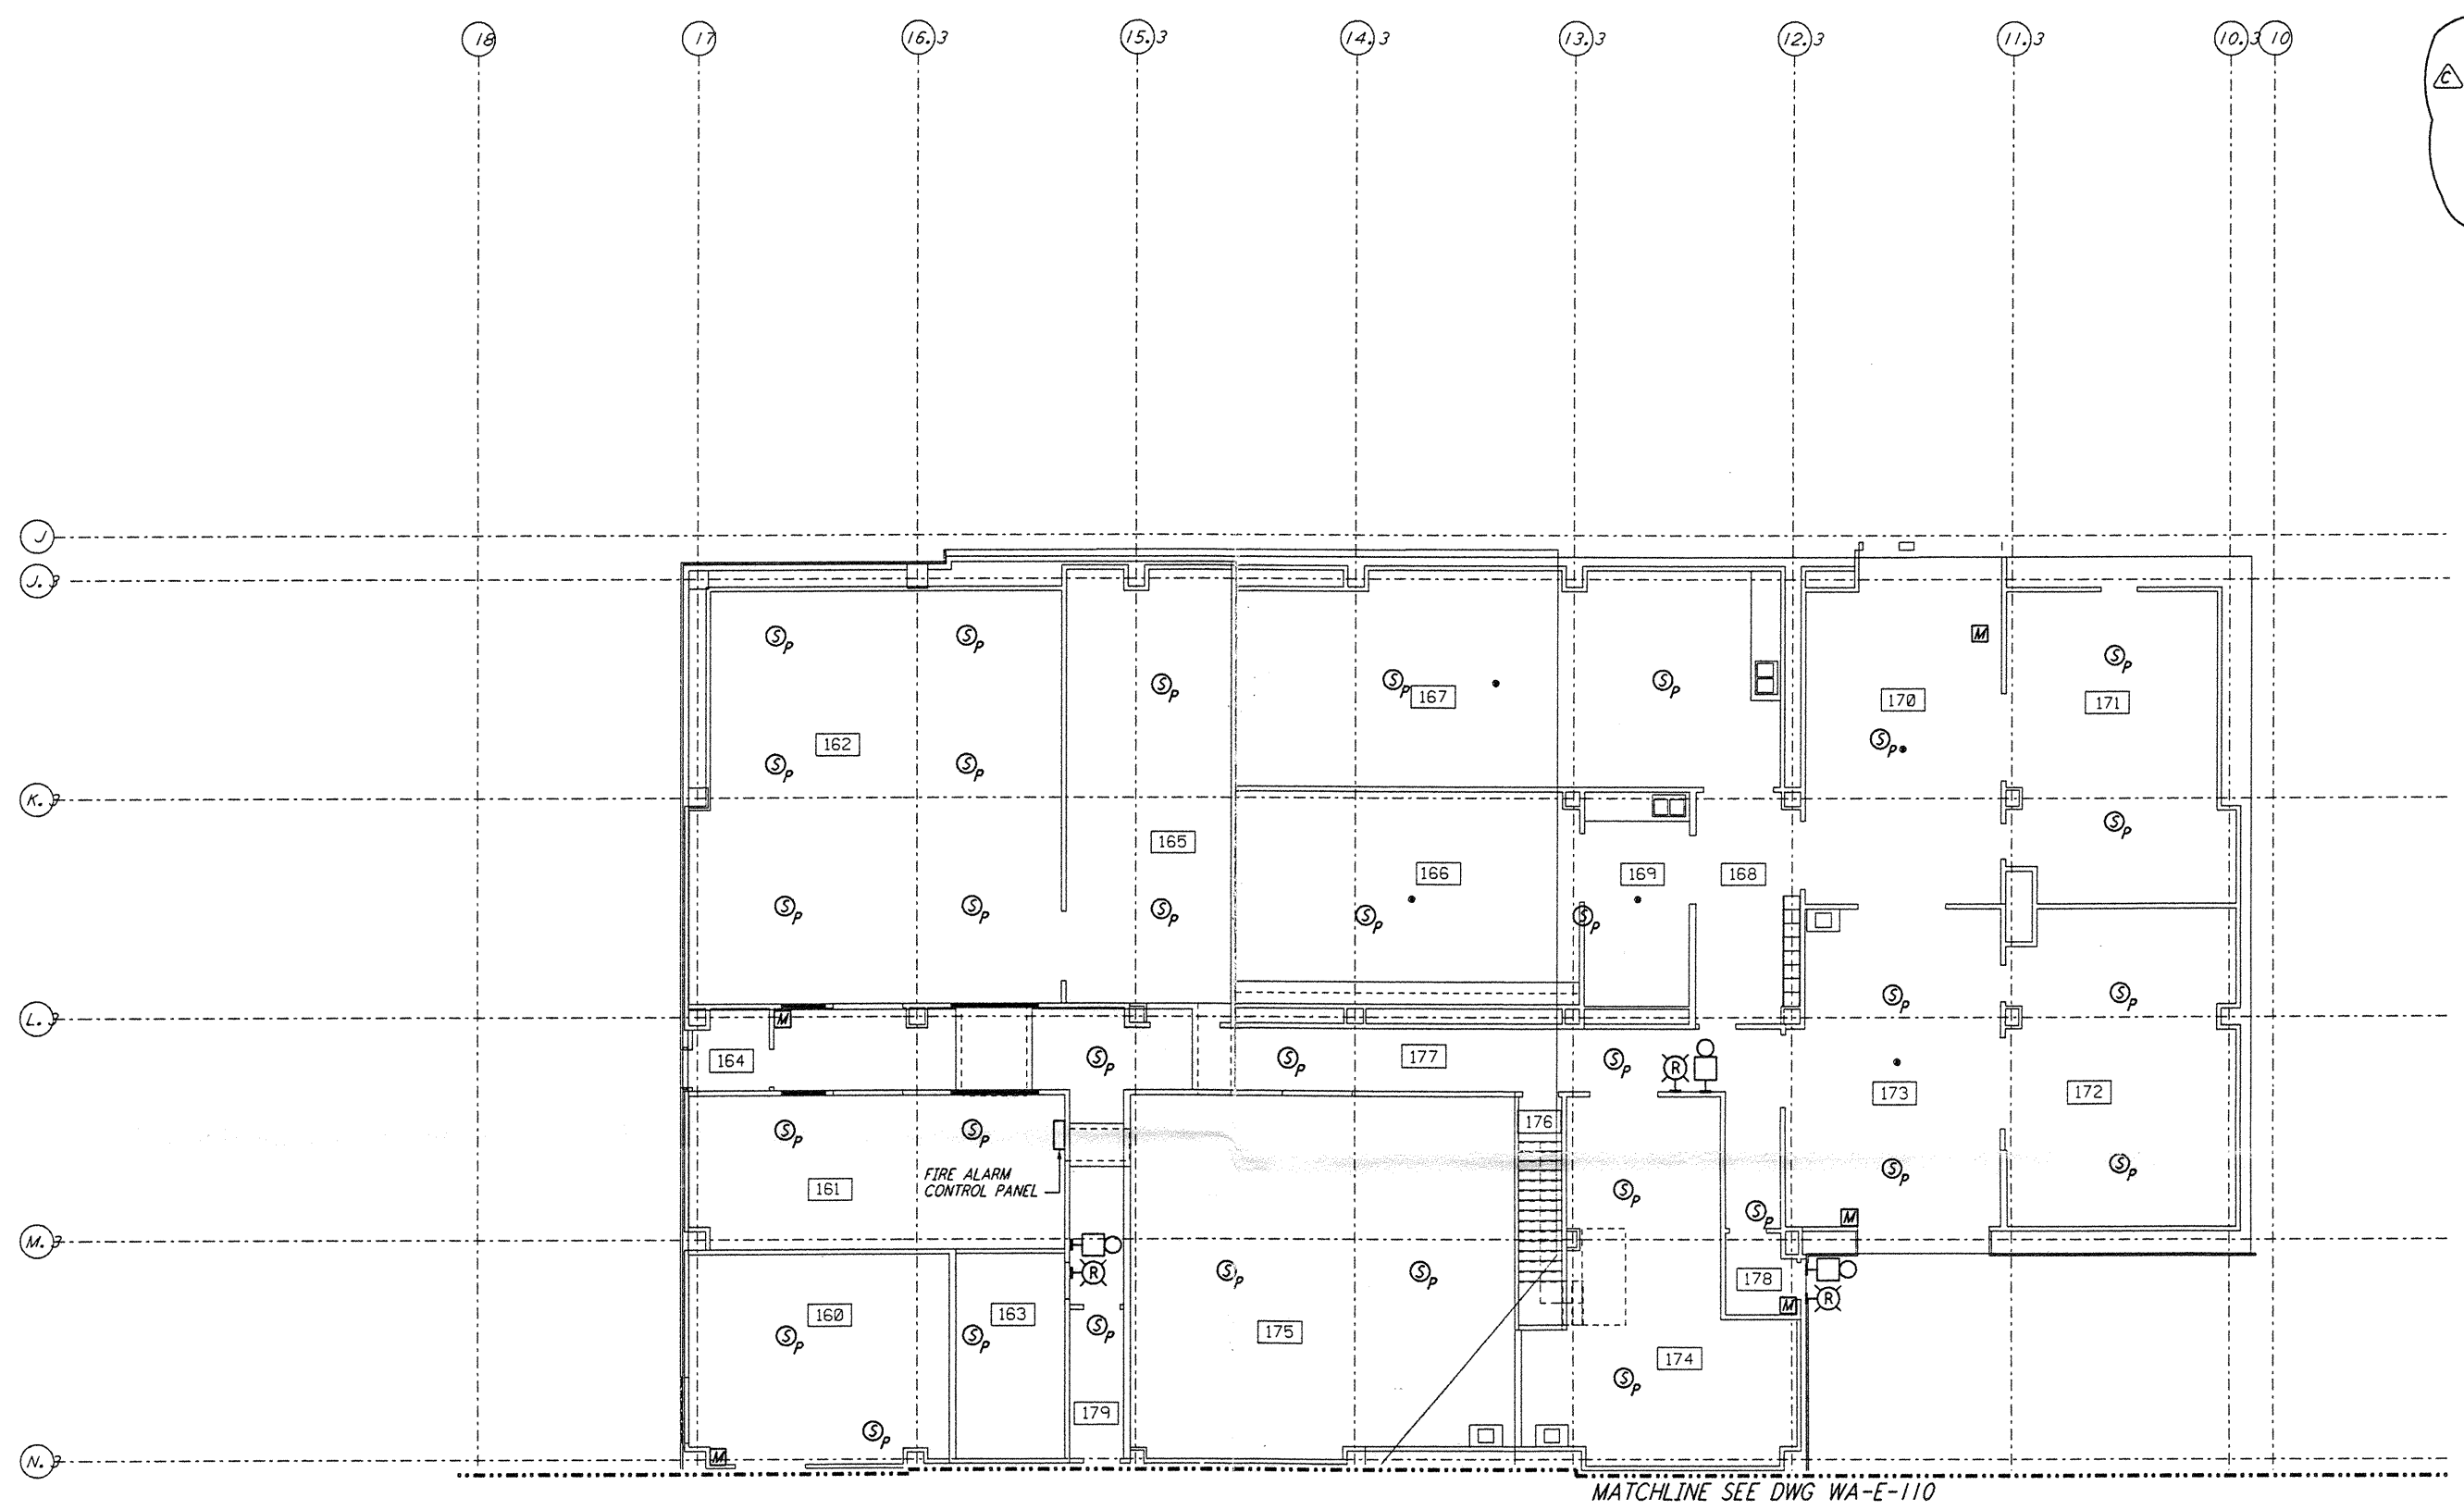


- NOTES:**
1. FOR PLAN SYMBOLS SEE DWG WA-E-002
 2. WIRING FOR FIRE DETECTION SHALL BE CLASS "A", FOR FIRE ALARM DEVICES SHALL BE CLASS "B".
 3. DUCT MOUNTED SMOKE DETECTORS SHALL BE PROVIDED WITH AN AUXILIARY RELAY CONTACT (N.C.) FOR EQUIPMENT SHUT-DOWN.
 4. COORDINATE SMOKE DETECTOR LOCATIONS WITH CLEAN AGENT DISCHARGE NOZZLES.
 5. COORDINATE AHU LOCATIONS AND DUCT MOUNTED SMOKE DETECTORS.

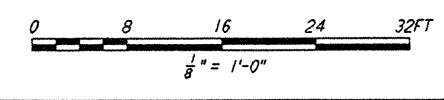

MATCHLINE SEE DWG WA-E-110

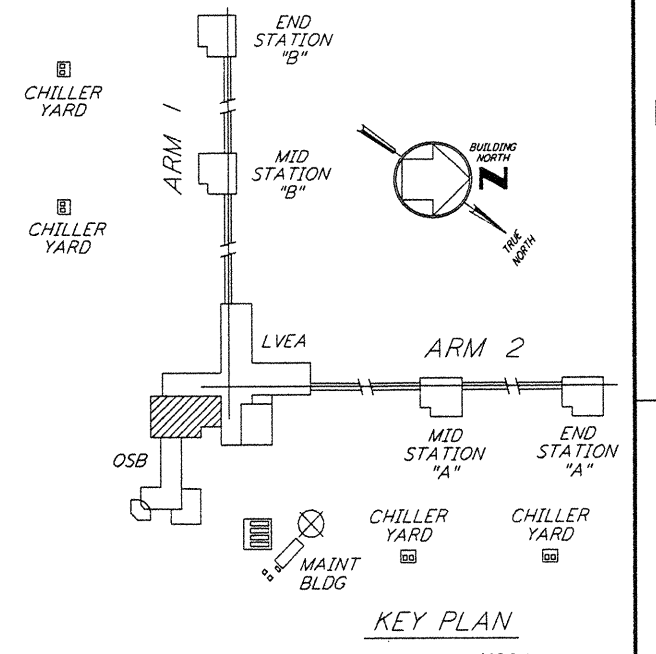

not be reproduced, copied, loaned, exhibited, or used in any other way, except by written consent from PARSONS to the borrower.

This document and the design it covers are the property of PARSONS. They are loaned only with the borrower's expressed written agreement that they will

NO.	DATE	BY	CHKD	ENGR	PROJ	DESCRIPTION
C	5-22-96	KAF	---	---	NDM	BID ADDENDUM #2
B	4-19-96	---	---	---	TDM	FINAL DESIGN REVIEW & BID
A	10-31-95	---	---	---	TDM	PRELIMINARY DESIGN REVIEW

DRAWN	J. G.
CHECKED	
ENGINEER	
PROJ	

PARSONS
 100 WEST WALNUT STREET
 PASADENA, CALIFORNIA

LIGO
 CALIFORNIA INSTITUTE OF TECHNOLOGY
 MASSACHUSETTS INSTITUTE OF TECHNOLOGY

LASER INTERFEROMETER
 GRAVITATIONAL-WAVE OBSERVATORY
 SITE NO. 1 - HANFORD, WASHINGTON

**ELECTRICAL
 CORNER STATION
 OSB LAB AREA FIRE DET
 & SECURITY PLAN**

AS NOTED PP150969 8094
WA-E-111

1000 PROJ_001_00202034_17700_317 LORONZ 01/14/10 10:00 AM 01/14/10 10:00 AM

1000 PROJ_001_00202034_17700_317 LORONZ 01/14/10 10:00 AM 01/14/10 10:00 AM