
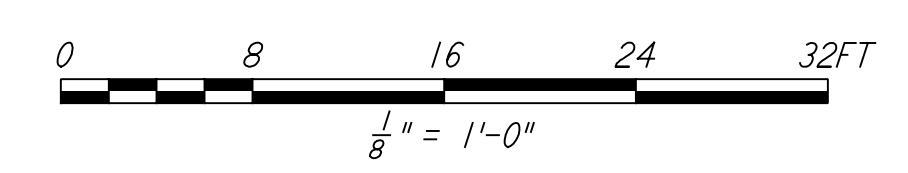
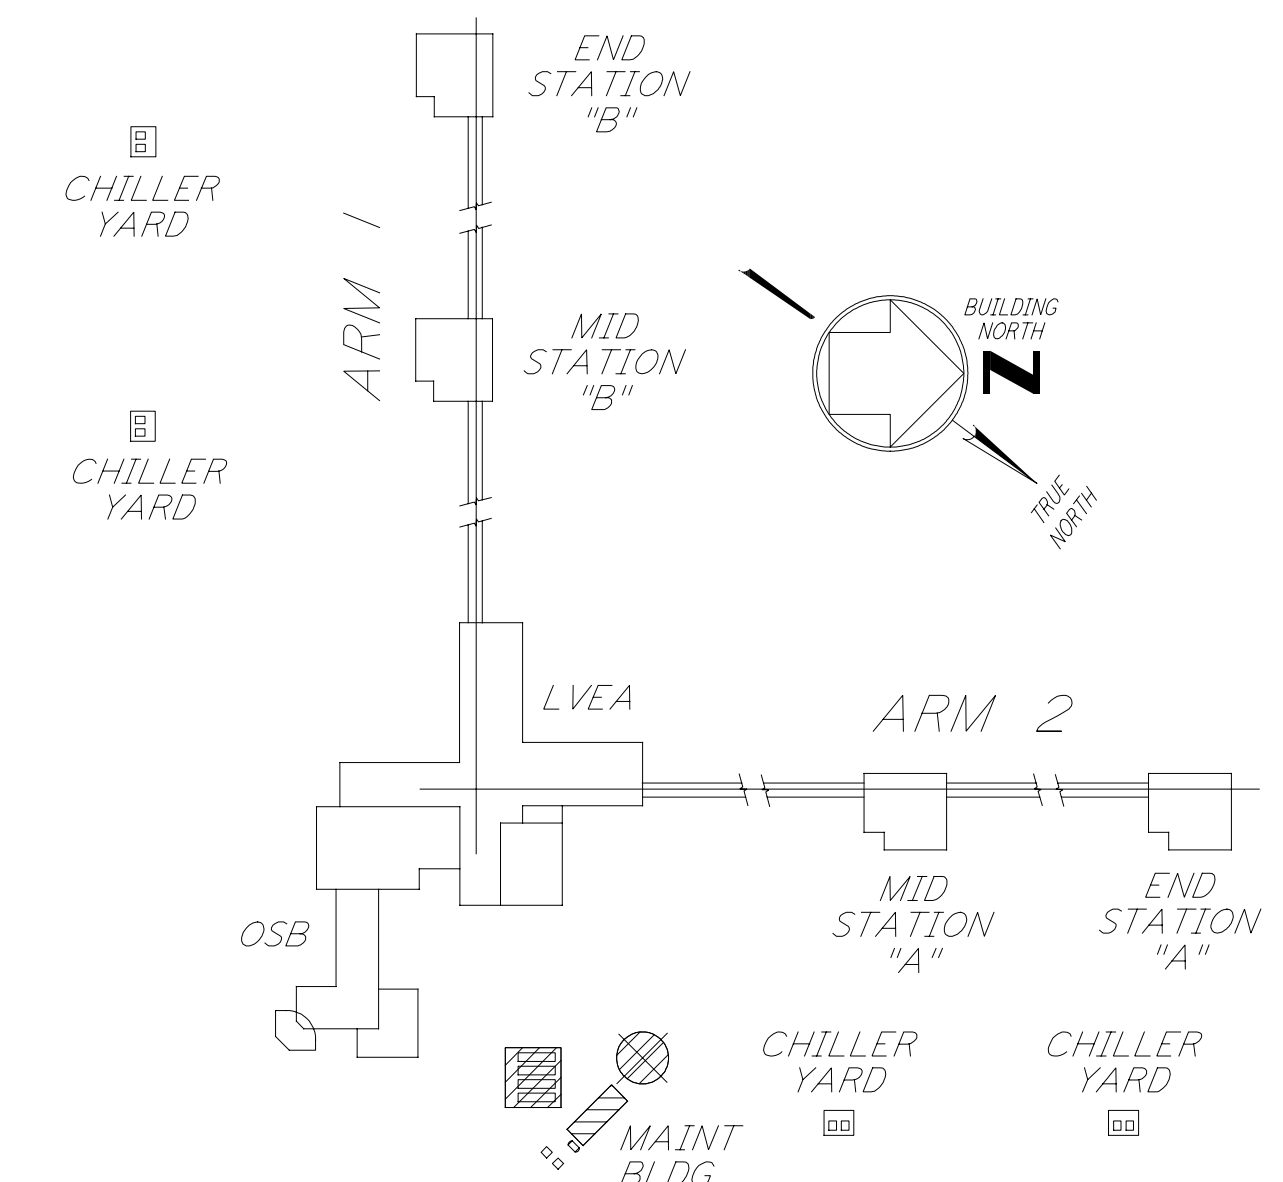


- NOTES:**
1. FOR GENERAL NOTES SEE DWG. WA-E-101.
 2. NOT USED
 3. NOT USED
 4. FOR STANDARD SYMBOLS, ABBREVIATIONS AND ACRONYMS SEE DWG. WA-E-001.
 5. FOR INSTALLATION DETAILS SEE DWG. WA-E-405 THRU 408.
 6. ALL RUNS ARE SHOWN DIAGRAMMATICALLY ONLY, CONTRACTOR SHALL COORDINATE WITH OTHER DISCIPLINES TO AVOID CONFLICT.

This document and the design it covers are the property of PARSONS. They are loaned only with the borrower's expressed written agreement that they will not be reproduced, copied, loaned, exhibited, or used in any other way, except by written consent from PARSONS to the borrower.

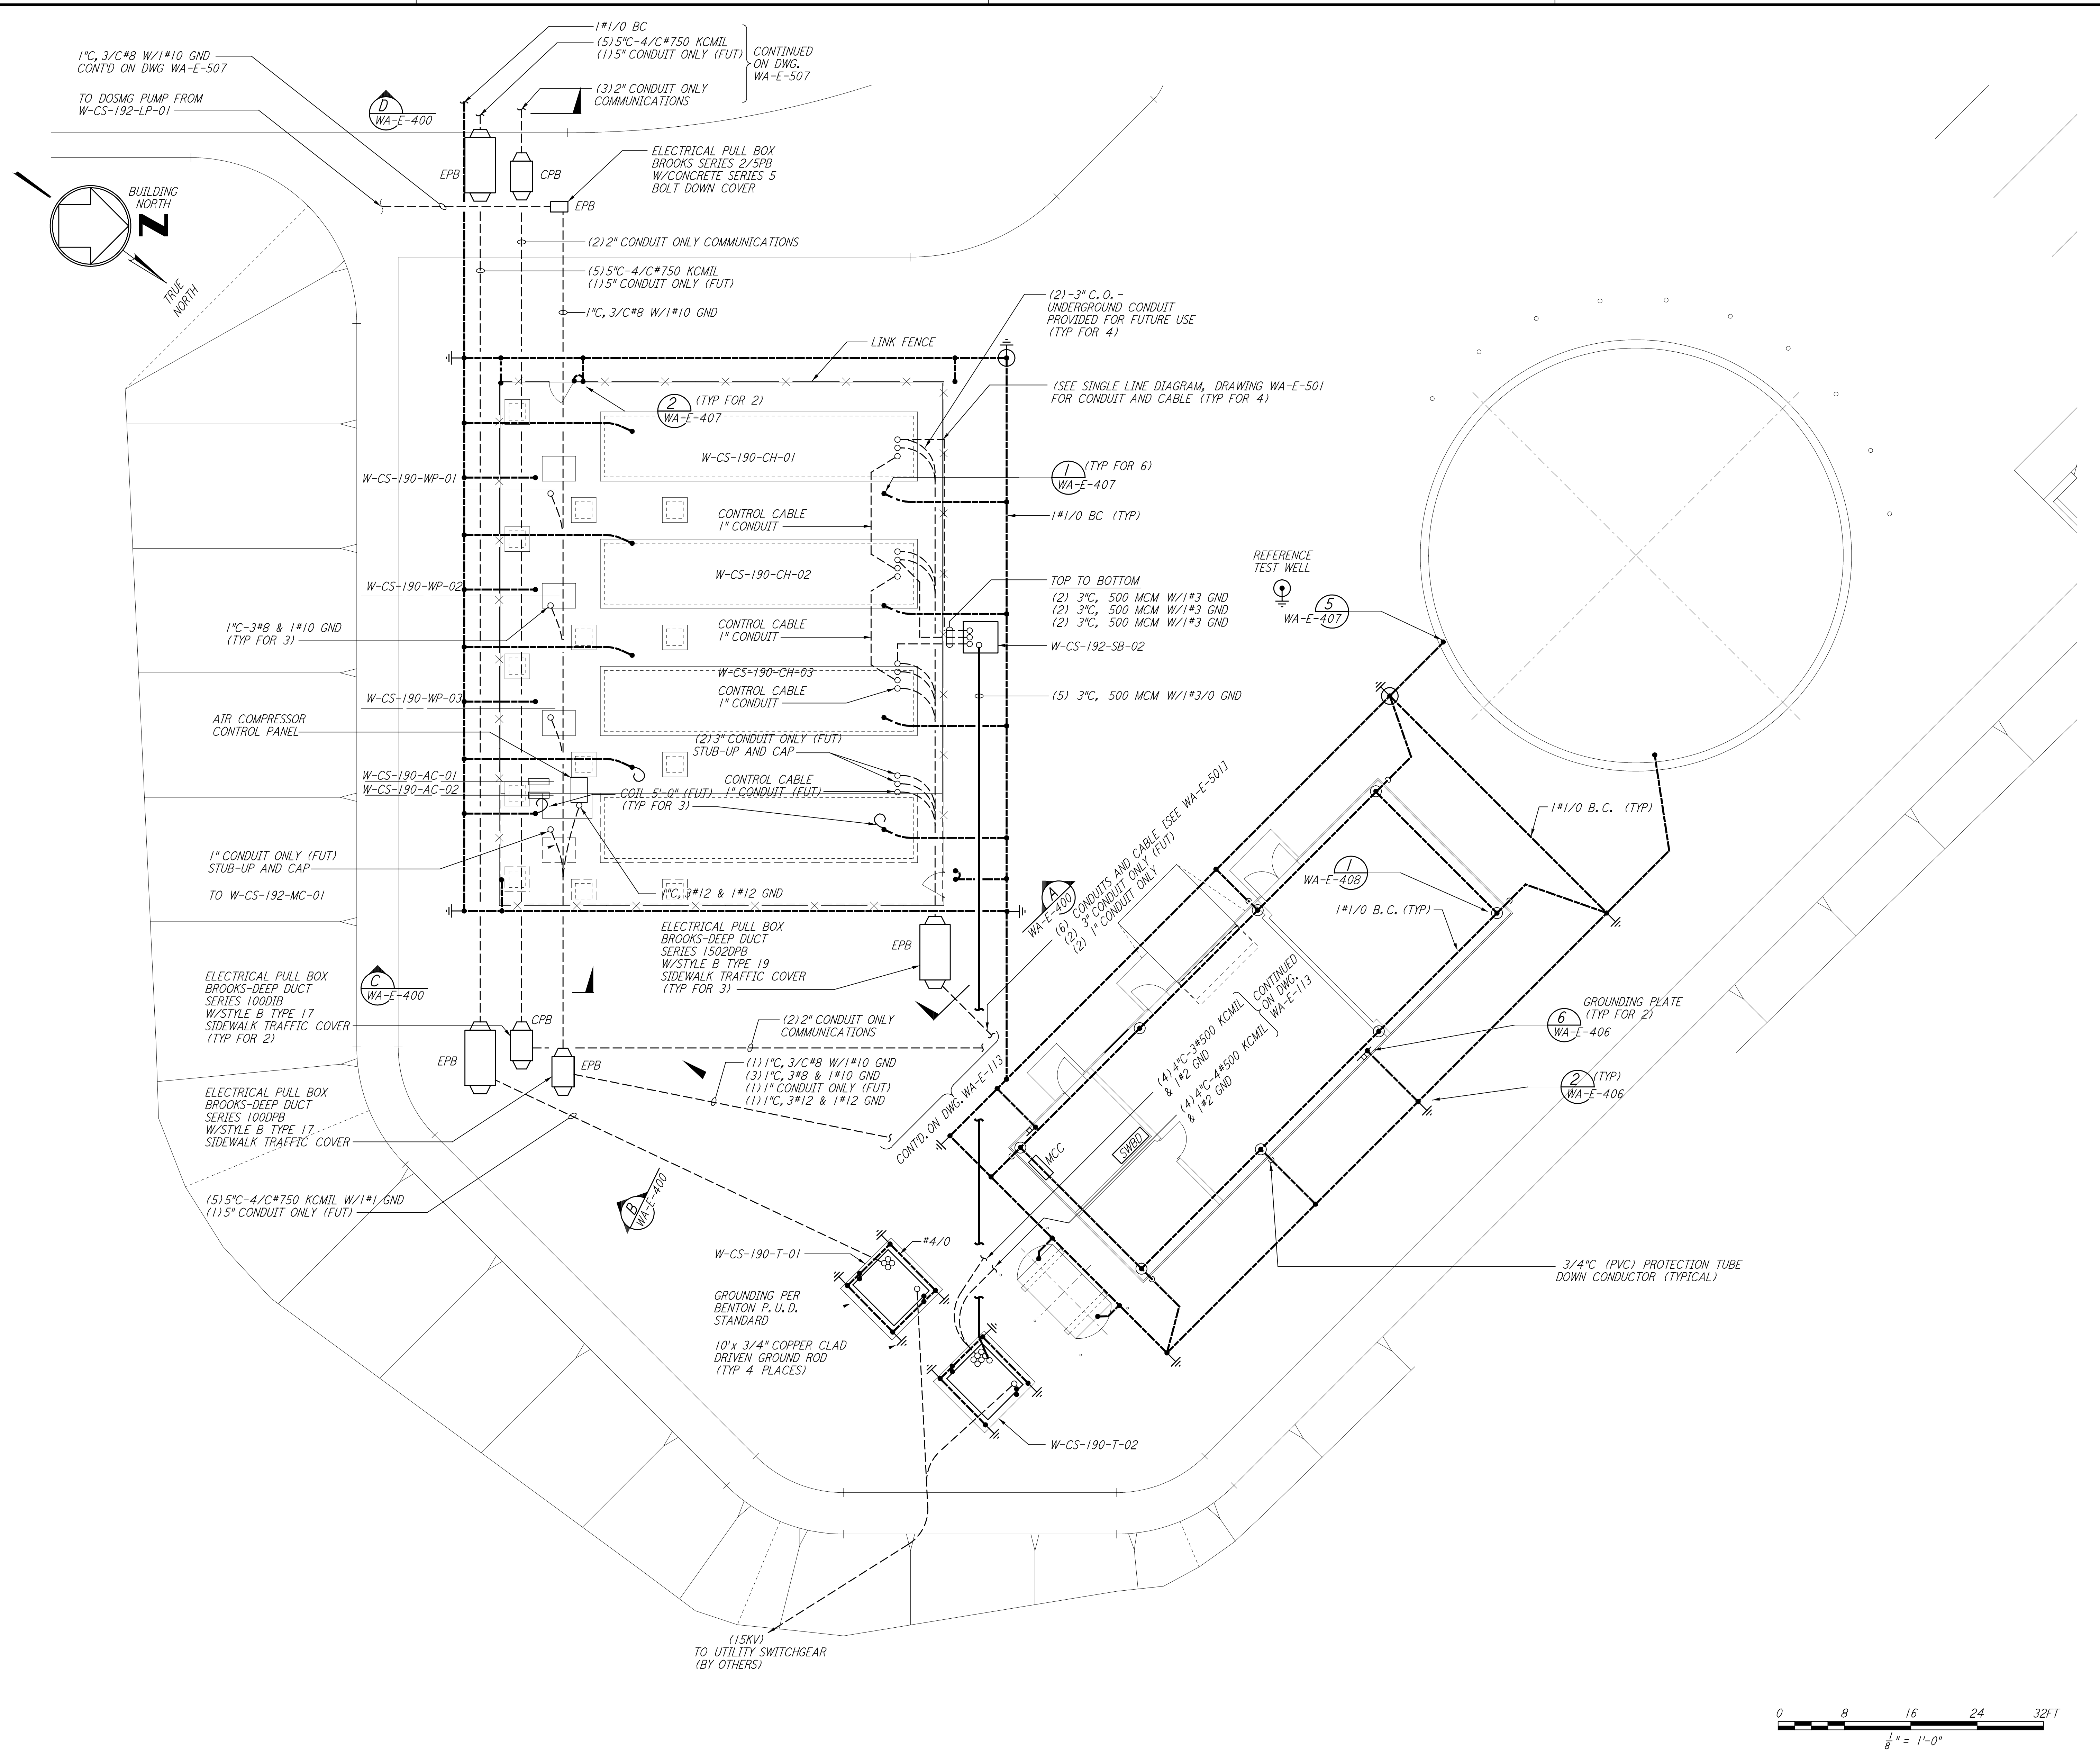

NO.	DATE	BY	CHKD	ENGR	PROJ	DESCRIPTION
1	6-15-98	J. G.				ISSUED FOR AS-BUILT

ISSUED FOR CONSTRUCTION		
DRAWN	M. M.	6-25-96
CHECKED	J. K.	7-3-96
ENGINEER	K. R.	7-3-96
PROJ	M. D. W.	7-8-96

AS-BUILT DRAWINGS



LIGO-D960401-01-O

LASER INTERFEROMETER
 GRAVITATIONAL-WAVE OBSERVATORY
 SITE NO. 1 - HANFORD, WASHINGTON

TITLE	SCALE	PROJECT NUMBER
ELECTRICAL CORNER STATION CHILLER PLANT & MAINT BLDG GROUNDING PLAN	AS NOTED	PP150969 8094
SHEET NUMBER	REVISIONS	
WA-E-112		

This drawing was prepared by PARSONS under contract to LIGO. It is the property of PARSONS and is loaned to you for your use only. It is not to be reproduced, copied, loaned, exhibited, or used in any other way, except by written consent from PARSONS to the borrower.