

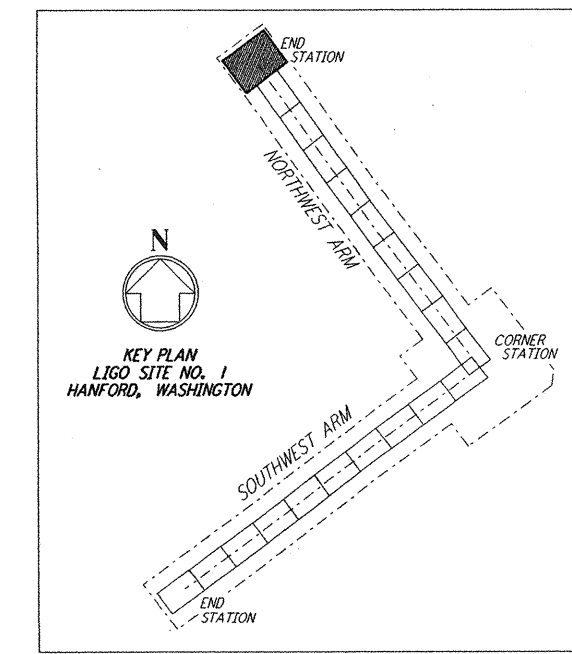
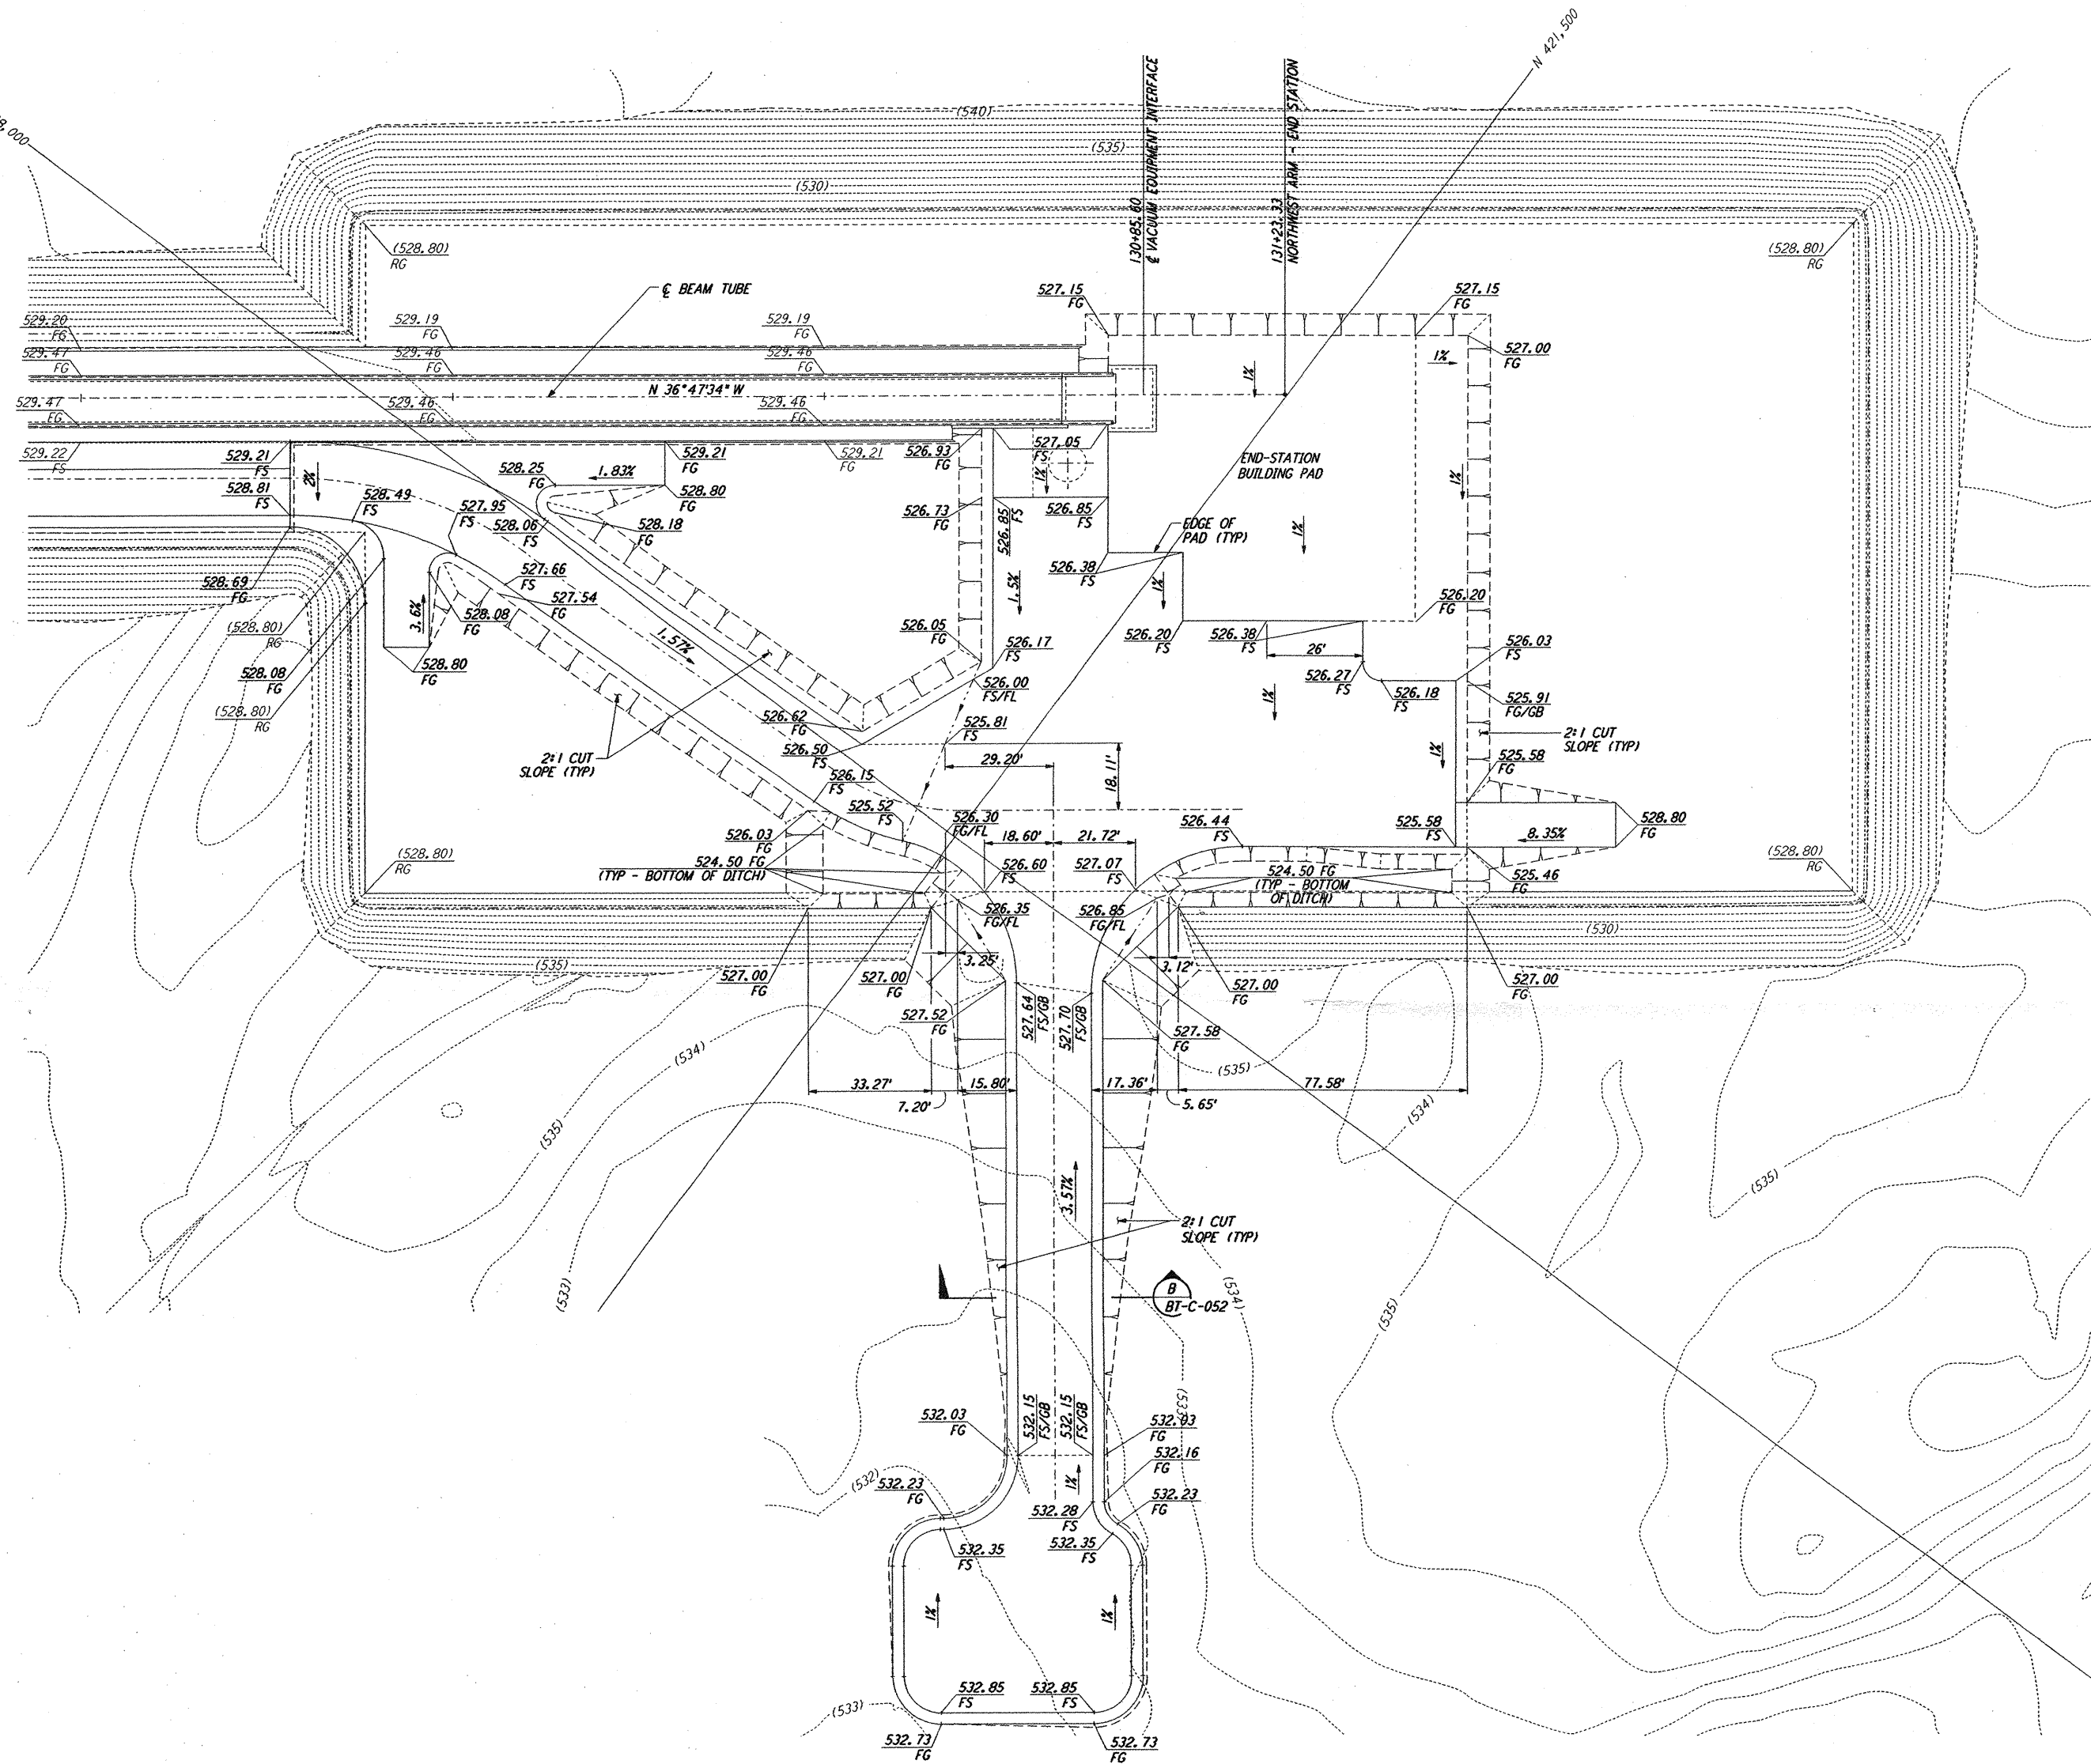


NOTES:
 1. SEE SHEET BT-C-002 FOR GENERAL NOTES, LEGEND AND ABBREVIATIONS.

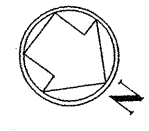

LIGO-D960720-00-O

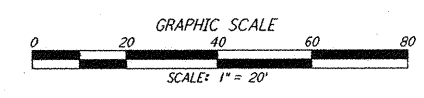

NO.	DATE	BY	CHKD	ENGR	PROJ	DESCRIPTION
0	1-22-99	ME1	--	--	MDW	ISSUED FOR AS BUILT
A	4-19-96	WRB	TDM		MDW	CHANGE ORDER NO. 4

DRAWN: WRB
 CHECKED: []
 ENGINEER: []
 PROJ: []

AS-BUILT DRAWINGS

PARSONS
 100 WEST WALNUT STREET
 PASADENA, CALIFORNIA

LIGO
 CALIFORNIA INSTITUTE OF TECHNOLOGY
 MASSACHUSETTS INSTITUTE OF TECHNOLOGY

LASER INTERFEROMETER
 GRAVITATIONAL-WAVE OBSERVATORY
 BTE SITework & FABRICATION - HANFORD, WA

TITLE: CIVIL NORTHWEST ARM END-STATION GRADING PLAN

SCALE: 1" = 20'

CONTRACT NUMBER: PP150969
 PROJECT NUMBER: 8094

SHEET NUMBER: **BT-C-026**

This document and the design it covers are the property of PARSONS. They are loaned only with the borrower's expressed written agreement that they will not be reproduced, copied, loaned, exhibited, or used in any other way, except by written consent from PARSONS to the borrower.

Thu, Jan 21 13:47:18 1999 C:\PILOT\GUE\SS\19882\007 52885 K:\5882\ee026a.prf LIGOBTF3.BOR