



This document and the design it covers are the property of PARSONS. They are loaned only with the borrower's expressed written agreement that they will not be reproduced, copied, issued, exhibited, or used in any other way, except by written consent from PARSONS to the borrower.

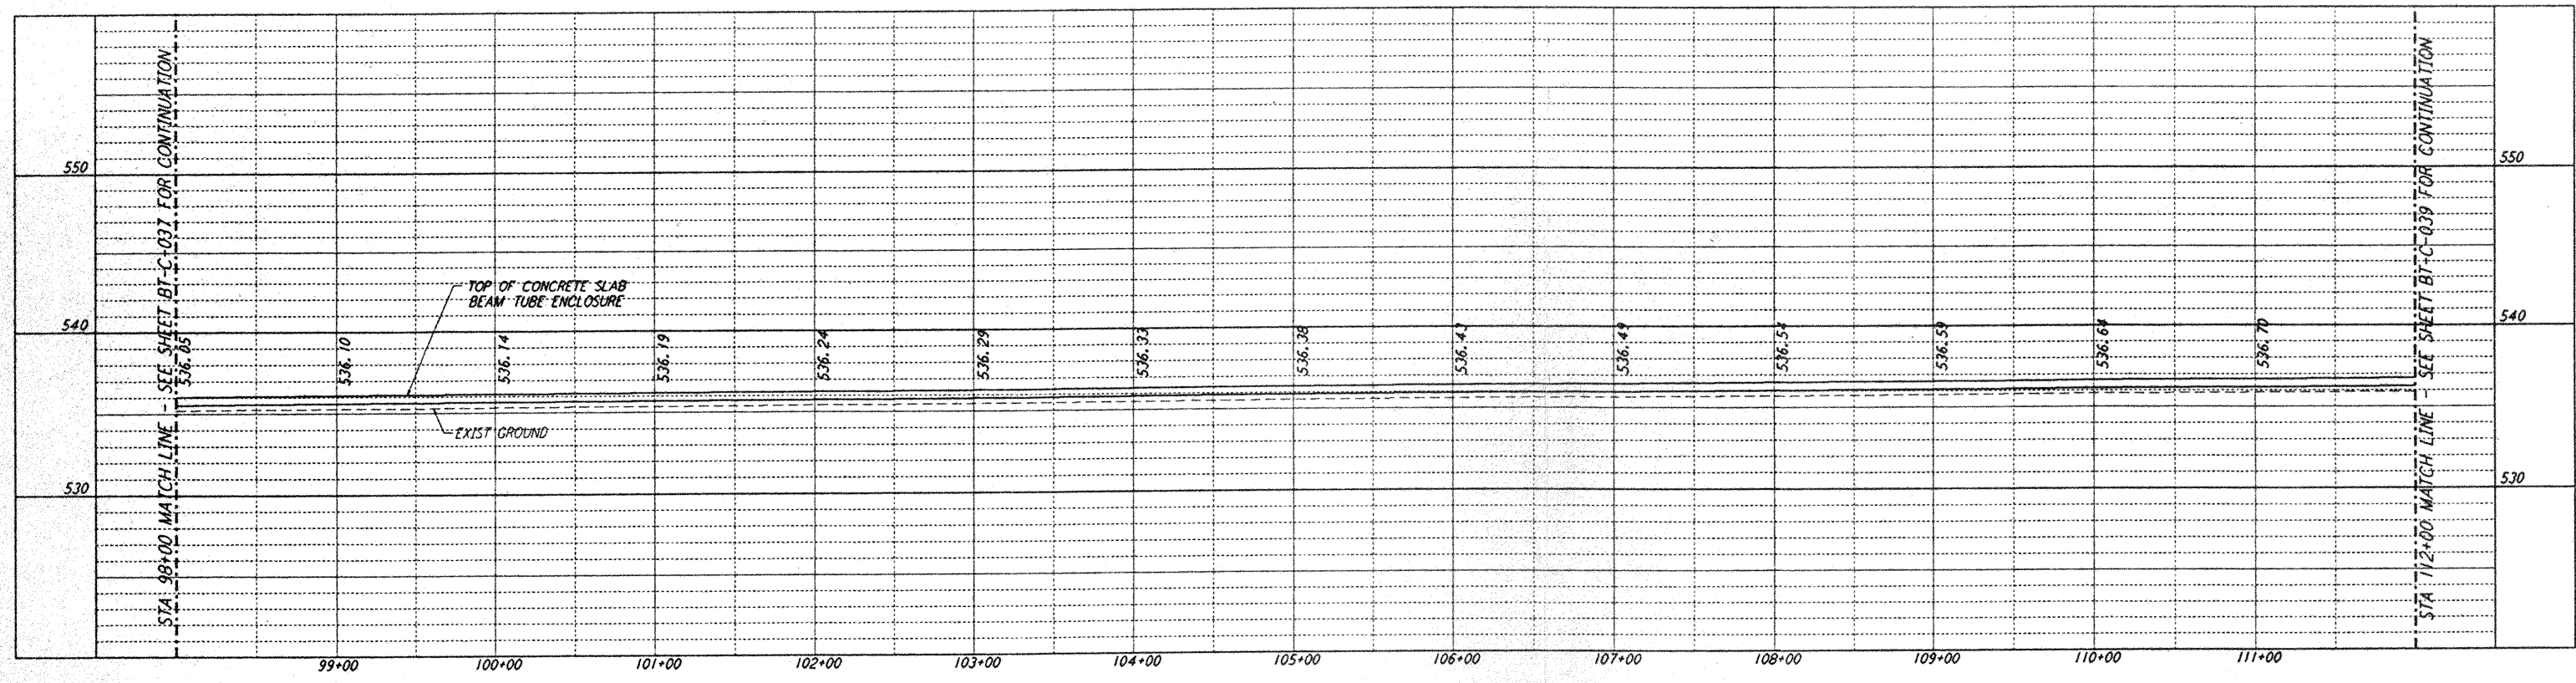



- NOTES:**
- SEE SHEET BT-C-002 FOR GENERAL NOTES, LEGEND AND ABBREVIATIONS.
 - SEE SHEET BT-C-004 FOR TYPICAL SECTIONS AND DETAILS.
 - TRANSITION BETWEEN SECTIONS, AS SHOWN ON PLAN.

PROFILE
 SCALES: HORIZ: 1" = 50'
 VERT: 1" = 5'

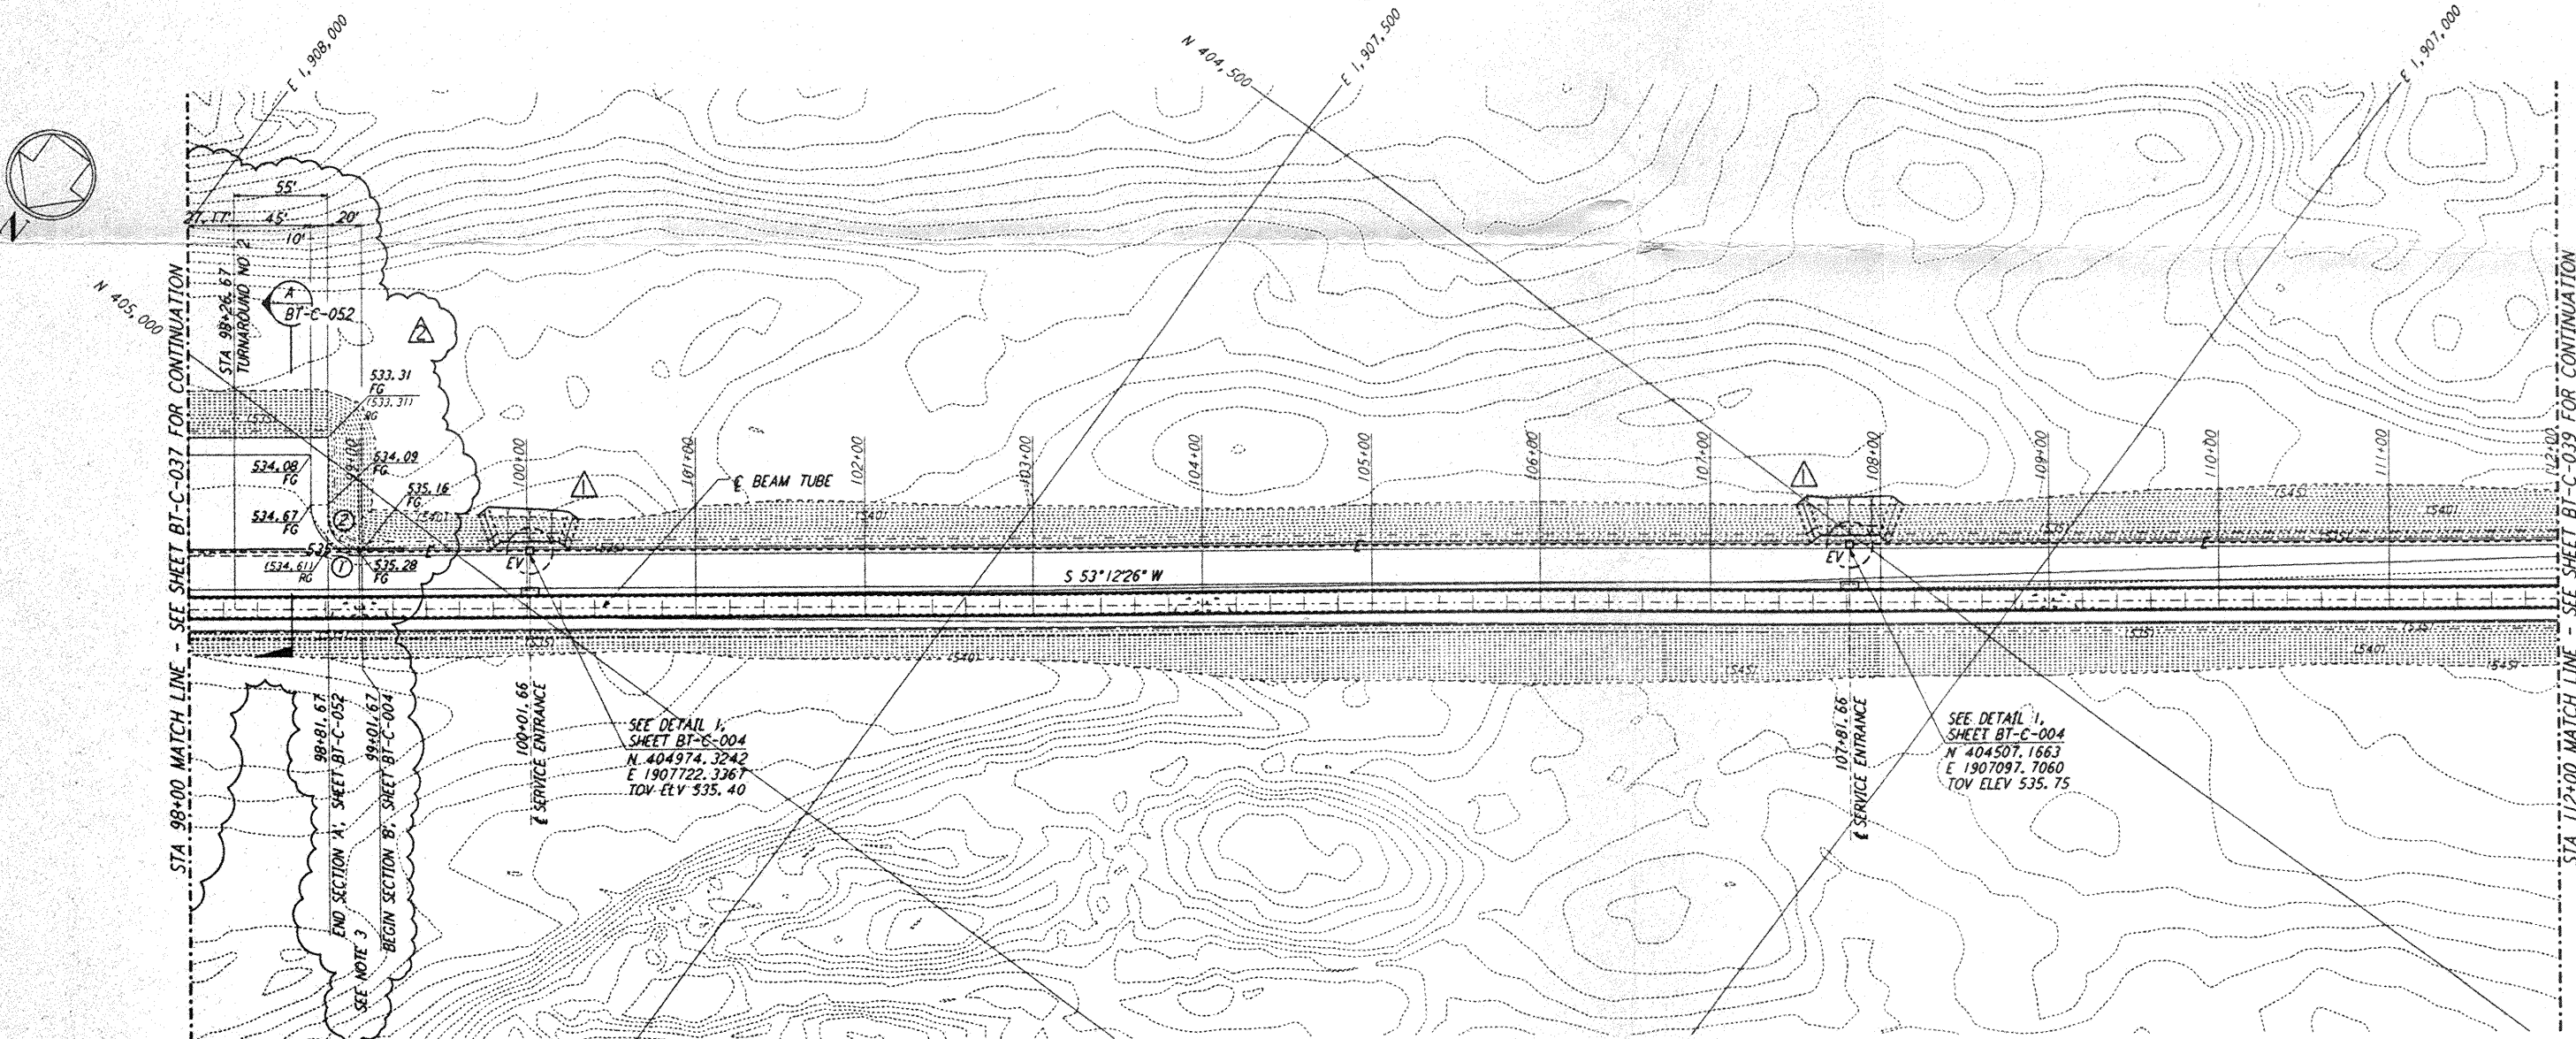

PLAN
 SCALE: 1" = 50'

| CURVE DATA | | | | |
|------------|-----------|--------|---------|--------|
| Δ | RADIUS | LENGTH | TANGENT | |
| 1 | 90°00'00" | 30' | 47.12' | 30.00' |
| 2 | 90°00'00" | 20' | 31.42' | 20.00' |

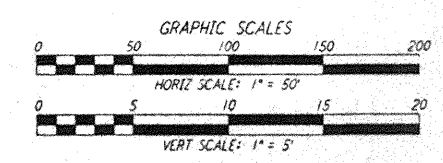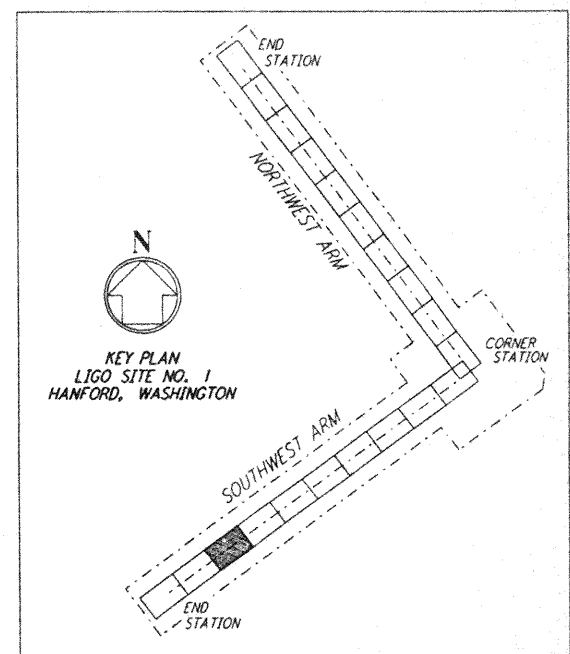

| NO. | DATE | BY | CHKD | ENGR | PROJ | DESCRIPTION |
|-----|---------|-----|------|------|------|--------------------|
| 2 | 4-19-96 | WRB | TDM | MDW | | CHANGE ORDER NO. 4 |
| 1 | 2-29-96 | WRB | TDM | MDW | | CHANGE ORDER NO. 2 |

| ISSUED FOR CONSTRUCTION | | |
|-------------------------|-----|---------|
| DRAWN | WRB | 1-19-96 |
| CHECKED | MP | 1-19-96 |
| ENGINEER | JB | 1-19-96 |
| PROJ | MDW | 1-19-96 |

PARSONS
 100 WEST WALNUT STREET
 PASADENA, CALIFORNIA

LIGO
 CALIFORNIA INSTITUTE OF TECHNOLOGY
 MASSACHUSETTS INSTITUTE OF TECHNOLOGY

LASER INTERFEROMETER
 GRAVITATIONAL-WAVE OBSERVATORY
 BTE SITWORK & FABRICATION - HANFORD, WA

| | | | | |
|--------------|--|----------|----------|------|
| TITLE | CIVIL SOUTHWEST ARM PLAN AND PROFILE | AS NOTED | PP150969 | 8094 |
| SHEET NUMBER | BT-C-038 | | | |