



ABBREVIATIONS

AB	ANCHOR BOLT	MAX	MAXIMUM
ACI	AMERICAN CONCRETE INSTITUTE	MS	MACHINE BOLT
AISC	AMERICAN INSTITUTE OF STEEL CONSTRUCTION	MECH	MECHANICAL
APPROX	APPROXIMATE	MEZZ	MEZZANINE
ARCH	ARCHITECTURAL	MFR	MANUFACTURER
ASTM	AMERICAN SOCIETY FOR TESTING AND MATERIALS	MIN	MINIMUM
AWS	AMERICAN WELDING SOCIETY	MISC	MISCELLANEOUS
B/B	BACK TO BACK	MPH	MILES PER HOUR
B/P	BASE PLATE	NS	NEAR SIDE
BM	BEAM	NTS	NOT TO SCALE
BOF	BOTTOM OF FOOTING	OC	ON CENTER
BOS	BOTTOM OF STEEL	OD	OUTSIDE DIAMETER
BRGC	BRACING	OH	OPPOSITE HAND
C	CAMBER	OPNG	OPENING
CC OR C/C	CENTER TO CENTER	OPP	OPPOSITE
CG	CENTER OF GRAVITY	OSB	OPERATIONS SUPPORT BUILDING
CJ	CONSTRUCTION JOINT	OTO	OUT TO OUT
CLG	CEILING	PCF	POUNDS PER CUBIC FOOT
CLR	CLEAR	PL	PLATE
CMU	CONCRETE MASONRY UNIT	PSF	POUNDS PER SQUARE FOOT
COL	COLUMN	PSI	POUNDS PER SQUARE INCH
CONC	CONCRETE	PT	POINT
CONT	CONTINUOUS	R	RADIUS
CU	CUBIC	RD	ROOF DRAIN
DET	DETAIL	REF	REFERENCE
DIAG	DIAGONAL	REIN	REINFORCING STEEL
DIM	DIMENSION	REQD	REQUIRED
DL	DEAD LOAD	REV	REVISE OR REVISION
DO	DITTO	SCHED	SCHEDULE
DWG	DRAWING	SECT	SECTION
DWL	DOWEL	SHT	SHEET
EA	EACH	SIM	SIMILAR
EF	EACH FACE	SLV	SHORT LEG VERTICAL
EL	ELEVATION	SPA	SPACED
ENCL	ENCLOSURE	ST STL	STAINLESS STEEL
ENGR	ENGINEER	STD	STANDARD
EO	EQUAL	STIF	STIFFENER
EQUIP	EQUIPMENT	SYM	SYMMETRICAL
ETC	ETCETERA	T&B	TOP AND BOTTOM
EW	EACH WAY	THK	THICKNESS
EXIST	EXISTING	TOC	TOP OF CONCRETE
FD	FLOOR DRAIN	TOF	TOP OF FOOTING
FIN	FOUNDATION	TOS	TOP OF STEEL
FLR	FLOOR	TOW	TOP OF WALL
FLSHG	FLASHING	TYP	TYPICAL
FOC	FACE OF CONCRETE	UON	UNLESS OTHERWISE NOTED
FRMG	FRAMING	VERT	VERTICAL
FS	FAR SIDE	W/	WITH
FT	FOOT, FEET	WP	WATER PROOF
FTG	FOOTING	WP	WORKING POINT
GA	GAUGE	WS	WELDED STUD
GALV	GALVANIZED	WT	WEIGHT
GR	GRADE	WWF	WELDED WIRE FABRIC
HP	HORIZONTAL	WWM	WELDED WIRE MESH
HP	HIGH POINT		
HSB	HANDRAIL		
HSB	HIGH STRENGTH BOLT		
ID	INSIDE DIAMETER		
IN	INCH		
INFO	INFORMATION		
INSUL	INSULATION		
JST	JOIST		
JT	JOINT		
LB	POUND		
LG	LENGTH		
LLH	LONG LEG HORIZONTAL		
LLV	LONG LEG VERTICAL		
LVEA	LASER AND VACUUM EQUIPMENT AREA		
LWC	LIGHT WEIGHT CONCRETE		

SYMBOLS

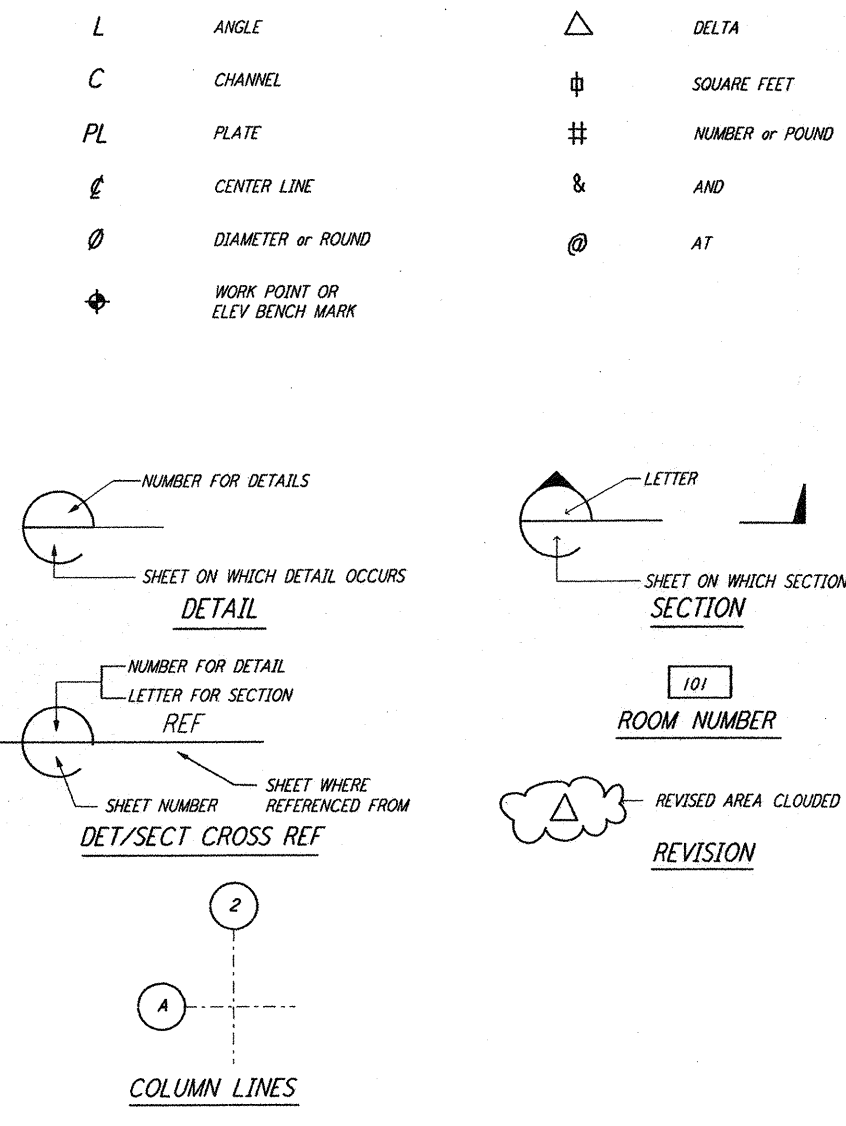

MATERIALS LEGEND

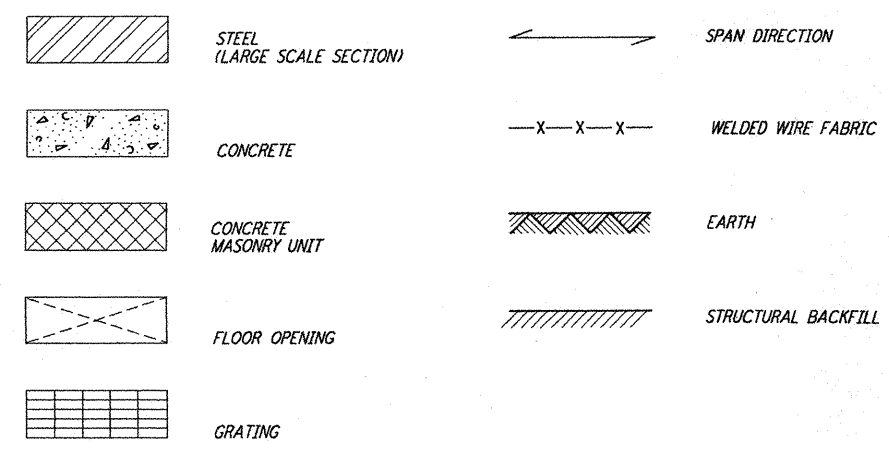

NOTES

INSPECTIONS AND APPROVALS

GENERAL

- PROFESSIONAL SOILS ENGINEER REGISTERED IN THE STATE OF WASHINGTON SHALL INSPECT AND APPROVE ALL FOOTING EXCAVATIONS PRIOR TO PLACING CONCRETE ACCORDING TO SECTION 2200 OF THE SPECIFICATION.
- CONTINUOUS INSPECTION BY AN INSPECTOR, APPROVED BY THE DEPARTMENT OF BUILDING AND SAFETY SHALL BE PROVIDED FOR THE FOLLOWING FIELD WORK:
 - PLACEMENT OF COMPACTED FILL.
 - PLACEMENT OF CONCRETE AND REINFORCING STEEL AND ANCHOR BOLTS.
 - EXPANSION TYPE CONCRETE ANCHORS.
 - FIELD WELDING.
 - INSTALLATION OF HIGH STRENGTH BOLTS.
- THE CONSTRUCTION SHALL COMPLY WITH REQUIREMENTS OF THE BUILDING CODE.
- ALL STRUCTURAL WORK AND MATERIALS SHALL CONFORM TO THE REQUIREMENTS OF THE JOB SPECIFICATIONS AND STANDARDS.
- FOR TYPICAL DETAILS SEE DRAWINGS BT-5-602 THROUGH BT-5-603.
- CONTRACTOR SHALL PROVIDE TEMPORARY BRACING AND SHORING AS REQUIRED TO MAINTAIN THE ALIGNMENT OF BUILDING AND RETAINING WALLS UNTIL ALL CONNECTIONS ARE COMPLETED AND SLAB AND WALLS CONSTRUCTED.
- PRIOR TO PLACING FOUNDATIONS & SLABS, REFER TO UNDERDRAIN SYSTEM DRAWINGS, ARCHITECTURAL DRAWINGS FOR SLOPES AND ELECTRICAL DRAWINGS FOR GROUNDING.
- FOR BUILDING COLUMN LOCATION COORDINATES SEE CIVIL DRAWINGS.

FOUNDATIONS

- FOUNDATION AND SOIL REQUIREMENTS ARE BASED ON SOIL REPORT BY DAMES AND MOORE; REPORT NO. 177-004-0016 DATED: FEBRUARY 10, 1993.

CONCRETE

- ALL CONCRETE MATERIALS AND CONSTRUCTION SHALL CONFORM TO THE REQUIREMENTS OF DIVISION 3 (CONCRETE) OF THE SPECIFICATIONS. (REGULAR WEIGHT AND LIGHT WEIGHT)
- STRUCTURAL CONCRETE SHALL HAVE AN ULTIMATE COMPRESSIVE STRENGTH OF 4000 PSI AT 28 DAYS UNLESS OTHERWISE NOTED. ALL CONCRETE SHALL BE REGULAR WEIGHT CONCRETE UNLESS OTHERWISE NOTED.
- ALL REINFORCING STEEL SHALL BE DEFORMED BARS CONFORMING TO ASTM A615 GRADE 60 (UNLESS OTHERWISE NOTED). SPLICES AND HOOKS SHALL CONFORM TO ACI 318-89. SPLICES SHALL BE CLASS B UNLESS OTHERWISE NOTED. MINIMUM LAP SHALL BE 30 DIAMETERS. STIRRUP AND TIE HOOKS SHALL HAVE 135-DEGREE BENDS.
- LOCATION OF ALL CONSTRUCTION JOINTS OR OTHER TYPES OF JOINTS, OTHER THAN SPECIFIED, SHALL BE APPROVED BY THE CONSTRUCTION MANAGER BEFORE PLACING.
- MINIMUM CONCRETE COVER PROVIDED FOR REINFORCEMENT SHALL BE IN ACCORDANCE WITH THE SPECIFICATION.
- ALL REINFORCING STEEL, ANCHOR BOLTS, DOWELS AND OTHER INSERTS SHALL BE WELL SECURED IN POSITION AND INSPECTED BY QUALIFIED INSPECTOR PRIOR TO PLACING CONCRETE.
- EXISTING PAVEMENT SHALL BE SAW CUT AND BROKEN OUT TO CLEAN, STRAIGHT EDGES OF DEMOLITION AREAS.
- EXPOSED EDGES OF CONCRETE SHALL HAVE A 1/4" CHAMFER UNLESS OTHERWISE NOTED ON DRAWINGS.
- EXCAVATING AND BACKFILLING SHALL BE IN ACCORDANCE WITH THE SPECIFICATIONS.
- CONSTRUCTION JOINTS SHALL BE CLEANED AND ROUGHENED TO 1/4" AMPLITUDE.
- PROVIDE REINFORCEMENT IN WALLS AT CORNER AND INTERSECTIONS AS PER DETAIL 2 BT-5-602

ANCHOR BOLTS

- FOR ANCHOR BOLT DETAILS SEE DRAWING BT-5-603

SCOPE OF WORK

- CONCRETE WORK FOR MID STATION "9" AND END STATION "8" AS FOLLOWS:
- ALL FOUNDATIONS, STRIP FOOTING AND 30 INCHES THICK EQUIPMENT FOUNDATION.
 - ALL ANCHOR BOLTS AND DOWELS.
 - SLAB ON GRADE.

LIGO-D960735-00-0

NO.	DATE	BY	CHKD	ENGR	PROJ	DESCRIPTION
0	1-22-99	MET	--	--	MDW	ISSUED FOR AS BUILT
A	4-19-96	MCS	KS	BP		CHANGE ORDER #4

AS-BUILT DRAWINGS

DRAWN: MCS
 CHECKED: MCS
 ENGINEER: MCS
 PROJ: MCS

PARSONS
 100 WEST WALNUT STREET
 PASADENA, CALIFORNIA

LIGO
 CALIFORNIA INSTITUTE OF TECHNOLOGY
 MASSACHUSETTS INSTITUTE OF TECHNOLOGY

LASER INTERFEROMETER
 GRAVITATIONAL-WAVE OBSERVATORY
 BTE SITWORK & FABRICATION - HANFORD, WA

SCALE: NONE
 CONTRACT NUMBER: PP150969
 PROJECT NUMBER: 8094

STRUCTURAL GENERAL NOTES, ABBREVIATIONS & LEGEND

SHEET NUMBER: BT-S-601

This document and the design it covers are the property of PARSONS. They are loaned only with the borrower's expressed written agreement that they will not be reproduced, copied, loaned, exhibited, or used in any other way, except by written consent from PARSONS to the borrower.

E
 D
 C
 B
 A

Thu Jan 21 13:41:52 1999 C:\PLOT\GIVE\3-Y\96B2.DWG 52896 K:\V36E2\4680b.prf LIG08TF.BDR