




This document and the design it covers are the property of PARSONS. They are loaned only with the borrower's expressed written agreement that they will not be reproduced, copied, loaned, exhibited, or used in any other way, except by written consent from PARSONS to the borrower.

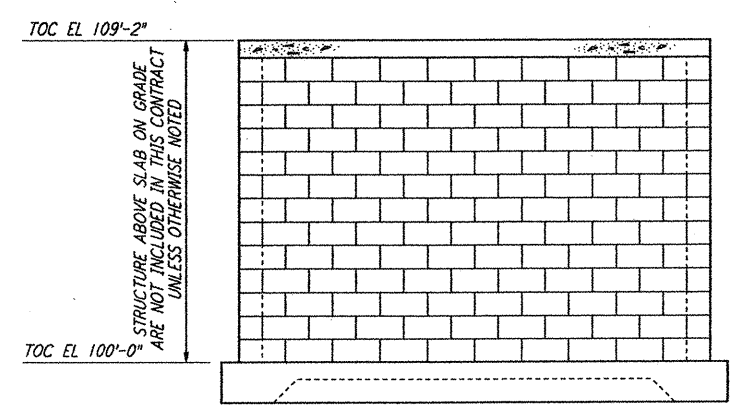


ELEVATION A REF
 $\frac{3}{8}'' = 1'-0''$ BT-S-606 BT-S-605

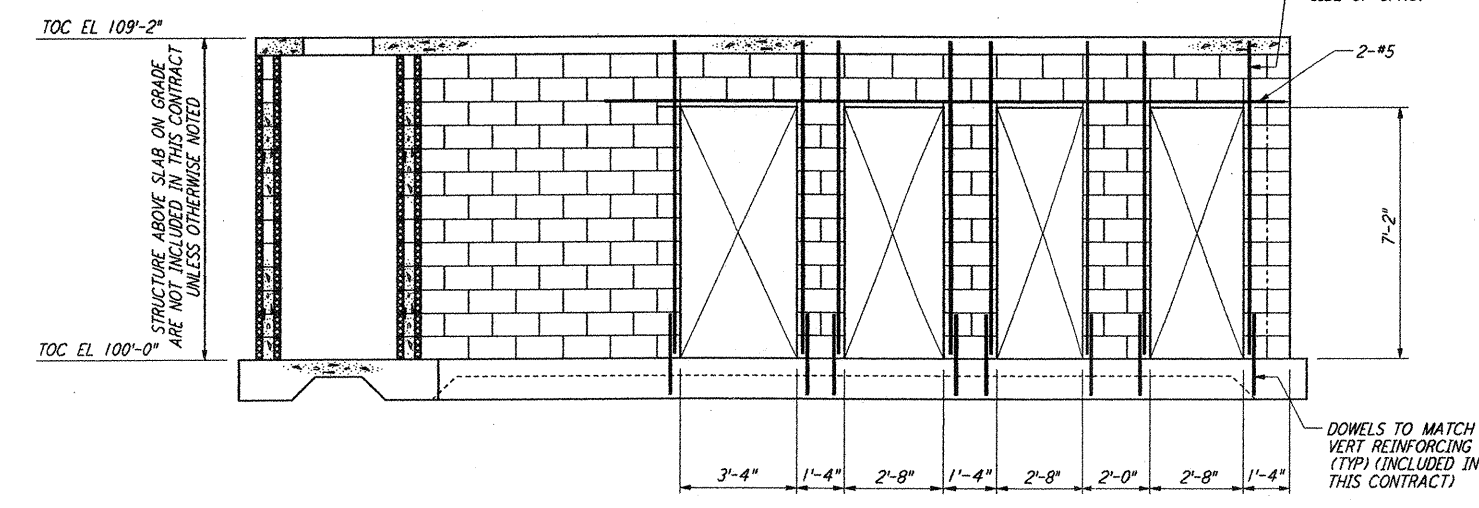


ELEVATION B REF
 $\frac{3}{8}'' = 1'-0''$ BT-S-606 BT-S-605

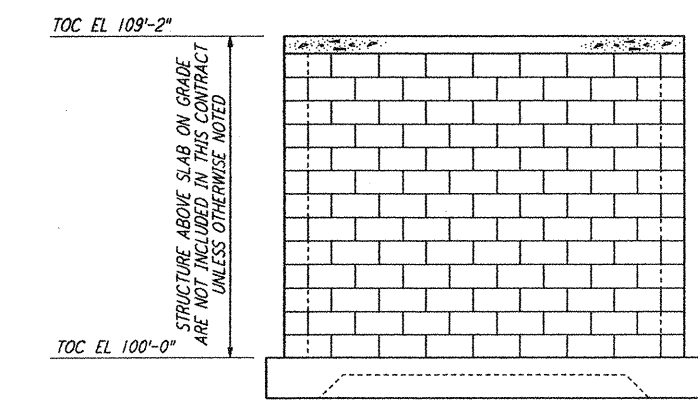


ELEVATION C REF
 $\frac{3}{8}'' = 1'-0''$ BT-S-606 BT-S-605

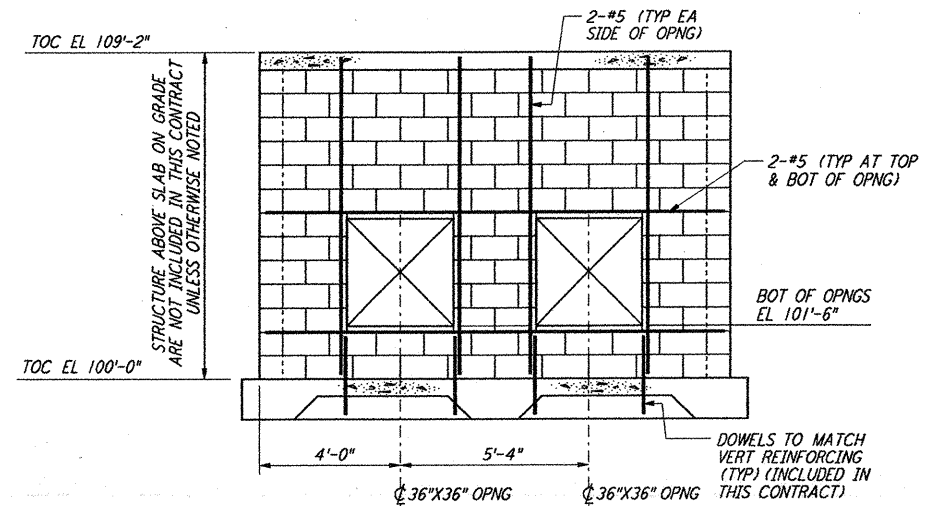


ELEVATION D REF
 $\frac{3}{8}'' = 1'-0''$ BT-S-606 BT-S-605

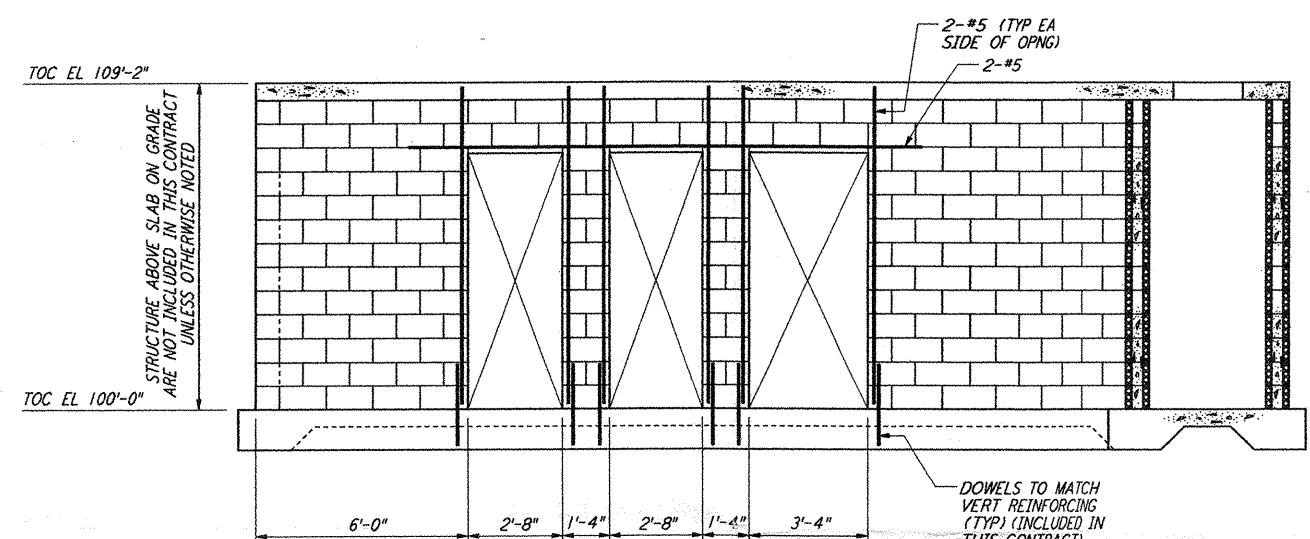


ELEVATION E REF
 $\frac{3}{8}'' = 1'-0''$ BT-S-606 BT-S-605

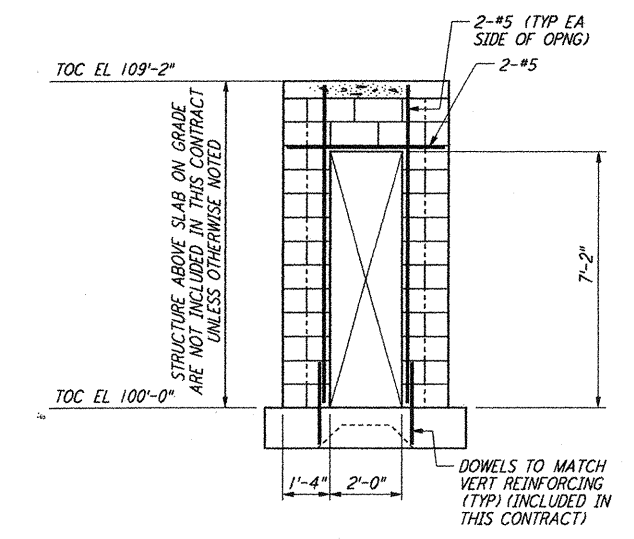

ELEVATION F REF
 $\frac{3}{8}'' = 1'-0''$ BT-S-606 BT-S-605

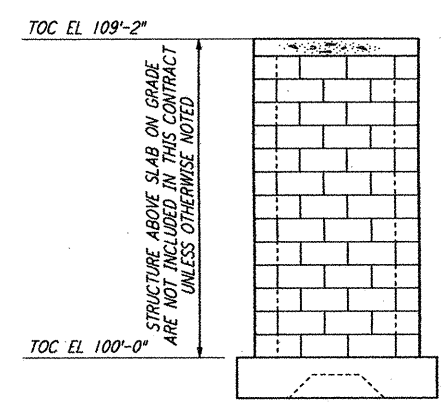

ELEVATION G REF
 $\frac{3}{8}'' = 1'-0''$ BT-S-606 BT-S-605

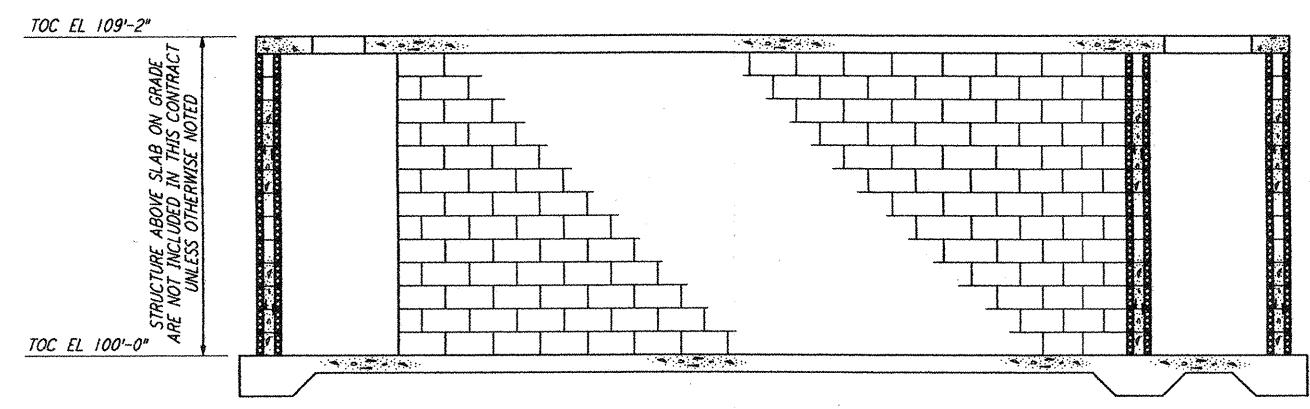

ELEVATION H REF
 $\frac{3}{8}'' = 1'-0''$ BT-S-606 BT-S-605

LIGO-D960740-00-O
 0 2 4 6 8 10 FT
 $\frac{3}{8}'' = 1'-0''$

NO.	DATE	BY	CHKD	ENGR	PROJ	DESCRIPTION
0	1-22-99	MEI	--	--	MDW	ISSUED FOR AS BUILT
A	4-19-96	MCS	KS	BP		CHANGE ORDER #4

AS-BUILT DRAWINGS

PARSONS
 100 WEST WALNUT STREET
 PASADENA, CALIFORNIA

LIGO
 CALIFORNIA INSTITUTE OF TECHNOLOGY
 MASSACHUSETTS INSTITUTE OF TECHNOLOGY

LASER INTERFEROMETER
 GRAVITATIONAL-WAVE OBSERVATORY
 BTE SITEWORK & FABRICATION - HANFORD, WA

TITLE	SCALE	CONTRACT NUMBER	PROJECT NUMBER
STRUCTURAL MID & END STATIONS "B" AIR HANDLING UNIT ENCLOSURE ELEV & SECTS	AS NOTED	PP150969	8094
SHEET NUMBER		REVISIONS	
BT-S-606			