


LIST OF MATERIAL

ITEM NO.	QTY	DESCRIPTION
1	1	SERVIT POST, #2-#2/0 WIRES, BURNDY K2C26
2	1	CONNECTOR, TWO #4-#2/0 WIRE FLAT BAR, BURNDY TYPE GCM26 (LONGER BOLT AS REQ'D)


MOTOR GROUNDING (1) REF
 N. T. S.

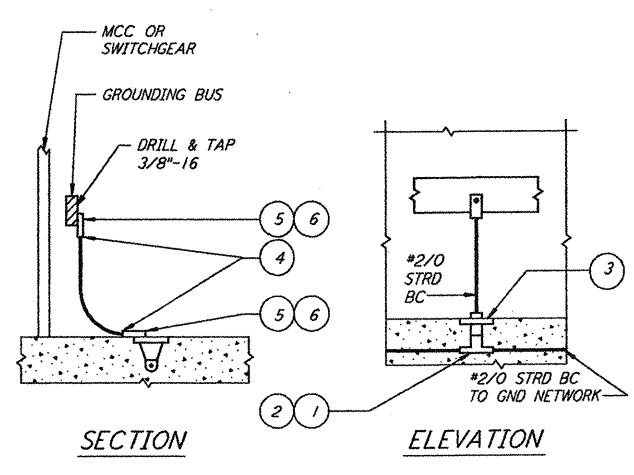

LIST OF MATERIAL

ITEM NO.	QTY	DESCRIPTION
1	AR	MOLD HORIZONTAL TEE, #4/0-#4/0 WIRE
2	1	CARTRIDGE, STANDARD POWDER 150 GRAMS
3	1	FLUSH PLATE, #4/0 WIRE SIZE, 3/8\"/>
4	2	LUG, #1/0-#2/0 WIRE x 3/8\"/>
5	2	SILICONE-BRONZE BOLT, 3/8\"/>
6	2	SILICONE-BRONZE LOCKWASHER SPRING 3/8\"/>


SWITCHGEAR OR CONTROL PANEL GROUNDING (2) REF
 N. T. S.

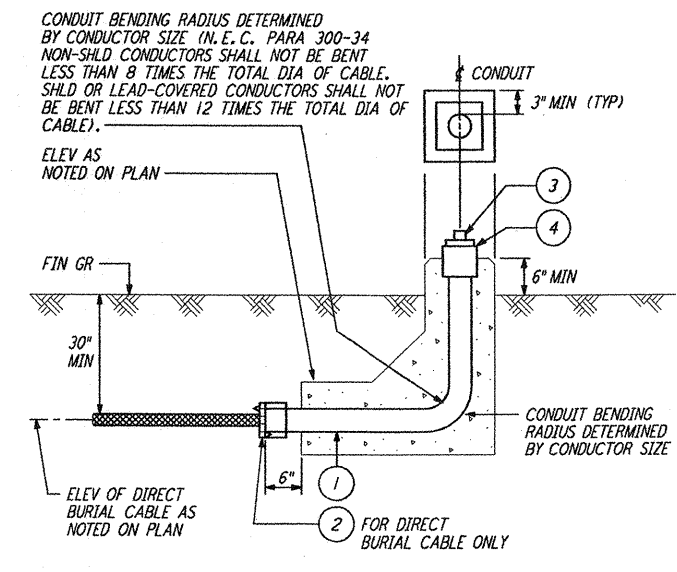

LIST OF MATERIAL

ITEM NO.	QTY	DESCRIPTION
1	AR	CONDUIT, RIGID GALVANIZED STEEL, SIZE PER PLAN
2	1	CONDUIT BUSHING, NON-INSULATED GALV, PER CONDUIT SIZE
3	1	PLUG, SO HD RIGID ALUM, PER CONDUIT SIZE
4	1	CONDUIT COUPLING, RIGID GALVANIZED STEEL, PER CONDUIT SIZE

CONDUIT STUB-UP (3) REF
 N. T. S.

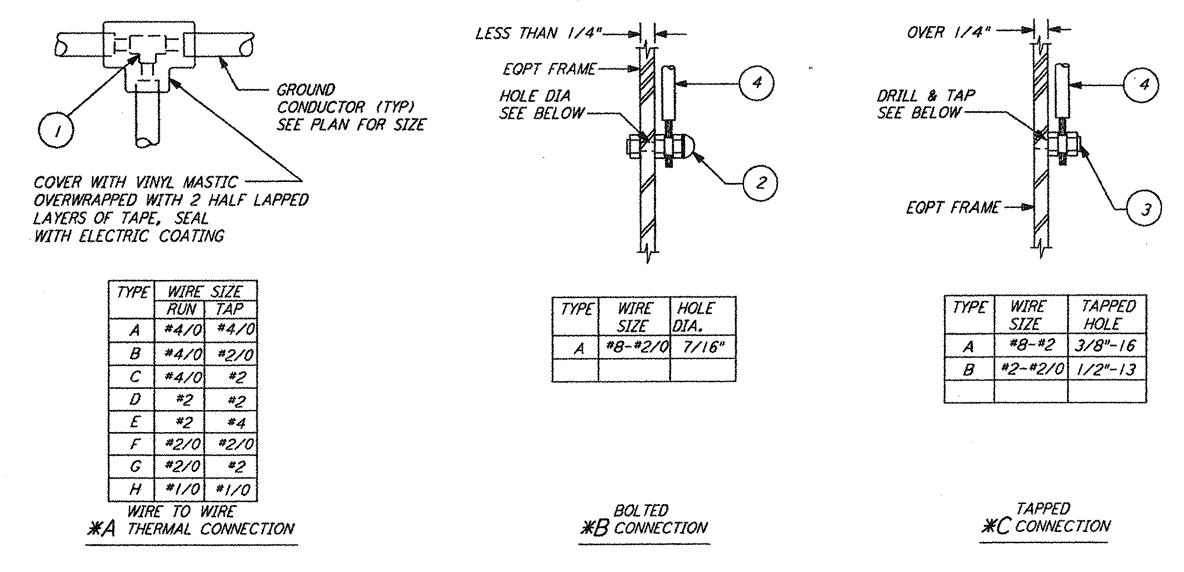

WIRE TO WIRE

TYPE	WIRE SIZE	WIRE TAP
A	#4/0	#4/0
B	#4/0	#2/0
C	#4/0	#2
D	#2	#2
E	#2	#4
F	#2/0	#2/0
G	#2/0	#2
H	#1/0	#1/0

BOLTED CONNECTION

TYPE	WIRE SIZE	HOLE DIA.
A	#8-#2/0	7/16\"/>


TAPPED CONNECTION

TYPE	WIRE SIZE	TAPPED HOLE
A	#8-#2	3/8\"/>
B	#2-#2/0	1/2\"/>

LIST OF MATERIAL

ITEM NO.	QTY	DESCRIPTION
1	1	THERMAL WELD, GROUND, SIZE AS REQUIRED
2	1	GROUND CONNECTOR, CABLE TO BAR, SIZE AS REQUIRED
3	1	GROUND POST, SIZE AS REQUIRED
4	AR	TYPE "TW" INSULATED GREEN GROUND WIRE (UNLESS OTHERWISE NOTED)


GROUNDING CONNECTIONS (4) REF
 N. T. S.

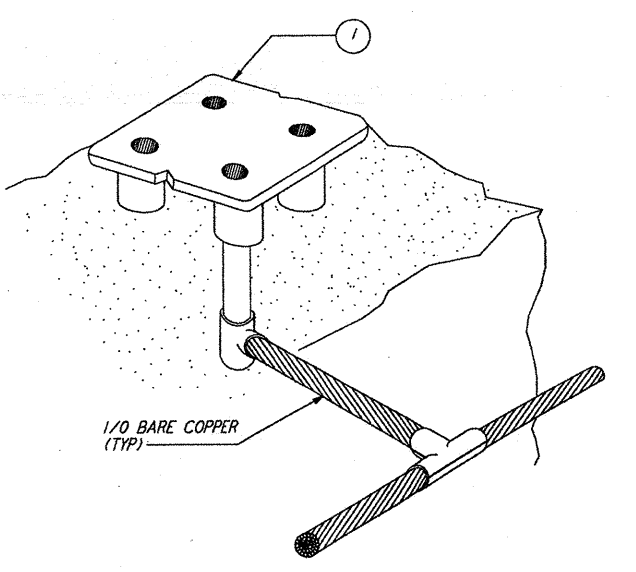

LIST OF MATERIAL

ITEM NO.	QTY	DESCRIPTION
1	1	GROUND PLATE, FLUSH, CADWELD #B16420

FLUSH FLOOR GROUND PLATE (5) REF
 N. T. S.

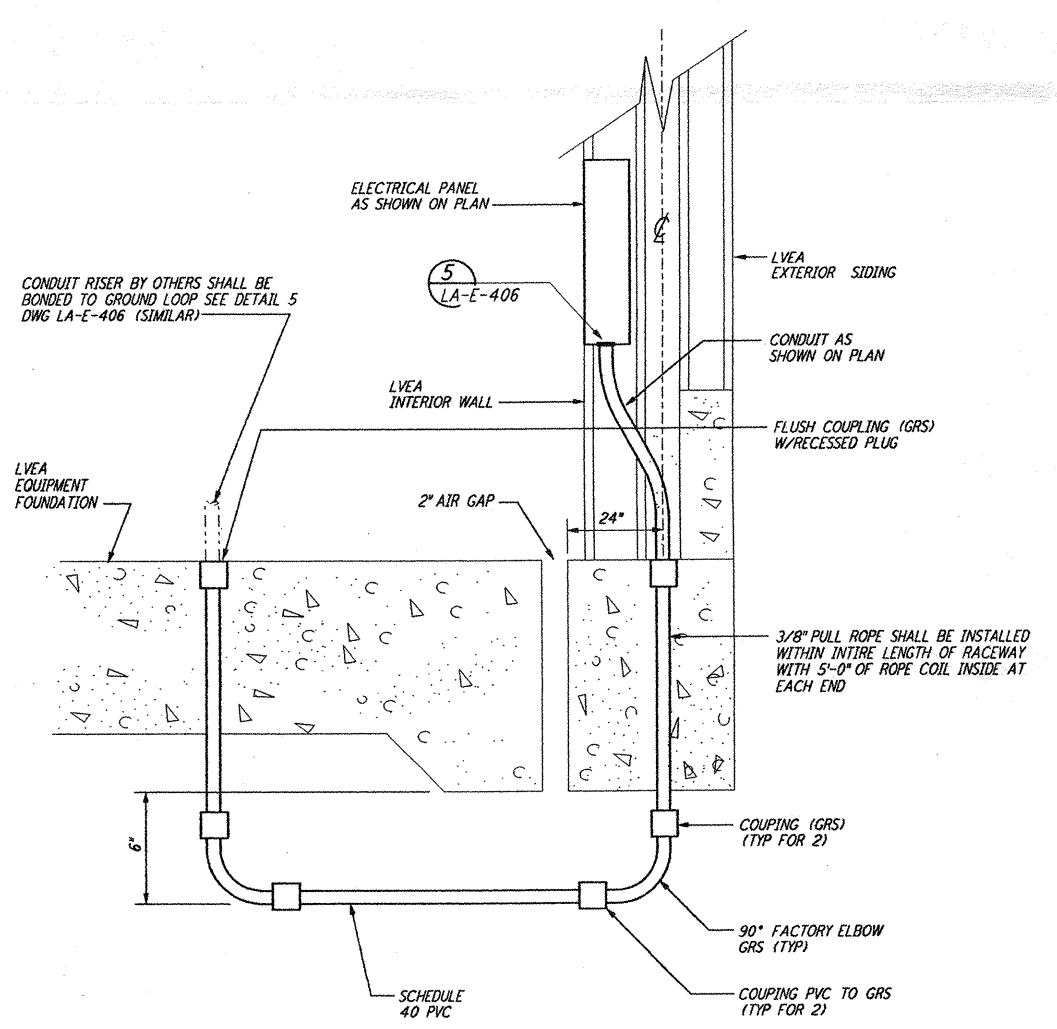

LVEA CONDUIT FLOOR RISER (6) REF
 N. T. S.

LIGO-D960745-00-0

NO.	DATE	BY	CHKD	ENGR	PROJ	DESCRIPTION
O	1-22-99	MET	--	--	MDW	ISSUED FOR AS BUILT
A	4-15-96				TDM	CHANGE ORDER #4

DRAWN M. M.
 CHECKED
 ENGINEER
 PROJ
AS-BUILT DRAWINGS

PARSONS
 100 WEST WALNUT STREET
 PASADENA, CALIFORNIA

LIGO
 CALIFORNIA INSTITUTE OF TECHNOLOGY
 MASSACHUSETTS INSTITUTE OF TECHNOLOGY

LASER INTERFEROMETER
 GRAVITATIONAL-WAVE OBSERVATORY
 BTE SITENETWORK & FABRICATION - HANFORD, WA
 TITLE
 SCALE NONE
 CONTRACT NUMBER PPI50969
 PROJECT NUMBER 8094
 SHEET NUMBER
BT-E-603
 REVISIONS