



NOTES:


1. CAP ALL PIPING STUB-UPS 12" ABOVE FINISHED FLOOR.
2. - - - - - INDICATES WORK TO BE DONE BY OTHERS.

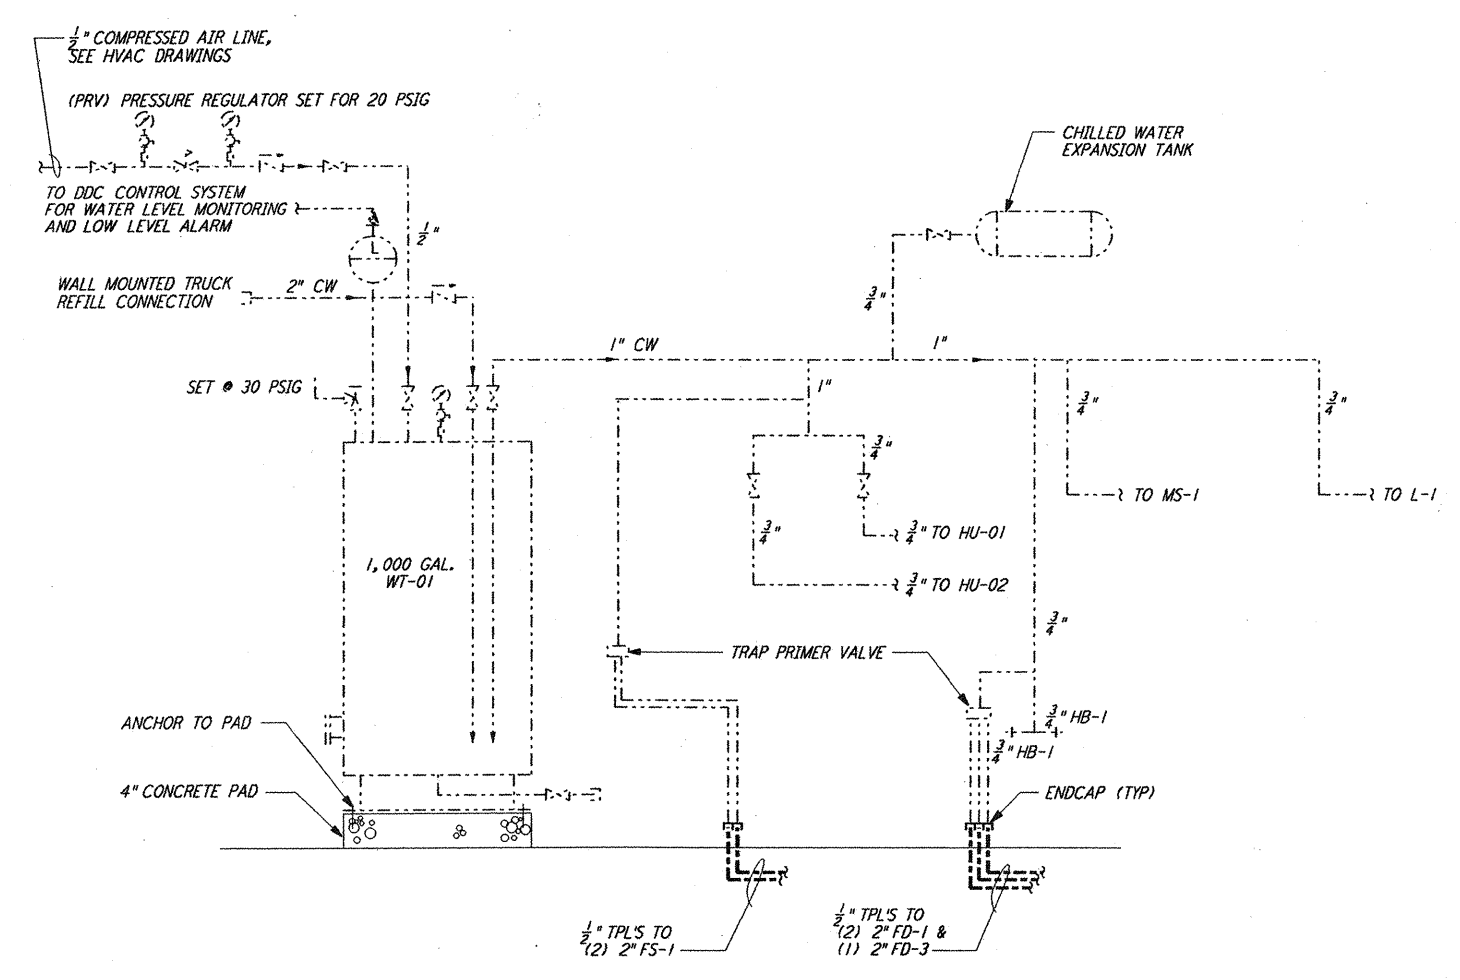

DOMESTIC WATER SUPPLY SYSTEM
 (TYP FOR 2 STATIONS)

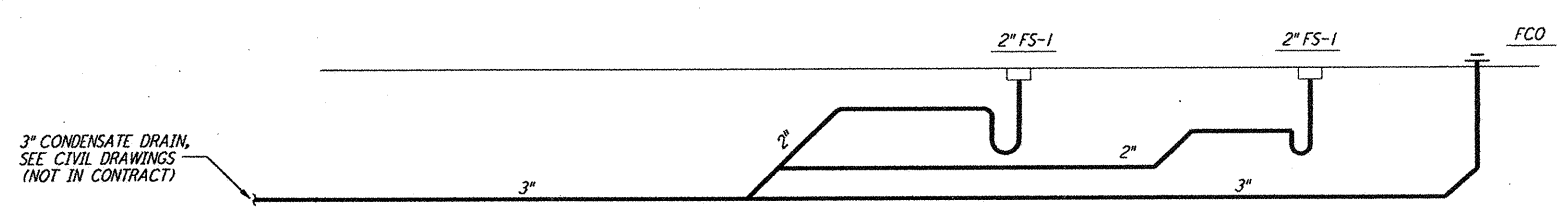

SANITARY SEWER PIPING SCHEMATIC FOR MECH ROOM 203
 (TYP FOR 2 STATIONS)

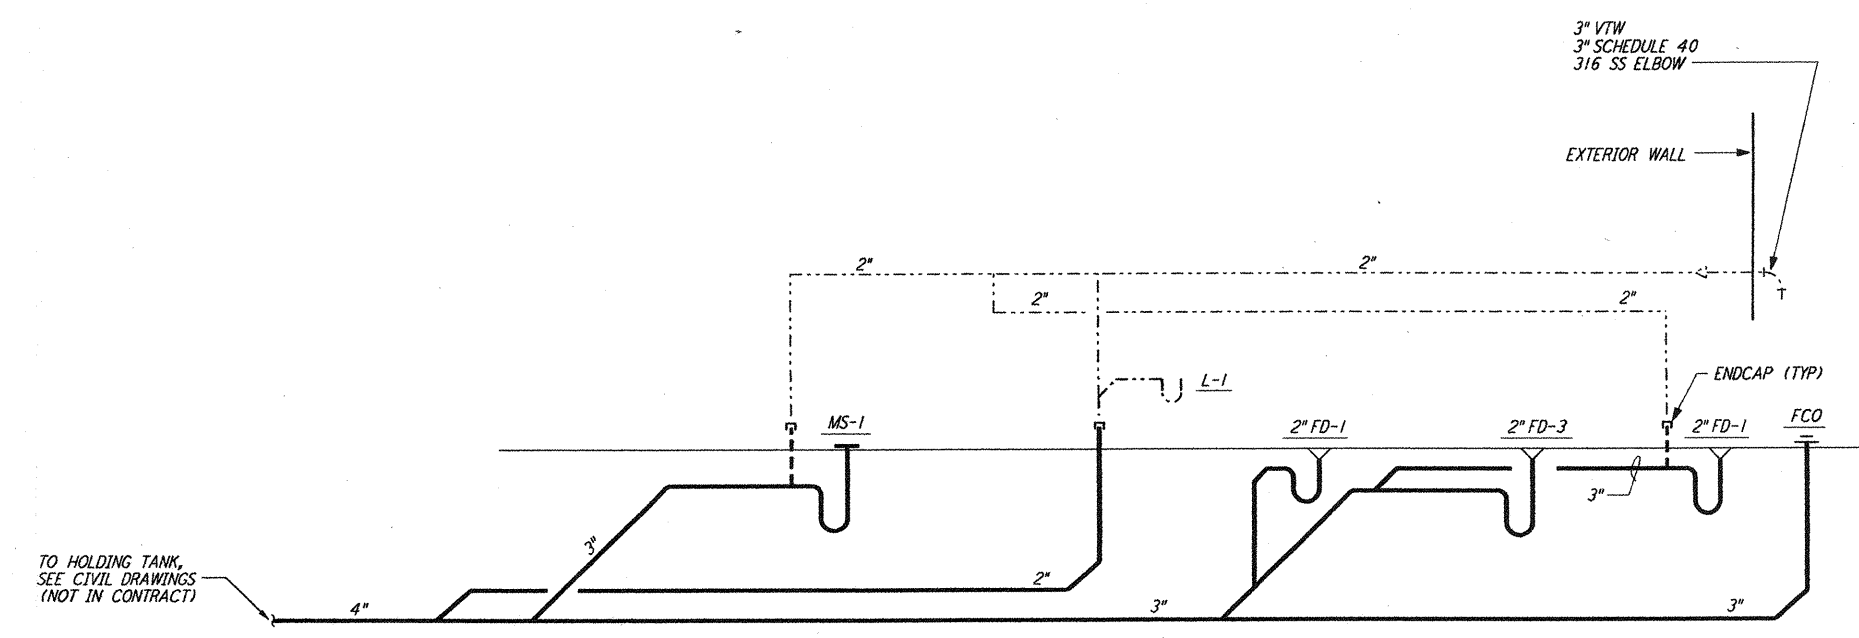

SANITARY SEWER PIPING SCHEMATIC FOR RESTROOM & CLEANING AREA
 (TYP FOR 2 STATIONS)

LIGO-D960748-00-0

NO.	DATE	BY	CHKD	ENGR	PROJ	DESCRIPTION
O	1-22-99	MET	--	--	MDW	ISSUED FOR AS BUILT
A	4-19-96	CLP				CHANGE ORDER #4

DRAWN	CLP
CHECKED	
ENGINEER	
PROJ	

AS-BUILT DRAWINGS

PARSONS
 100 WEST WALNUT STREET
 PASADENA, CALIFORNIA

LIGO
 CALIFORNIA INSTITUTE OF TECHNOLOGY
 MASSACHUSETTS INSTITUTE OF TECHNOLOGY

LASER INTERFEROMETER
 GRAVITATIONAL-WAVE OBSERVATORY
 BTE SITEWORK & FABRICATION - HANFORD, WA

TITLE	SCALE	CONTRACT NUMBER	PROJECT NUMBER
PLUMBING MID & END STATIONS "B" RISER DIAGRAM & SCHEMATICS	NONE	PP150969	8094
SHEET NUMBER		REVISIONS	
BT-P-602			

not be reproduced, copied, loaned, exhibited, or used in any other way, except by written consent from PARSONS to the borrower.

This document and the design it covers are the property of PARSONS. They are loaned only with the borrower's expressed written agreement that they will

Thu Jan 21 13:24:42 1999 C:\PLOT\00E\S3\Y3662.DCF 52895 K:\V3662.m602.dpf