

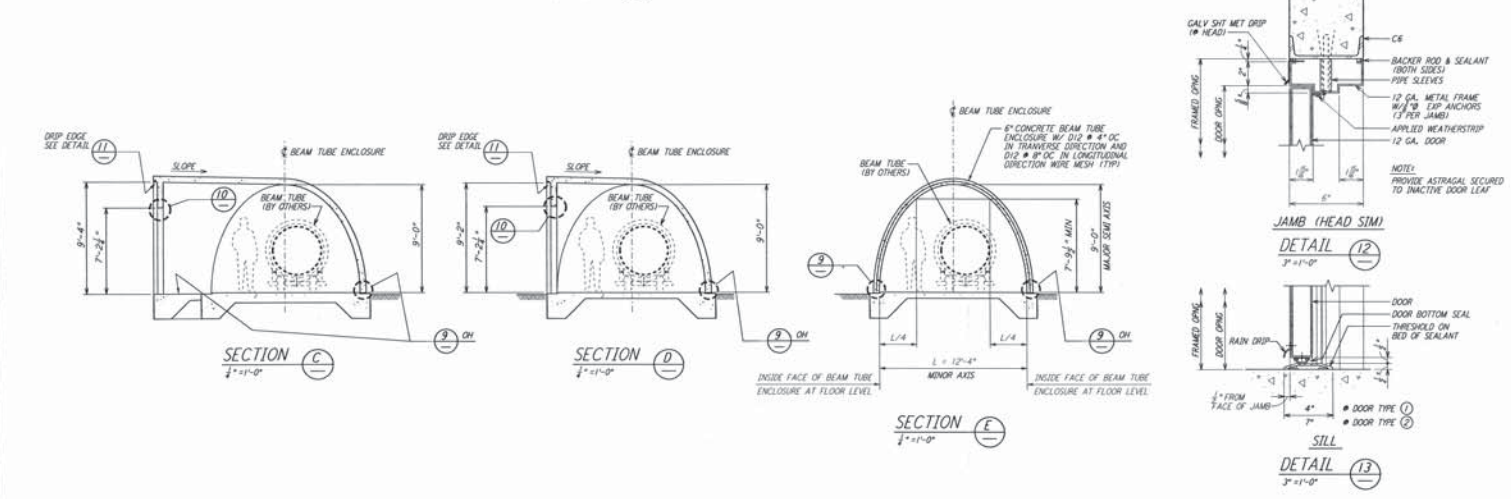
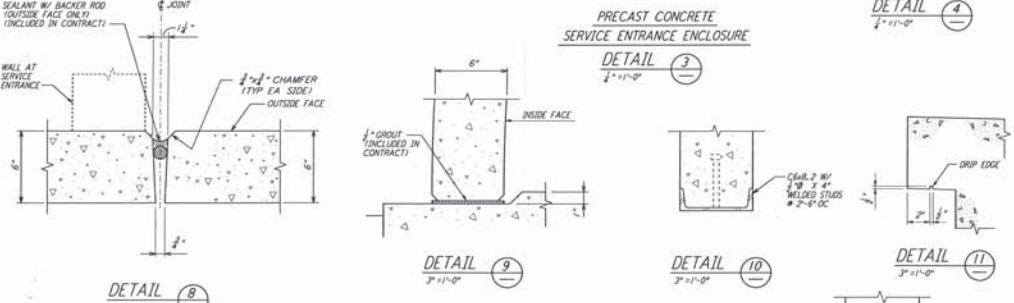
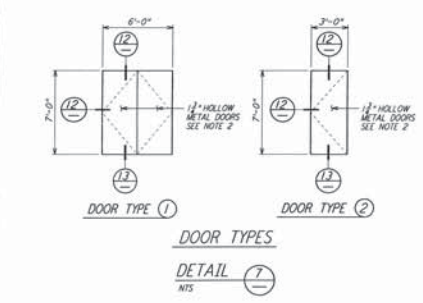
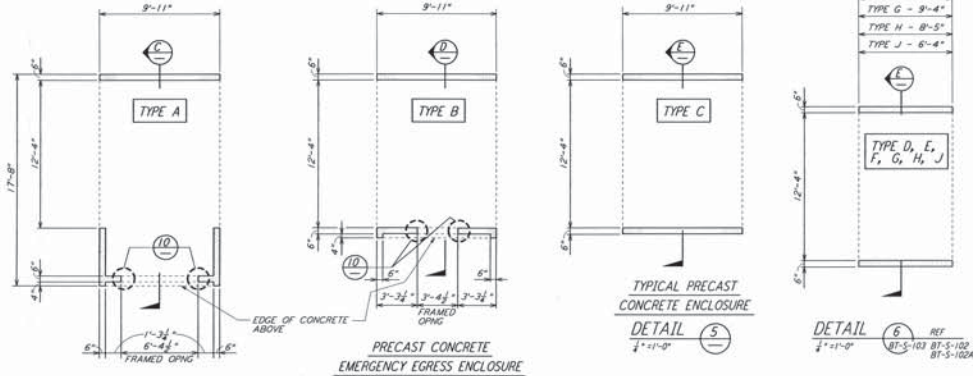


TYPE D	5'-10"
TYPE E	6'-4 1/2"
TYPE F	5'-0"
TYPE G	9'-4"
TYPE H	8'-5"
TYPE J	6'-4"

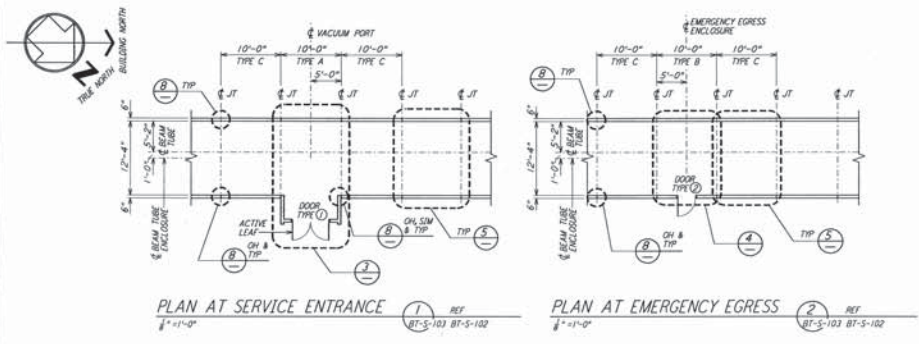

- NOTES:**
- FOR GENERAL NOTES, ABBREVIATIONS AND LEGEND SEE DRAWING BT-S-101.
  - ALL DOORS, DOOR HARDWARES AND INSTALLATION OF DOORS TO BEAM TUBE ENCLOSURE ARE INCLUDED IN THIS CONTRACT.

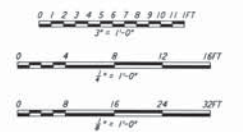

This document and the design it covers are the property of PARSONS. They are loaned only with the borrower's expressed written agreement that they will not be reproduced, copied, loaned, exhibited, or used in any other way, except by written consent from PARSONS to the borrower.

ISSUED FOR CONSTRUCTION	DR	SH	6-24-96
CHECKED	ENGINEER	PROJ	
<b>AS-BUILT DRAWINGS</b>			
NO.	DATE	BY	ENGR ENPR PROJ
1	1-22-99	MEY	--- MOJ ISSUED FOR AS BUILT

<p>100 WEST WALNUT STREET PASADENA, CALIFORNIA</p>	<p>CALIFORNIA INSTITUTE OF TECHNOLOGY MASSACHUSETTS INSTITUTE OF TECHNOLOGY</p>	<p>LASER INTERFEROMETER GRAVITATIONAL-WAVE OBSERVATORY BTE INSTALLATION - HANFORD, WA</p>	
		<p>STRUCTURAL BEAM TUBE ENCLOSURE PLANS, SECTIONS &amp; DETAILS</p>	<p>AS NOTED PP150969 8094</p> <p><b>BT-S-103</b></p>