


LASER INTERFEROMETER GRAVITATIONAL-WAVE OBSERVATORY

LIVINGSTON FACILITY ISSUED FOR CONSTRUCTION BUILDING AND INFRASTRUCTURE CONSTRUCTION

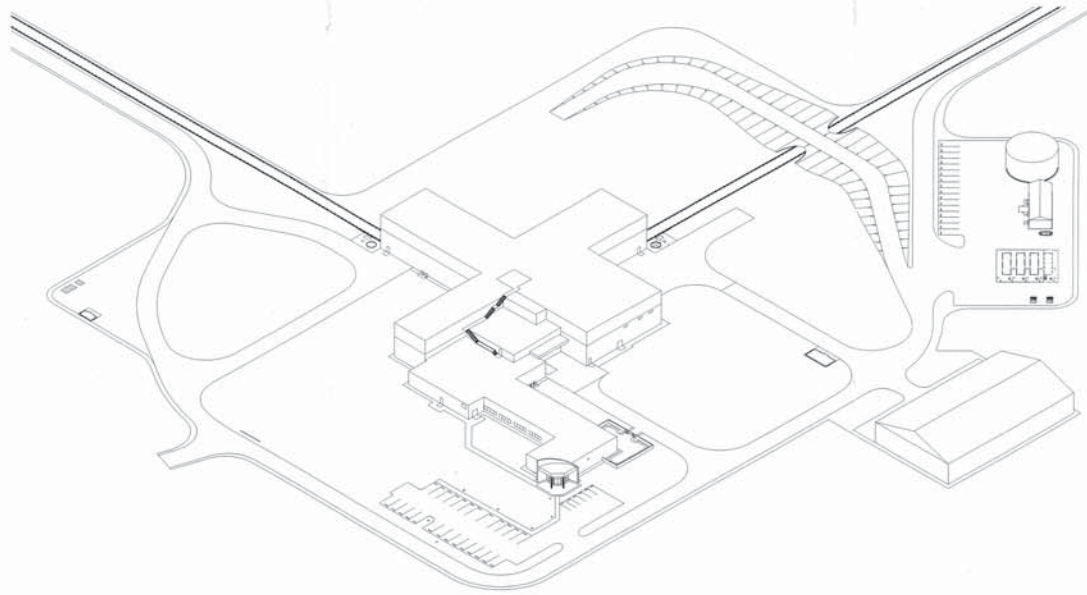

**SITE NO. 2
LIVINGSTON, LOUISIANA**

LIGO-D960816-03-0

DRAWING LIST

REV	DATE	SHEET NO.	TITLE
3	08-07-98	LA-C-001	GENERAL COVER AND DRAWING INDEX SHEET 1
2	08-07-98	LA-C-002	GENERAL DRAWING INDEX SHEET 2
4	08-07-98	LA-C-003	GENERAL DRAWING INDEX SHEET 3
1	08-07-98	LA-C-001	CIVIL DRAWING INDEX LOCATION & VICINITY MAPS
1	08-07-98	LA-C-002	CIVIL GENERAL NOTES, LEGEND & ABBREVIATIONS
1	08-07-98	LA-C-003	CIVIL DRAWING MATRIX
1	08-07-98	LA-C-004	CIVIL TYPICAL SECTIONS AND DETAILS
2	08-07-98	LA-C-005	CIVIL CORNER STATION PLOT PLAN

DRAWING LIST

REV	DATE	SHEET NO.	TITLE
2	08-07-98	LA-C-006	CIVIL CORNER STATION PLOT PLAN ENLARGED PLAN
2	08-07-98	LA-C-007	CIVIL CORNER STATION GRADING PLAN
2	08-07-98	LA-C-008	CIVIL CORNER STATION GRADING PLAN ENLARGED PLAN
2	08-07-98	LA-C-009	CIVIL CORNER STATION UTILITY PLAN
2	08-07-98	LA-C-010	CIVIL CORNER STATION UTILITY PLAN ENLARGED PLAN
2	08-07-98	LA-C-011	CIVIL SOUTHWEST ARM PLAN AND PROFILE STA 0+00 TO STA 14+00
2	08-07-98	LA-C-012	CIVIL SOUTHWEST ARM PLAN AND PROFILE STA 14+00 TO STA 28+00
2	08-07-98	LA-C-013	CIVIL SOUTHWEST ARM PLAN AND PROFILE STA 28+00 TO STA 42+00
2	08-07-98	LA-C-014	CIVIL SOUTHWEST ARM PLAN AND PROFILE STA 42+00 TO STA 56+00
2	08-07-98	LA-C-015	CIVIL SOUTHWEST ARM PLAN AND PROFILE STA 56+00 TO STA 70+00
2	08-07-98	LA-C-016	CIVIL SOUTHWEST ARM PLAN AND PROFILE STA 70+00 TO STA 84+00

DRAWING LIST

REV	DATE	SHEET NO.	TITLE
2	08-07-98	LA-C-017	CIVIL SOUTHWEST ARM PLAN AND PROFILE STA 84+00 TO STA 98+00
2	08-07-98	LA-C-018	CIVIL SOUTHWEST ARM PLAN AND PROFILE STA 98+00 TO STA 112+00
2	08-07-98	LA-C-019	CIVIL SOUTHWEST ARM PLAN AND PROFILE STA 112+00 TO STA 126+00
2	08-07-98	LA-C-020	CIVIL SOUTHWEST ARM PLAN AND PROFILE STA 126+00 TO STA 132+00
2	08-07-98	LA-C-021	CIVIL SOUTHWEST ARM PUMP STATION PLOT PLAN
2	08-07-98	LA-C-022	CIVIL SOUTHWEST ARM PUMP STATION GRADING PLAN
2	08-07-98	LA-C-023	CIVIL SOUTHWEST ARM PUMP STATION UTILITY PLAN
1	08-07-98	LA-C-025	CIVIL SOUTHWEST ARM END STATION PLOT PLAN
1	08-07-98	LA-C-026	CIVIL SOUTHWEST ARM END STATION GRADING PLAN
1	08-07-98	LA-C-027	CIVIL SOUTHWEST ARM END STATION UTILITY PLAN
2	08-07-98	LA-C-031	CIVIL SOUTHWEST ARM PLAN AND PROFILE STA 0+00 TO STA 14+00

REV	DATE	BY	CHKD	ENGR	PROJ	DESCRIPTION
3	08-07-98	ME1	ME1	ME1	ME1	ISSUED FOR AS-BUILT
2	04-22-94	ME1	TDM	ME1	TDM	UPDATED INDEX SHEET
1	02-21-93	ME1	TDM	ME1	TDM	ADDED REV COLUMN & UPDATED INDEX SHEET

ISSUED FOR CONSTRUCTION			
DRAWN	AGC	11-15-96	
CHECKED	TDM	11-15-96	
ENGINEER	ME1	11-15-96	
PROJ	TDM	11-15-96	
AS-BUILT DRAWINGS			

PARSONS
100 WEST WALNUT STREET
PASADENA, CALIFORNIA

LIGO
CALIFORNIA INSTITUTE OF TECHNOLOGY,
MASSACHUSETTS INSTITUTE OF TECHNOLOGY

LASER INTERFEROMETER
GRAVITATIONAL-WAVE OBSERVATORY
SITE NO. 2 - LIVINGSTON, LOUISIANA

TITLE	GENERAL COVER AND DRAWING INDEX SHEET 1	NONE	PP150969	8094
LA-G-001				

This document and the design it covers are the property of PARSONS. It may not be reproduced, stored, or used in any manner without the prior written consent of PARSONS.