

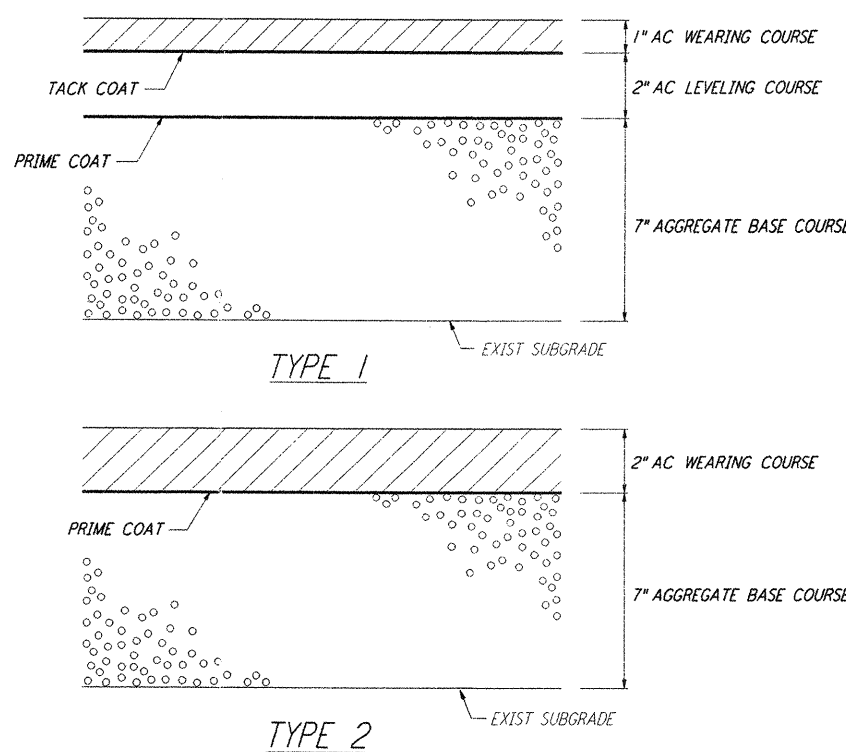
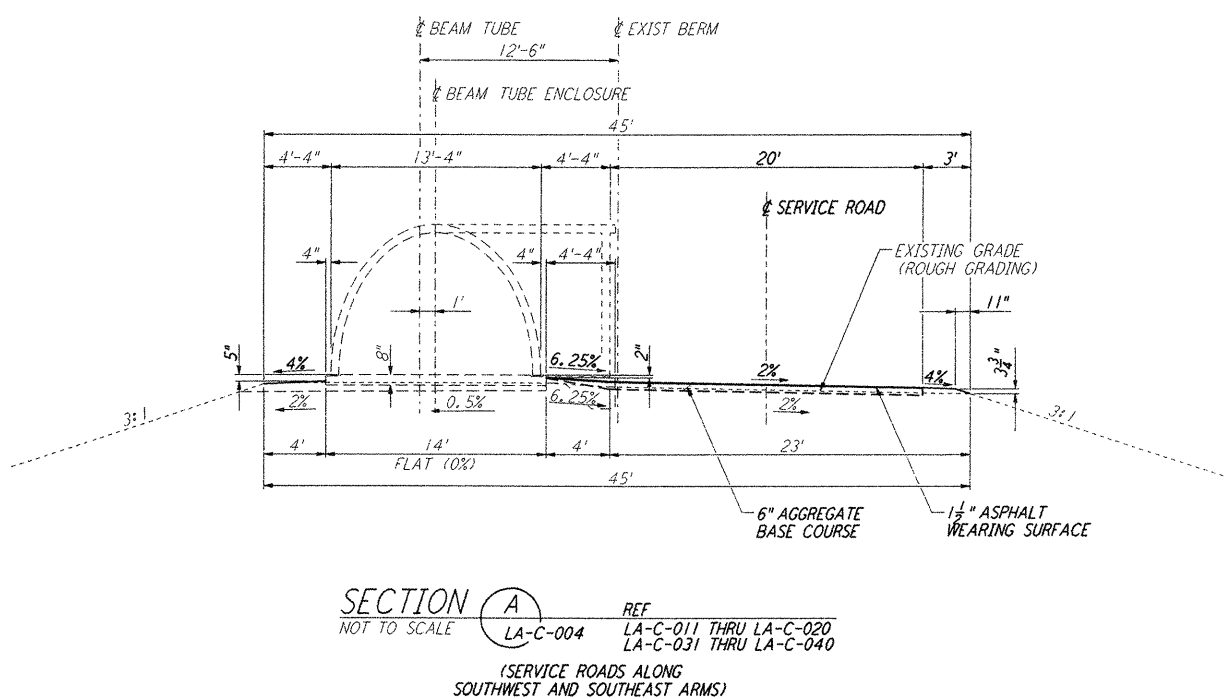
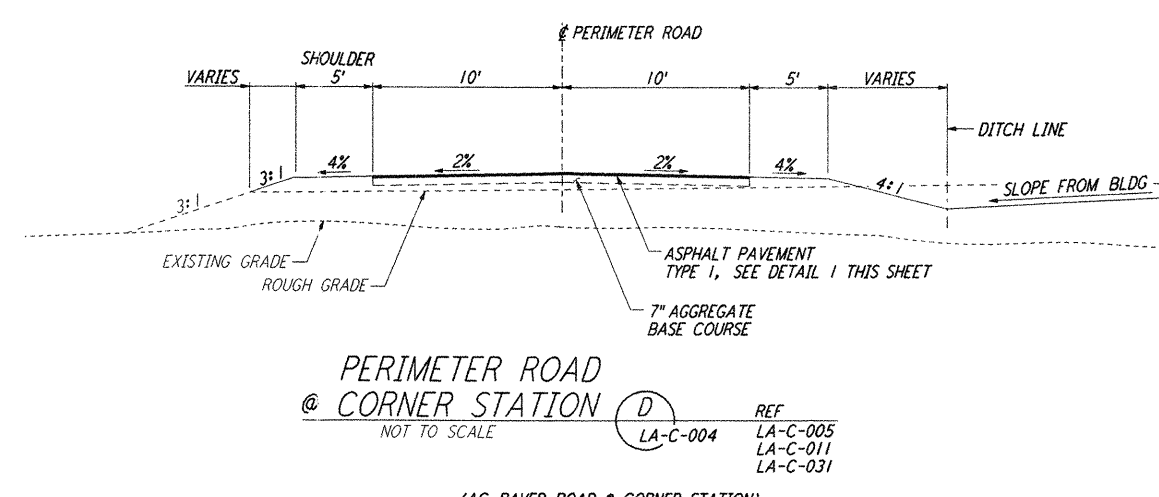
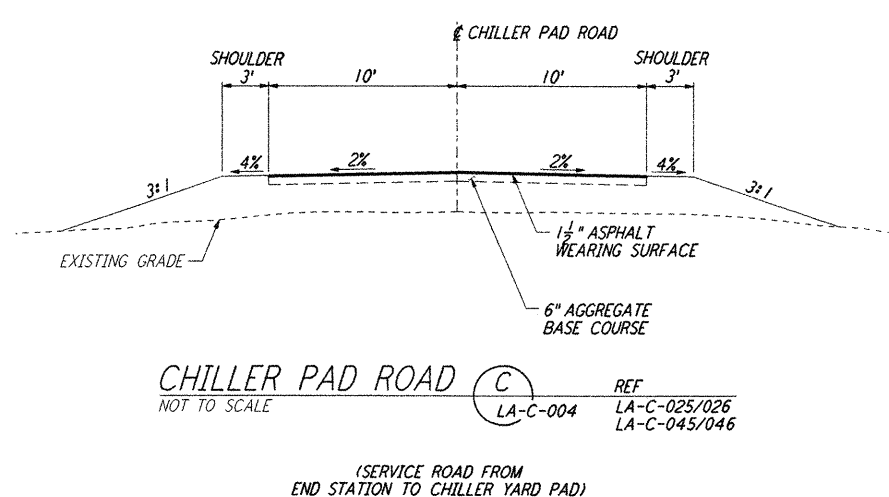


This document and the design it covers are the property of PARSONS. They are loaned only with the borrower's expressed written agreement that they will not be reproduced, copied, loaned, exhibited, or used in any other way, except by written consent from PARSONS to the borrower.

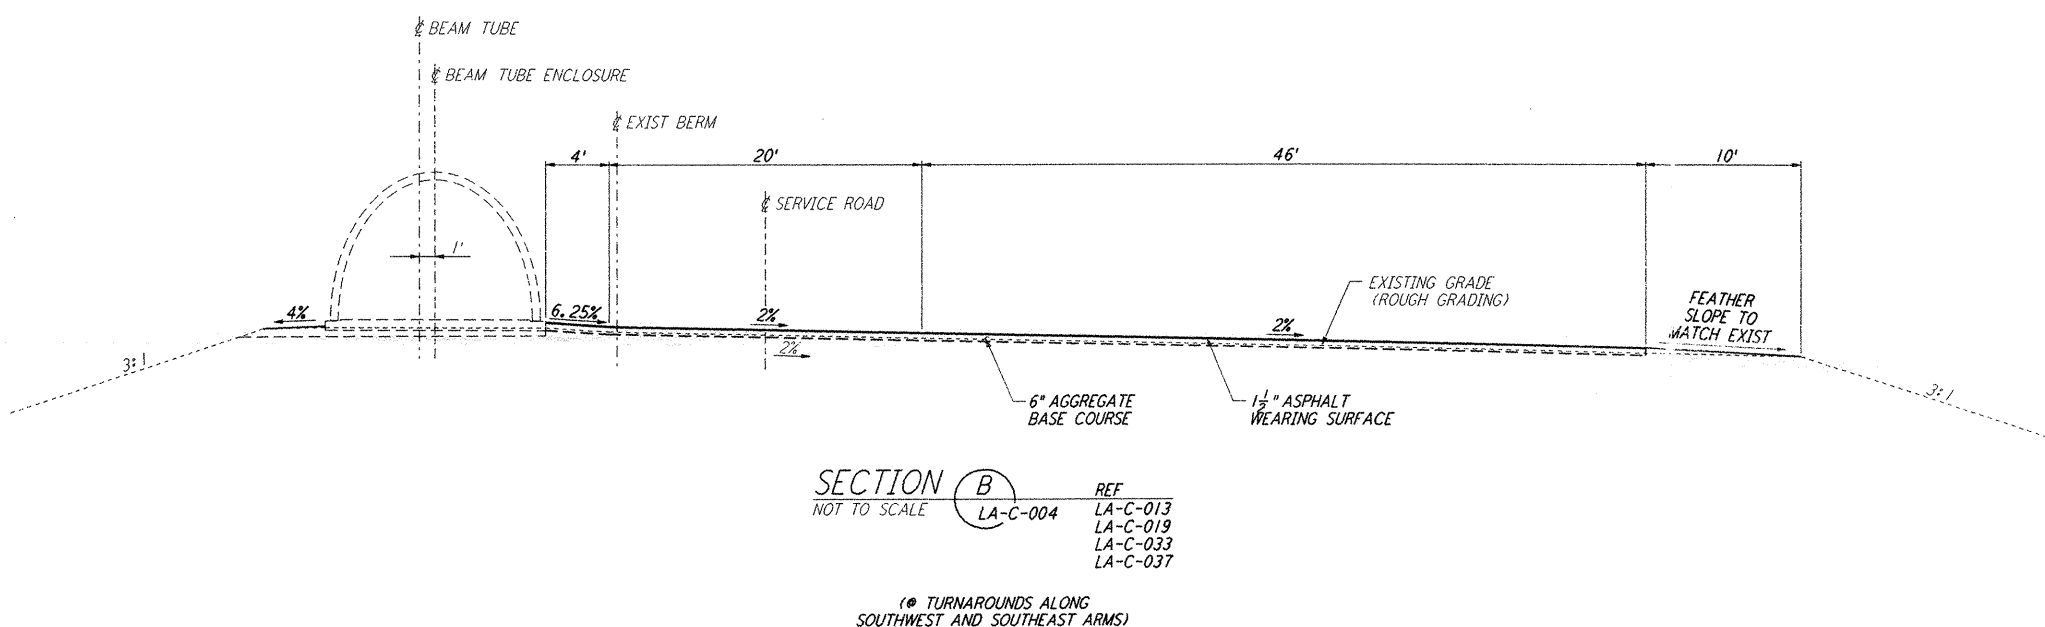

NOTES:
1. SEE SHEET LA-C-002 FOR GENERAL NOTES, LEGEND AND ABBREVIATIONS.

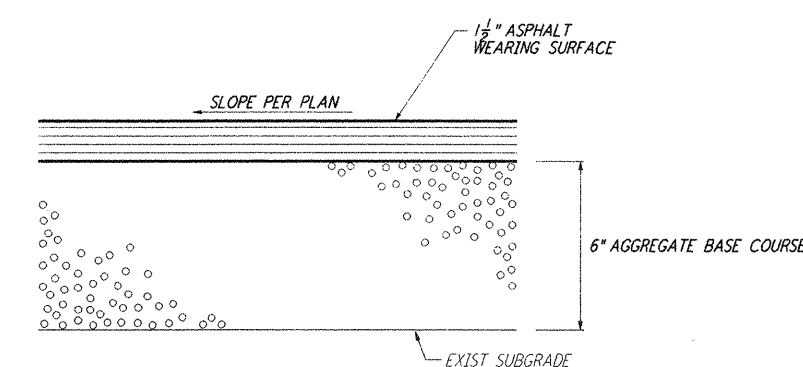

NO.	DATE	BY	CHKD	ENGR	PROJ	DESCRIPTION
1	08-07-98	WRB	Q2	YD	WLD	ISSUED FOR AS-BUILT

ISSUED FOR CONSTRUCTION
DRAWN: WRB 11-15-96
CHECKED: JML 11-15-96
ENGINEER: JB 11-15-96
PROJ: TOM 11-15-96
AS-BUILT DRAWINGS



LIGO-D960822-01-0

LASER INTERFEROMETER GRAVITATIONAL-WAVE OBSERVATORY SITE NO. 2 - LIVINGSTON, LOUISIANA

TITLE	SCALE	CONTRACT NUMBER	PROJECT NUMBER
	NONE	PP150969	8094
SHEET NUMBER	REVISIONS		
LA-C-004			