
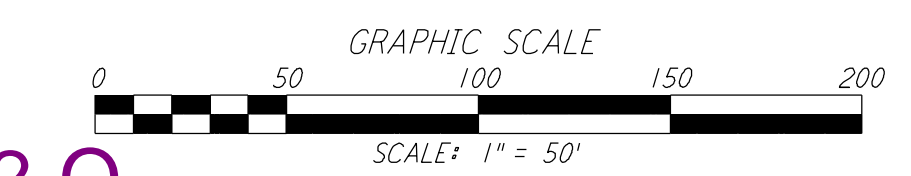
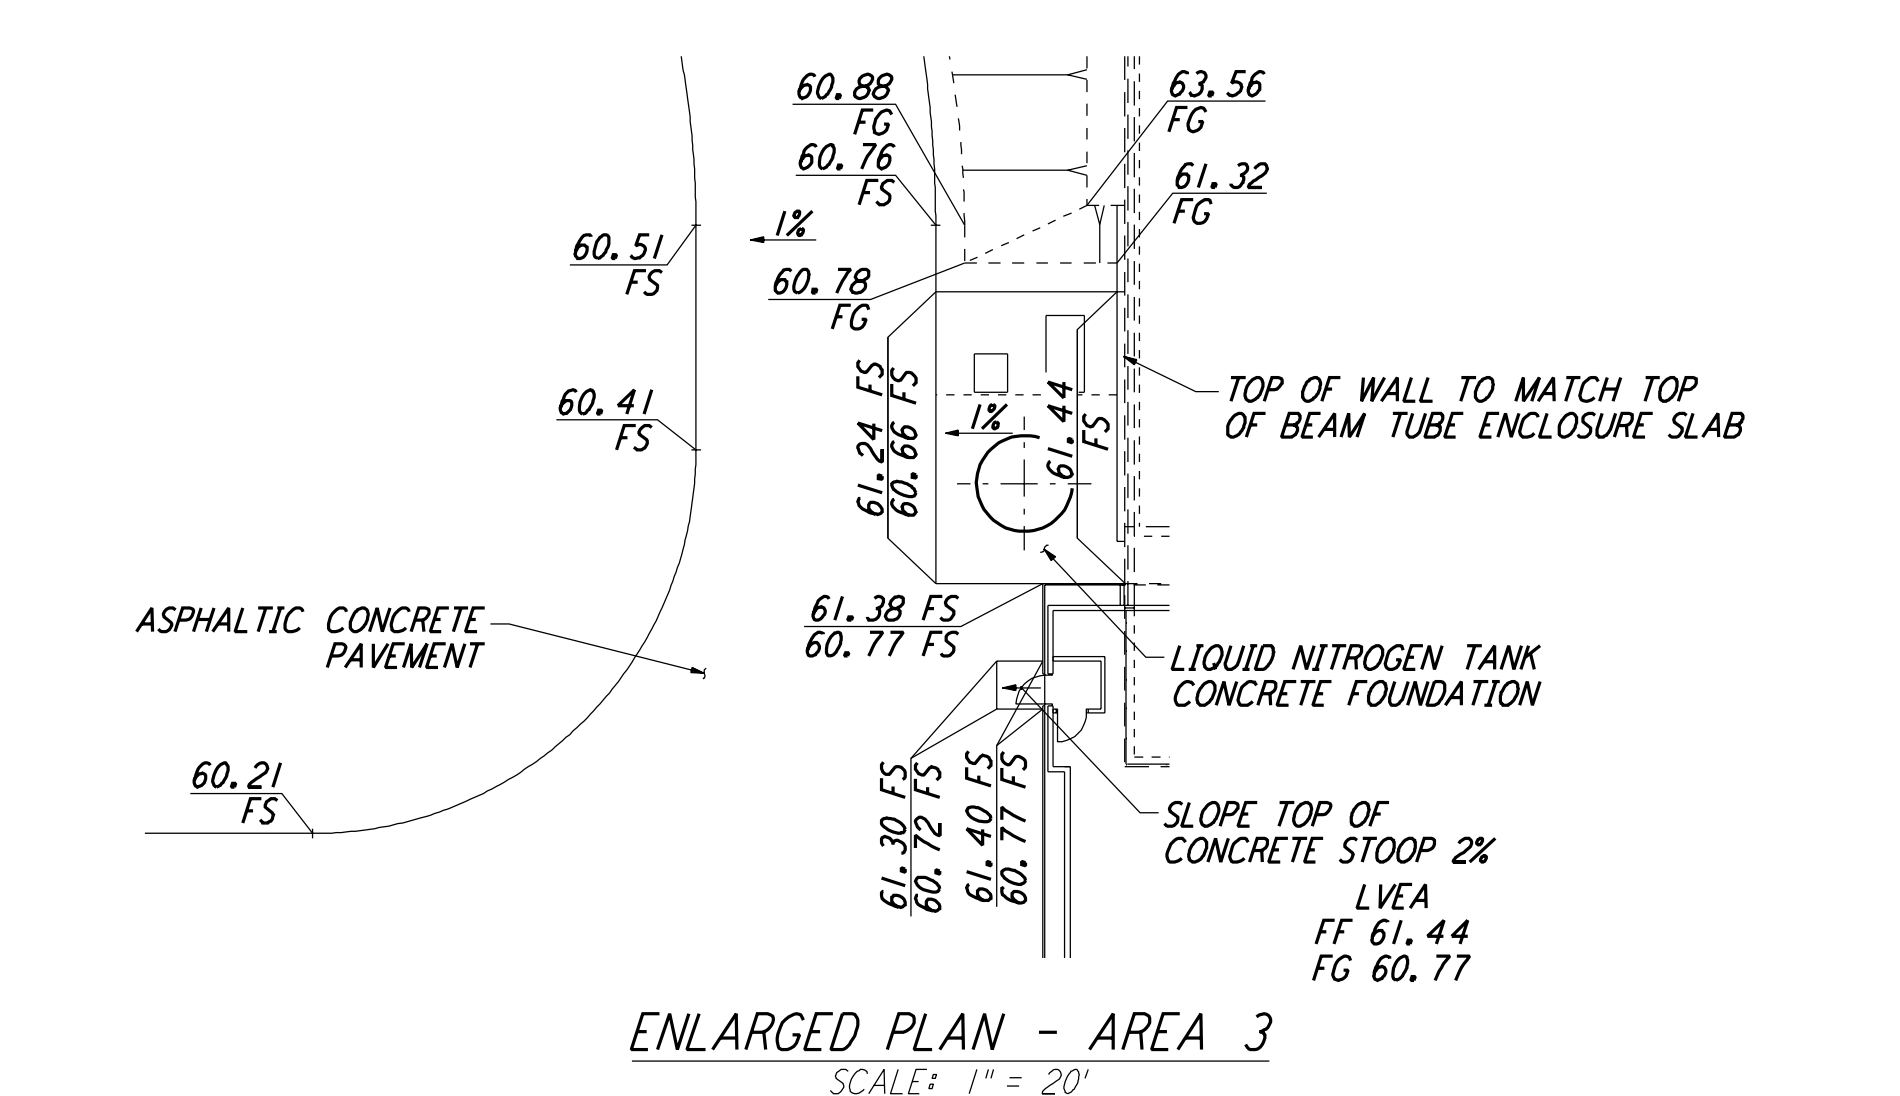
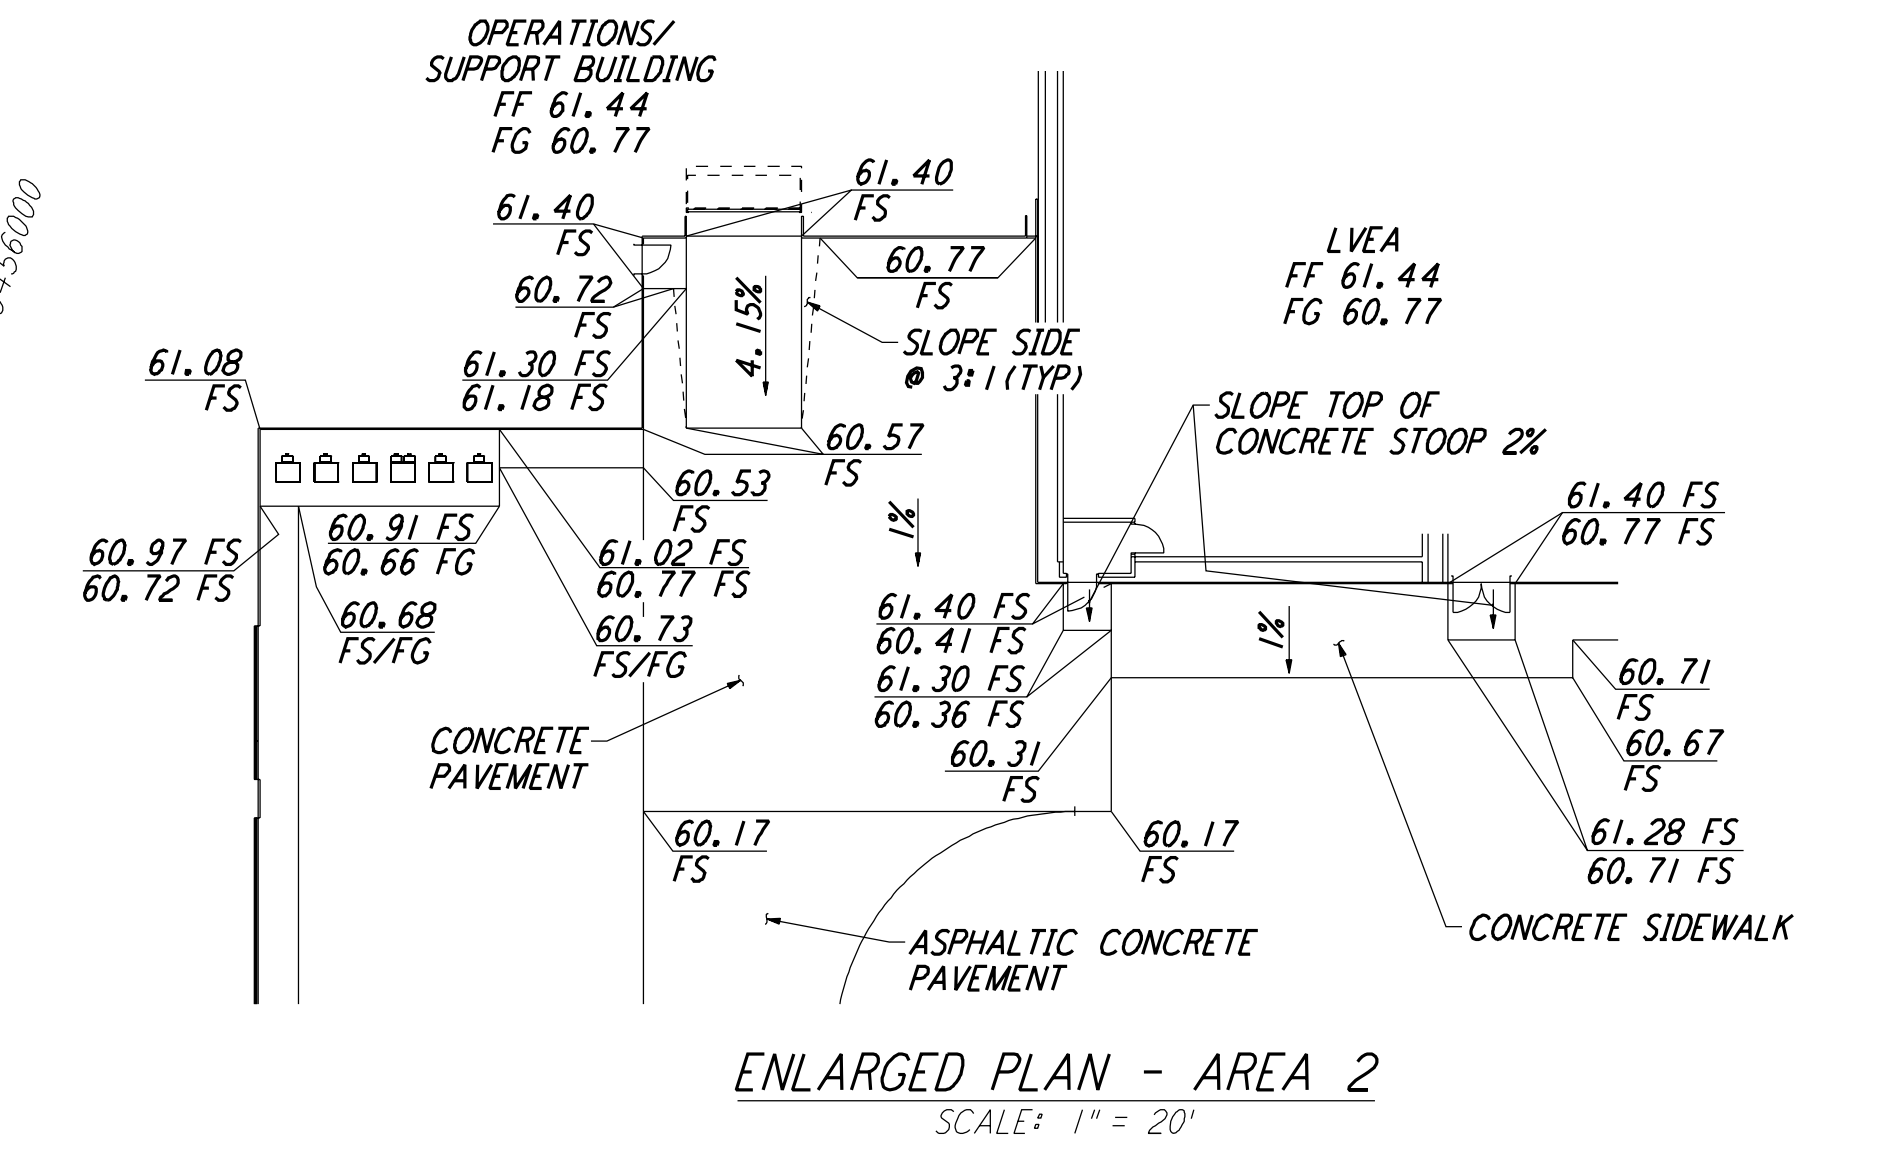
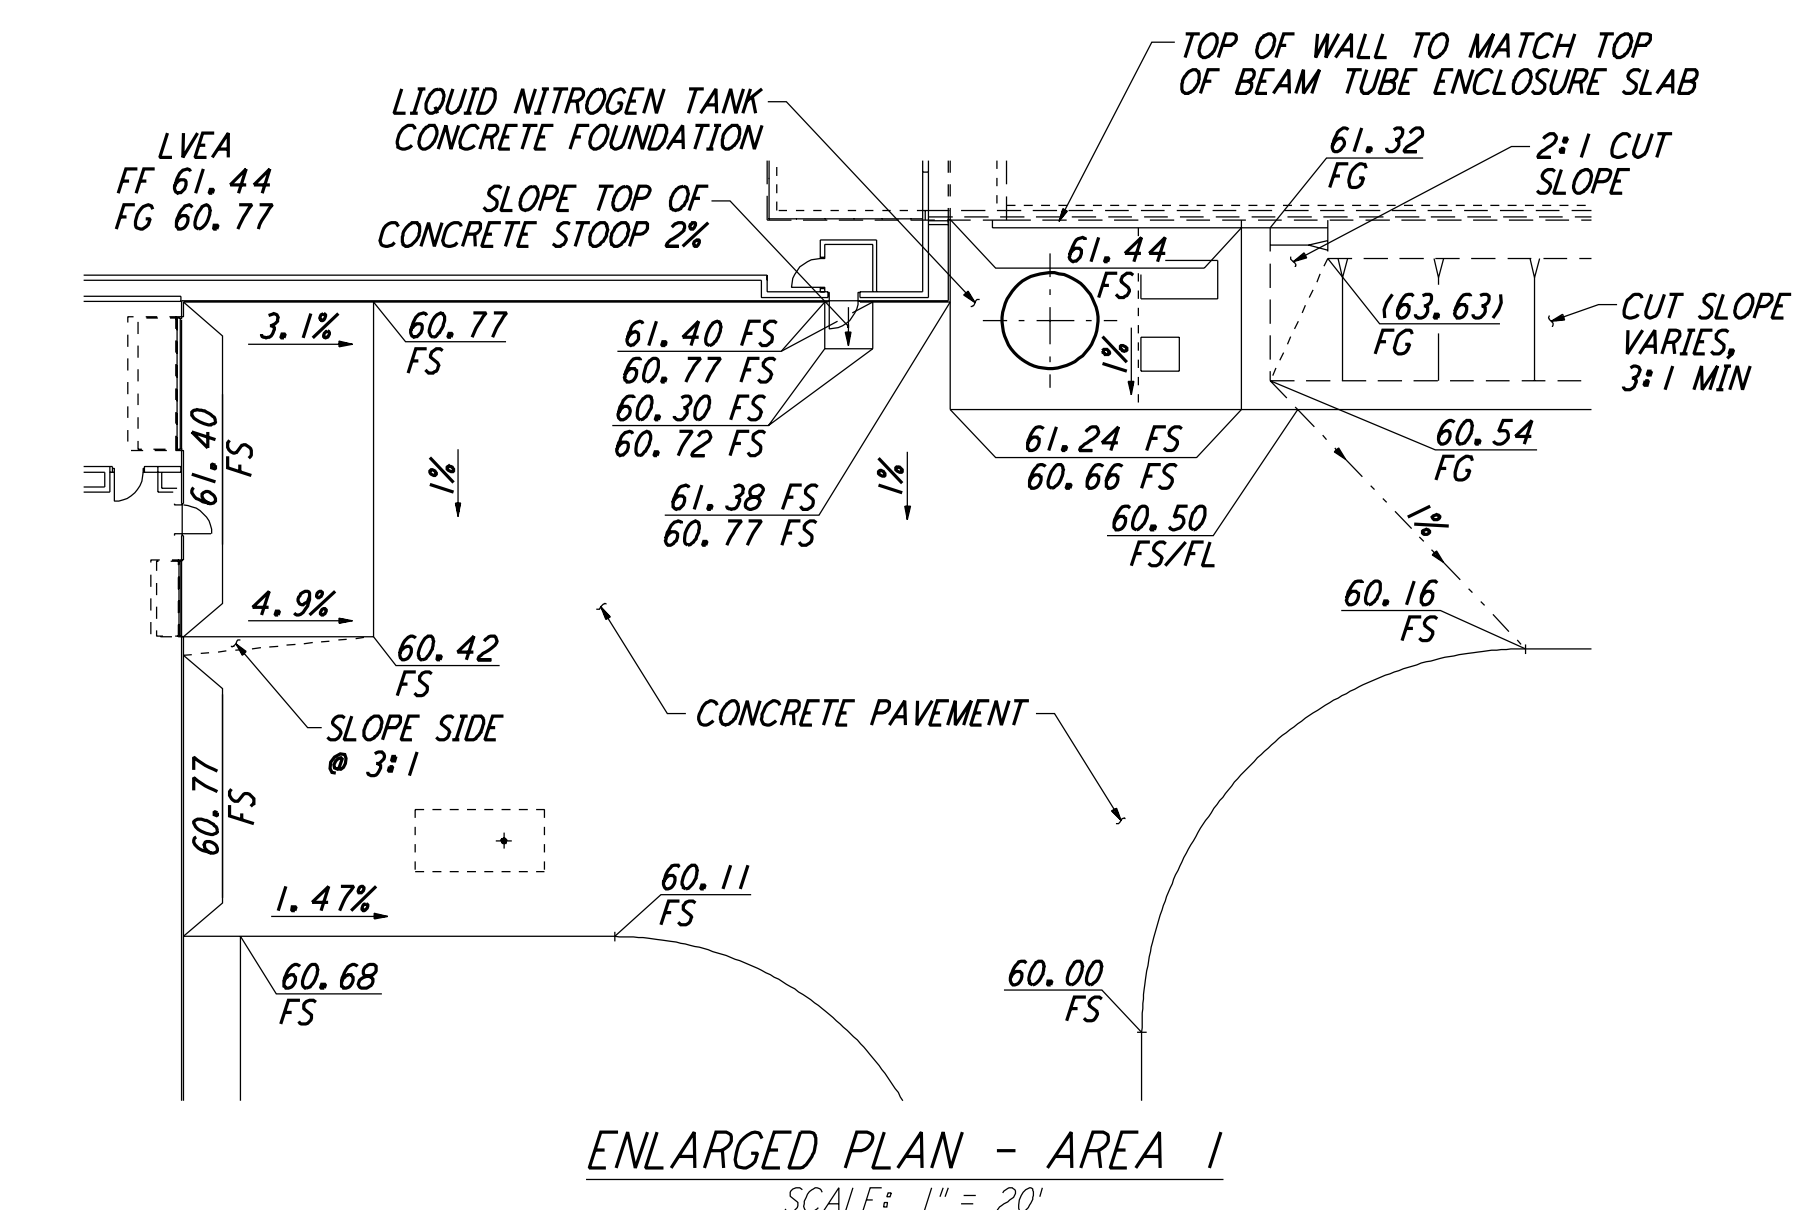


NOTES:
 1. SEE SHEET LA-C-002 FOR GENERAL NOTES, LEGEND AND ABBREVIATIONS.

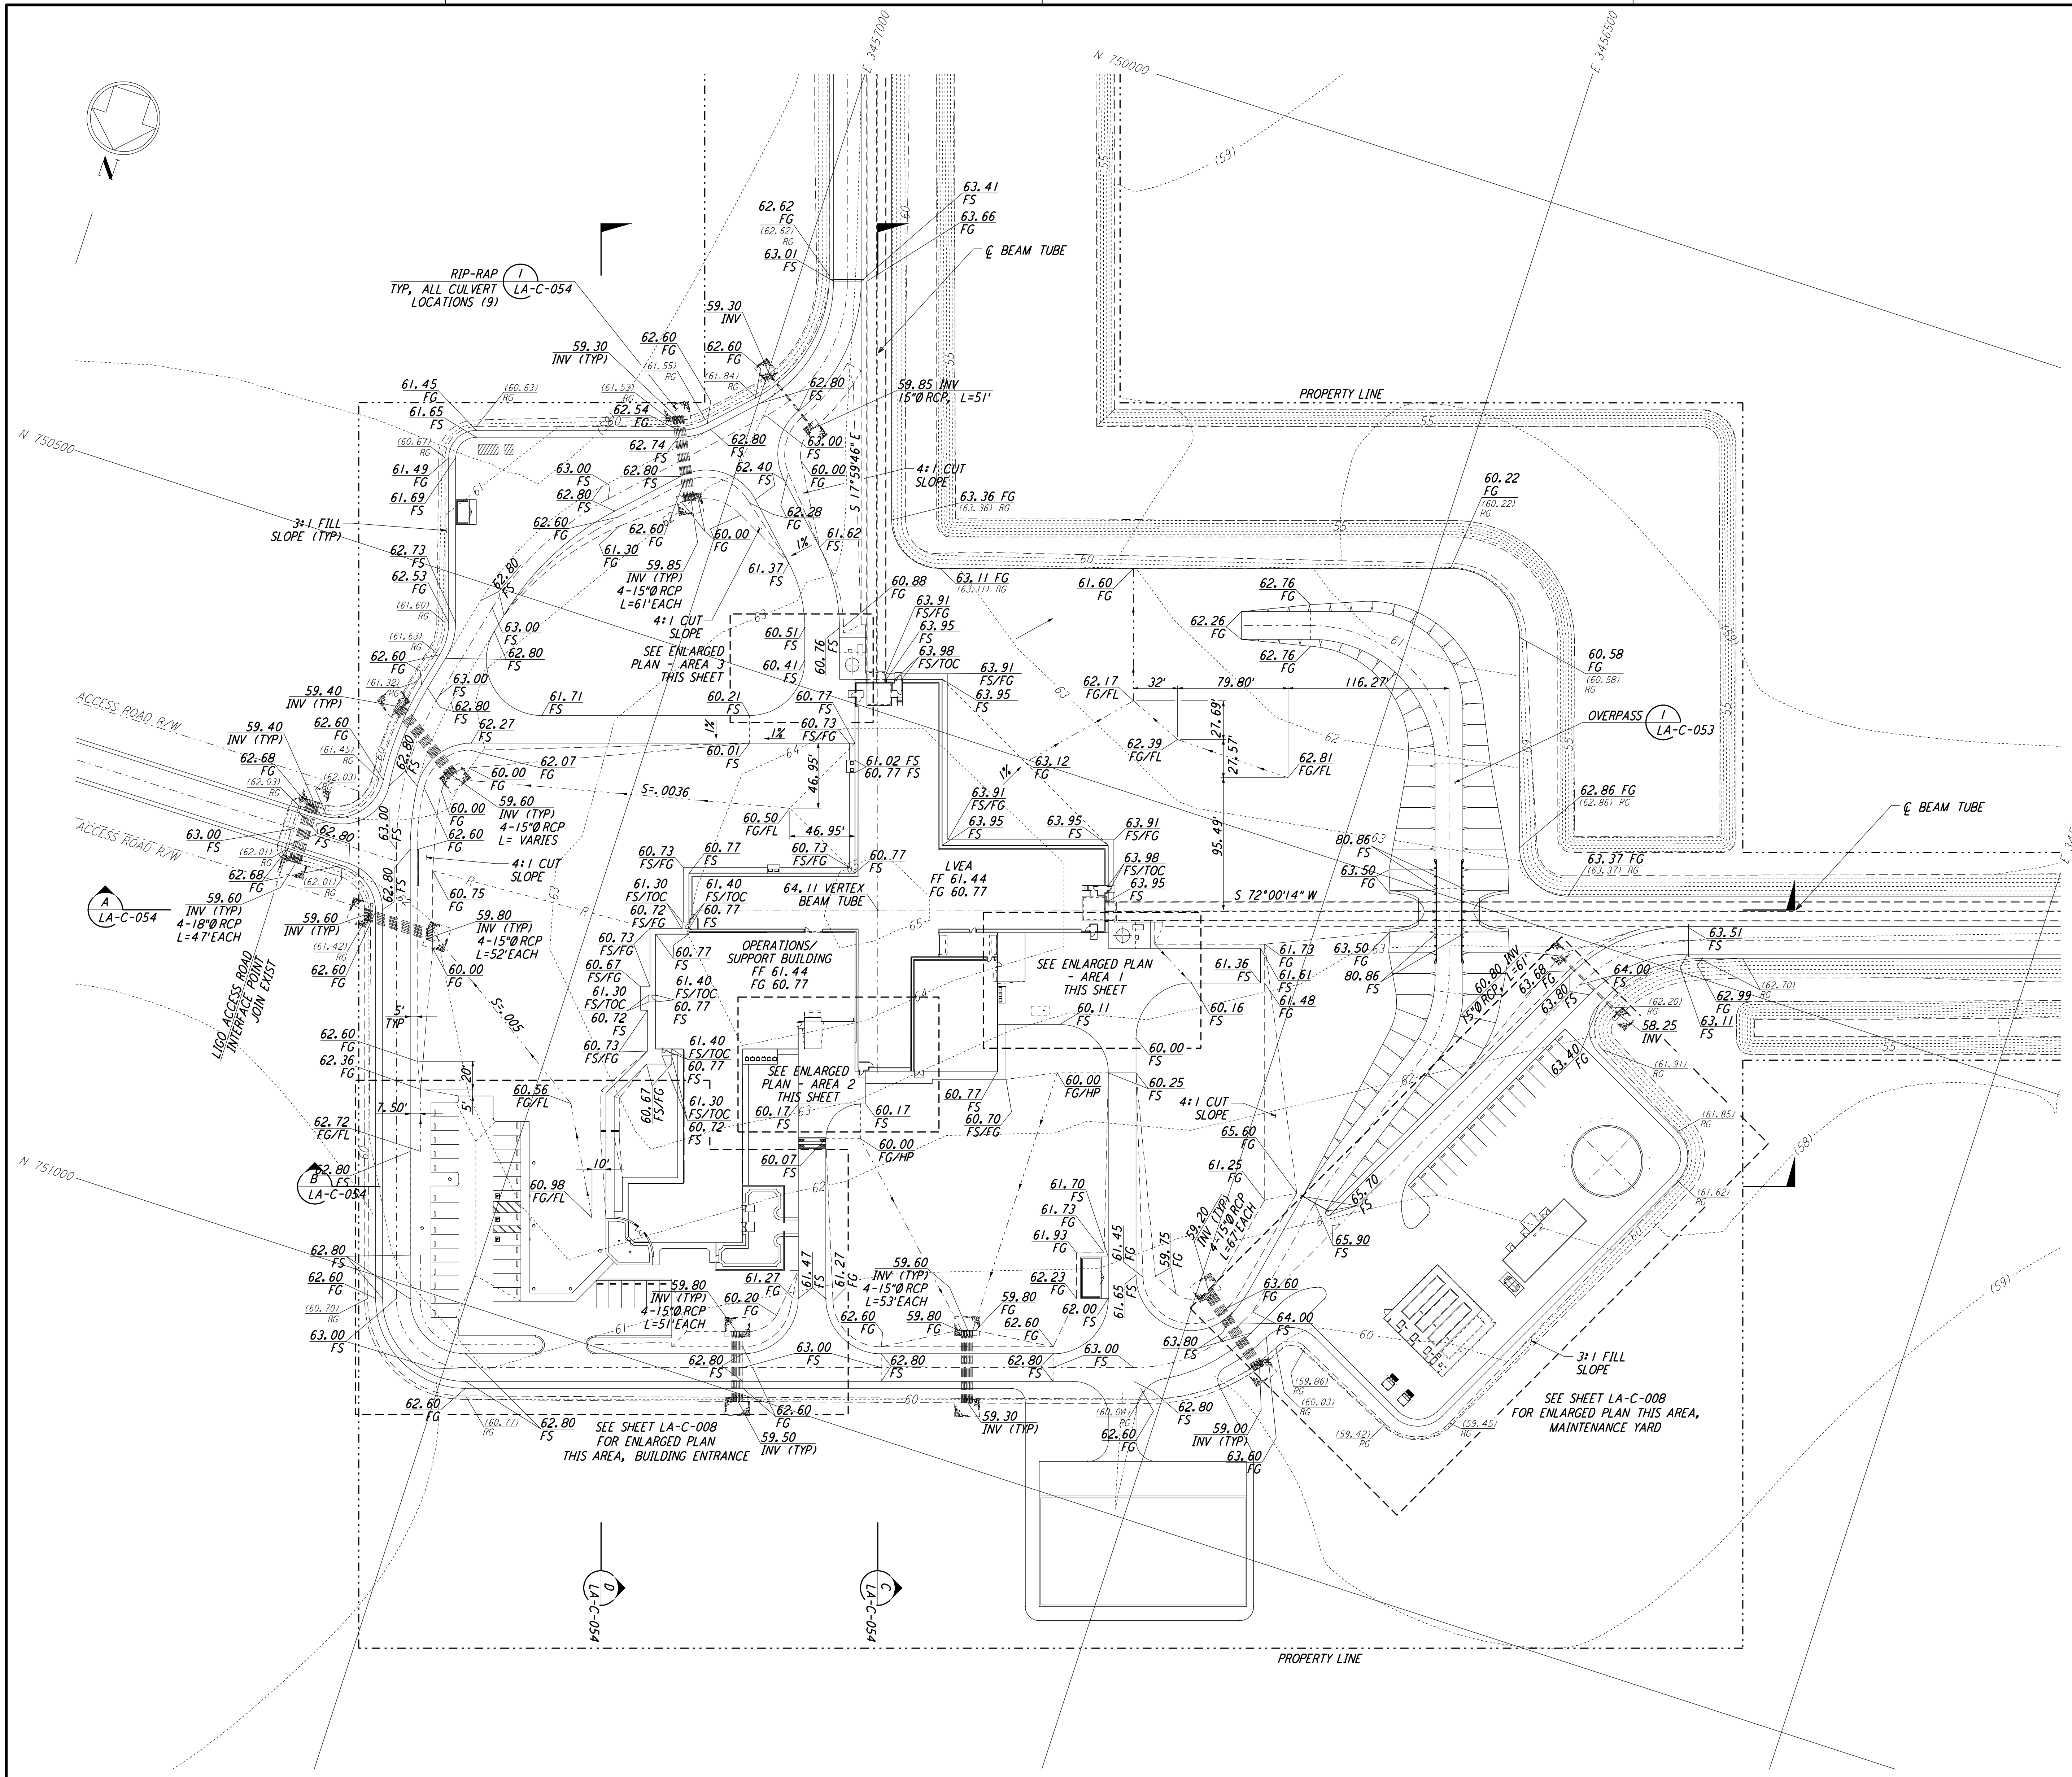

LIGO-D960825-02-0

This document and the design it covers are the property of PARSONS. They are loaned only with the borrower's expressed written agreement that they will not be reproduced, copied, loaned, exhibited, or used in any other way, except by written consent from PARSONS to the borrower.

NO.	DATE	BY	CHKD	ENGR	PROJ	DESCRIPTION
2	08-07-98	WRB	ML	JB	TDM	ISSUED FOR AS-BUILT
1	2-28-97	WRB	ML	JB	TDM	ADDED WALK/ENLARGED PAD, REVISED GRADING

NO.	DATE	BY	CHKD	ENGR	PROJ	DESCRIPTION
1	11-15-96	WRB	ML	JB	TDM	DRAWN
1	11-15-96	WRB	ML	JB	TDM	CHECKED
1	11-15-96	WRB	ML	JB	TDM	ENGINEER
1	11-15-96	WRB	ML	JB	TDM	PROJ

ISSUED FOR CONSTRUCTION	
DRAWN	WRB 11-15-96
CHECKED	ML 11-15-96
ENGINEER	JB 11-15-96
PROJ	TDM 11-15-96
AS-BUILT DRAWINGS	

PARSONS
 100 WEST WALNUT STREET
 PASADENA, CALIFORNIA

LIGO
 CALIFORNIA INSTITUTE OF TECHNOLOGY
 MASSACHUSETTS INSTITUTE OF TECHNOLOGY

LASER INTERFEROMETER
 GRAVITATIONAL-WAVE OBSERVATORY
 SITE NO. 2 - LIVINGSTON, LOUISIANA

CIVIL CORNER STATION GRADING PLAN

SCALE: 1" = 50' CONTRACT NUMBER: PP150969 PROJECT NUMBER: 8094
 SHEET NUMBER: LA-C-007