
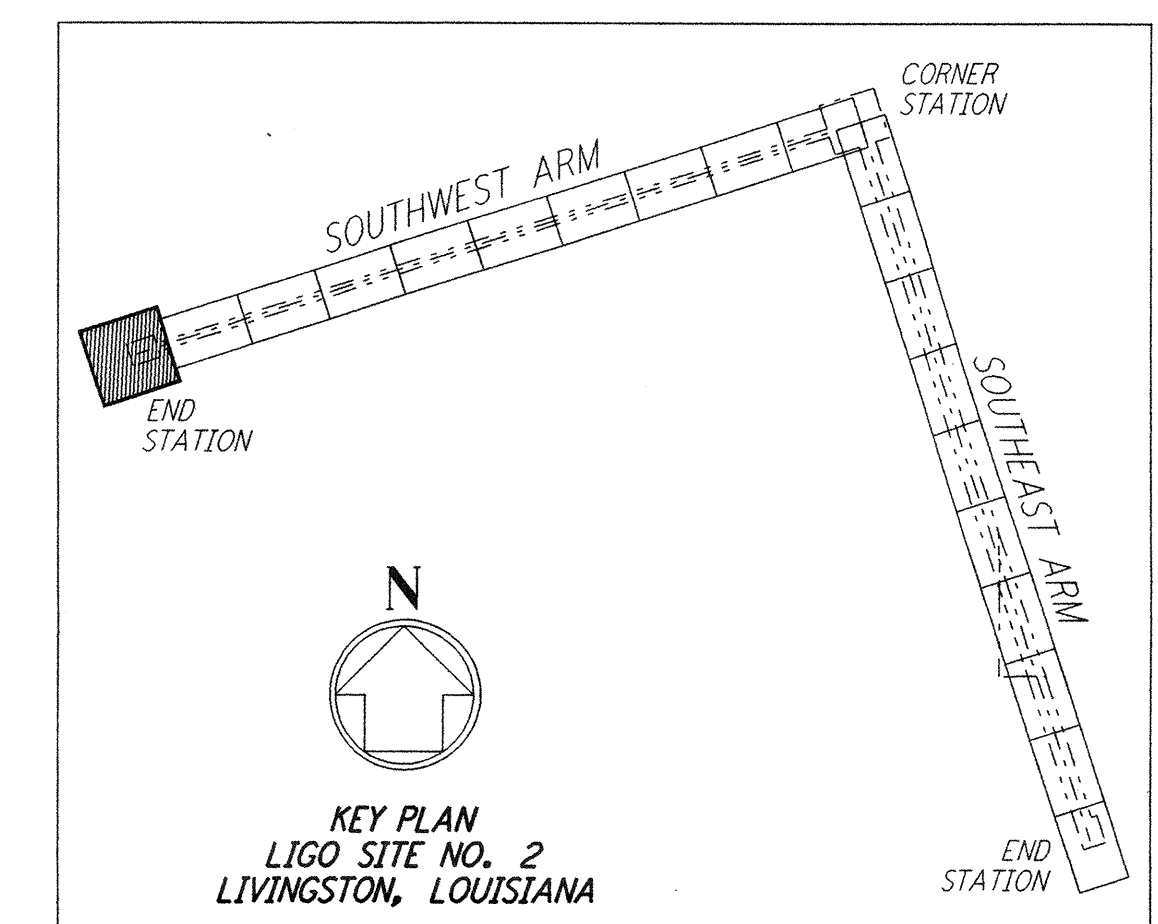
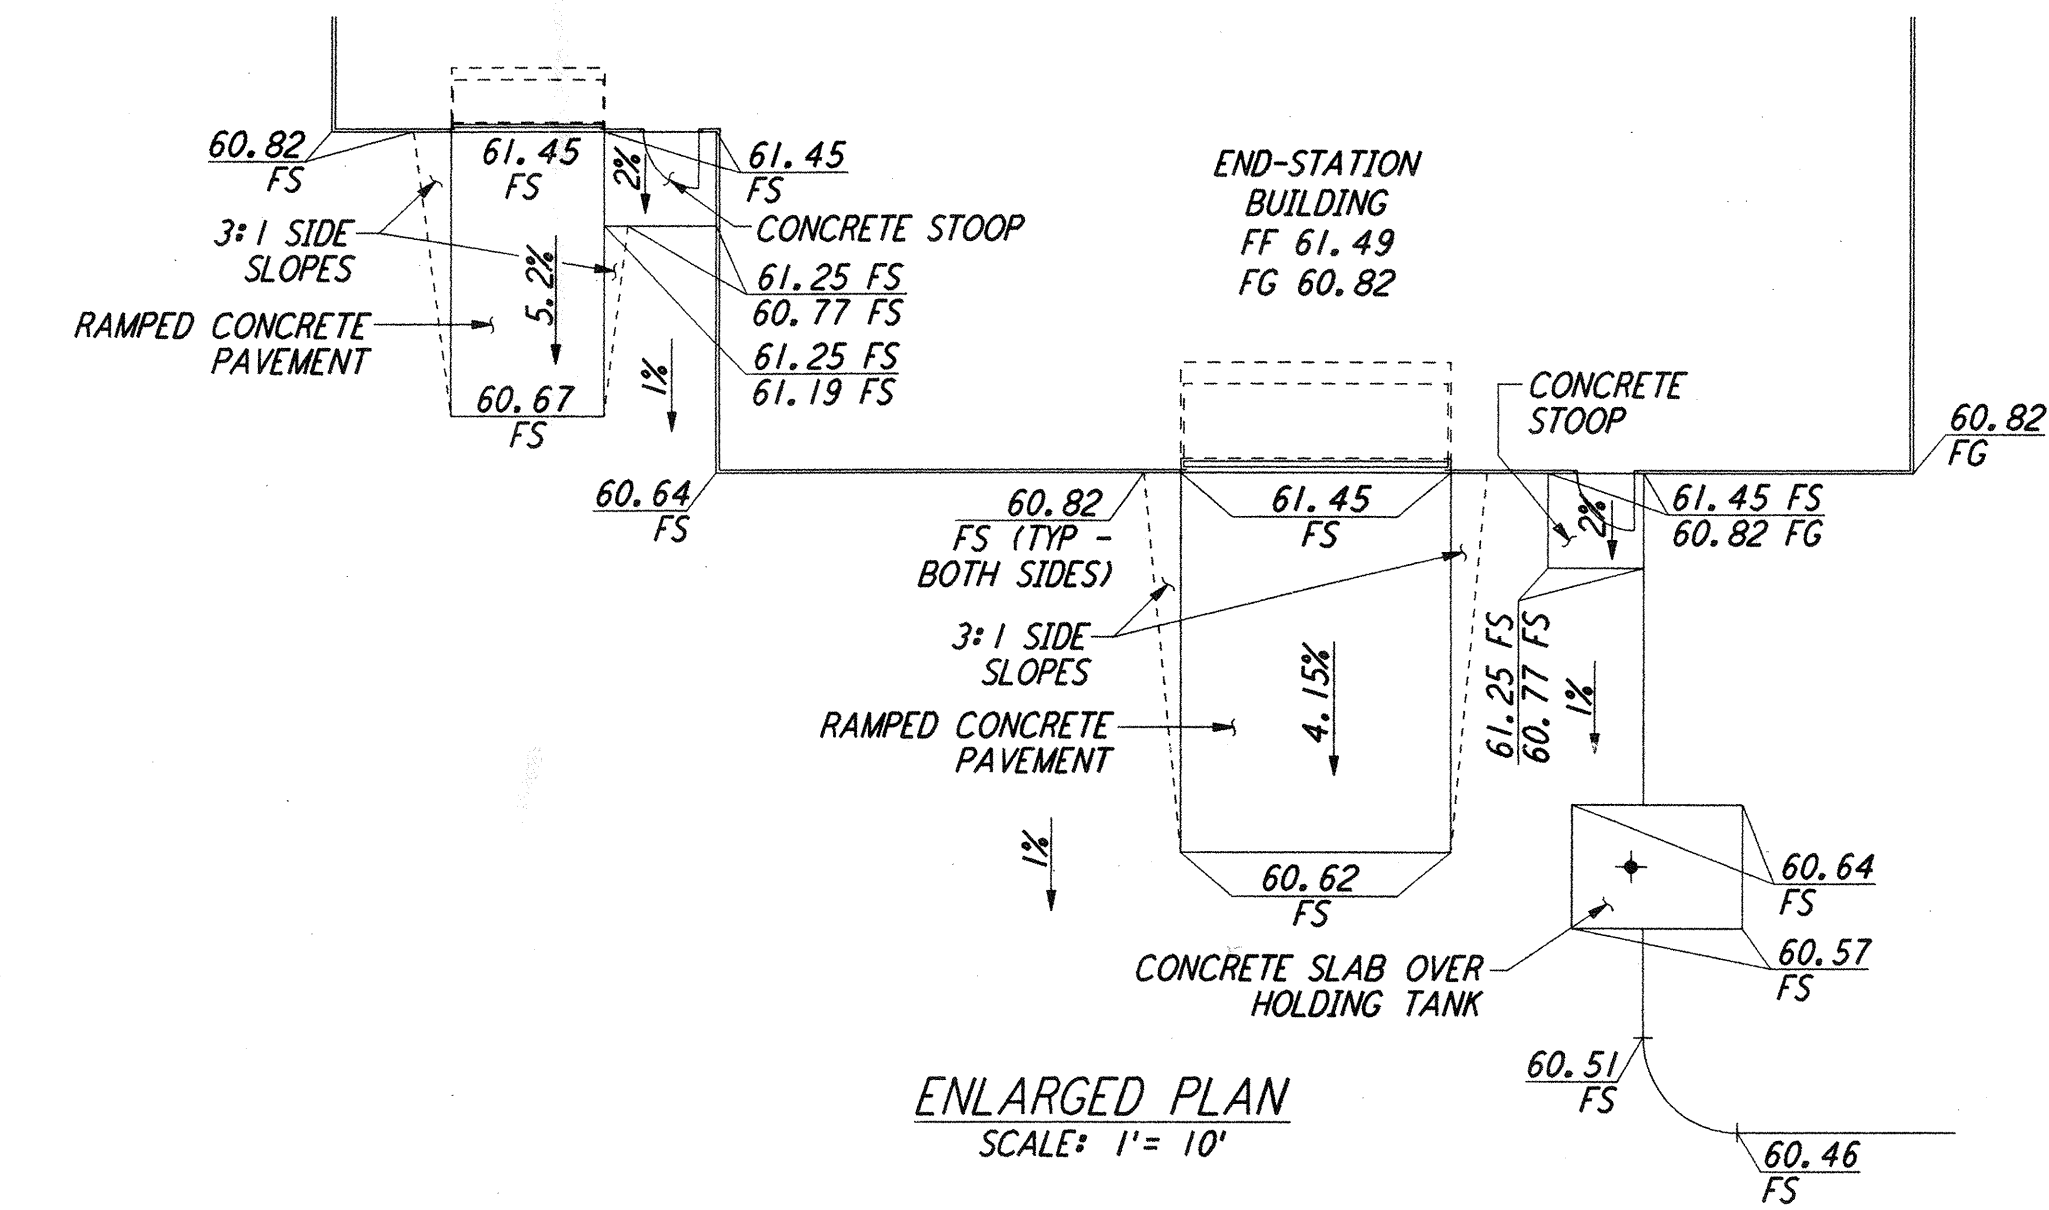
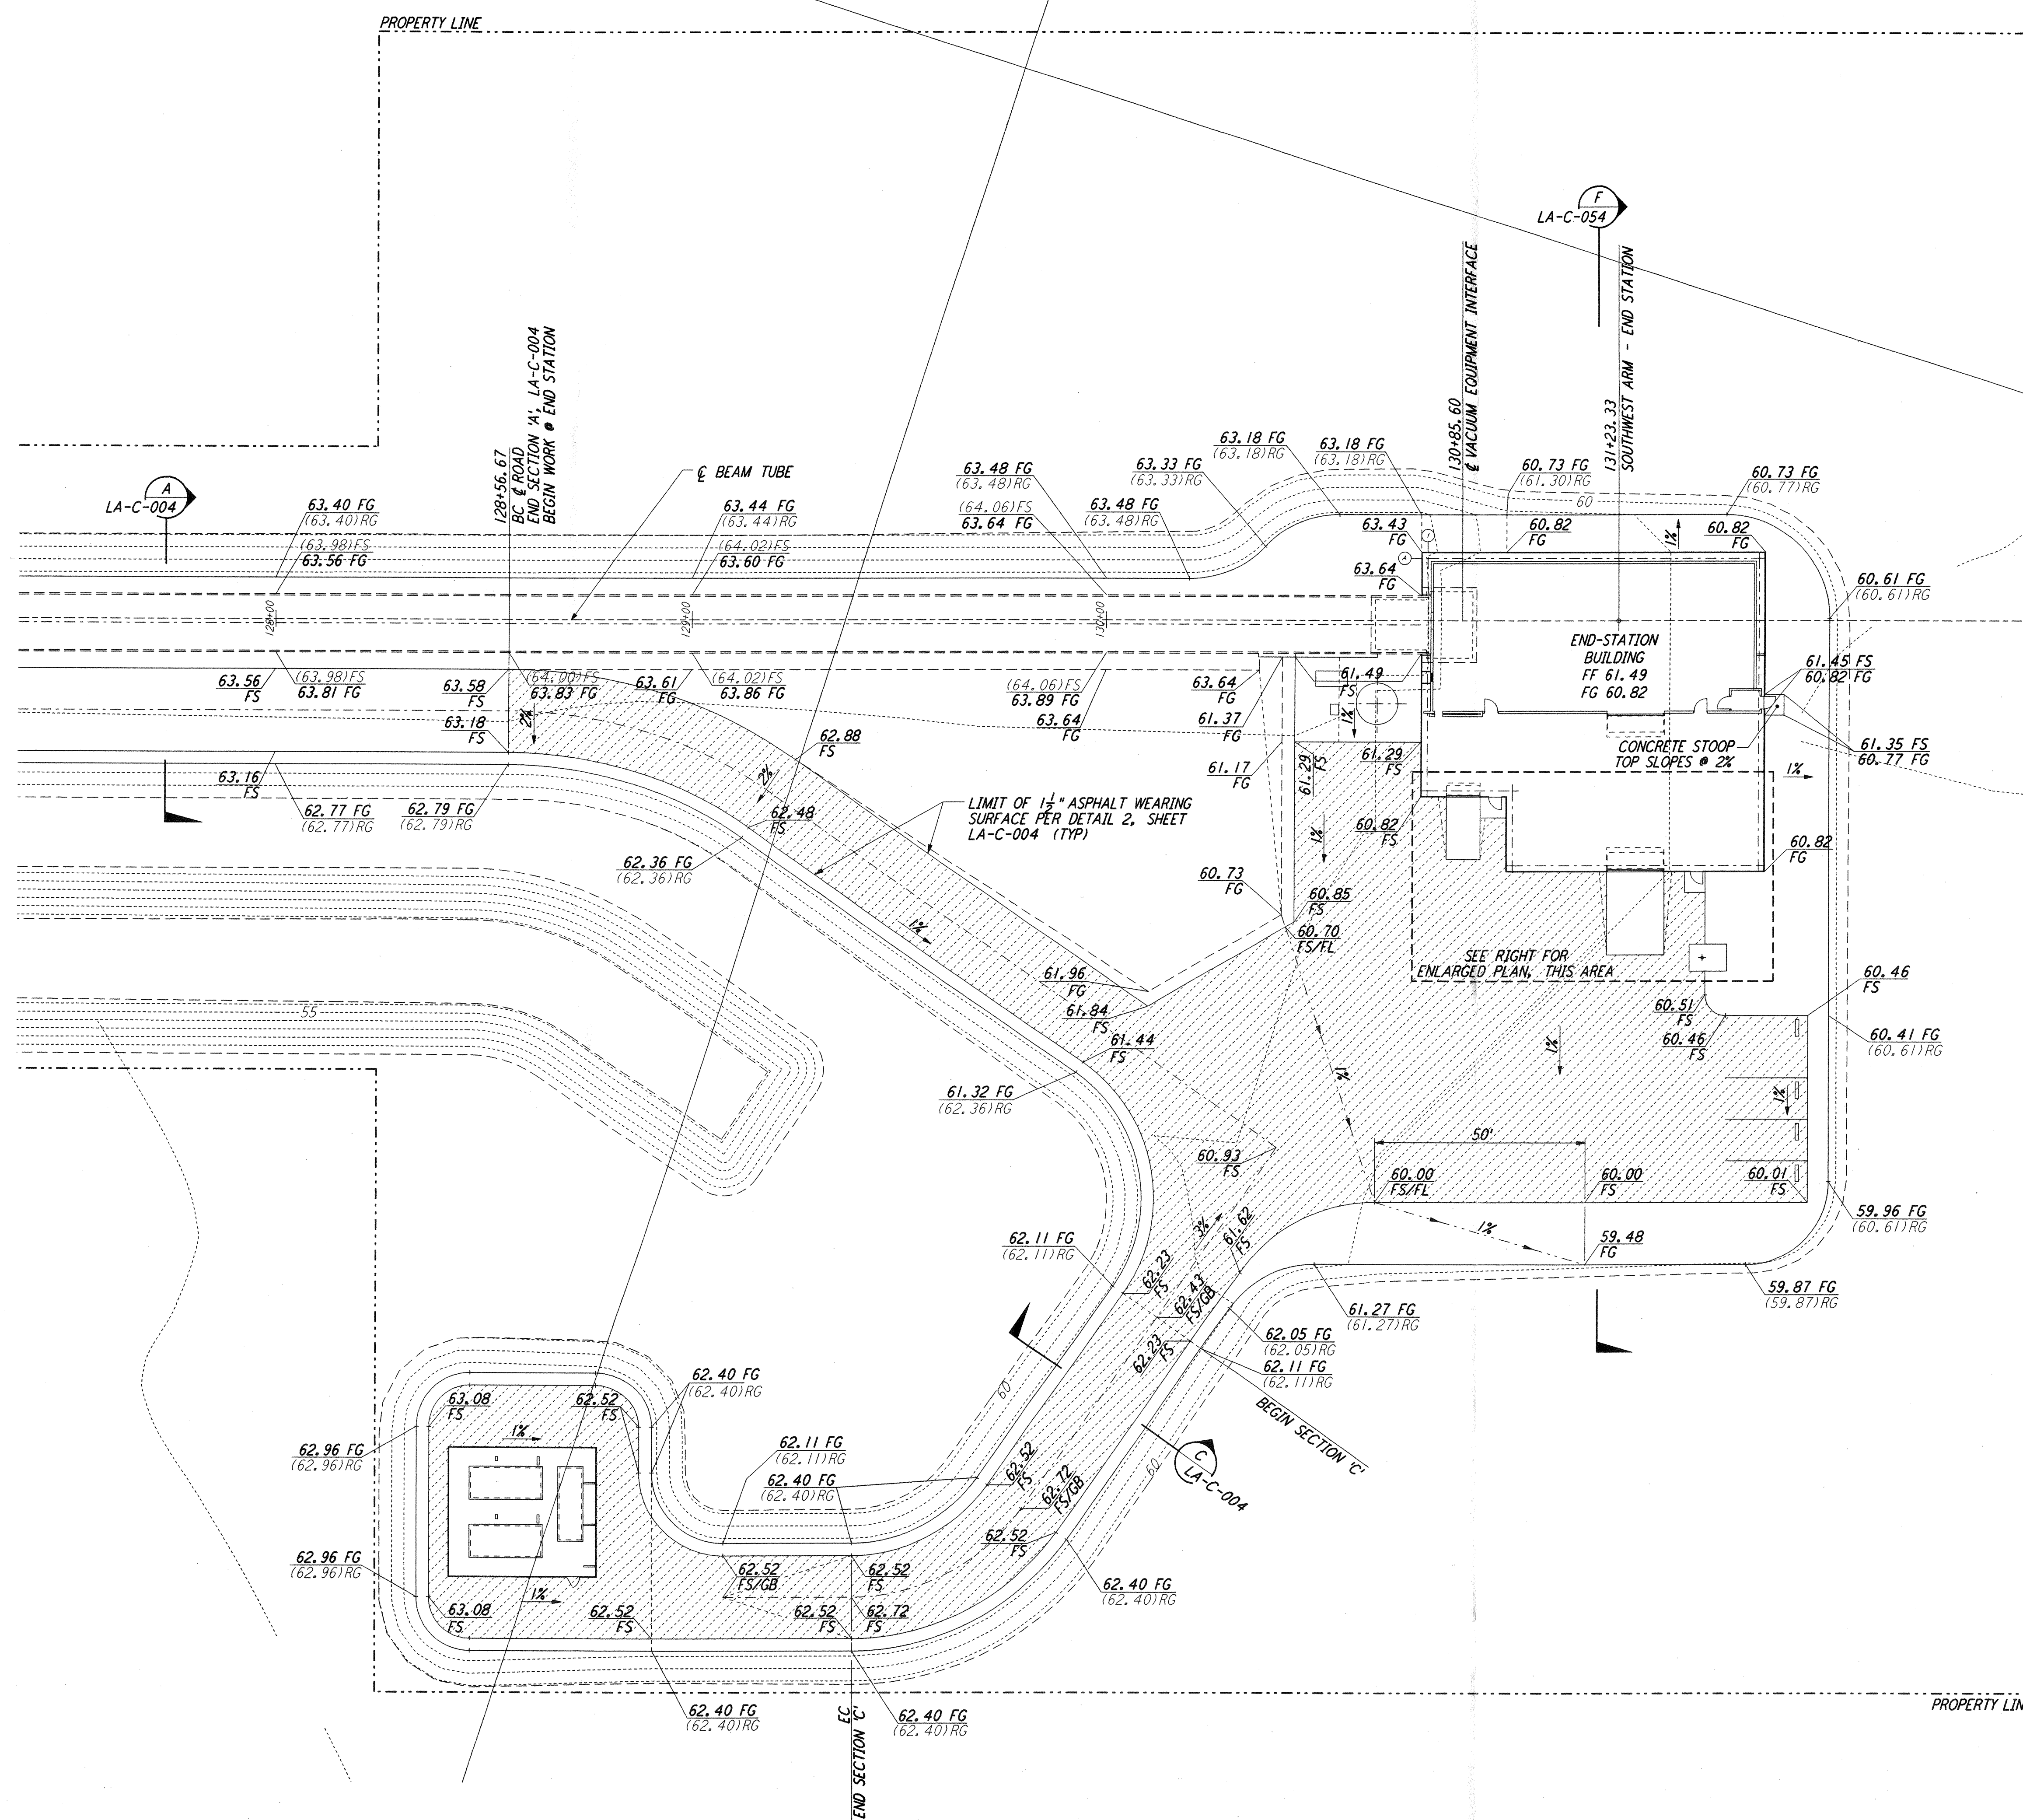


NOTES:  
1. SEE SHEET LA-C-002 FOR GENERAL NOTES, LEGEND AND ABBREVIATIONS.

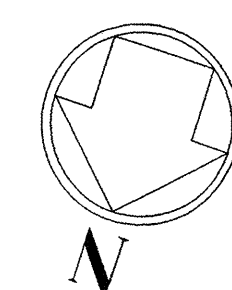

LIGO-D960843-01-0

LASER INTERFEROMETER GRAVITATIONAL-WAVE OBSERVATORY SITE NO. 2 - LIVINGSTON, LOUISIANA			
TITLE	SCALE	CONTRACT NUMBER	PROJECT NUMBER
CIVIL SOUTHWEST ARM END-STATION GRADING PLAN	1" = 20'	PP150969	8094
SHEET NUMBER		REVISIONS	
LA-C-026			

ISSUED FOR CONSTRUCTION	DRAWN	WRB	11-15-96			
CHECKED	ML	11-15-96				
ENGINEER	JB	11-15-96				
PROJ	TDM	11-15-96				
<b>AS-BUILT DRAWINGS</b>						
NO.	DATE	BY	CHKD	ENGR	PROJ	DESCRIPTION
1	08-07-98	WRB	JD	JB	WDM	ISSUED FOR AS-BUILT

**PARSONS**  
100 WEST WALNUT STREET  
PASADENA, CALIFORNIA

**LIGO**  
CALIFORNIA INSTITUTE OF TECHNOLOGY  
MASSACHUSETTS INSTITUTE OF TECHNOLOGY

This document and the design it covers are the property of PARSONS. They are loaned only with the borrower's expressed written agreement that they will not be reproduced, copied, loaned, exhibited, or used in any other way, except by written consent from PARSONS to the borrower.