
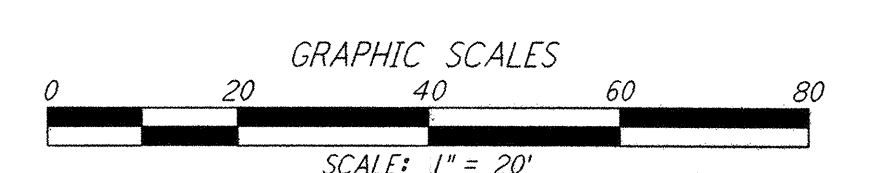


NOTES:
 1. SEE SHEET LA-C-002 FOR GENERAL NOTES, LEGEND AND ABBREVIATIONS.

CURVE DATA					
Δ	RADIUS	LENGTH	TANGENT	REMARK	
1	46°23'52"	25'	20.24'	10.71'	EDGE OF PAD (EXIST)
2	90°00'00"	25'	39.27'	25.00'	EDGE OF PAD (EXIST)
3	90°00'00"	20'	31.42'	20.00'	EDGE OF PAD (EXIST)
4	55°00'00"	25'	24.00'	13.01'	EDGE OF PAD (EXIST)
5	55°00'00"	63'	60.48'	32.80'	EDGE OF PAD (EXIST)
6	90°00'00"	13'	20.42'	13.00'	EDGE OF PAD (EXIST)
7	90°00'00"	17'	26.70'	17.00'	EDGE OF PAD (EXIST)
8	55°00'00"	37'	35.52'	19.26'	EDGE OF PAD (EXIST)
9	90°00'00"	37'	58.12'	37.00'	EDGE OF PAD (EXIST)
10	35°00'00"	97'	59.25'	30.58'	EDGE OF PAD (EXIST)
11	35°00'00"	110'	67.19'	34.68'	EDGE OF ROAD
12	55°00'00"	50'	48.00'	26.03'	EDGE OF ROAD
13	55°00'00"	40'	38.40'	20.82'	
14	90°00'00"	5'	7.85'	5.00'	

COORDINATES			
Δ	NORTH	EAST	REMARK
1	738240.1477	3460820.9696	PI EDGE OF PAD (EXIST)
2	738221.2989	3460810.7773	PI EDGE OF PAD (EXIST)
3	738098.6358	3460850.6170	PI EDGE OF PAD (EXIST)
4	738154.4793	3461022.5245	PI EDGE OF PAD (EXIST)
5	738291.4282	3460978.0370	PI EDGE OF PAD (EXIST)
6	738345.1456	3461018.5221	PI EDGE OF PAD (EXIST)
7	738545.6226	3460953.3889	PI EDGE OF PAD (EXIST)
8	738524.9199	3460889.6677	PI EDGE OF PAD (EXIST)
9	738471.6601	3460906.9714	PI EDGE OF PAD (EXIST)
10	738484.3293	3460945.9644	PI EDGE OF PAD (EXIST)
11	738349.9850	3460989.6121	PI EDGE OF PAD (EXIST)
12	738294.1309	3460947.5166	PI EDGE OF PAD (EXIST)
13	738390.7051	3460819.3766	PI EDGE OF PAD (EXIST)
14	738382.7902	3460808.2789	PI EDGE OF ROAD
15	738275.9249	3460950.0741	EDGE OF ROAD INTERSECTION
16	738347.5656	3461004.0669	PI EDGE OF ROAD

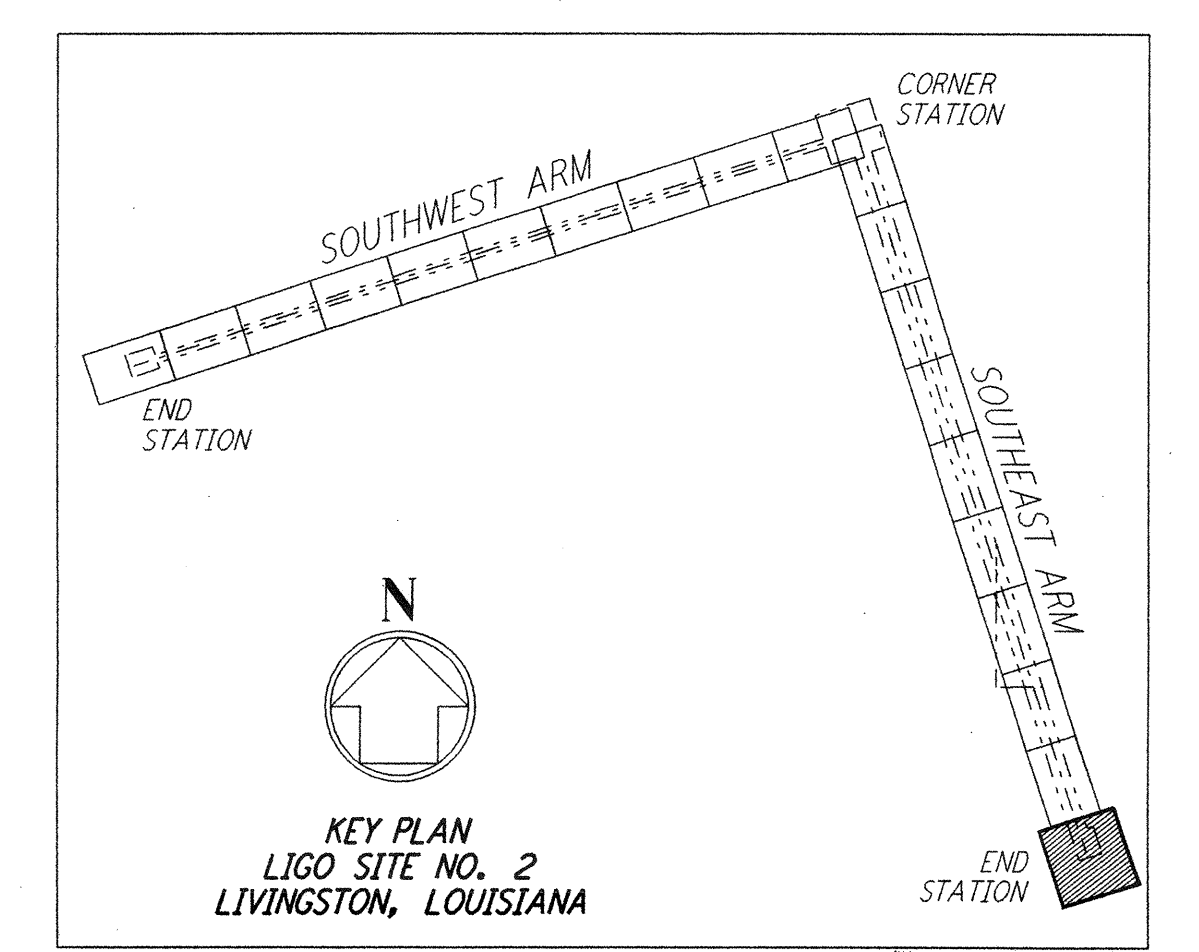

This document and the design it covers are the property of PARSONS. They are loaned only with the borrower's expressed written agreement that they will not be reproduced, copied, loaned, exhibited, or used in any other way, except by written consent from PARSONS to the borrower.

NO.	DATE	BY	CHKD	ENGR	PROJ	DESCRIPTION
1	08-07-98	WRB				ISSUED FOR AS-BUILT

ISSUED FOR CONSTRUCTION
 DRAWN: WRB 11-15-96
 CHECKED: ML 11-15-96
 ENGINEER: JB 11-15-96
 PROJ: TDM 11-15-96

AS-BUILT DRAWINGS

PARSONS
 100 WEST WALNUT STREET
 PASADENA, CALIFORNIA

LIGO
 CALIFORNIA INSTITUTE OF TECHNOLOGY
 MASSACHUSETTS INSTITUTE OF TECHNOLOGY

LIGO-D960858-01-0

LASER INTERFEROMETER
 GRAVITATIONAL-WAVE OBSERVATORY
 SITE NO. 2 - LIVINGSTON, LOUISIANA

CIVIL
 SOUTHWEST ARM
 END-STATION
 PLOT PLAN

SCALE: 1" = 20'
 CONTRACT NUMBER: PPI50969
 PROJECT NUMBER: 8094
LA-C-045