

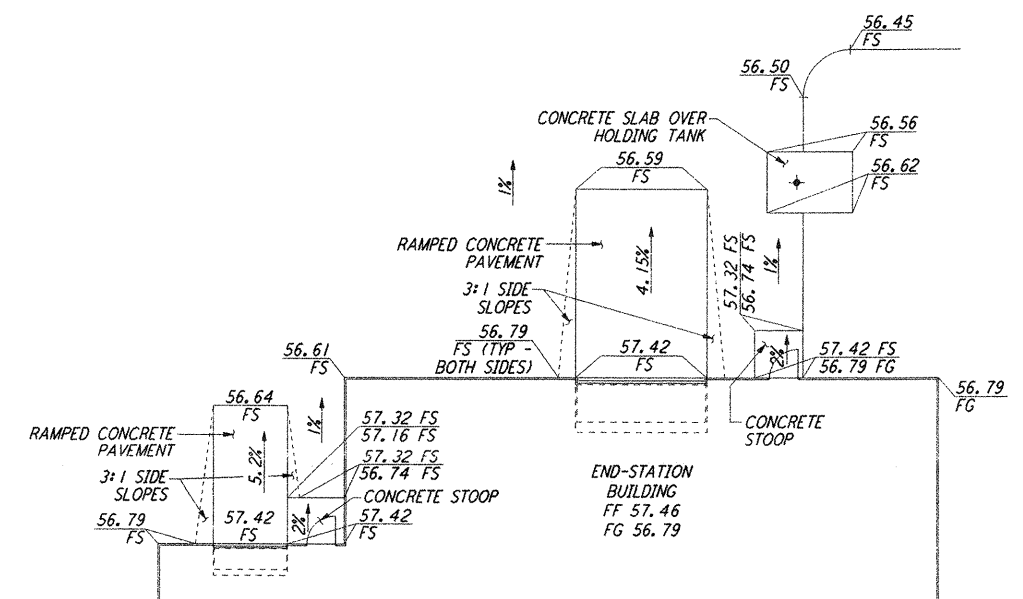


NOTES:
1. SEE SHEET LA-C-002 FOR GENERAL NOTES, LEGEND AND ABBREVIATIONS.

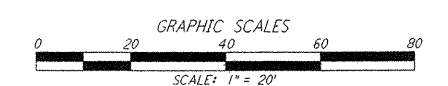

ENLARGED PLAN
SCALE: 1" = 10'

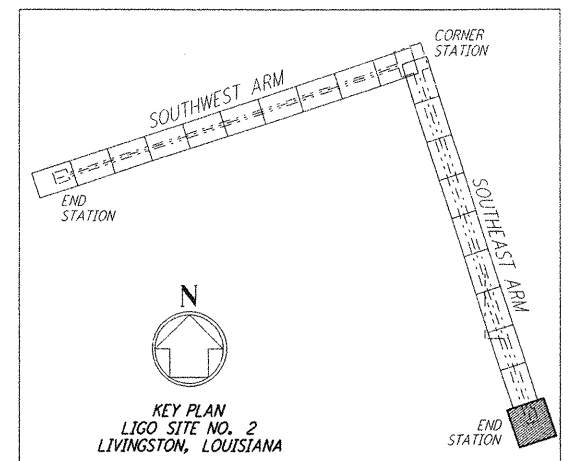

LIGO-D960859-01-0

LASER INTERFEROMETER GRAVITATIONAL-WAVE OBSERVATORY SITE NO. 2 - LIVINGSTON, LOUISIANA			
TITLE	SCALE	CONTRACT NUMBER	PROJECT NUMBER
CIVIL SOUTHEAST ARM END-STATION GRADING PLAN	1" = 20'	PP150969	8094
LA-C-046		REVISIONS	

ISSUED FOR CONSTRUCTION	DATE
DRAWN WRB	11-15-96
CHECKED ML	11-15-96
ENGINEER JB	11-15-96
PROJ TDM	11-15-96

**AS-BUILT
DRAWINGS**



100 WEST WALNUT STREET
PASADENA, CALIFORNIA



CALIFORNIA INSTITUTE OF TECHNOLOGY
MASSACHUSETTS INSTITUTE OF TECHNOLOGY

This document and the design it covers are the property of PARSONS. They are loaned only with the borrower's expressed written agreement that they will not be reproduced, copied, loaned, exhibited, or used in any other way, except by written consent from PARSONS to the borrower.

NO.	DATE	BY	CHKD	ENGR	PROJ	DESCRIPTION
1	08-07-98	WRB	JB	MD	MD	ISSUED FOR AS-BUILT