

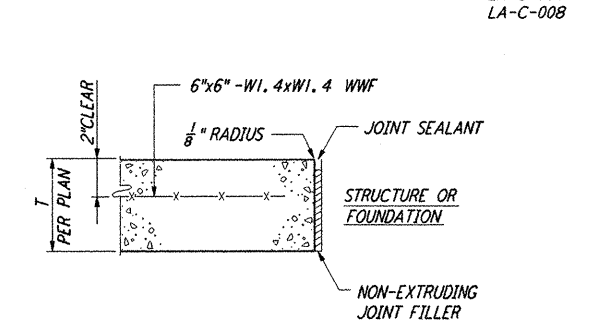
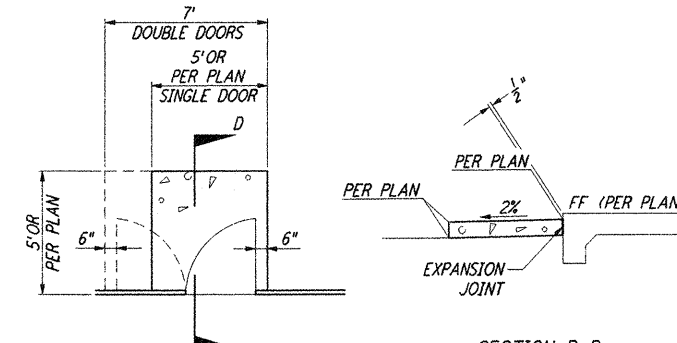


CONCRETE WALKWAY (1) NOT TO SCALE


CONCRETE APRON (1) SIM NOT TO SCALE

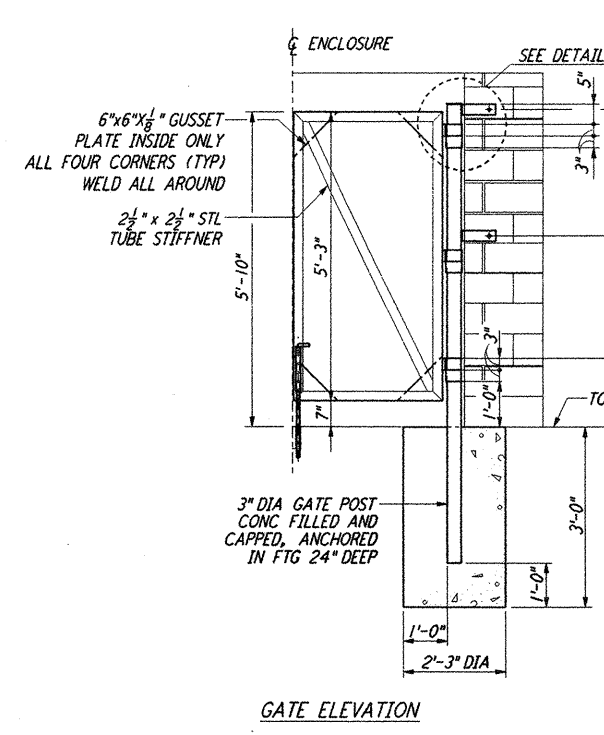




EXPANSION JOINT (EJ) (5) NOT TO SCALE

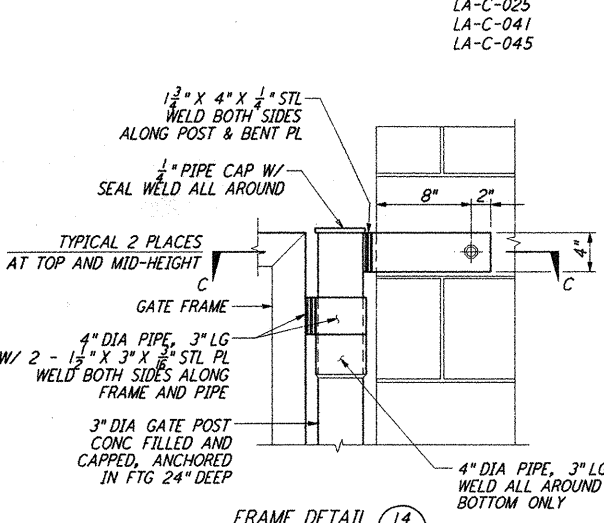


CONCRETE STOOP (2) NOT TO SCALE

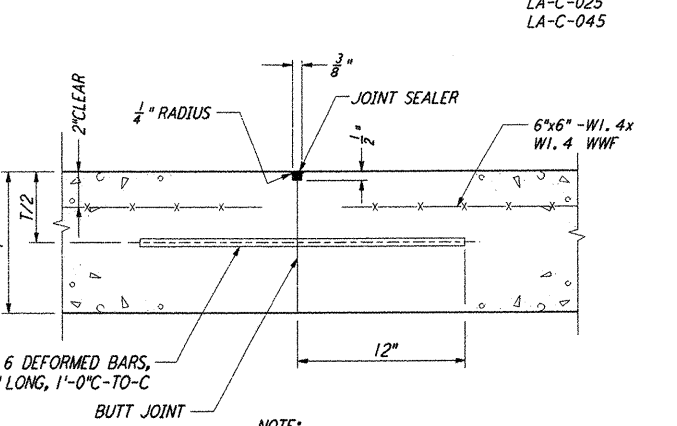




CONSTRUCTION JOINT (CJ) (6) NOT TO SCALE

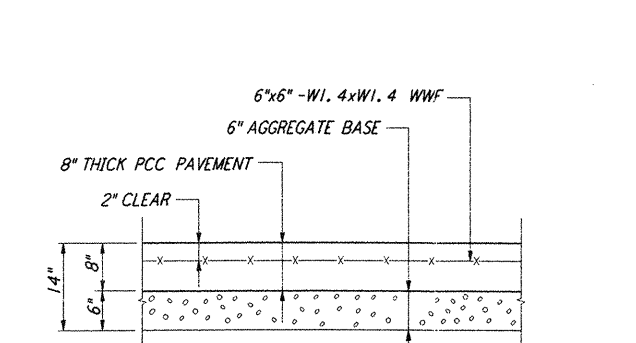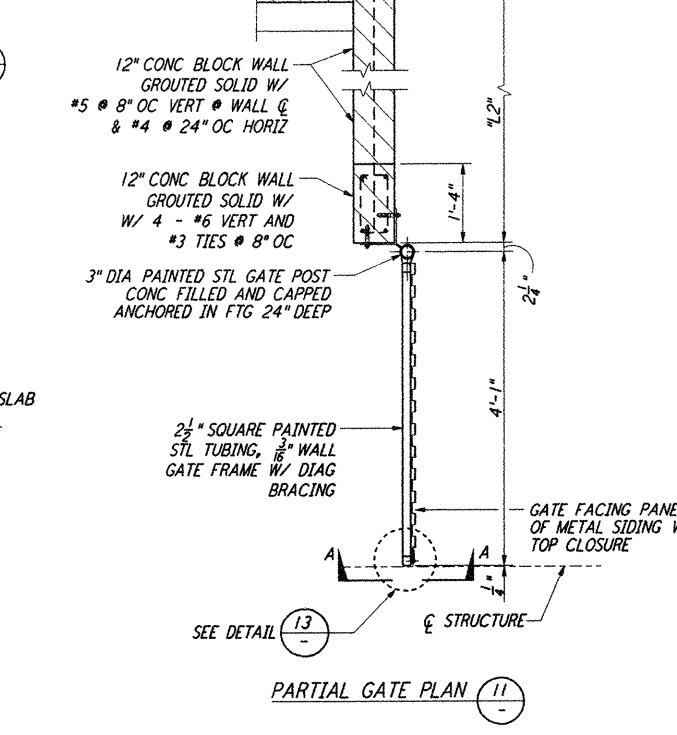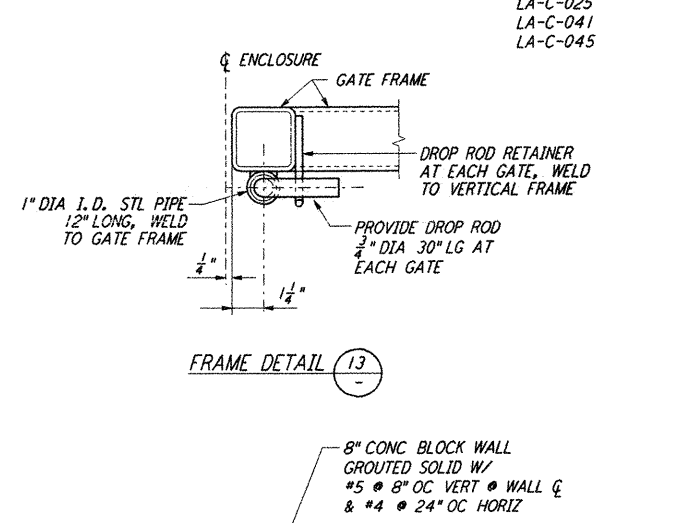


CONCRETE PAVEMENT (3) NOT TO SCALE

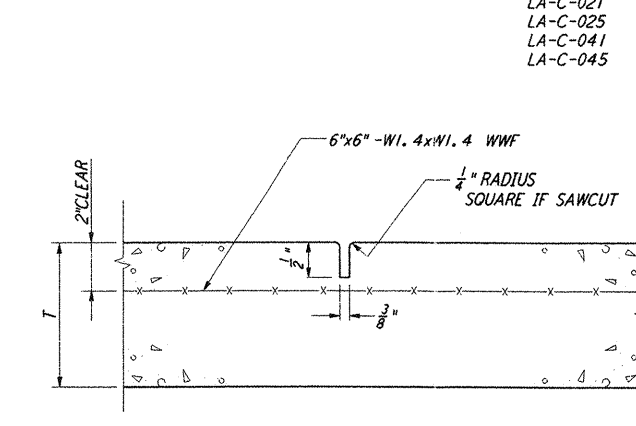

CONTRACTION JOINT (CO) (7) NOT TO SCALE

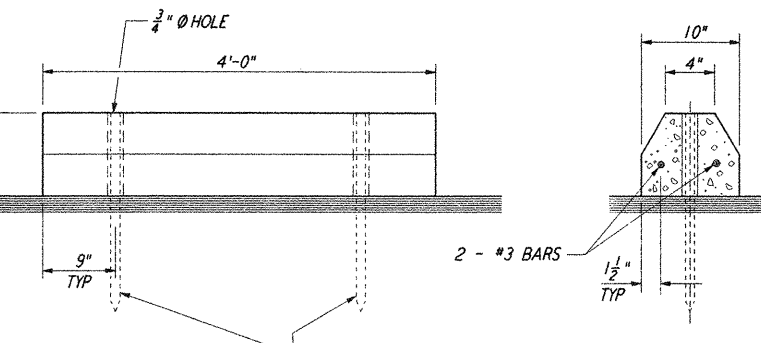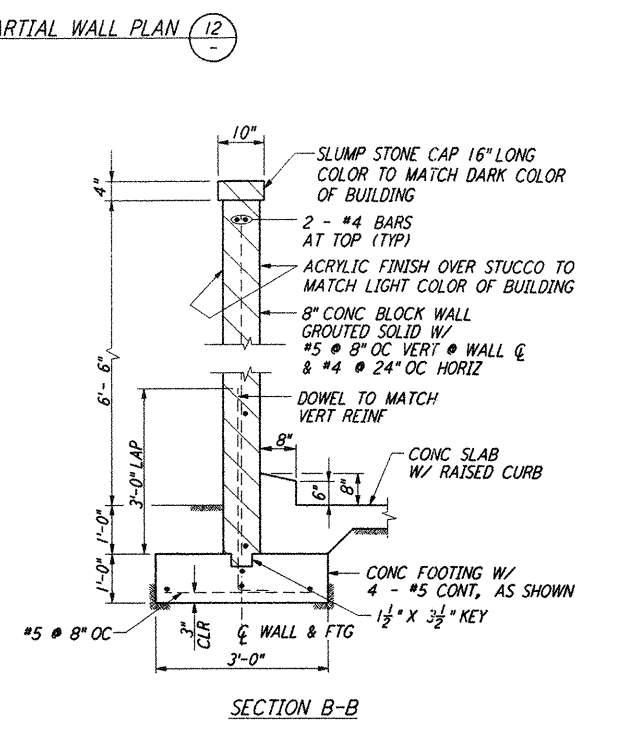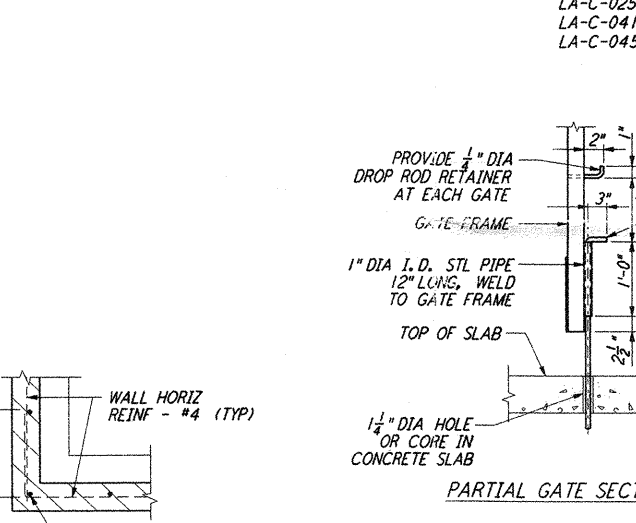


CONCRETE PARKING BUMPER (4) NOT TO SCALE

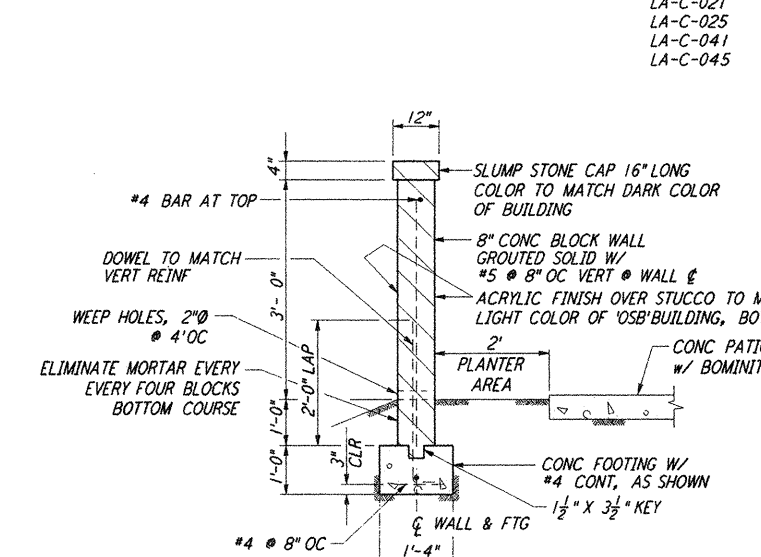


PATIO WALL (8) NOT TO SCALE

BLOCK WALL ENCLOSURE DIMENSIONS				
	7'	7'1"	7'2"	7'
HAZARDOUS WASTE STORAGE	30'	28'-4"	10'-8 1/2"	15'
TRASH ENCLOSURE	18'	16'-4"	4'-8 1/2"	10'


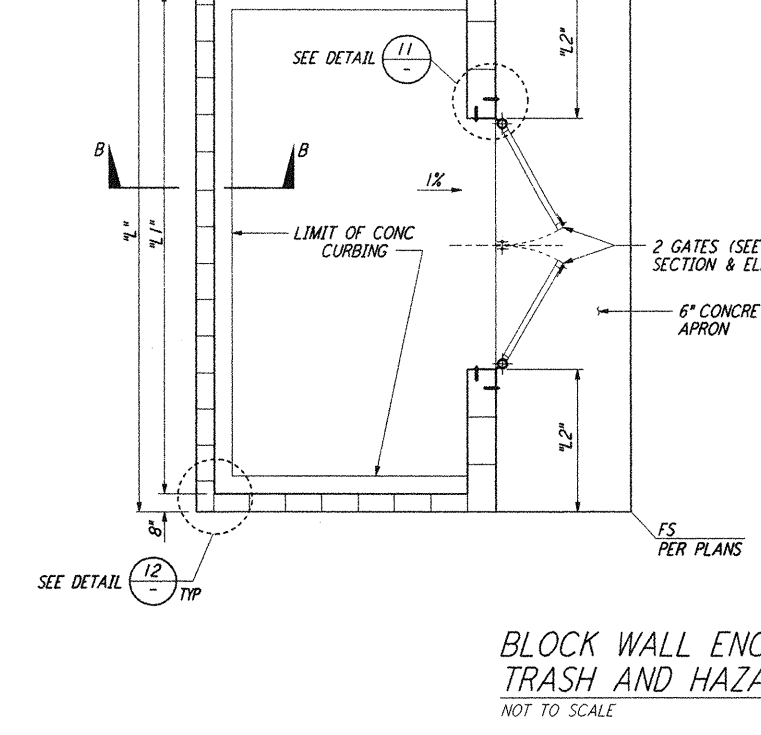


BLOCK WALL ENCLOSURE FOR TRASH AND HAZARDOUS WASTE STORAGE (10) NOT TO SCALE

NOTES:
1. SEE SHEET LA-C-002 FOR GENERAL NOTES, LEGEND AND ABBREVIATIONS.

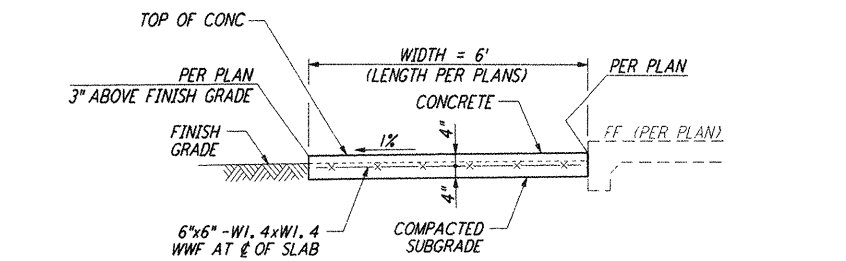

RAISED CONCRETE PAD FOR ELECTRICAL TRANSFORMERS (9) NOT TO SCALE

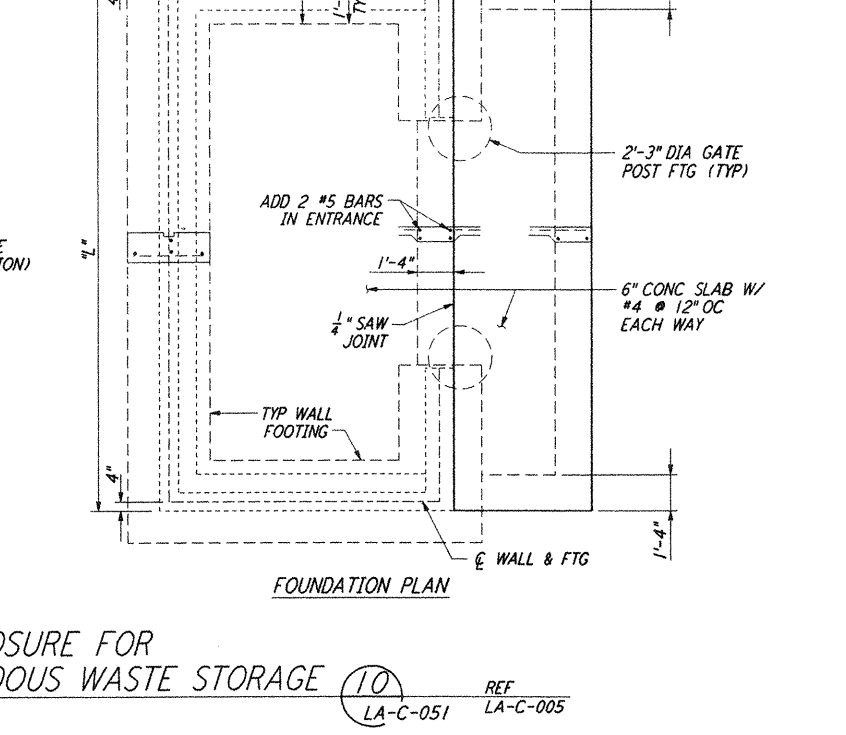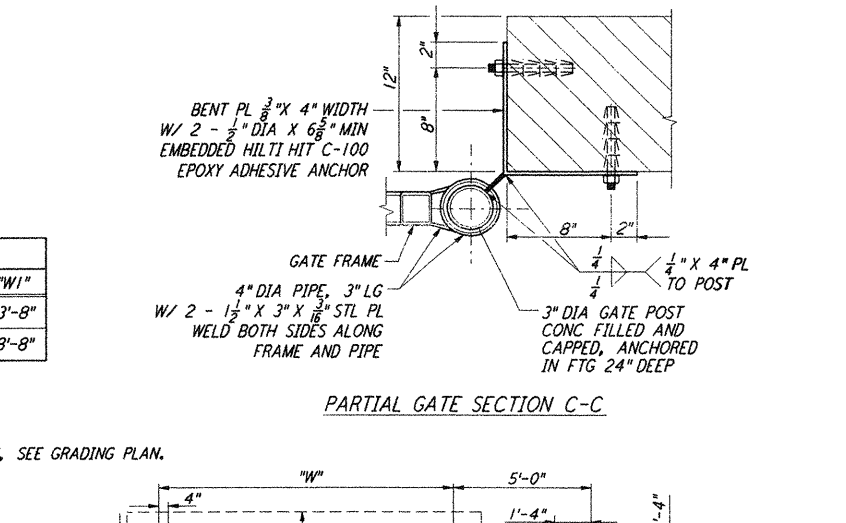

FOUNDATION PLAN

This document and the design it covers are the property of PARSONS. They are loaned only with the borrower's expressed written agreement that they will not be reproduced, copied, loaned, exhibited, or used in any other way, except by written consent from PARSONS to the borrower.

NO.	DATE	BY	CHKD	ENGR	PROJ	DESCRIPTION
1	08-07-98	WRB				ISSUED FOR AS-BUILT

ISSUED FOR CONSTRUCTION	
DRAWN	WRB 11-15-96
CHECKED	ML 11-15-96
ENGINEER	JB 11-15-96
PROJ	TDM 11-15-96

AS-BUILT DRAWINGS

PARSONS
100 WEST WALNUT STREET
PASADENA, CALIFORNIA

LIGO
CALIFORNIA INSTITUTE OF TECHNOLOGY
MASSACHUSETTS INSTITUTE OF TECHNOLOGY

LIGO-D960861-01-0
LASER INTERFEROMETER
GRAVITATIONAL-WAVE OBSERVATORY
SITE NO. 2 - LIVINGSTON, LOUISIANA

CIVIL
SITWORK DETAILS
SHEET 1

AS NOTED
PP150969
8094

LA-C-051