


- NOTES:
- 30 AMP DEDICATED OUTLET - STD. RECEPTACLE.
 - DOUBLE DOOR SHALL BE 6'-0" X 7'-0" WITH HARDWARE.
 - EXACT LOCATION OF CLOSET SHALL BE DETERMINED IN THE FIELD.
 - 3/8" GYP. BD. AT INTERIOR WALLS.
 - 2" RIGID INSULATION TO 8'-0" ON INTERIOR WALLS.
 - HOLD CLOSET BACK FROM CONTROL JOINT 1" MINIMUM.

not be reproduced, copied, loaned, exhibited, or used in any other way, except by written consent from PARSONS to the borrower.

This document and the design it covers are the property of PARSONS. They are loaned only with the borrower's expressed written agreement that they will

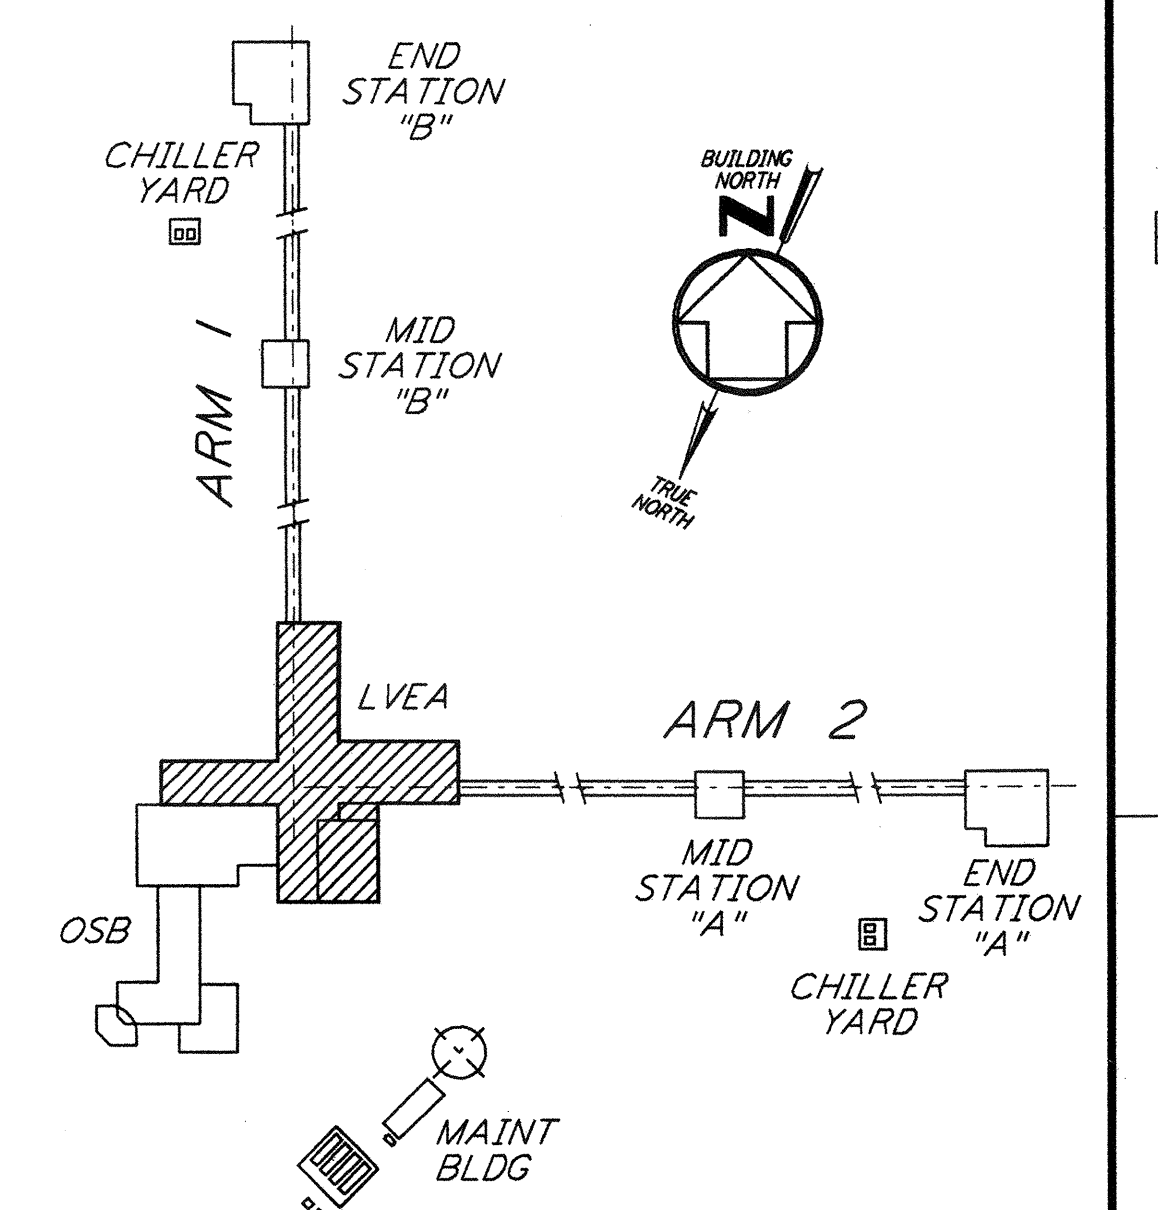

0 8 16 24 32 40 48 56 64 FT
 1/8" = 1'-0"
 DATUM POINT EL +100.00 = 61.44' (LVEA)
 DATUM POINT EL +100.00 = 61.44' (OSB)

NO.	DATE	BY	CHKD	ENGR	PROJ	DESCRIPTION
1	08-07-98	SJM	CKT	RM	TDM	ISSUED FOR AS-BUILT

ISSUED FOR CONSTRUCTION
 DRAWN CKT 11-15-96
 CHECKED TB 11-15-96
 ENGINEER SF 11-15-96
 PROJ TDM 11-15-96

AS-BUILT DRAWINGS

PARSONS
 100 WEST WALNUT STREET
 PASADENA, CALIFORNIA

LIGO
 CALIFORNIA INSTITUTE OF TECHNOLOGY
 MASSACHUSETTS INSTITUTE OF TECHNOLOGY

LASER INTERFEROMETER GRAVITATIONAL-WAVE OBSERVATORY SITE NO. 2 - LIVINGSTON, LOUISIANA

ARCHITECTURAL CORNER STATION LVEA FLOOR PLAN

SCALE: AS NOTED
 CONTRACT NUMBER: PPI50969
 PROJECT NUMBER: 8094

SHEET NUMBER: **LA-A-101**