
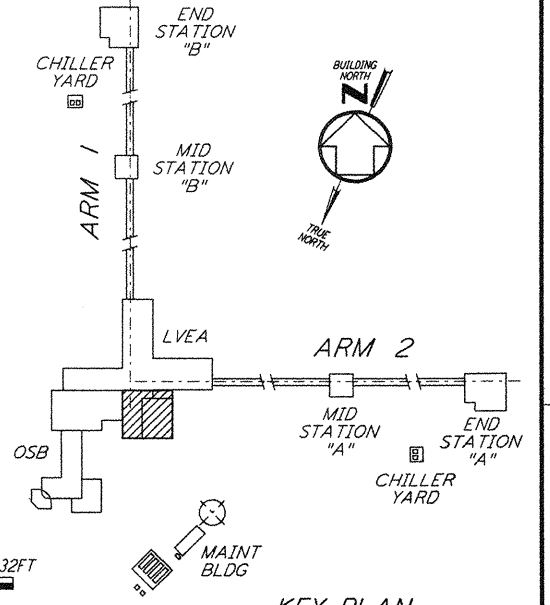
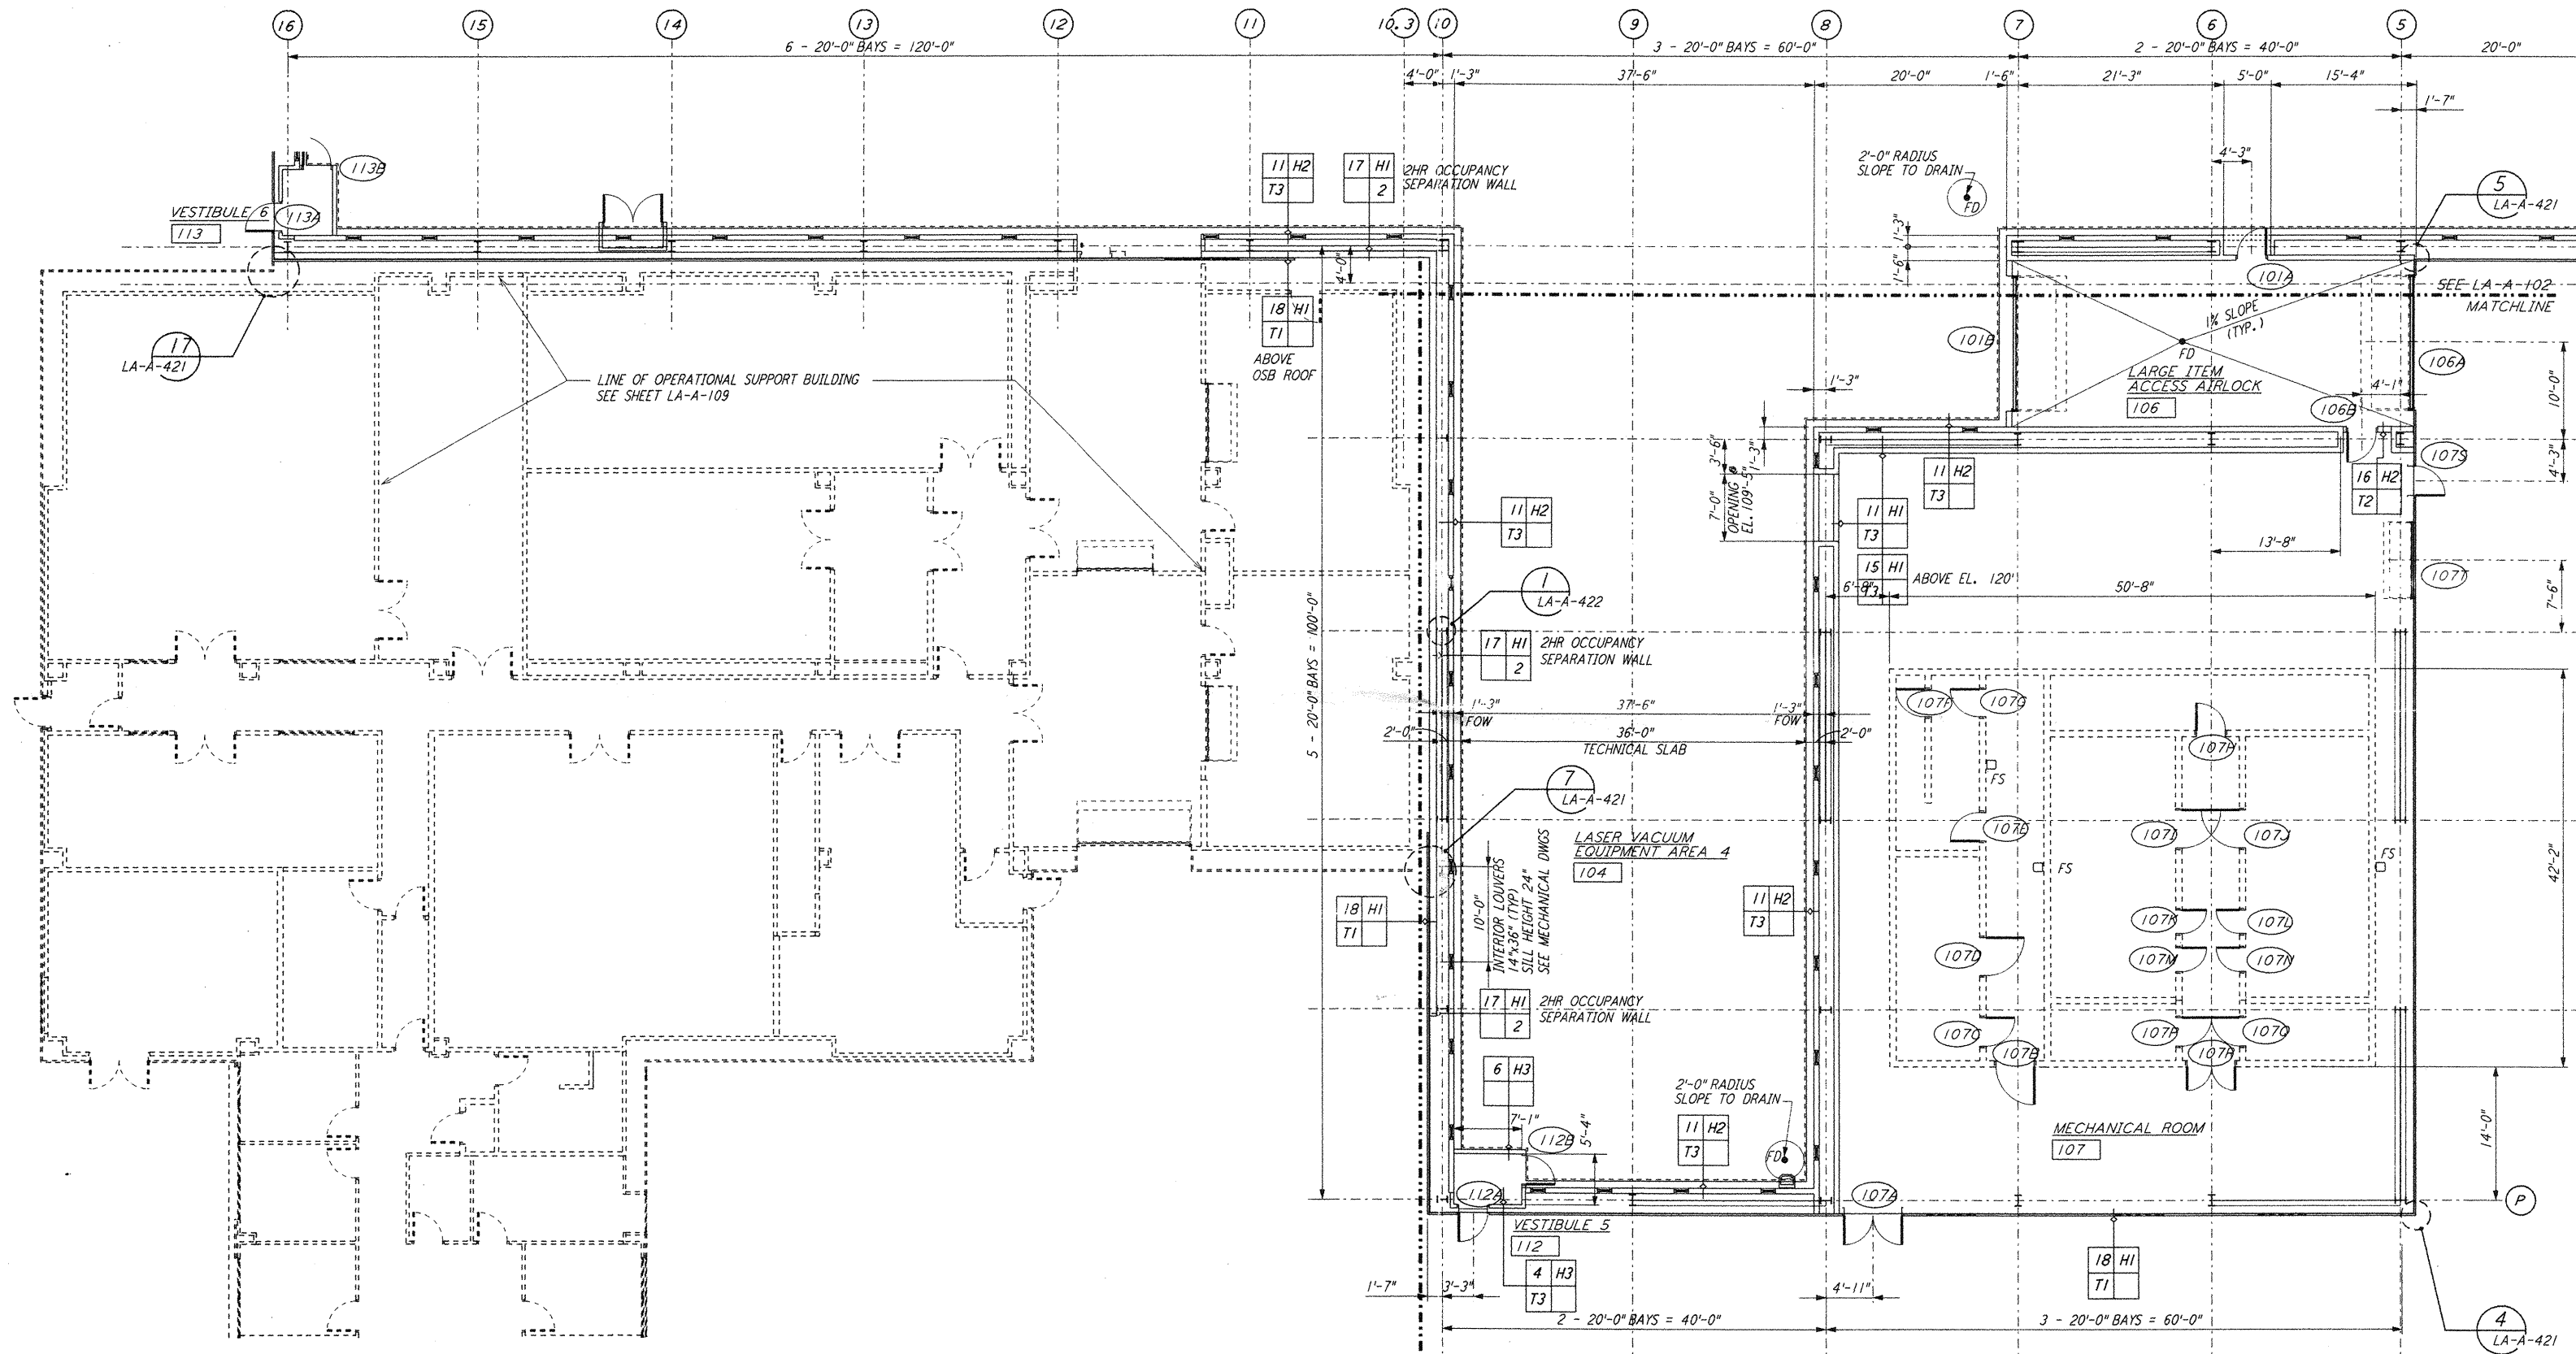


NOTE:  
 1. SEE SPECIFICATIONS FOR ADDITIONAL INFORMATION AND SCHEDULES  
 2. PROVIDE CONTROL JOINTS @ 40'-0" O. C. MAX THROUGHOUT LVEA AREAS - AT GRID LINES AND WHERE OTHERWISE INDICATED.

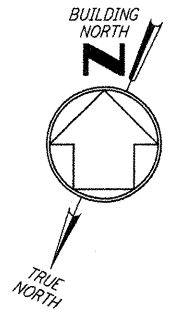

This document and the design it covers are the property of PARSONS. They are loaned only with the borrower's expressed written agreement that they will not be reproduced, copied, loaned, exhibited, or used in any other way, except by written consent from PARSONS to the borrower.

| NO. | DATE     | BY  | CHKD | ENGR | PROJ | DESCRIPTION                                       |
|-----|----------|-----|------|------|------|---|
| 2   | 08-07-98 | SJM | CKT  | AK   | TDM  | ISSUED FOR AS-BUILT CORNER STATION VSEA PARTITION |
| 1   | 2-28-97  | CKT | TB   | AK   | TDM  | ISSUED FOR AS-BUILT CORNER STATION VSEA PARTITION |

| ISSUED FOR CONSTRUCTION |     |          |
|-------------------------|-----|----------|
| DRAWN                   | CKT | 11-15-96 |
| CHECKED                 | TB  | 11-15-96 |
| ENGINEER                | SF  | 11-15-96 |
| PROJ                    | MDW | 11-15-96 |

**AS-BUILT DRAWINGS**

**PARSONS**  
 100 WEST WALNUT STREET  
 PASADENA, CALIFORNIA

**LIGO**  
 CALIFORNIA INSTITUTE OF TECHNOLOGY  
 MASSACHUSETTS INSTITUTE OF TECHNOLOGY

**LIGO-D960871-02-0**  
 LASER INTERFEROMETER  
 GRAVITATIONAL-WAVE OBSERVATORY  
 SITE NO. 2 - LIVINGSTON, LOUISIANA

TITLE: ARCHITECTURAL CORNER STATION LVEA PARTIAL FLOOR PLAN SHEET 4  
 SCALE: AS NOTED  
 CONTRACT NUMBER: PPI50969  
 PROJECT NUMBER: 8094  
 SHEET NUMBER: **LA-A-105**